egis / MOFARREH GROUP	Document Title:	**DOCUMENT SUBMISSION FORM**		MODON
	Project Name:	Development of Infrastructure in Alkharj Industrial City.	Project Contractor:	MOFARREH GROUP
	Project Number:	KHJ1-02-007	Project Consultant:	EGIS
	Project Program Manager:		Document Reference No.:	KHJ1-02-007-MAH-TS9-1-PRM-WPR-0042-00

DOCUMENT ISSUED BY				DOCUMENT RECEIVED BY			
Issued By	Hassan Salam			Received By			
Position / Company	Project Manager			Position / Company			
Signature				Signature			
	October 20,2026	Time	01:30 PM	Date		Time	

RECEIVED 20 OCT 2026

DOCUMENT SUBMISSION TYPE *(Tick relevant Box)*

	As Built		Material Sample		Bill of Quantities
	Certificate		Manual		Schedule
	Drawing		Pre-qualification		Shop Drawing
	Engineering Calculation		Procedure/Methodology		Bank Warranty
	Job Order		Product Data		Letter
■	Report		Test Report		Other

PURPOSE FOR DOCUMENT SUBMISSION				DATE RESPONSE REQUIRED BY
FOR INFORMATION ☐	FOR REVIEW & APPROVAL ■	AS REQUESTED ☐	OTHER *(As Noted)* ☐	*Indicate Date*

SUBMITTED DOCUMENTS REFERENCE NUMBERS

#	Document Reference No.	Document Description	Rev.	Hard Copy	Soft Copy
1	KHJ1-02-007-MAH-TS9-1-PRM-WPR-0042	Weekly Progress Report (October 19, 2026)	00		

To continue List - use "Submittal Continuation Form"(MOD-DOC-10.0-002)

RESPONSE STATUS

APPROVED AS SUBMITTED (APP) ☐	APPROVED AS NOTED (APN) ■	REJECTED / RE-SUBMIT (RRS) ☐

COMMENTS

Contractor has to comply attached comments sheet (CRS)

To continue Comments - use "Submittal Continuation Form"(MOD-DOC-10.0-002)

RESPONSE ISSUED BY		RESPONSE RECEIVED BY	
Issued By		Received By	
Position / Company		Position / Company	
Signature		Signature	
Date	Time	Date	Time

RECEIVED 20 OCT 2026

DAR CM Team	Action 1 (Initials)	Date / Time	Action 2 (Initials)	Date / Time	Action 3 (Initials)	Date / Time	Action 4 (Initials)	Date / Time	DAR CM Target Response - Work Days
							MAH		

KHJ1-02-007-MAH-TS9-1-PRM-WPR-0042-00

CRS Industrial City Weekly Report Oct 19, 2026.

1. The weekly SPI values maintain from approximately 1.03 to 1.03 while earned progress rises from 34.4% to 35.2%. The indicators are broadly consistent with the main report, but the calculation basis and data cut-off should be clarified, particularly given the physical progress

2. The cumulative figures indicate approximately 83.0% baseline progress, 57.9% revised-plan progress, and 47.0% actual progress through October 2026. The October cumulative actual is 52.54%, broadly consistent with the main report. Confirm that all series use the same cut-off and that monthly values are not confused with cumulative values.

3. The main report shows forecast completion dates of 2 October 2026 for roadworks and the medium-voltage network, whereas the Milestones sheet shows 7 November 2026 and 31 October 2026, respectively. These inconsistent dates prevent the report from presenting a single reliable milestone forecast.
   Road Works Forecast = **02-Oct-2026** **Over due**
   MV Network Forecast = **02-Oct-2026** **Over due**
   All Networks = **02-Feb-2027**

4. Invoice 1 records a period start date of 15 December 2026 and a period end date of 25 March 2026. The start date is later than both the stated period end date and the report data date of 19 October 2026. The recorded dates require correction or documentary clarification.

5. The main report shows planned and earned progress of 34.17% and 35.16%, respectively, while Quality-Stat reports cumulative planned and actual progress of 33.3% and 34.4%. Different measurement bases may explain the variance, but the report does not identify or reconcile those bases.

Yasser El naggar

Egis Saudi Engineering Consultancy


Data sensitivity - Public

Weekly Progress Report - Construction Projects	19-Oct-26
Contract General Information	
Project Name	Development Industrial City-Alkharj
Project ID	3121
Contractor	Moffreh Group
Consultant	EGIS
Stage	45th Week
Modon PM	Rakan Alotaibi
Key Dates	
Contract Award Date	09-Nov-25
Contract Sign Date	16-Nov-25
Site Handover Date	03-Dec-25
Original Completion	02-Dec-27
Contract Award Date (Hijri)	18/05/1447
Contract Sign Date (Hijri)	25/05/1447
Site Handover Date (Hijri)	12/06/1447
Original Completion (Hijri)	04/07/1449
Revised Completion Date	02-Dec-27
Committed Completion Date	02-Dec-27
Forecast Completion	02-Dec-27
Variance	0

Data sensitivity - Public

CUT & FILL LAYOUT ZONE-A

ZONE A(Cumulative Qty)				
ITEM	Total Quantity (m3)	Excuted Quantity (m3)	Remaining Quantity (m3)	Percentage %
Fill	357335	268632	88703	75.18%
Cut	97475	89831	7644	92.16%

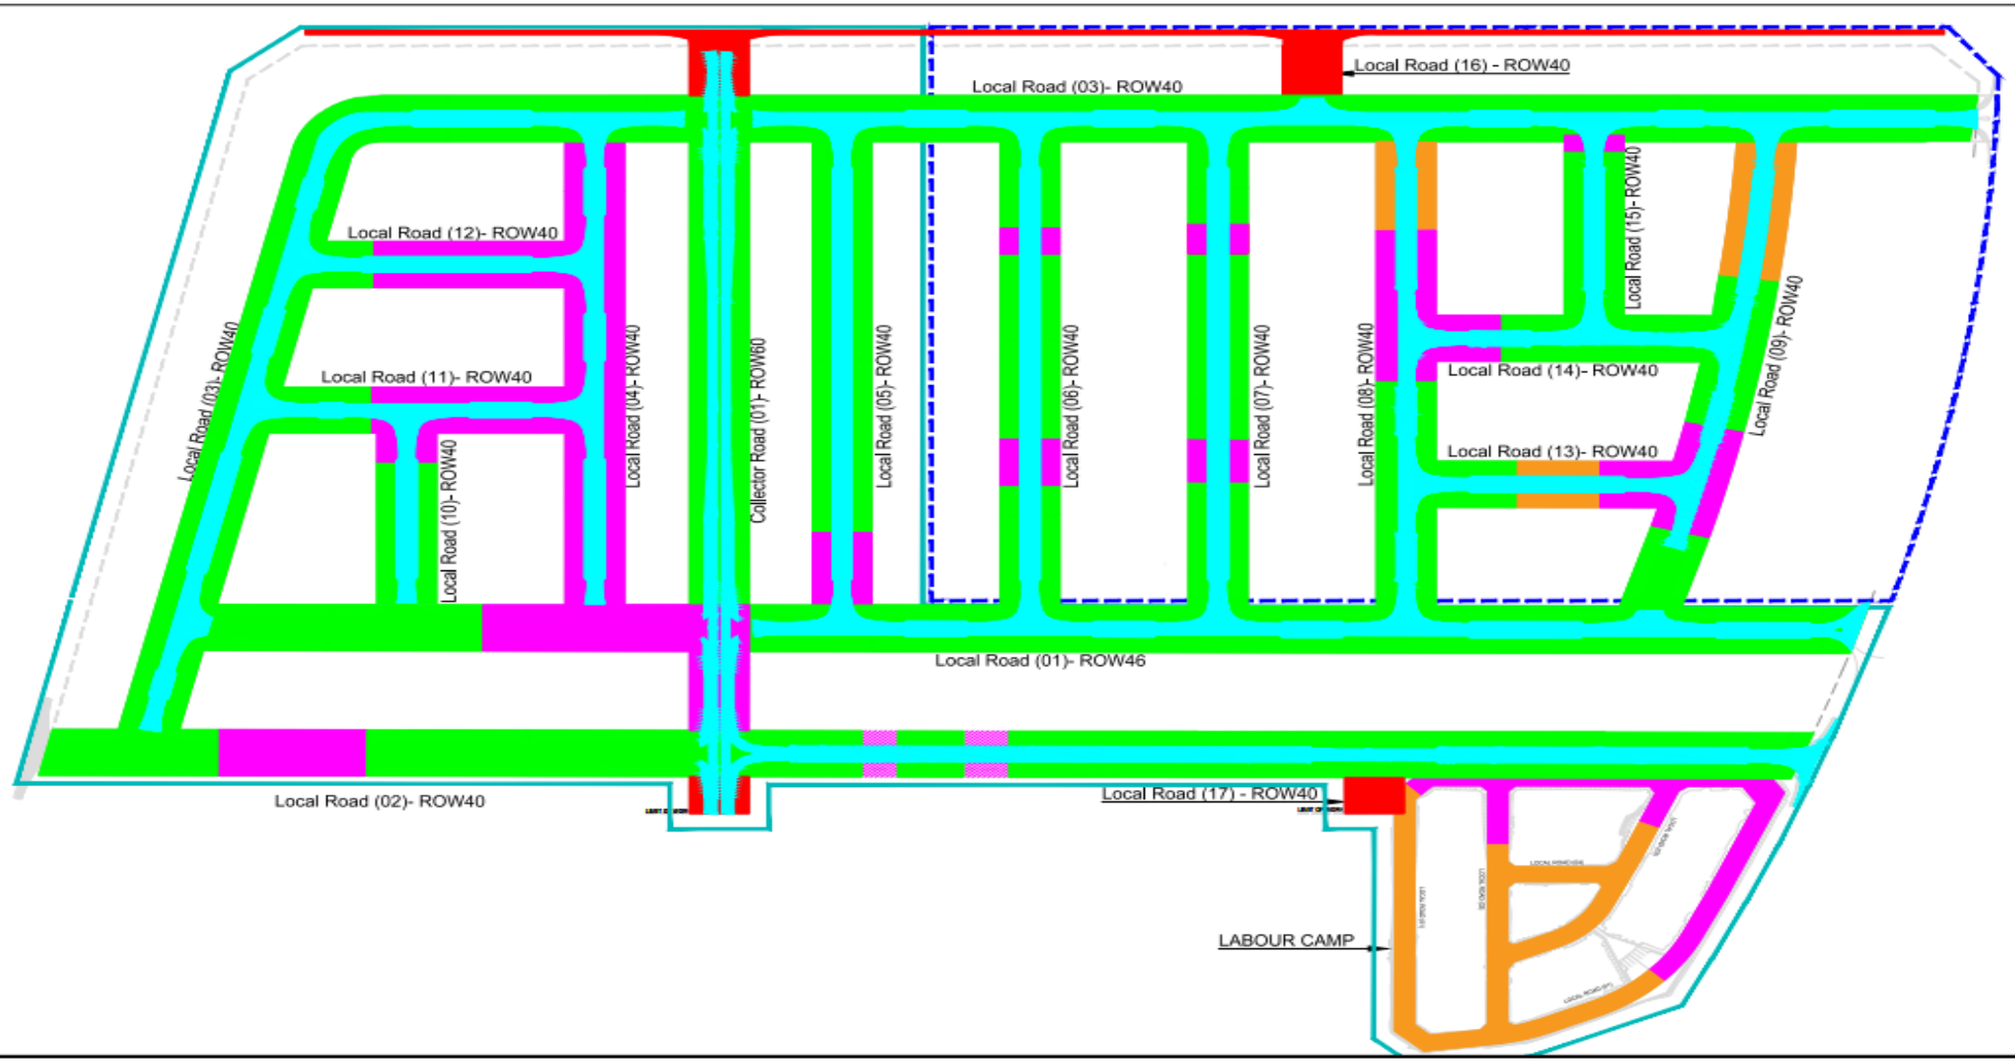



Legend

- Excuted Fill
- Excuted Cut
- Remaining Cut
- Remaining Fill
- Bottom Subgrade

0 10 20 30 40 50 100 METERS
SCALE (A1) 1:1000

REFERENCE DRAWINGS

REVISIONS TABLE

PURPOSE OF ISSUE: FOR APPROVAL


Weekly Progress

FILL-ZONE A


SCALE 1:1000

BACKFILLING LAYOUT ZONE-B

ZONE B (CUT&FILL) PROGRESS				
ITEM	Total Quantity (m3)	Excuted Quantity (m3)	Remaining Quantity (m3)	Percentage %
Fill	505230	281676	223554	55.75%
Cut	40190	36189	4001	90.04%

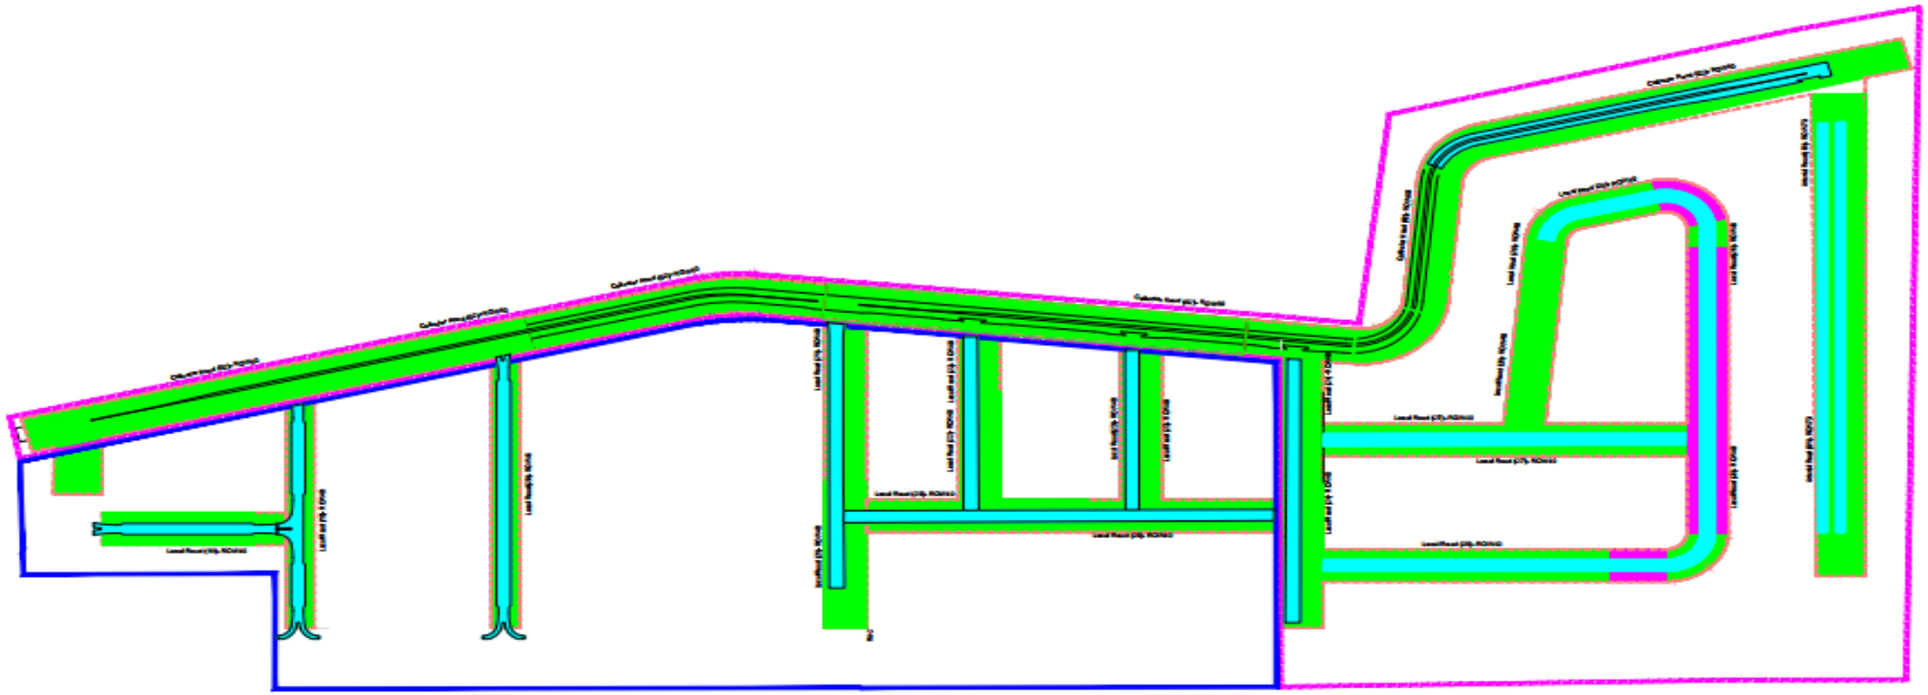

KEY PLAN

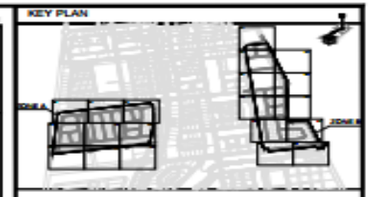

Legend

- Executed Fill
- Executed Cut
- Remaing Fill
- Bottom Subgrade

0 10 20 30 40 50 100 METERS

SCALE (A1) 1:1000

REFERENCE DRAWINGS

REVISIONS TABLE

PURPOSE OF ISSUE: FOR APPROVAL

MODON

egis

MOFARREH GROUP

Weekly Progress


Layout-Zone B

SCALE 1:1000

Date

ROAD LAYOUT ZONE-A

ZONE A				
ITEM	Total Quantity (m3)	Excuted Quantity (m3)	Remaining Quantity (m3)	Percentage %
Subgrade	82330.47	57234.000	25096.472	69.52%
Aggregate BaseCourse	52379.08	31268.000	21111.078	59.70%
Asphalt Binder Course	19244.50	10256.000	8988.498	53.29%
Asphalt Wearing Course	12399.96	0.000	12399.958	0.00%

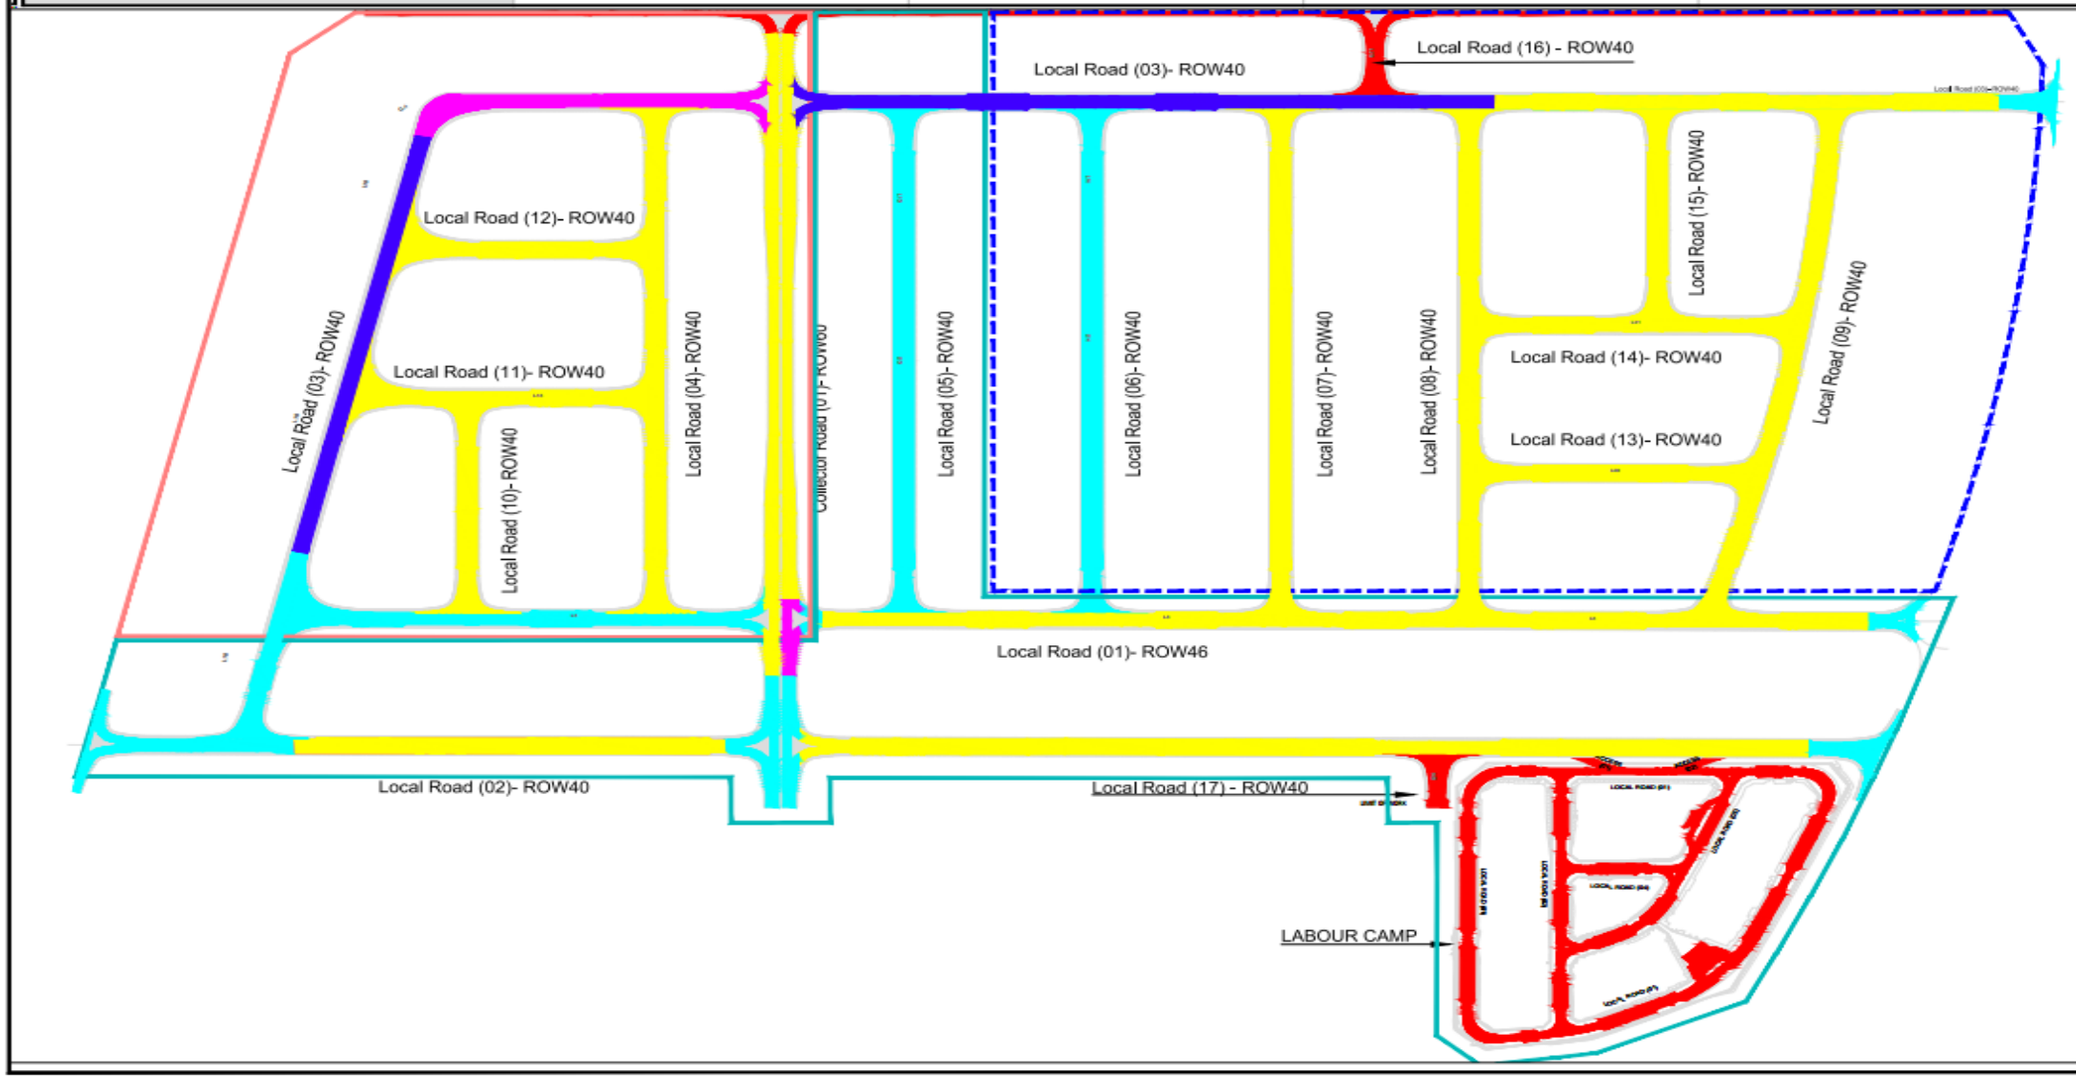

KEY PLAN



Legend

- Bottom Subgrade
- Subgrade
- Aggregate Base Course
- Asphalt Binder Course
- Asphalt Wearing Couse
- Remaining

Work Area

- Engr.Shamy
- Engr.Mohammed
- Engr.Nivin

0 10 20 30 40 50 100 METERS
SCALE (A1) 1:1000

REFERENCE DRAWINGS

REVISIONS TABLE

REV	DESCRIPTION	DATE

PURPOSE OF ISSUE: FOR APPROVAL



Weekly Progress

ROAD PROGRESS LAYOUT-ZONE A

SCALE 1:1000 Date

ROAD LAYOUT ZONE-B

ROAD ACTIVATES PROGRESS ZONE B				
ITEM	Total Quantity	Excuted Quantity	Remaining Quantity	Percentage %
Subgrade(M3)	78595.25	69459.000	9136.246	88.38%
Aggregate BaseCourse(M3)	47537.25	31271.000	16266.252	65.78%
Asphalt Binder Course + MC(M3)	24947.75	14689.000	10258.748	58.88%
Asphalt Wearing Course + RC (M3)	11204.81	0.000	11204.809	0.00%

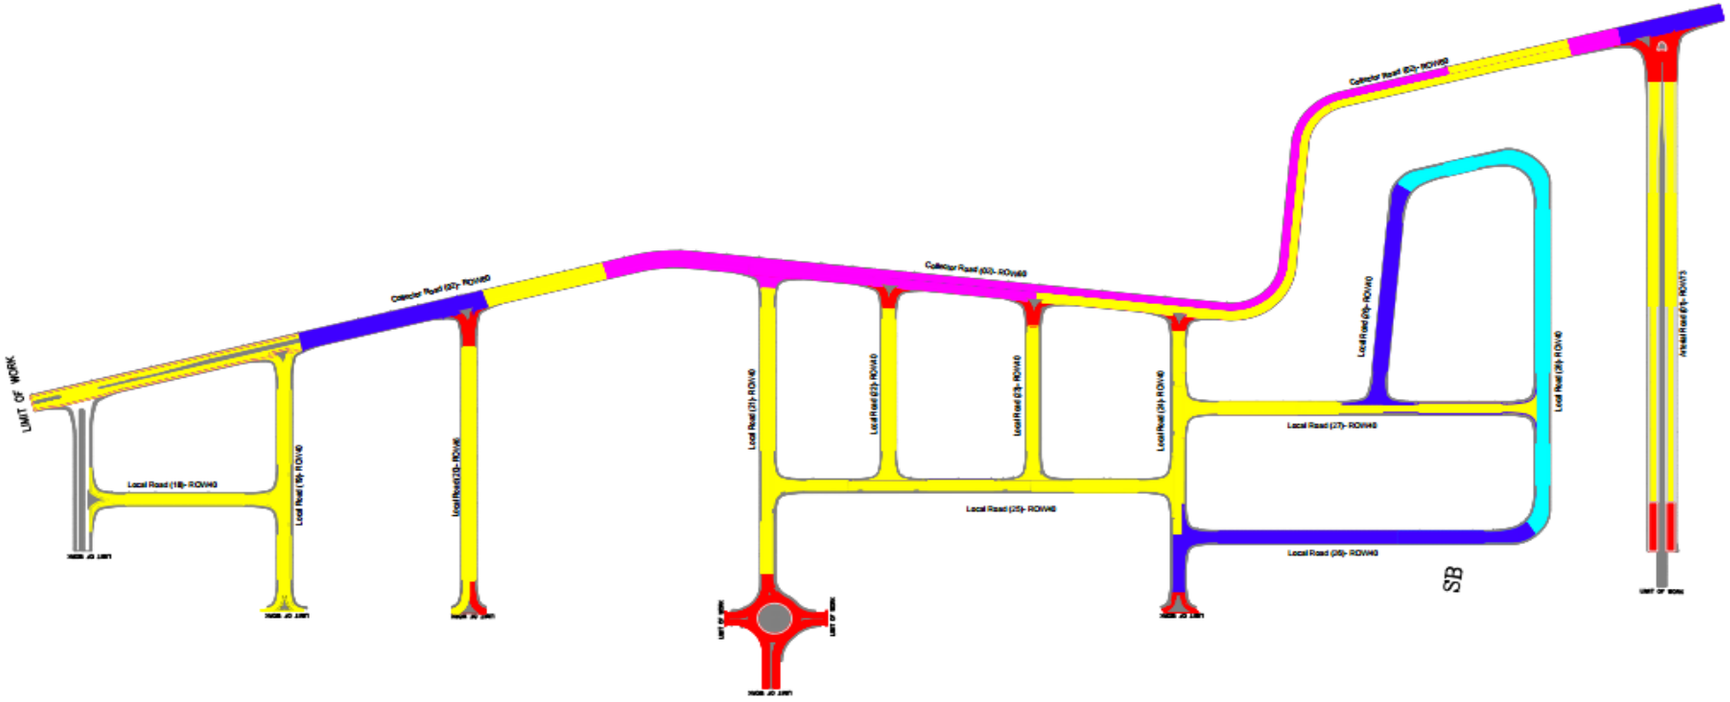

KEY PLAN



Legend

- Bottem Subgrade
- Subgrade
- Aggregate Base Course
- Asphalt Binder Course
- Asphalt Wearing Course
- Work Remaining

Work Area

- Eng.Bestawi
- Eng.Salem

REFERENCE DRAWINGS

REVISIONS TABLE

REV	DESCRIPTION	DATE

PURPOSE OF ISSUE: FOR APPROVAL

MODON - UPDATED CONCEPT MASTER PLAN AND INFRASTRUCTURE DESIGNS FOR ALKHAWI INDUSTRIAL CITY

Weekly Progress


LAYOUT - ZONE B

SCALE 1:1000

Date

SEWER NETWORK PROGRESS LAYOUT ZONE-A

ZONE A (Sewer)				
ITEM	Total Quantity (LM)	Executed Quantity (LM)	Remaining Quantity (LM)	Percentage %
Excavation	14307.84	13334.729	973.111	93.20%
Bedding	14307.84	11489.019	2818.821	80.30%
Installation	14307.84	10529.821	3778.019	73.59%
Backfilling	14307.84	6604.387	7703.453	46.16%

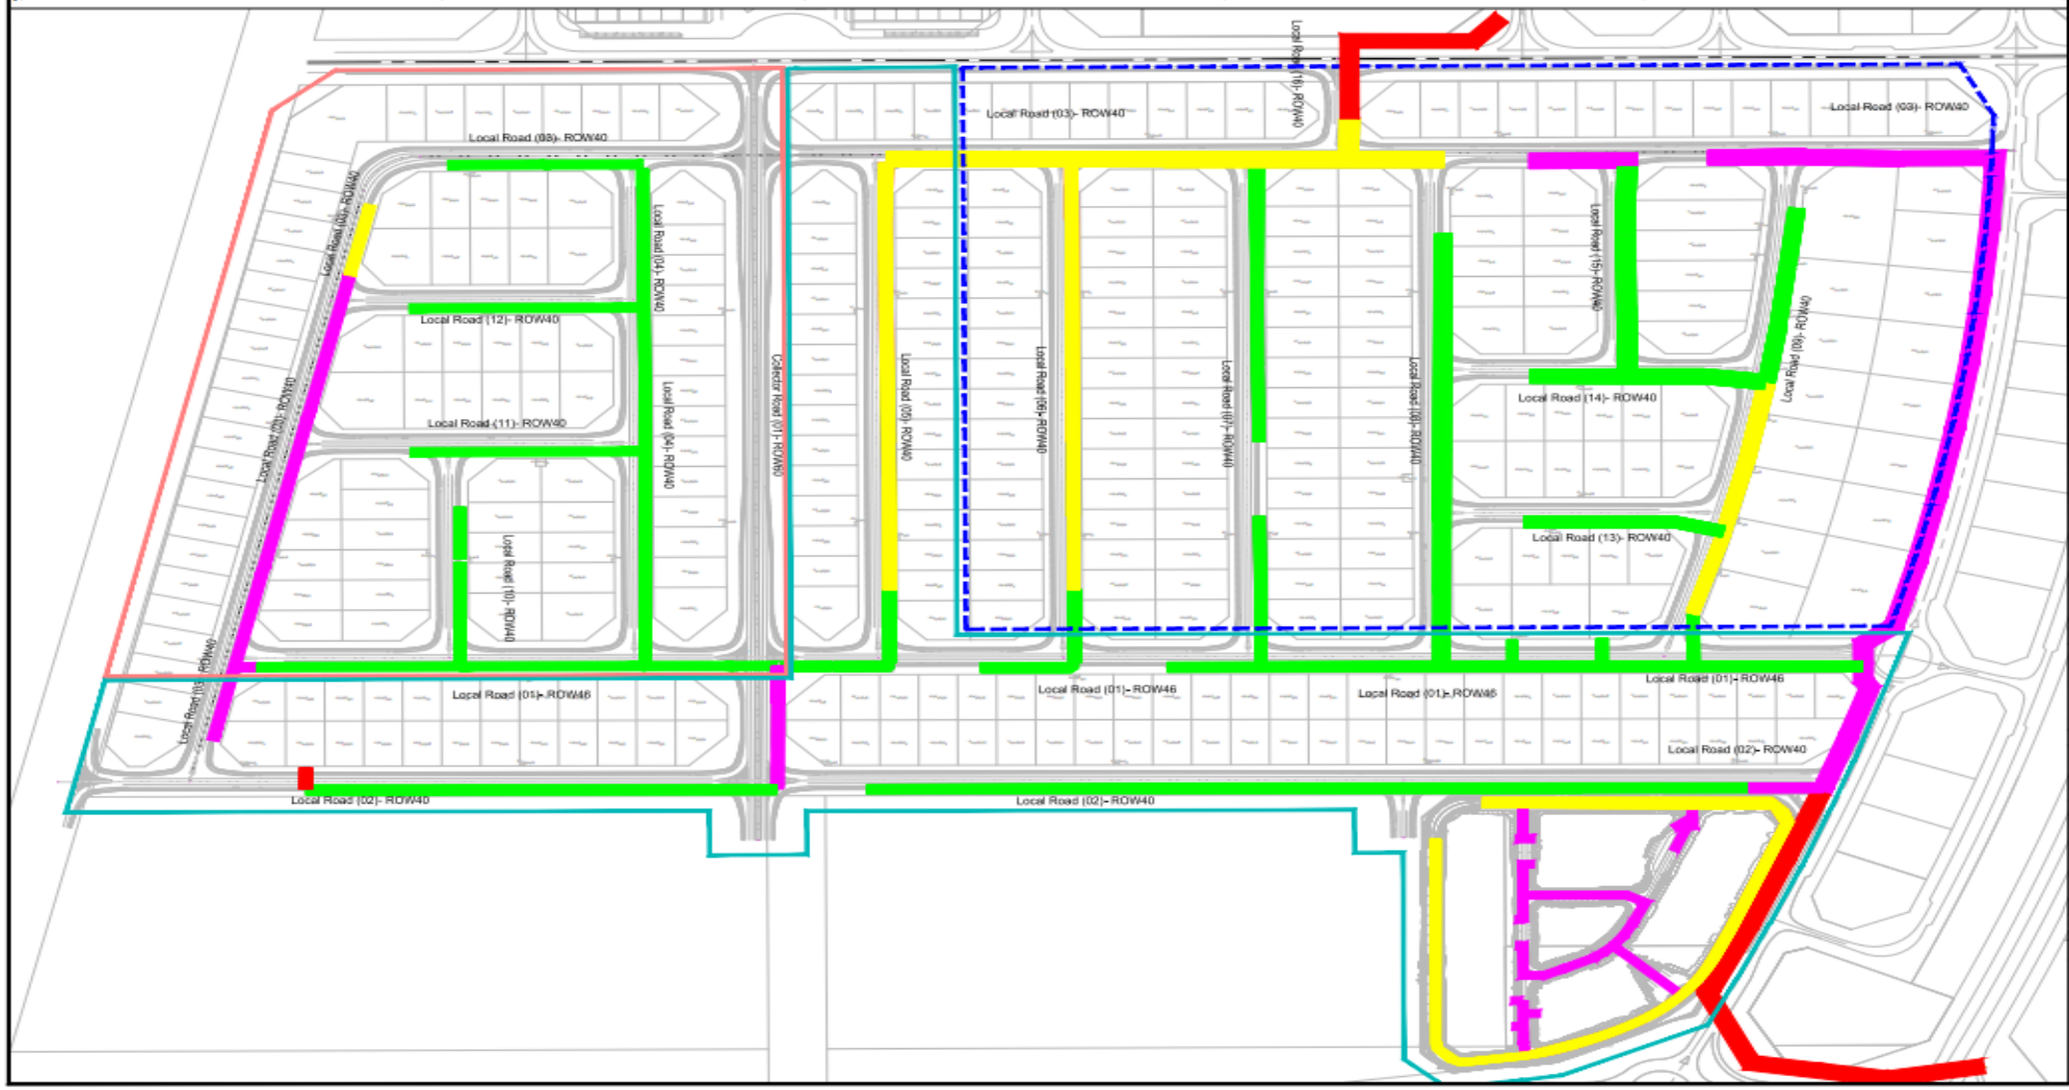

KEY PLAN



Legend

- Excavation
- Bedding
- Installation
- Backfilling
- Remaining

REFERENCE DRAWINGS

REVISIONS TABLE


REV	DESCRIPTION	DATE

PURPOSE OF ISSUE: FOR APPROVAL

SCALE
1:1000

SEWER NETWORK PROGRESS LAYOUT ZONE-B

(SEWER) PIPE PROGRESS ZONE B				
ITEM	Total Quantity (LM)	Excuted Quantity (LM)	Remaining Quantity (LM)	Percentage %
Excavation	7539	5946.07	1592.93	78.87%
Bedding	7539	5946.07	1592.93	78.87%
Installation	7539	5927.88	1611.12	78.63%
Backfilling	7398	4833.53	2564.47	65.34%

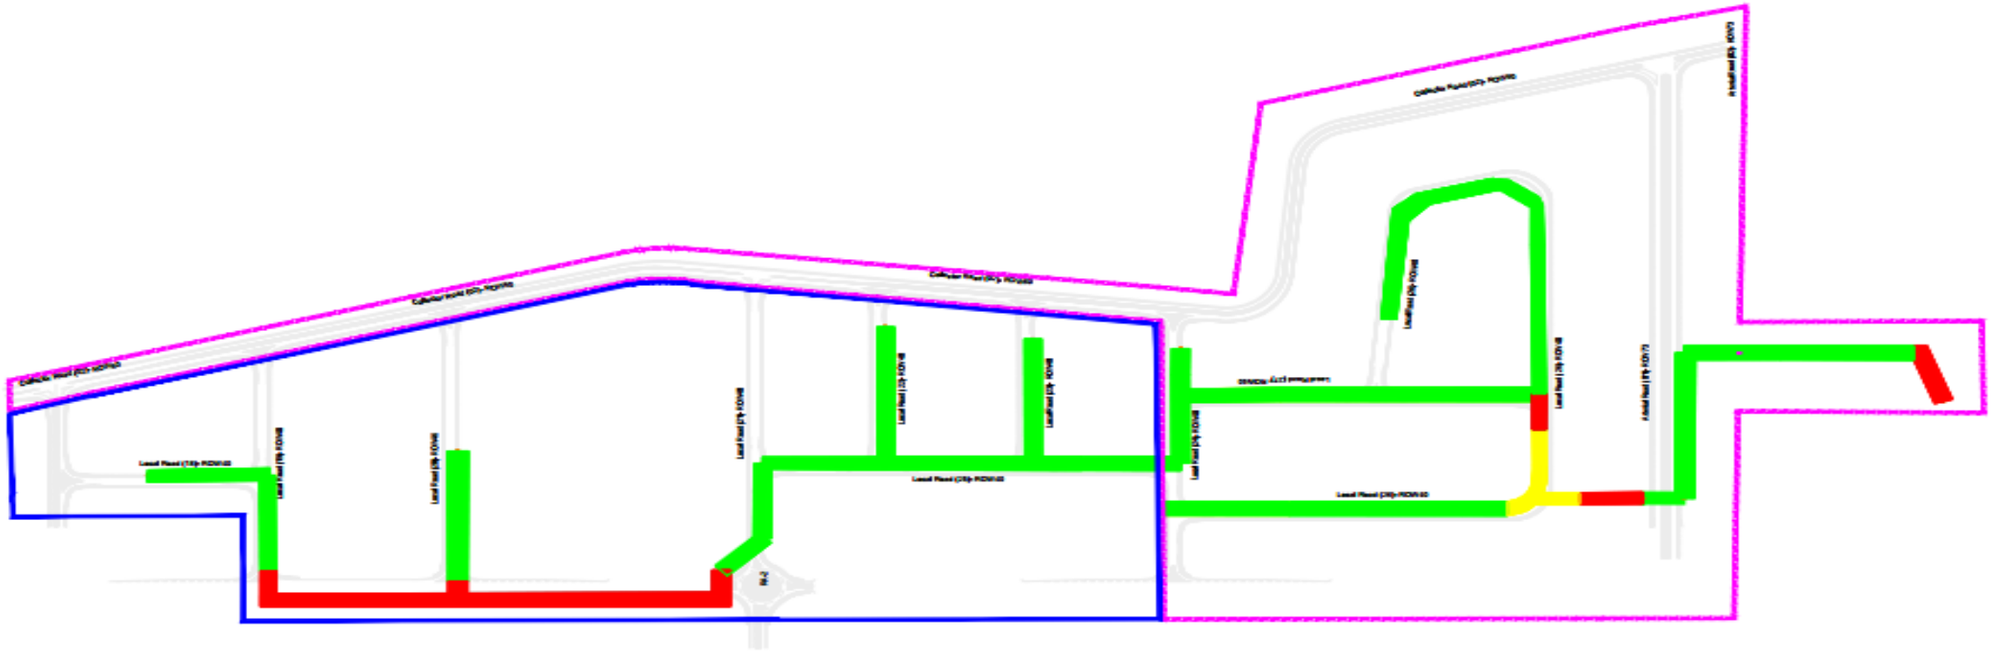

KEY PLAN



Legend

- Excavation
- Bedding
- Installation
- Backfilling
- Remaining


REFERENCE DRAWINGS

REVISIONS TABLE

PURPOSE OF ISSUE: FOR APPROVAL

SEWER MANHOLE PROGRESS LAYOUT ZONE-A

ZONE A (Sewer Manhole)				
ITEM	Total Quantity (EA)	Executed Quantity (EA)	Remaining Quantity (EA)	Percentage %
Excavation	286	173	114	60.31%
Blinding	286	144	142	50.35%
Installation	286	135	151	47.10%
Backfilling	286	80	206	27.97%

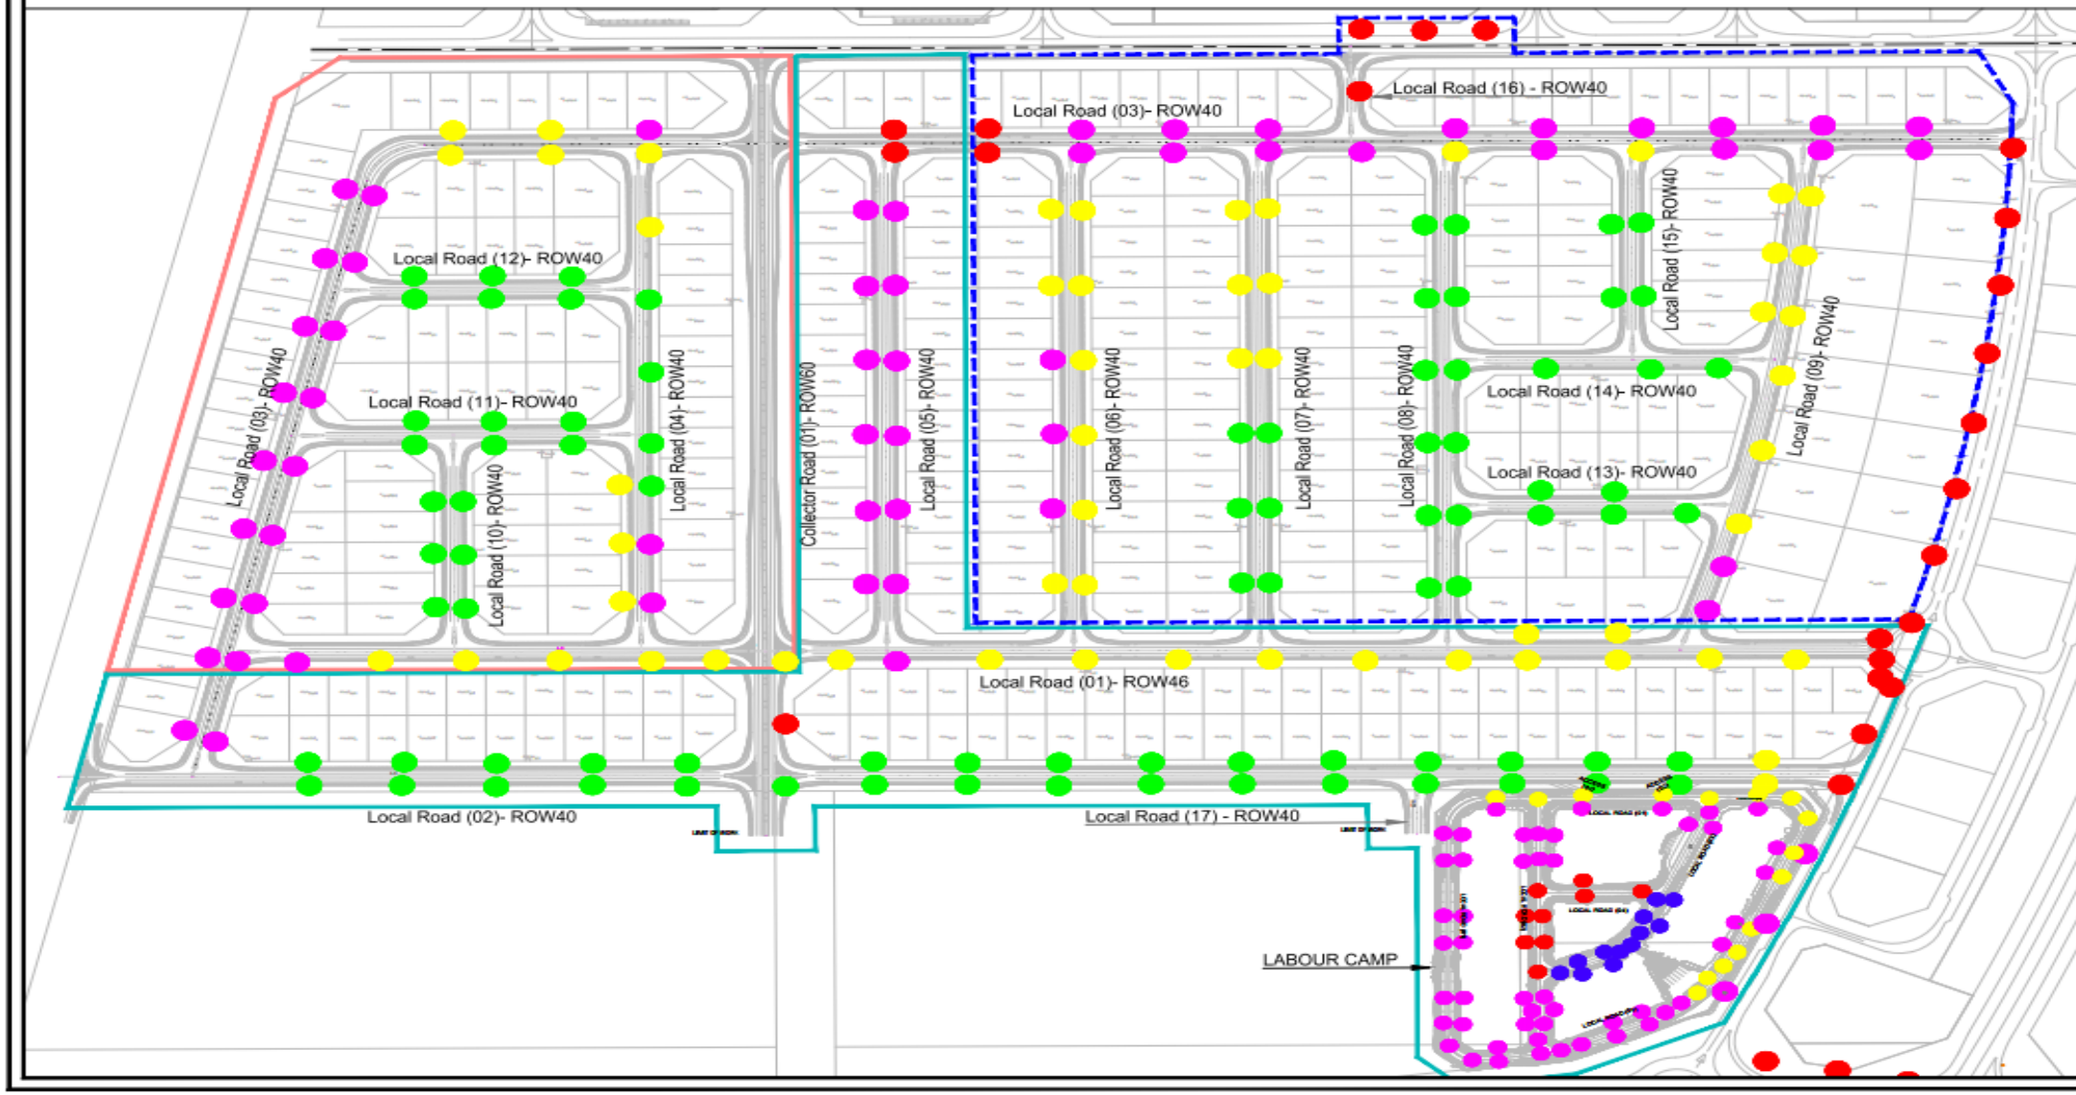



Legend

- Excavation
- Blinding
- Installation
- Backfilling
- Remaining

REFERENCE DRAWINGS

REVISIONS TABLE

PURPOSE OF ISSUE: FOR APPROVAL

MODON

egis

MOFARREH GROUP
ENGINEERING & CONSTRUCTION


SEWER NETWORK SYSTEM

SEWER MANHOLE PROGRESS LAYOUT ZONE-A

SCALE 1:1000

SEWER MANHOLE PROGRESS LAYOUT ZONE-B

ZONE B (Sewer Manhole) Progress				
ITEM	Total Quantity (EA)	Executed Quantity (EA)	Remaining Quantity (EA)	Percentage %
Excavation	107	92	15	85.98%
Blinding	107	82	25	76.64%
Installation	107	83	24	77.29%
Backfilling	107	19	88	17.76%

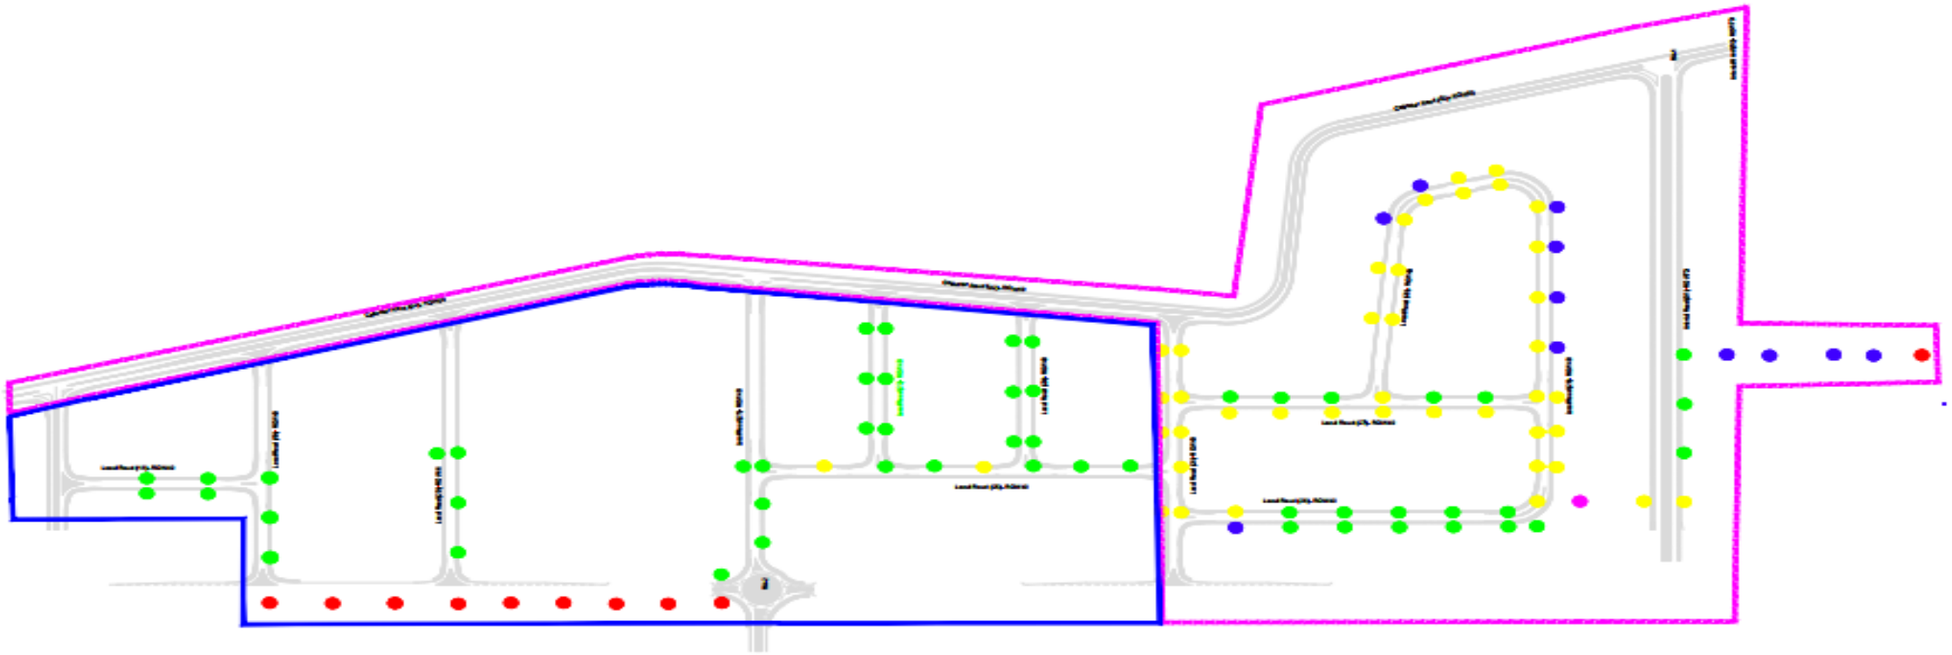

KEY PLAN



Legend

- Excavation
- Blinding
- Installation
- Backfilling
- Remaining

REFERENCE DRAWINGS

REVISIONS TABLE

PURPOSE OF ISSUE: FOR APPROVAL

MODON

egis

MOFARREH GROUP


SEWER NETWORK PROCUREMENT PROGRESS LAYOUT (ZONE-A,B & LABOUR CAMP)

Sewer Network materials status

SR	MATERIAL	UNIT	TOTAL QTY	DELIVERED	% DELIVERED	REMAINING QTY	% REMIAINING
1	GRP PIPE DIA 150 mm	L.M	4,111.00	4,111.00	100.00%	0	0.00%
2	GRP PIPE DIA 200 mm	L.M	12,824.00	11,787.00	91.91%	1037	8.09%
3	GRP PIPE DIA 250 mm	L.M	2,310.00	2,310.00	100.00%	0	0.00%
4	GRP PIPE DIA 300 mm	L.M	2,700.00	2,700.00	100.00%	0	0.00%
5	GRP PIPE DIA 400 mm	L.M	2,086.00	2,086.00	100.00%	0	0.00%
6	GRP PIPE DIA 500 mm	L.M	1,164.00	1,164.00	100.00%	0	0.00%
7	GRP PIPE DIA 600 mm	L.M	1,792.00	1,692.00	94.42%	100	5.58%
8	Sewege Manhole	EA	393.00	390.00	99.24%	3	0.76%
9	Warning tape	Roll	926.00	450.00	48.60%	476	51.40%

STORM NETWORK PROGRESS LAYOUT ZONE-A

ZONE A (Storm)				
ITEM	Total Quantity (LM)	Excuted Quantity (LM)	Remaining Quantity (LM)	Percentage %
Excavation	14482	11320.798	3161.202	78.17%
Bedding	14482	11119.242	3362.758	76.78%
Installation	14482	10579.754	3902.246	73.05%
Backfilling	14482	6872	7610	47.45%

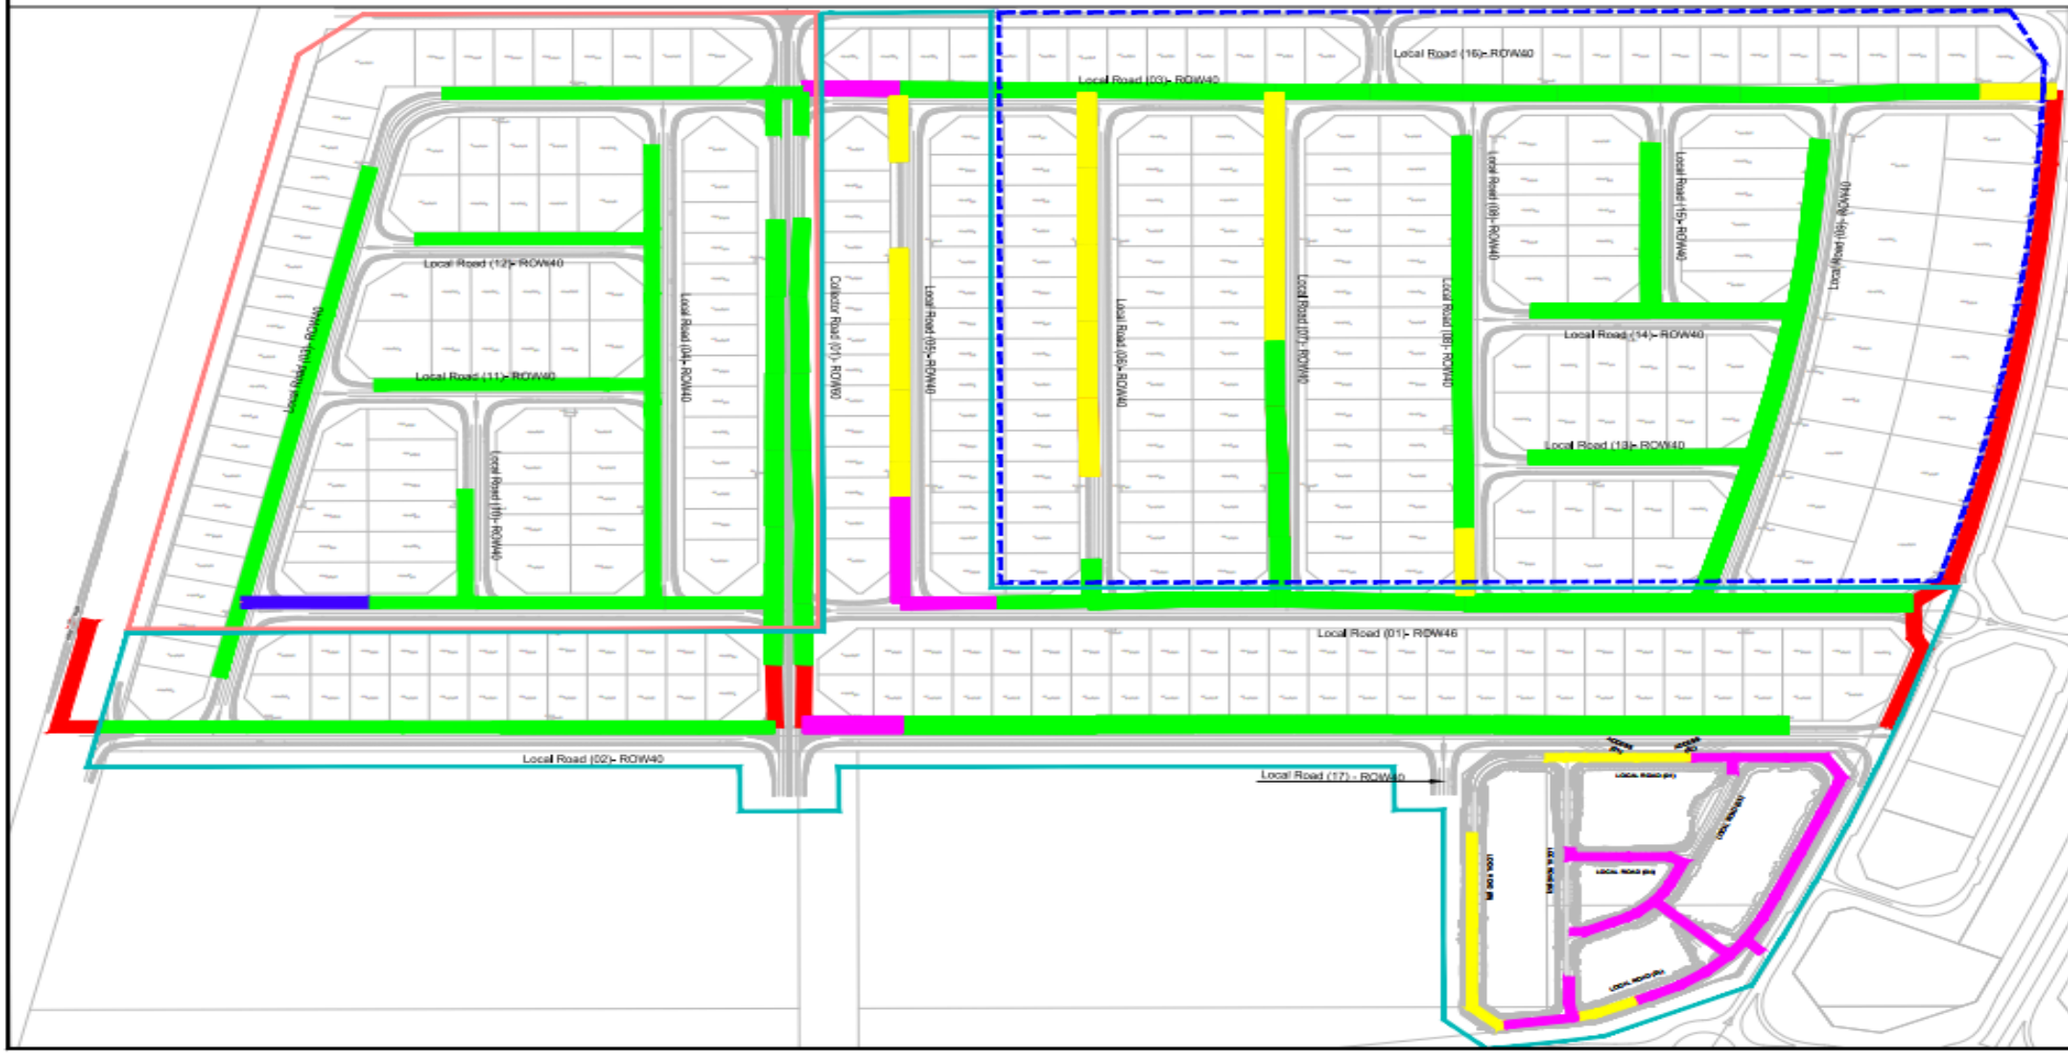

KEY PLAN



Legend

- Excavation
- Bedding
- Installation
- Backfilling
- Remaining

REFERENCE DRAWINGS

REVISIONS TABLE

PURPOSE OF ISSUE: FOR APPROVAL

MODON

egis


MOFARREH GROUP

SCALE 1:1000


SHEET

STORM NETWORK PROGRESS LAYOUT ZONE-B

(STORM) PIPE PROGRESS ZONE B				
ITEM	Total Quantity (LM)	Excuted Quantity (LM)	Remaining Quantity (LM)	Percentage %
Excavation	8544.19	7810.437	733.753	91.41%
Bedding	8544.19	7142.368	1401.823	83.59%
Installation	8544.19	6303.569	2240.621	73.78%
Backfilling	8544.19	3813.072	4731.118	44.63%

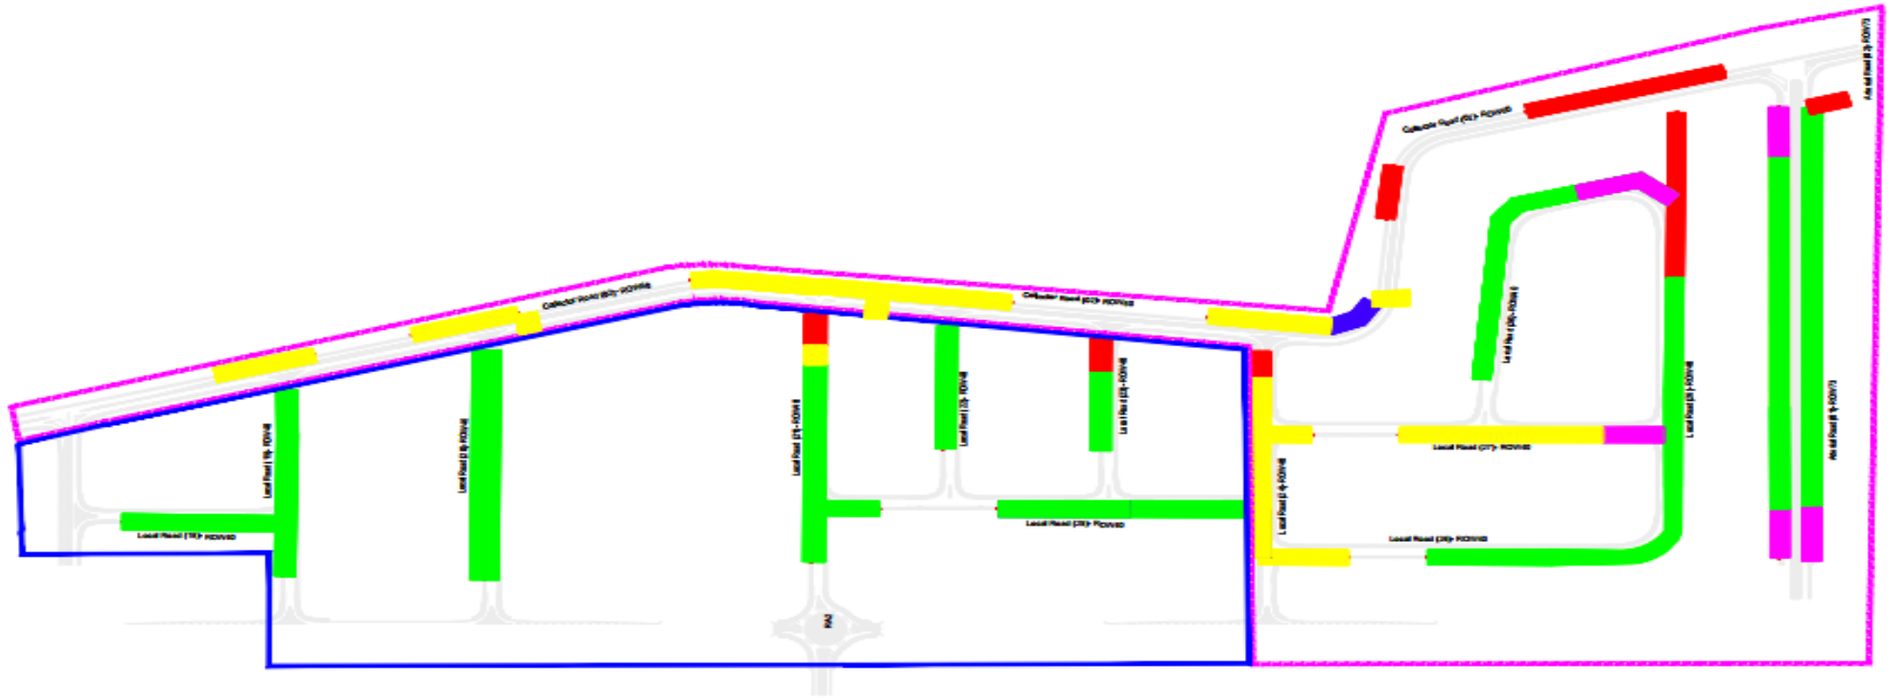

KEY PLAN

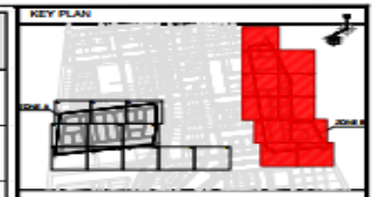

Legend

- Excavation
- Bedding
- Installation
- Backfilling

REFERENCE DRAWINGS

REVISIONS TABLE

PURPOSE OF ISSUE: FOR APPROVAL

MODON

egis


MOFARREH GROUP ENGINEERING & CONSTRUCTION

SCALE

SHEET

STORM MANHOLE PROGRESS LAYOUT ZONE-A

ZONE A + Labor Camp (Storm Manhole)				
ITEM	Total Quantity (EA)	Executed Quantity (EA)	Remaining Quantity (EA)	Percentage %
Excavation	194	134	60	69.07%
Blinding	194	116	78	59.79%
Installation	194	111	83	57.32%
Backfilling	194	59	135	30.41%

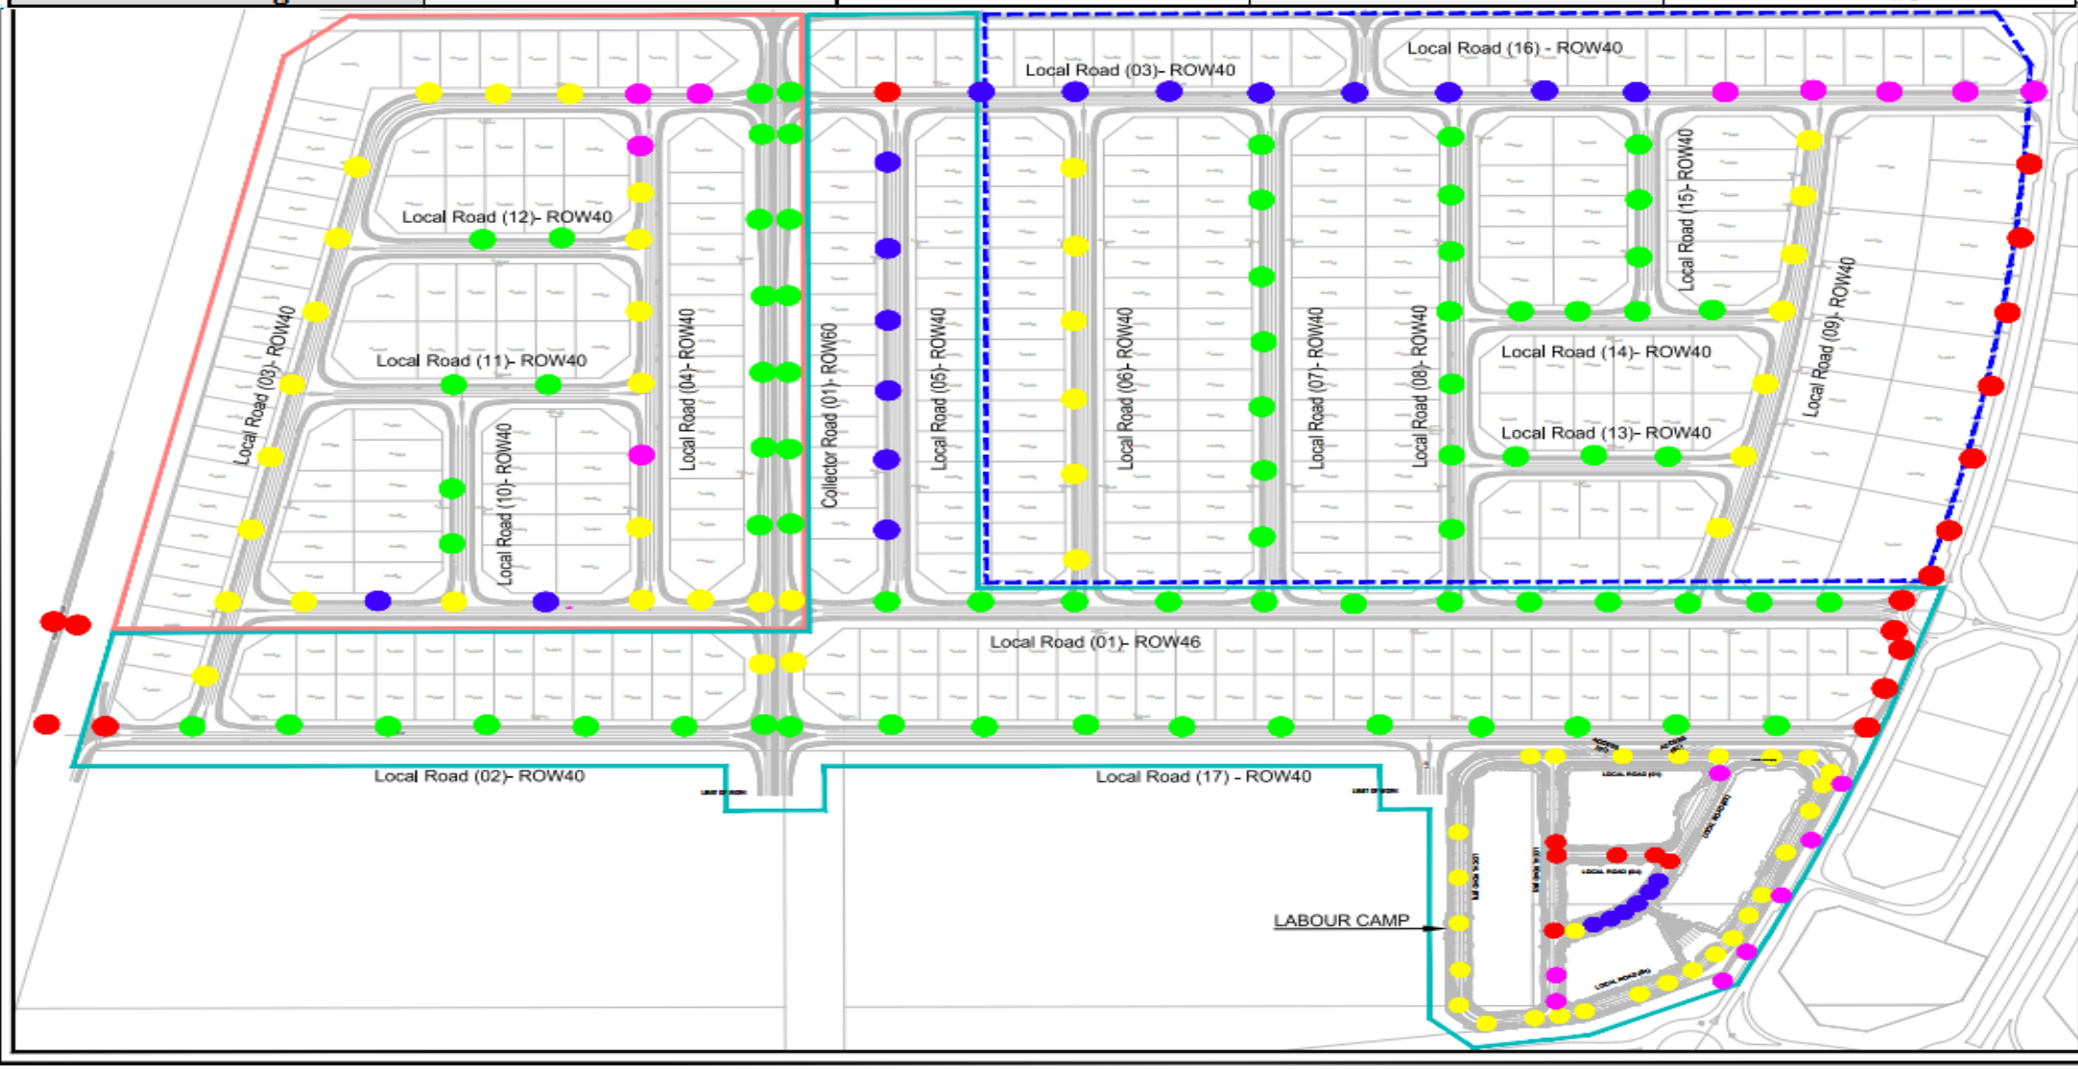

KEY PLAN



Legend

- Excavation
- Blinding
- Installation
- Backfilling
- Remaining


REFERENCE DRAWINGS

REVISIONS TABLE

PURPOSE OF ISSUE: FOR APPROVAL

SCALE 1:1000 SHEET

ZONE B (Storm Manhole) Progress				
ITEM	Total Quantity (EA)	Executed Quantity (EA)	Remaining Quantity (EA)	Percentage %
Excavation	104	94	10	90.38%
Blinding	104	87	17	83.65%
Installation	104	85	19	81.35%
Backfilling	104	25	79	24.04%

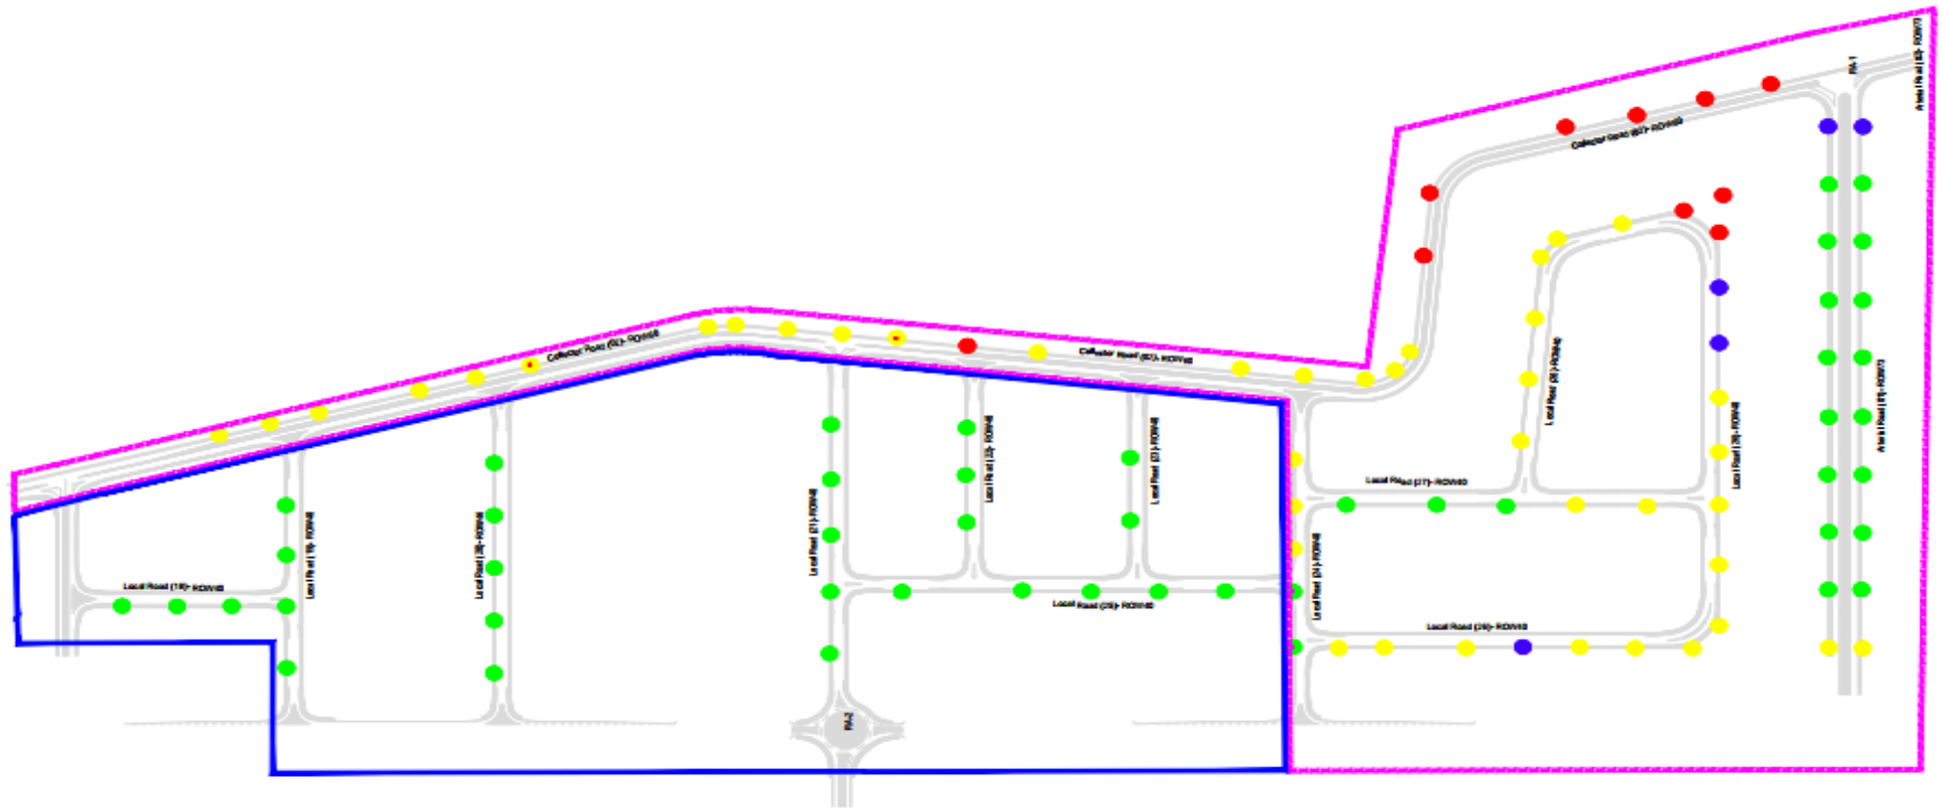

KEY PLAN



Legend

- Excavation
- Blinding
- Installation
- Backfilling
- Remaining

REFERENCE DRAWINGS

REVISIONS TABLE

PURPOSE OF ISSUE: FOR APPROVAL

MODON

egis

MOFARREH GROUP

STORM DRAINAGE SYSTEM


STORM DRAINAGE LAYOUT PLAN ZONE B

SCALE 1:1000

SHEET of 0052

STORM SECONDARY NETWORK PROGRESS LAYOUT ZONE-A

ZONE A (Storm Secondary)				
ITEM	Total Quantity (LM)	Excuted Quantity (LM)	Remaining Quantity (LM)	Percentage %
Excavation	7206.5	4648.260	2558.240	64.50%
Bedding	7206.5	4512.165	2694.335	62.61%
Installation	7206.5	4325.941	2880.559	60.03%
Backfilling	7206.5	2698.612	4507.888	37.45%

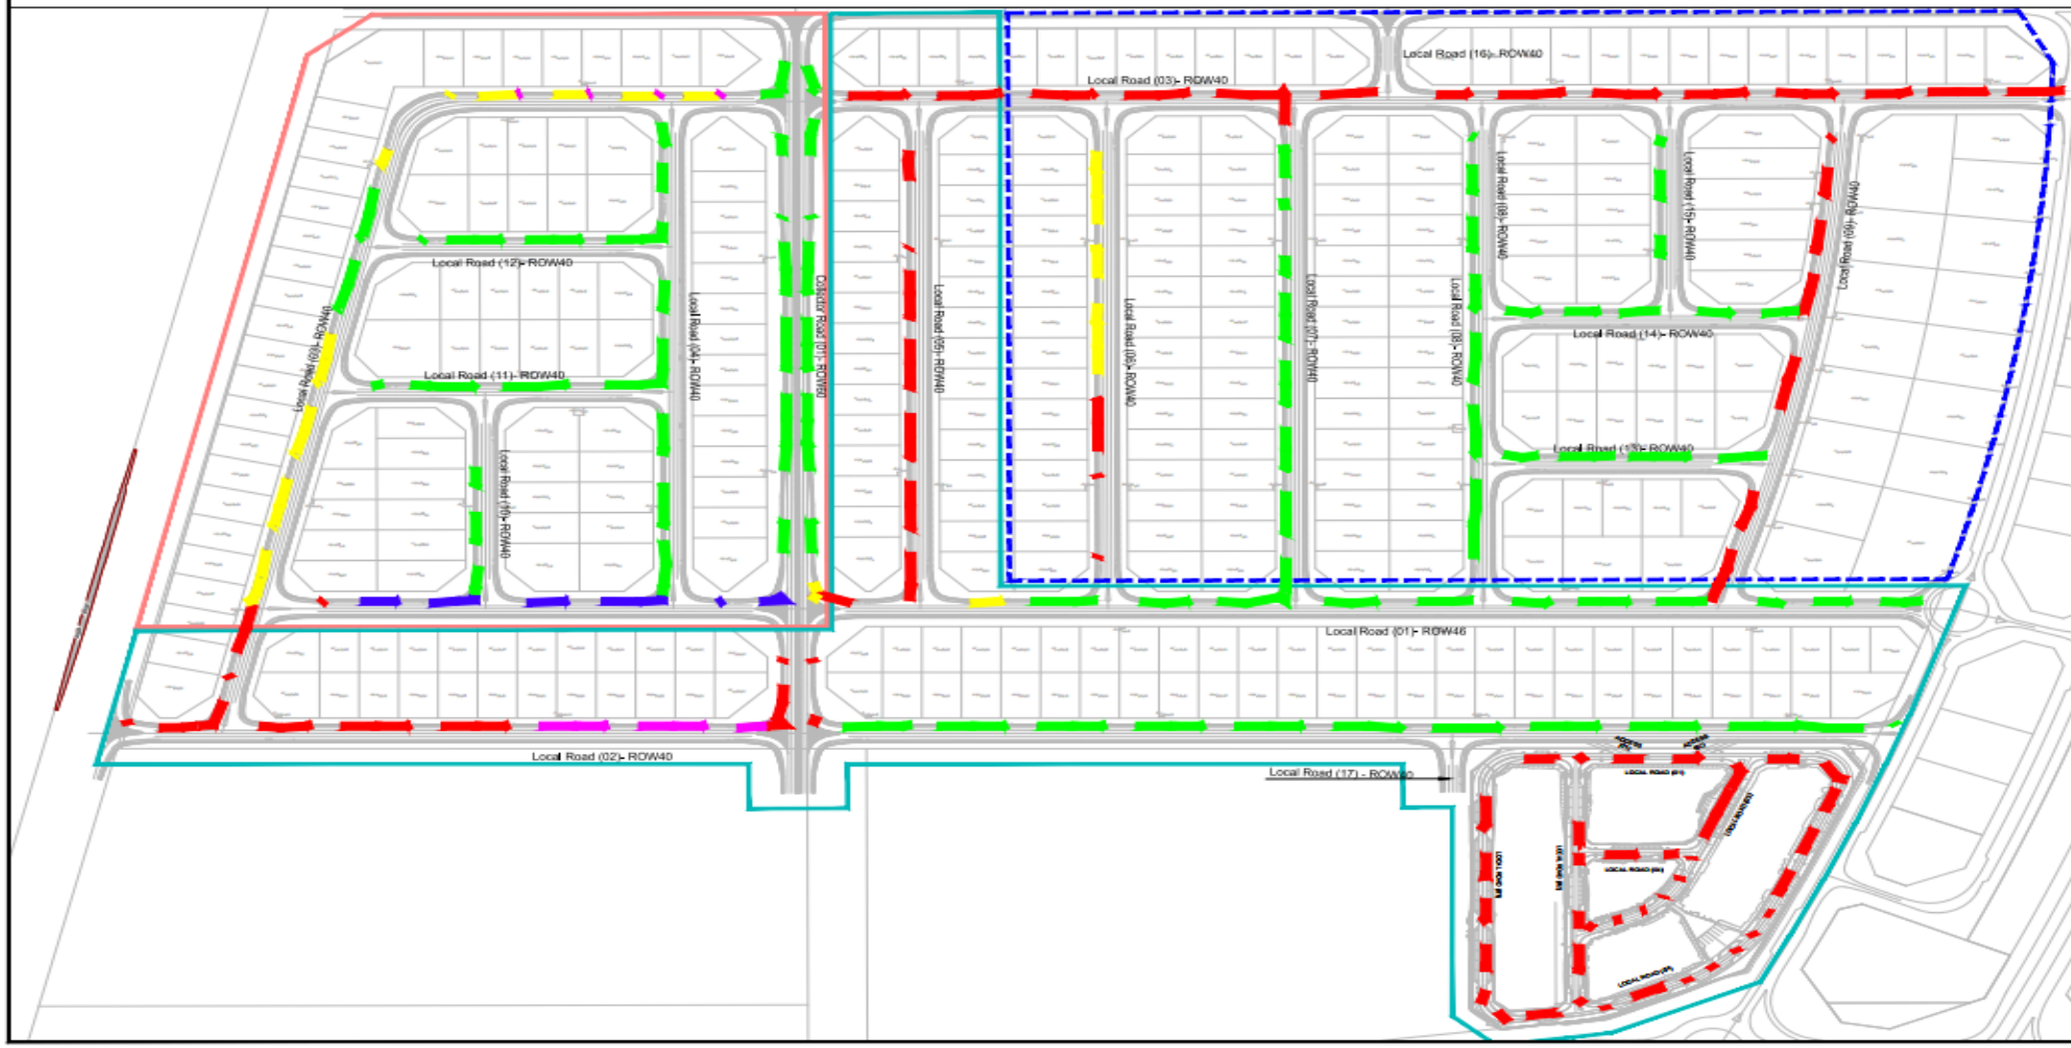

KEY PLAN



Legend

- Excavation
- Bedding
- Installation
- Backfilling
- Remaining

REFERENCE DRAWINGS

REVISIONS TABLE

PURPOSE OF ISSUE: FOR APPROVAL

MODON

egis

MOFARREH GROUP

STORM SECONDARY NETWORK ZONE -A

SCALE 1:1000

SHEET

SECONDARY STORM NETWORK PROGRESS LAYOUT ZONE-B

ZONE B (Storm Secondary) Pipes				
ITEM	Total Quantity (LM)	Excuted Quantity (LM)	Remaining Quantity (LM)	Percentage %
Excavation	5322.62	3259.231	2063.389	61.23%
Bedding	5322.62	3199.833	2122.788	60.12%
Installation	5322.62	3070.052	2252.568	57.68%
Backfilling	5322.62	739.601	4583.019	13.90%



KEY PLAN



Legend

- Excavation
- Bedding
- Installation
- Backfilling
- Remaining

REFERENCE DRAWINGS

REVISIONS TABLE

PURPOSE OF ISSUE: FOR APPROVAL

MODON

egis

MOFARREH GROUP
ENGINEERING & CONSTRUCTION

STORM DRAINAGE SYSTEM


STORM DRAINAGE SECONDARY LAYOUT PLAN ZONE B

SCALE

SHEET

SECONDARY STORM CATCH BASIN PROGRESS LAYOUT ZONE-A

ZONE A (Catch Basin)				
ITEM	Total Quantity (EA)	Executed Quantity (EA)	Remaining Quantity (EA)	Percentage %
Excavation	416	221	195	53.13%
Blinding	416	205	211	49.28%
Installation	416	203	213	48.77%
Backfilling	416	106	310	25.48%

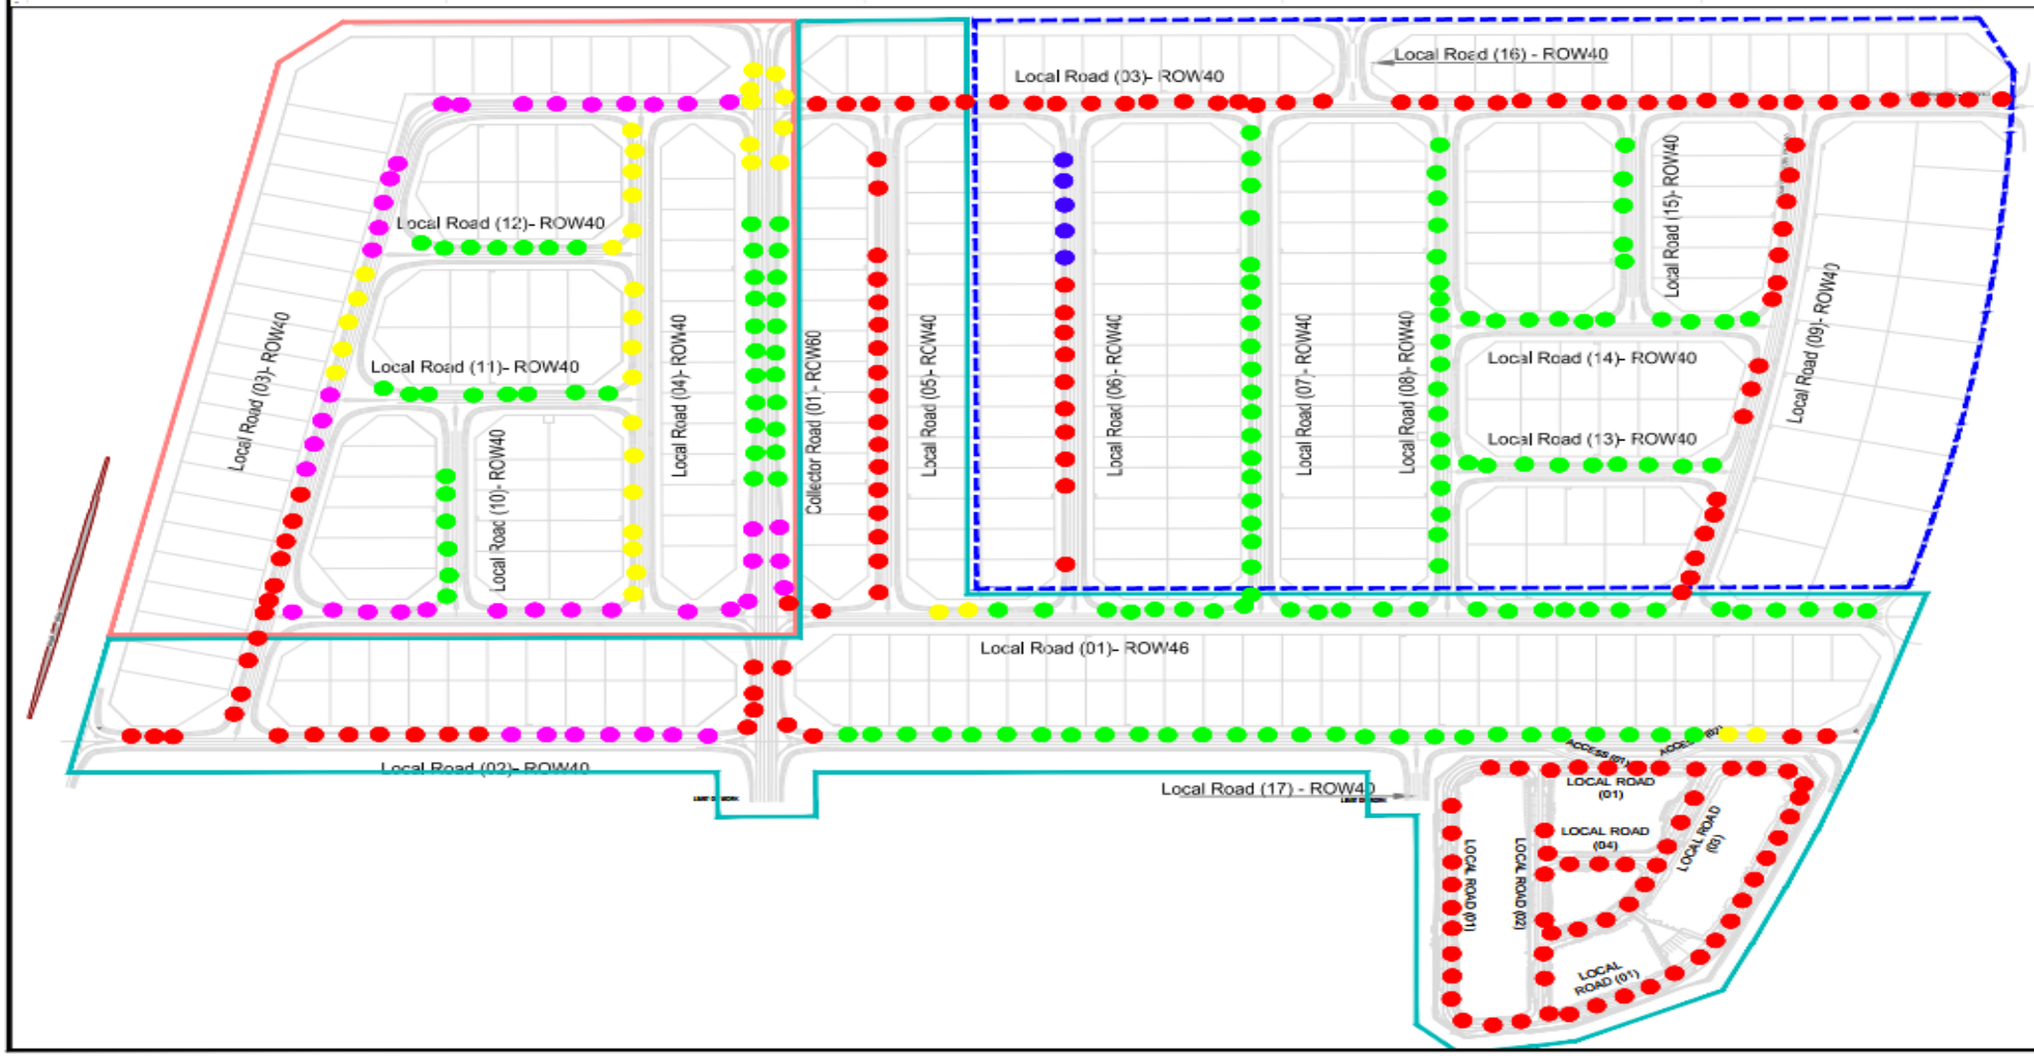



Legend

- Excavation
- Blinding
- Installation
- Backfilling
- Remaining

REFERENCE DRAWINGS

REVISIONS TABLE


PURPOSE OF ISSUE: FOR APPROVAL

CATCH BASIN LAYOUT ZONE-A

SCALE 1:1000

SECONDARY STORM CATCH BASIN PROGRESS LAYOUT ZONE-B

STORM SECONDARY CATCH BASIN PROGRESS (ZONE B)				
ITEM	Total Quantity (EA)	Executed Quantity (EA)	Remaining Quantity (EA)	Percentage %
Excavation	257	157	100	61.09%
Blinding	257	155	102	60.31%
Installation	257	179	78	69.49%
Backfilling	257	58	199	22.57%

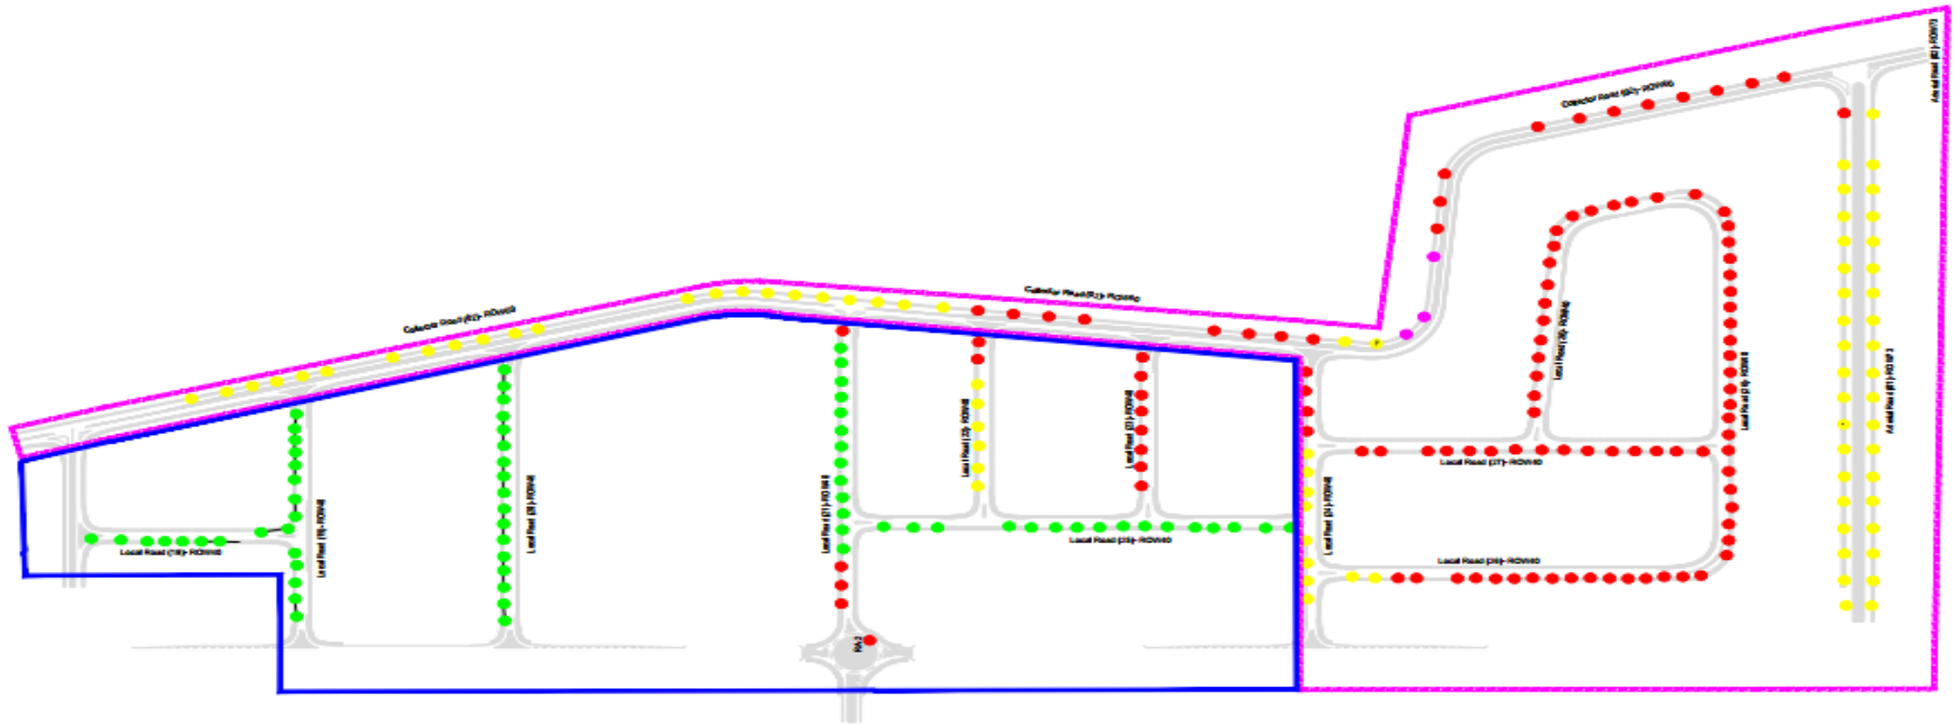

KEY PLAN



Legend

- Excavation
- Blinding
- Installation
- Backfilling
- Remaining

REFERENCE DRAWINGS

REVISIONS TABLE

PURPOSE OF ISSUE: FOR APPROVAL

egis

MOFARREH GROUP

STORM DRAINAGE SECONDARY LAYOUT PLAN ZONE B

SCALE


SHEET

STORM NETWORK PROCUREMENT PROGRESS LAYOUT (ZONE-A,B & LABOUR CAMP)

Storm Network materials status							
SR	MATERIAL	UNIT	TOTAL QTY	DELIVERED QTY	% DELIVERED	REMAINING QTY	% REMIAINING
1	GRP PIPE DIA 400 mm	L.M	12,011.00	9,790.00	81.51%	2,221.00	18.49%
2	GRP PIPE DIA 800 mm	L.M	1,850.00	1,572.00	84.97%	278.00	15.03%
3	GRP PIPE DIA 500 mm	L.M	1,225.00	1,836.00	149.88%	-611.00	-49.88%
4	GRP PIPE DIA 600 mm	L.M	2,578.00	2,796.00	108.46%	-218.00	-8.46%
5	GRP PIPE DIA 700 mm	L.M	1,245.00	1,064.00	85.46%	181.00	14.54%
6	GRP PIPE DIA 900 mm	L.M	870.00	754.00	86.67%	116.00	13.33%
7	GRP PIPE DIA 1000 mm	L.M	765.00	568.00	74.25%	197.00	25.75%
8	GRP PIPE DIA 1200 mm	L.M	1,690.00	1,690.00	100.00%	0.00	0.00%
9	Storm Manhole	EA	298.00	294.00	98.66%	4.00	1.34%
10	Box culvert	EA (2.5 M)	264.00	264.00	100.00%	0.00	0.00%
11	Box Conduit	EA (2.5 M)	799.00	298.00	37.30%	501.00	62.70%
12	Catch basin	EA	668.00	610.00	91.32%	58.00	8.68%
13	UPVC pipe dia 200 mm	L.M	1,818.00	1,500.00	82.51%	318.00	17.49%
14	UPVC pipe dia 300 mm	L.M	13,375.00	12,335.00	92.22%	1,040.00	7.78%
15	UPVC pipe dia 400 mm	L.M	915.00	738.00	80.66%	177.00	19.34%
16	Warning tape	Roll	900.00	450.00	50.00%	450.00	50.00%
17	DI COVERS FOR STORM MANHOLE & CATCH BASIN	EA	966.00	417.00	43.17%	549.00	56.83%

POTABLE WATER NETWORK PROGRESS LAYOUT ZONE-A

(TSE) PIPE PROGRESS ZONE A				
ITEM	Total Quantity (LM)	Excuted Quantity (LM)	Remaining Quantity (LM)	Percentage %
Excavation	13023	175.000	12848.000	1.34%
Bedding	13023	155.000	12868.000	1.19%
Installation	13023	130.000	12893.000	1.00%
Backfilling	13023	0.000	13023.000	0.00%

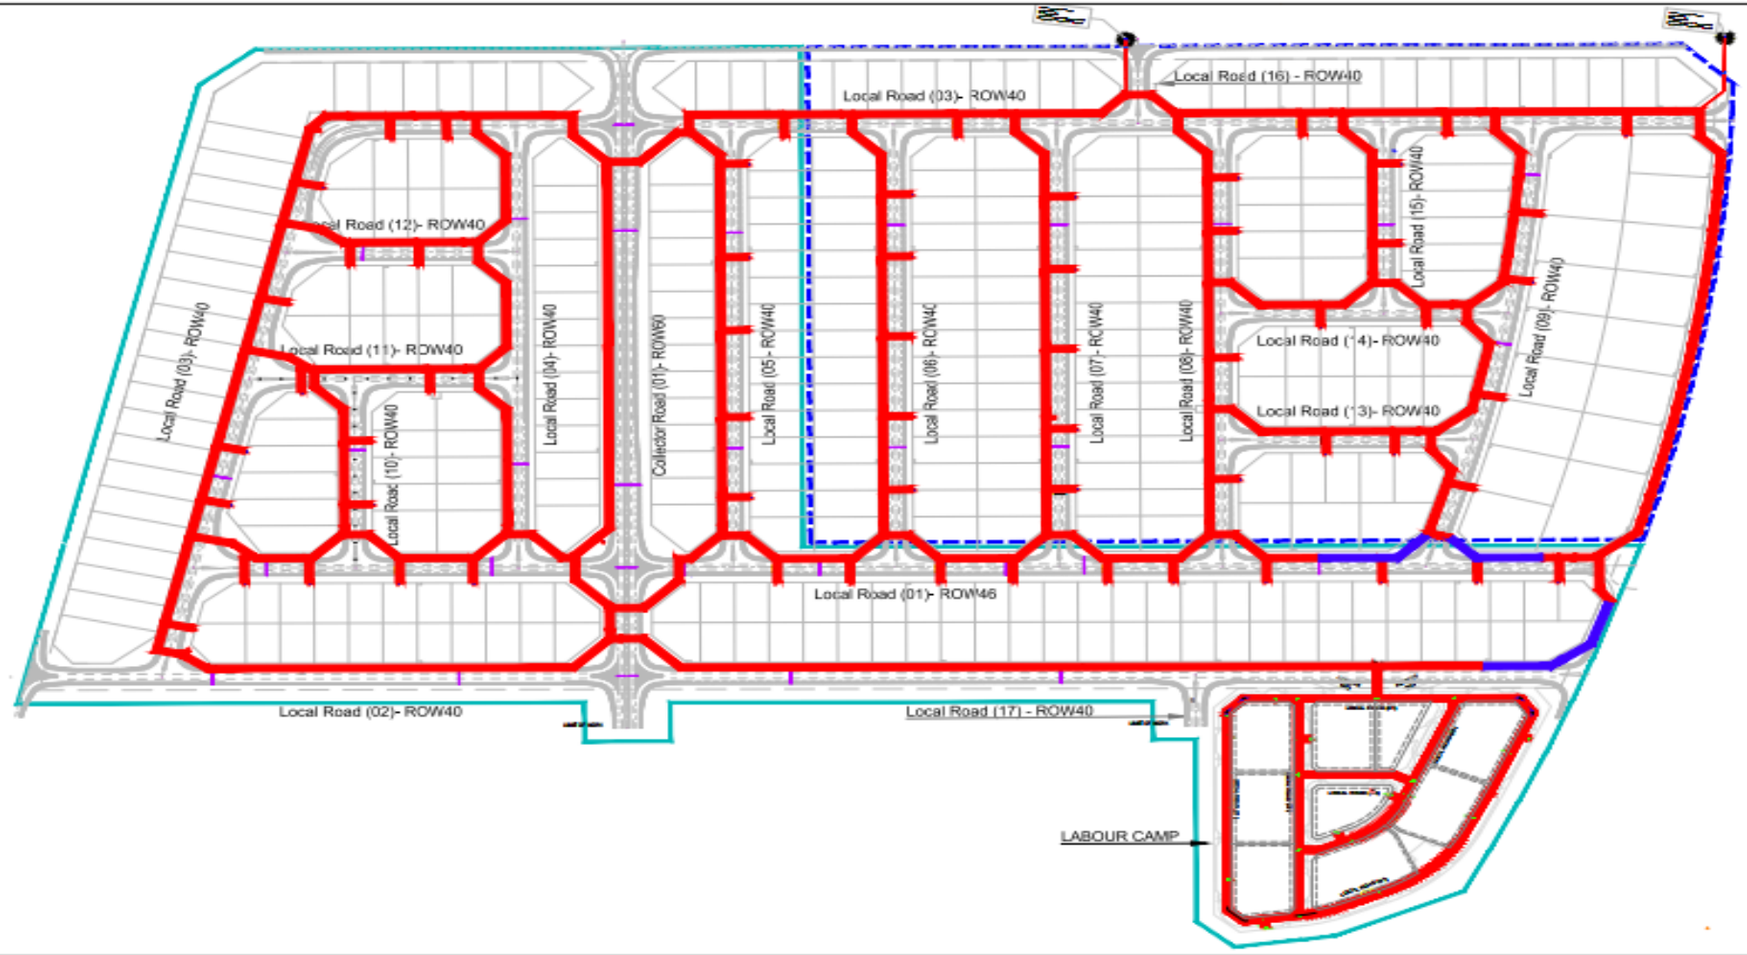

KEY PLAN



Legend

- Excavation
- Base Installation
- Backfilling
- Remaining

REFERENCE DRAWINGS

REVISIONS TABLE

PURPOSE OF ISSUE: FOR APPROVAL

MODON

egis


MOFARREH GROUP


TSE PROGRESS LAYOUT ZONE-A

SCALE 1:1000

POTABLE WATER NETWORK PROGRESS LAYOUT ZONE-B

ZONE B (Potable) Pipes				
ITEM	Total Quantity (LM)	Excuted Quantity (LM)	Remaining Quantity (LM)	Percentage %
Excavation	10308.00	6209.33	4098.67	60.24%
Bedding	10308.00	6184.33	4123.67	60.00%
Installation	10308.00	6184.33	4123.67	60.00%
Backfilling	10308.00	1675.00	8633.00	16.25%

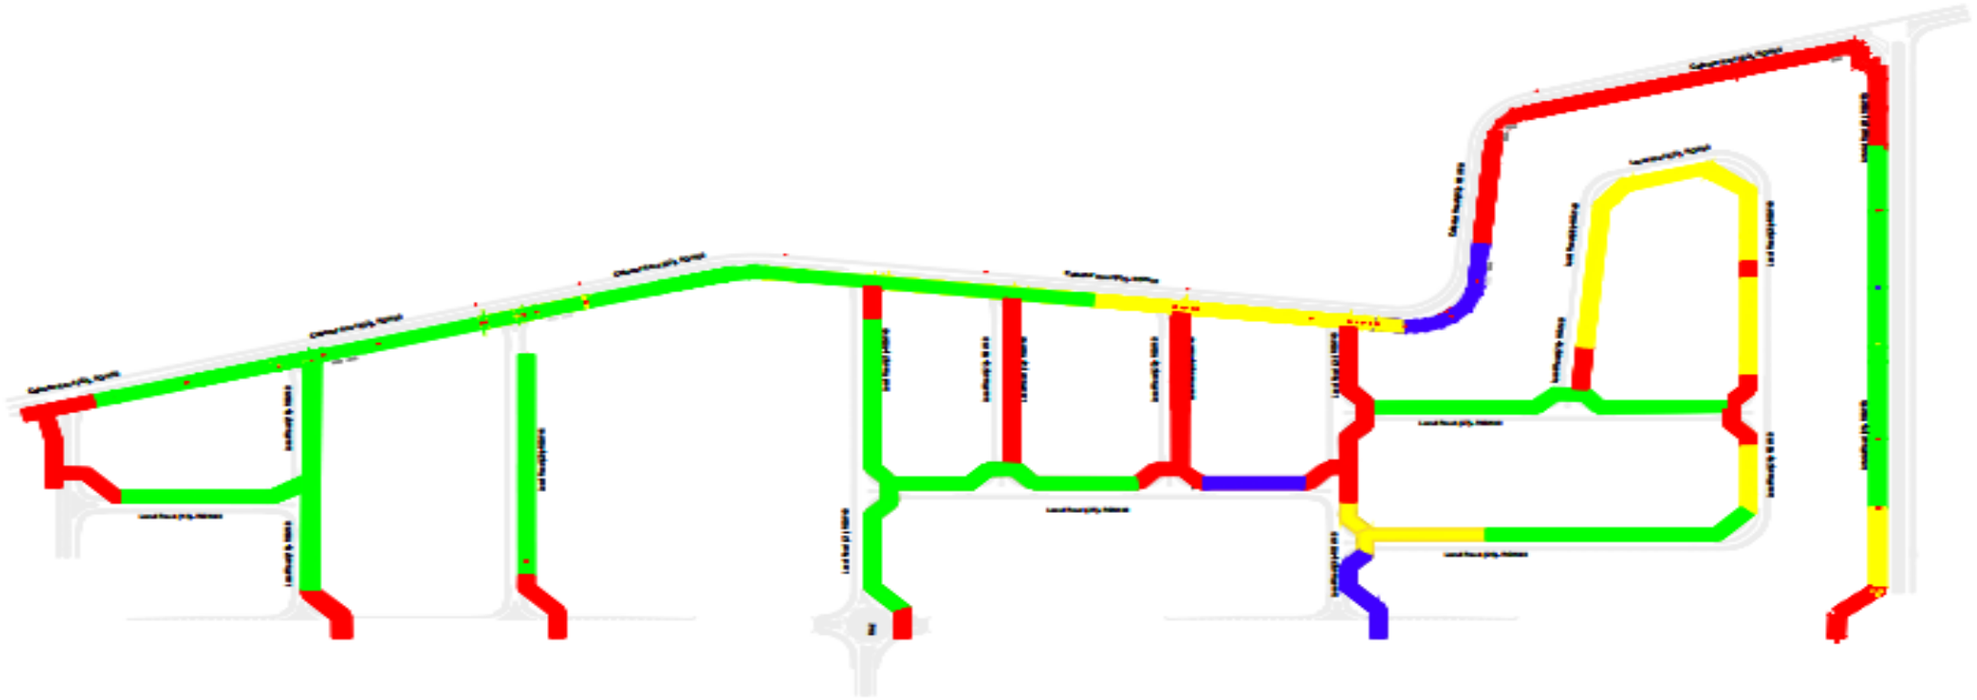

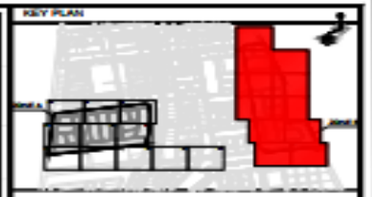


Legend

- Excavation
- Bedding
- Installation
- Backfilling
- Remaining

POTABLE FIRE HYDRANT PROGRESS LAYOUT ZONE-A

ZONE A FireHydrant Progress				
ITEM	Total Quantity (EA)	Excuted Quantity (LM)	Remaining Quantity (LM)	Percentage %
Excavation	170	13	157	7.65%
Blinding	170	2	168	1.18%
Installation	170	3	167	1.76%
Backfilling	170	2	168	1.18%

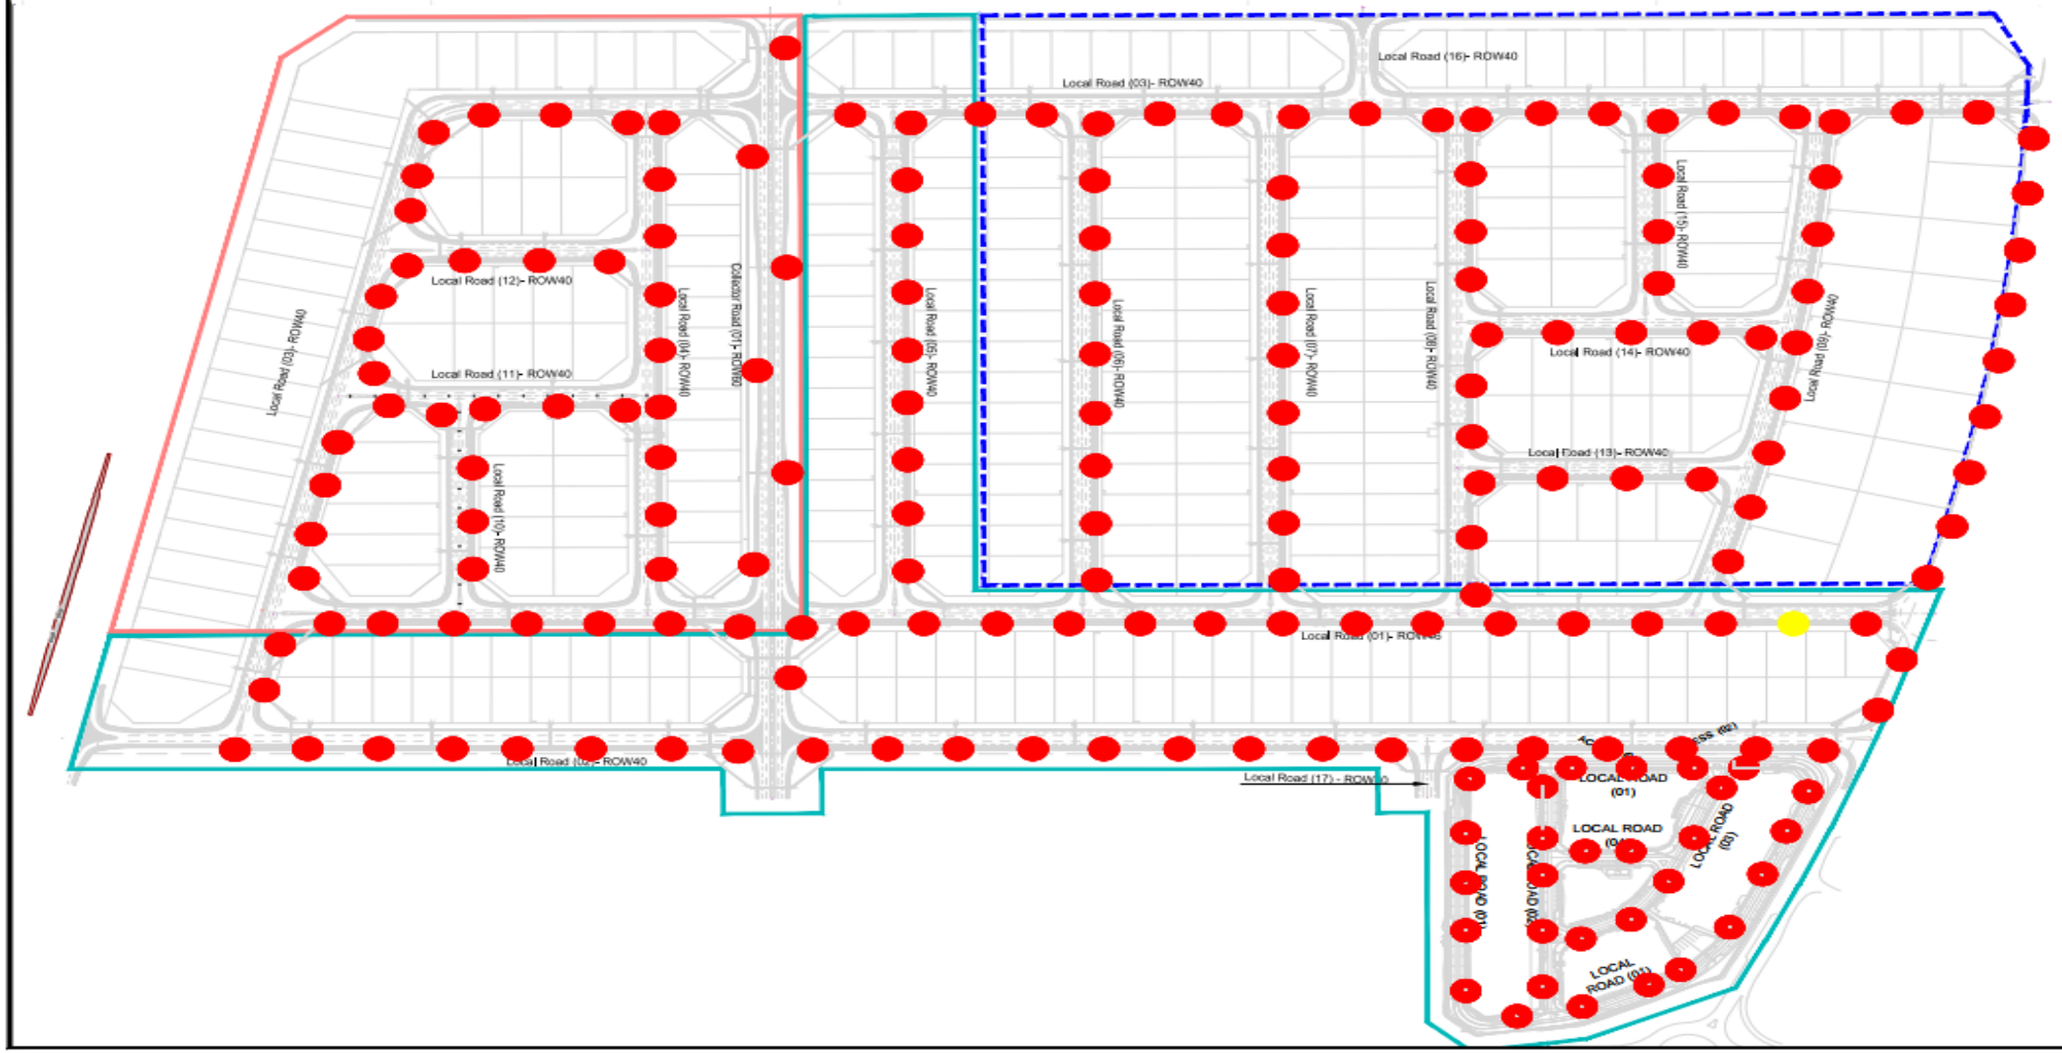

KEY PLAN



Legend

- Excavation
- Blinding
- Installation
- Backfilling
- Remaining

REFERENCE DRAWINGS

REVISIONS TABLE

PURPOSE OF ISSUE: FOR APPROVAL



FIRE HYDRANT LAYOUT ZONE-A

SCALE 1:1000


SHEET

POTABLE FIRE HYDRANT PROGRESS LAYOUT ZONE-B

ZONE B FireHydrant Progress				
ITEM	Total Quantity (EA)	Excuted Quantity	Remaining Quantity (LM)	Percentage %
Excavation	110.00	4	106	3.64%
Blinding	110.00	4	106	3.64%
Installation	110.00	4	106	3.64%
Backfilling	110.00	0	110	0.00%

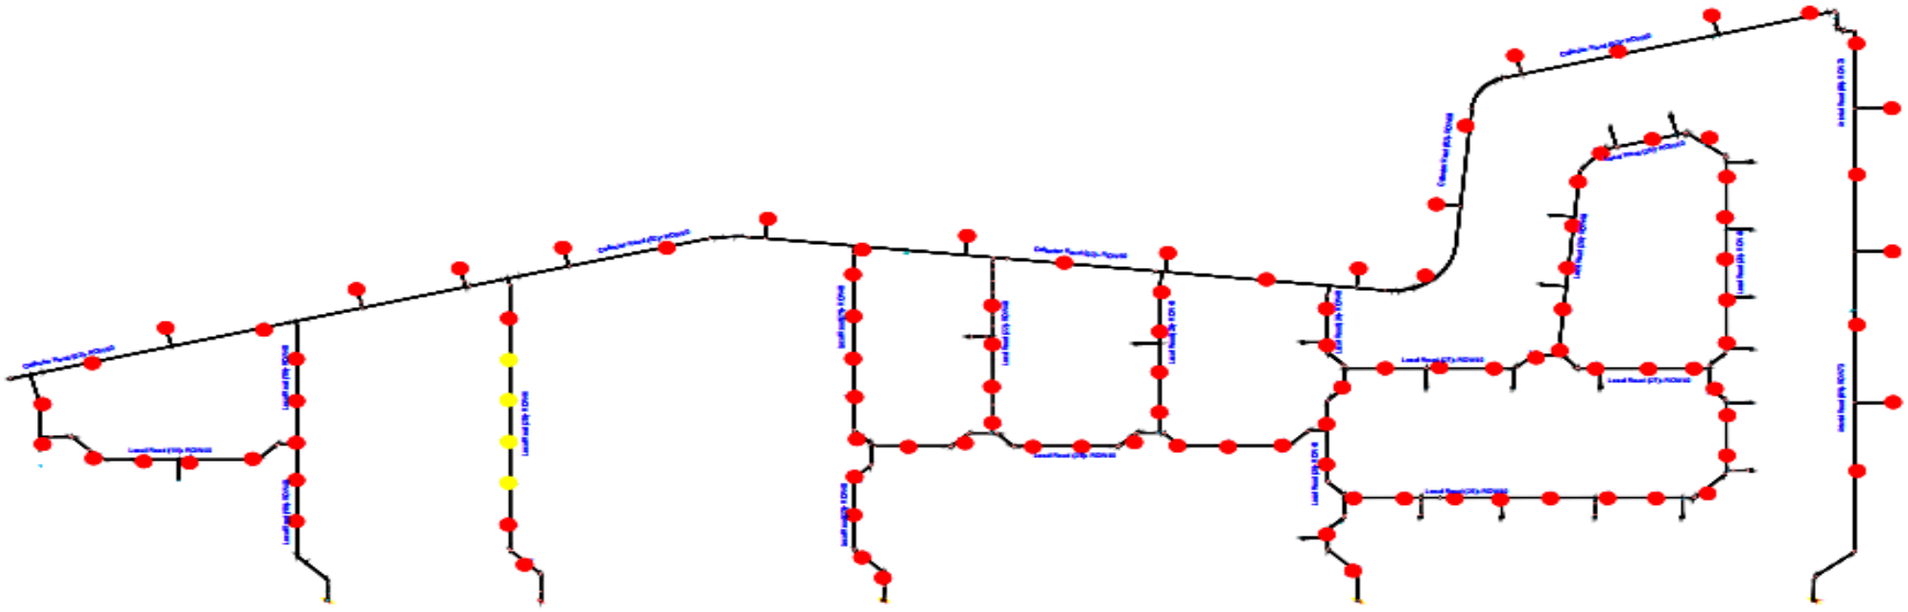

KEY PLAN

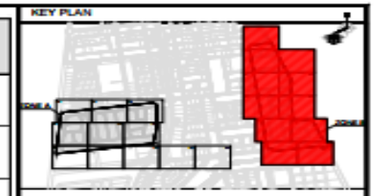

Legend

- Excavation
- Blinding
- Installation
- Backfilling
- Remaining

REFERENCE DRAWINGS

REVISIONS TABLE

PURPOSE OF ISSUE: FOR APPROVAL


POTABLE SYSTEM


POTABLE LAYOUT PLAN ZONE B

SCALE

SHEET

TSE WATER NETWORK PROGRESS LAYOUT ZONE-A

(TSE) PIPE PROGRESS ZONE A				
ITEM	Total Quantity (LM)	Excuted Quantity (LM)	Remaining Quantity (LM)	Percentage %
Excavation	13023	175.000	12848.000	1.34%
Bedding	13023	155.000	12868.000	1.19%
Installation	13023	130.000	12893.000	1.00%
Backfilling	13023	0.000	13023.000	0.00%

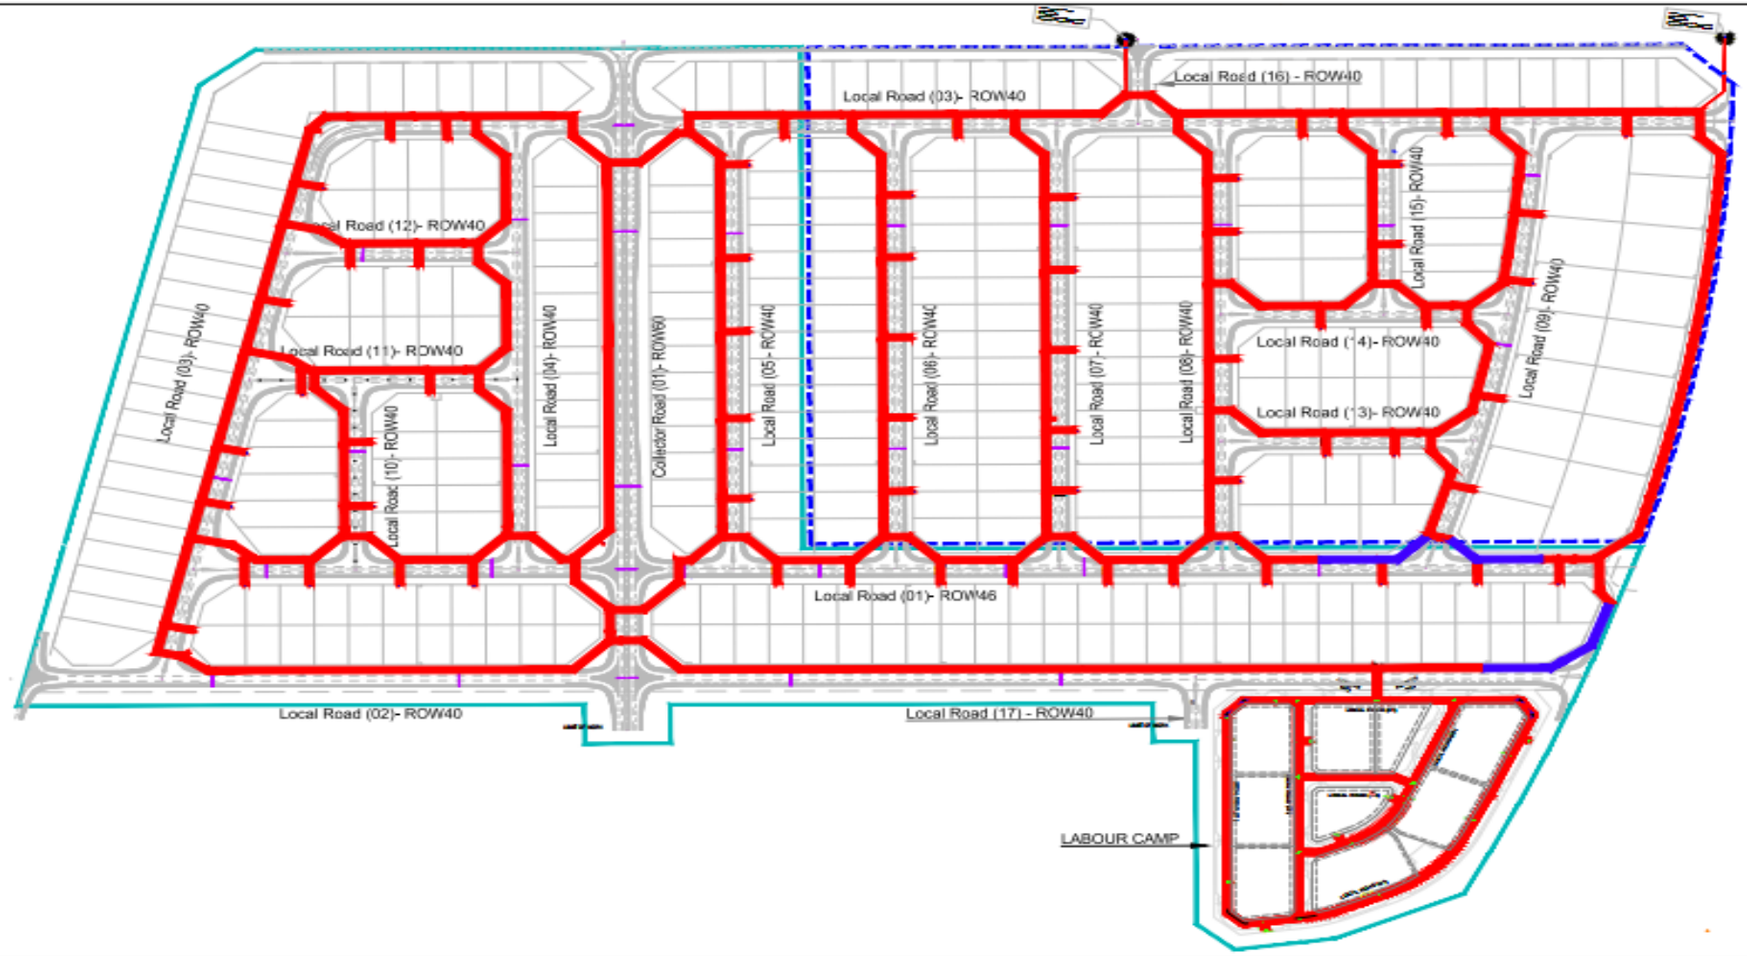

KEY PLAN



Legend

- Excavation
- Base Installation
- Backfilling
- Remaining

REFERENCE DRAWINGS

REVISIONS TABLE

PURPOSE OF ISSUE: FOR APPROVAL

MODON

egis


MOFARREH GROUP

SCALE

DATE

TSE WATER NETWORK PROGRESS LAYOUT ZONE-B

(TSE) PIPE PROGRESS ZONE B				
ITEM	Total Quantity (LM)	Excuted Quantity (LM)	Remaining Quantity (LM)	Percentage %
Excavation	10991	4090.780	6900.220	37.22%
Bedding	10991	4090.780	6900.220	37.22%
Installation	10991	3946.780	7044.220	35.91%
Backfilling	10991	2770.780	8220.220	25.21%

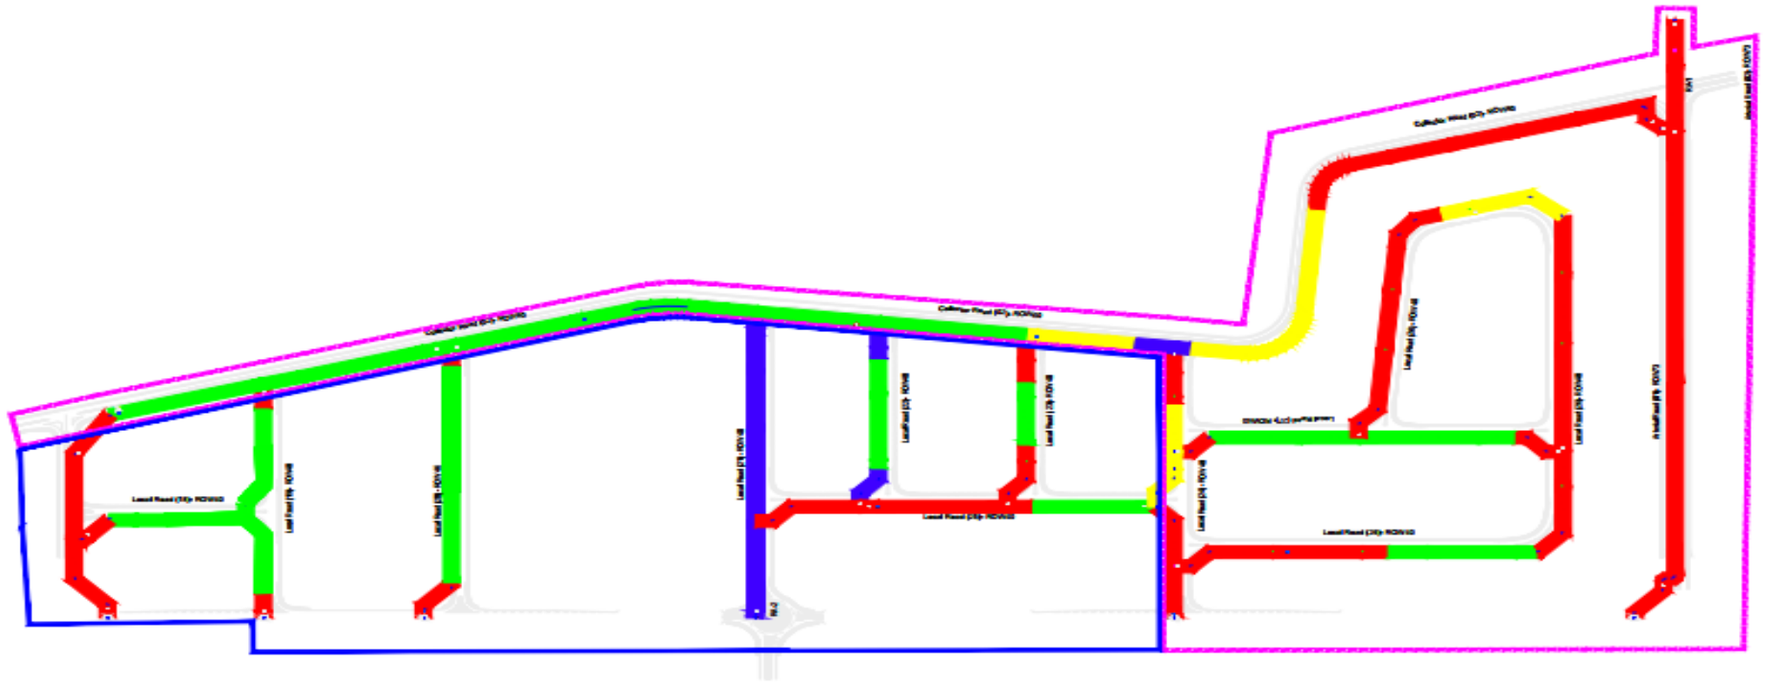

KEY PLAN



Legend

- Excavation
- Bedding
- Installation
- Backfilling
- Remaining

REFERENCE DRAWINGS

REVISIONS TABLE

PURPOSE OF ISSUE: FOR APPROVAL


MODON

egis

MOFARREH GROUP

SCALE:

CROSSING PROGRESS LAYOUT-ZONE A

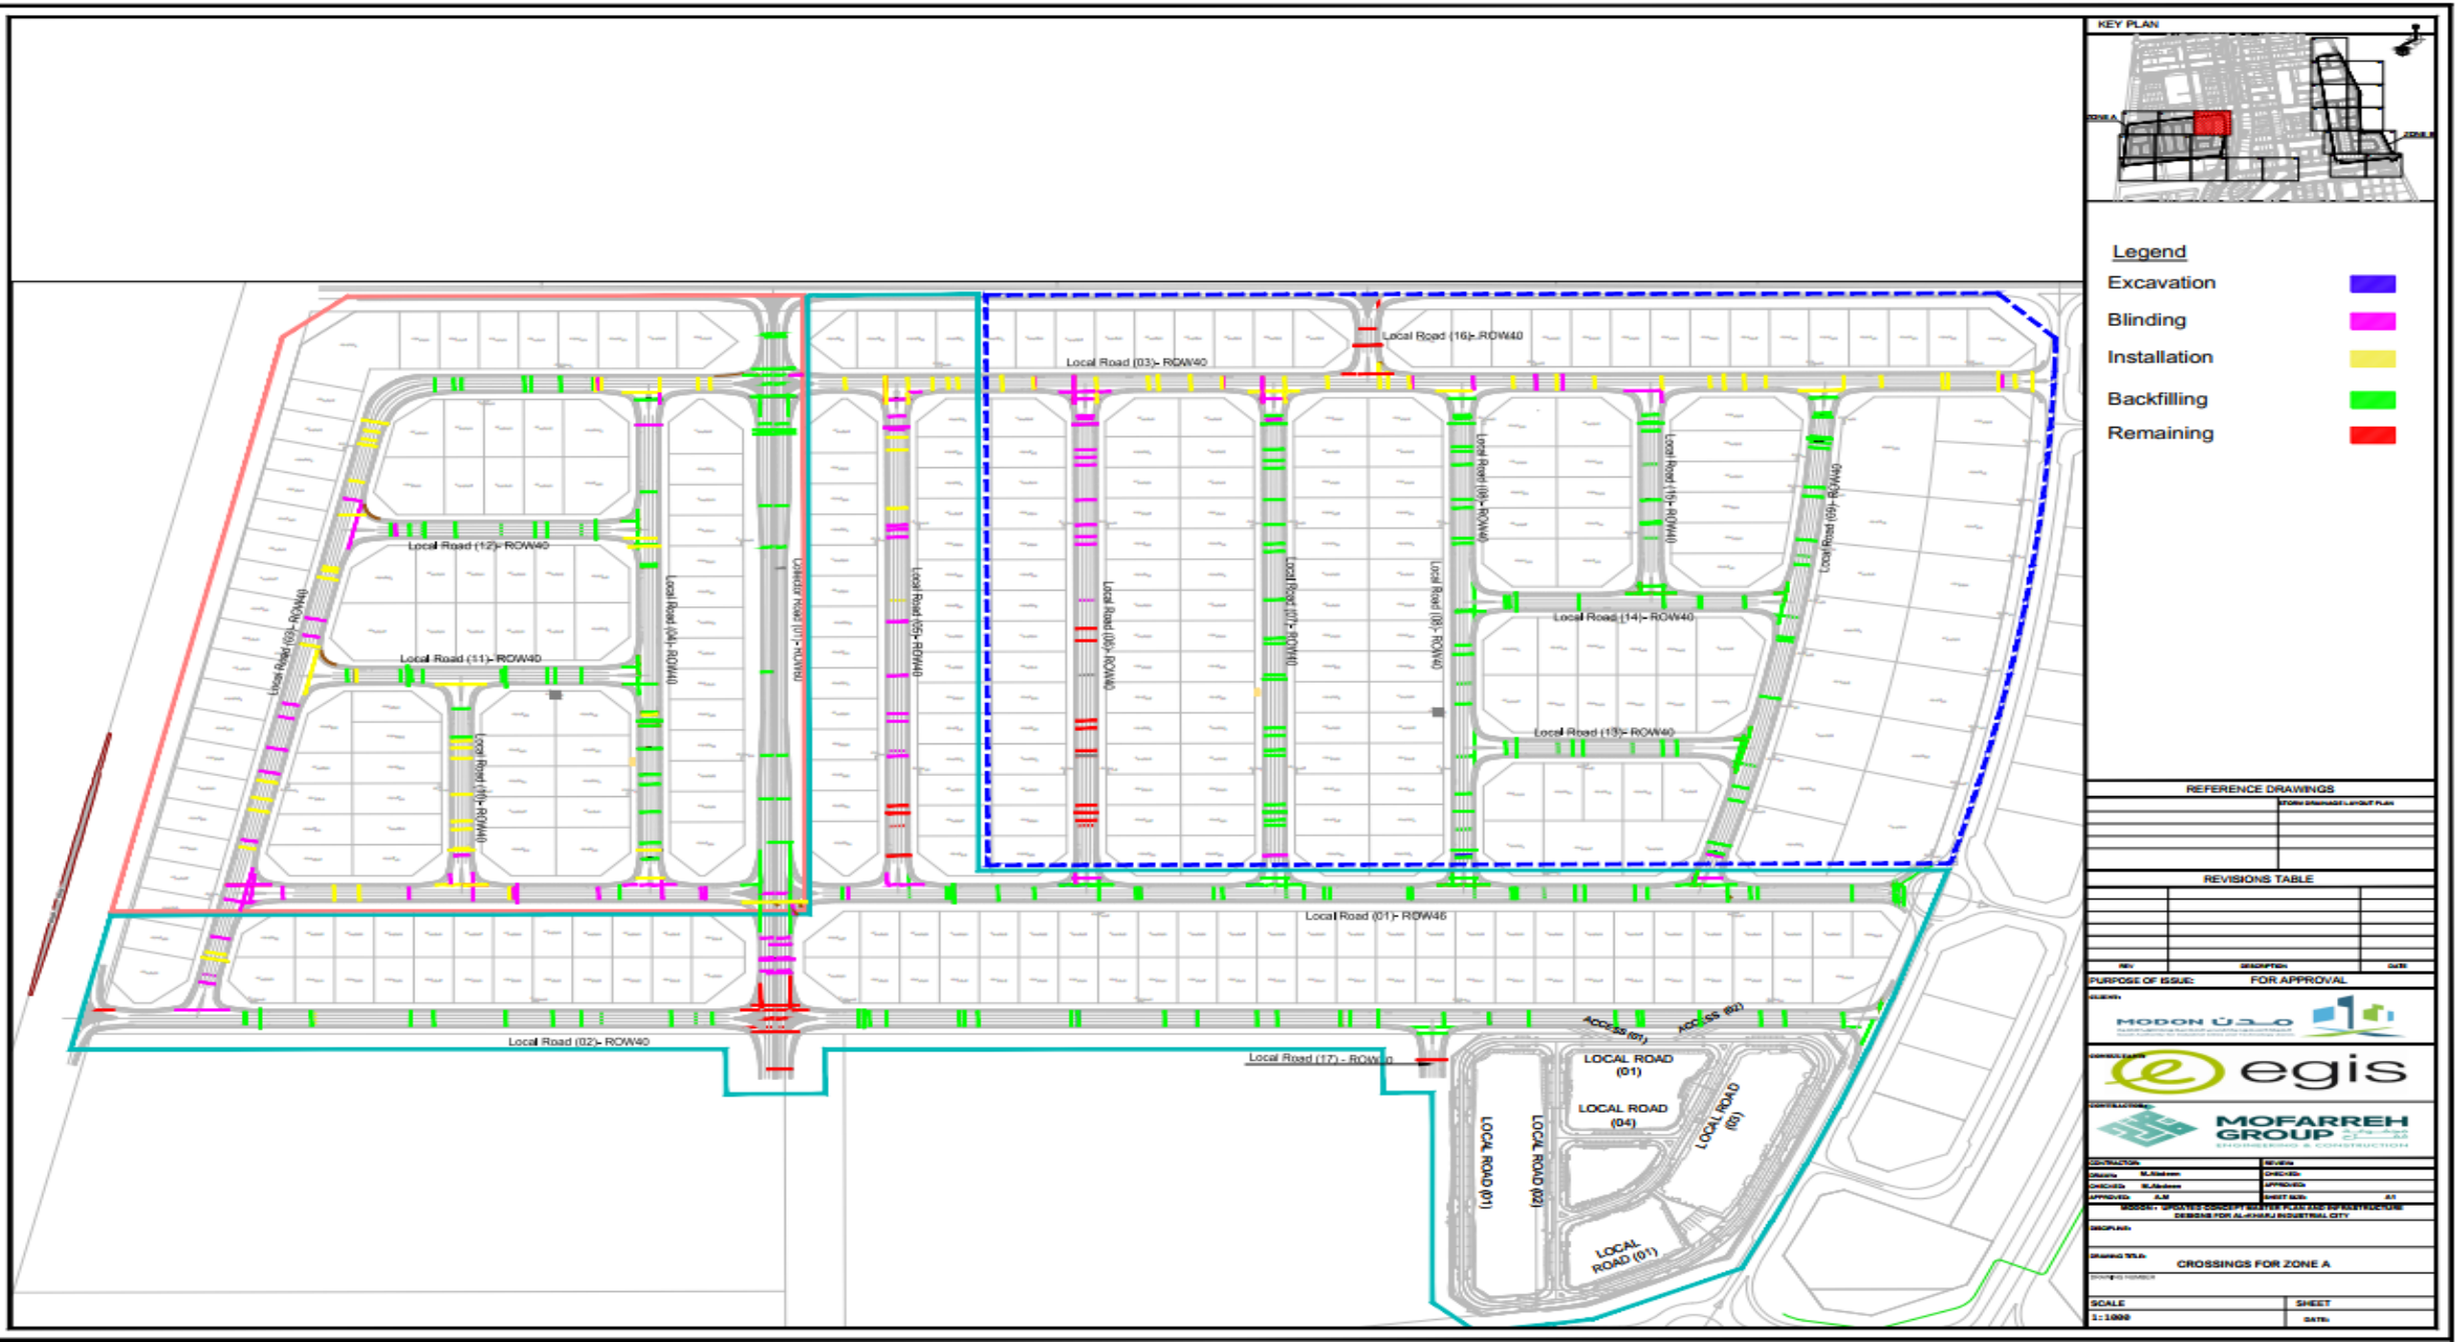

KEY PLAN

Legend

- Excavation
- Blinding
- Installation
- Backfilling
- Remaining

REFERENCE DRAWINGS

	STORM DRAINAGE LAYOUT PLAN

REVISIONS TABLE

REV.	DESCRIPTION	DATE

PURPOSE OF ISSUE: FOR APPROVAL

CONTRACTOR: MOFARREH GROUP

DESIGN:	M. Abdelmoez	CHECKED:	
CHECKED:	M. Abdelmoez	APPROVED:	
APPROVED:	A.M	SHEET SIZE:	A1

MODON - UPDATED CONCEPT MASTER PLAN AND RE-TENDERING DESIGNS FOR AL-KHARJ INDUSTRIAL CITY

DISCIPLINE:


DRAWING TITLE: CROSSINGS FOR ZONE A

DRAWING NUMBER:

SCALE	SHEET
1:1000	


DATE:

CROSSING PROGRESS LAYOUT ZONE-B

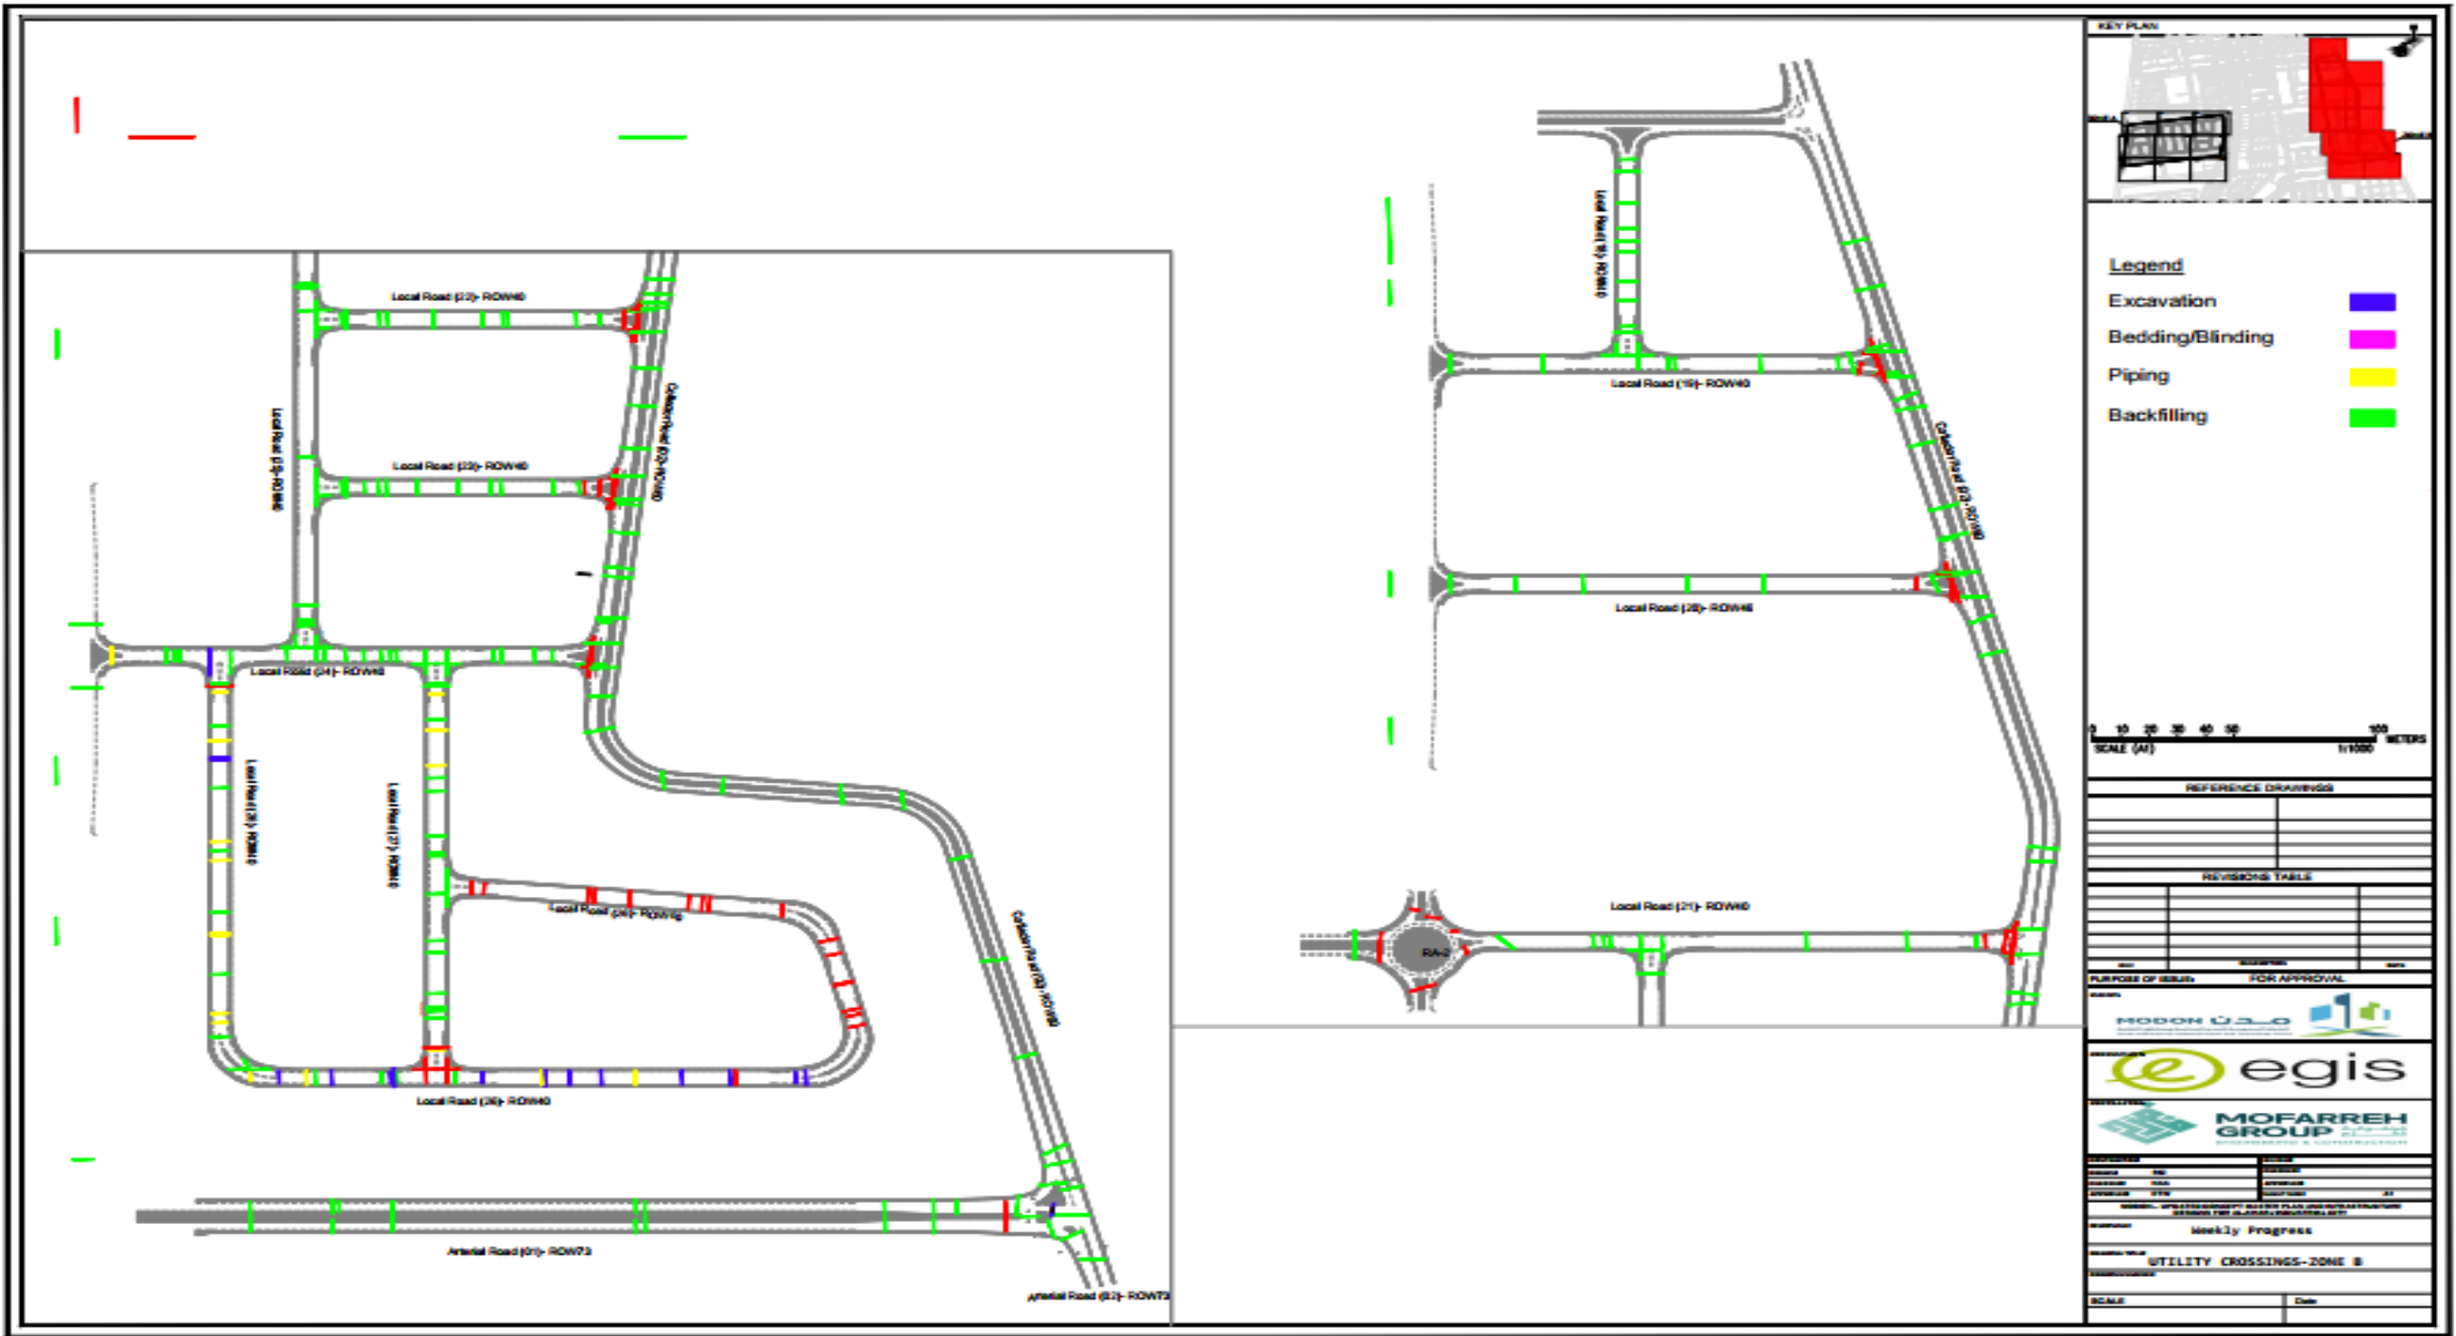

CURBSTONE PROGRESS LAYOUT ZONE-A

ZONE A (Curbstone)				
ITEM	Total Quantity (LM)	Excuted Quantity (LM)	Remaining Quantity (LM)	Percentage %
Excavation	81,767.97	3734.320	78033.650	4.57%
Blinding	81,767.97	1041.000	80726.970	1.27%
Installation	81,767.97	1041.000	80726.970	1.27%

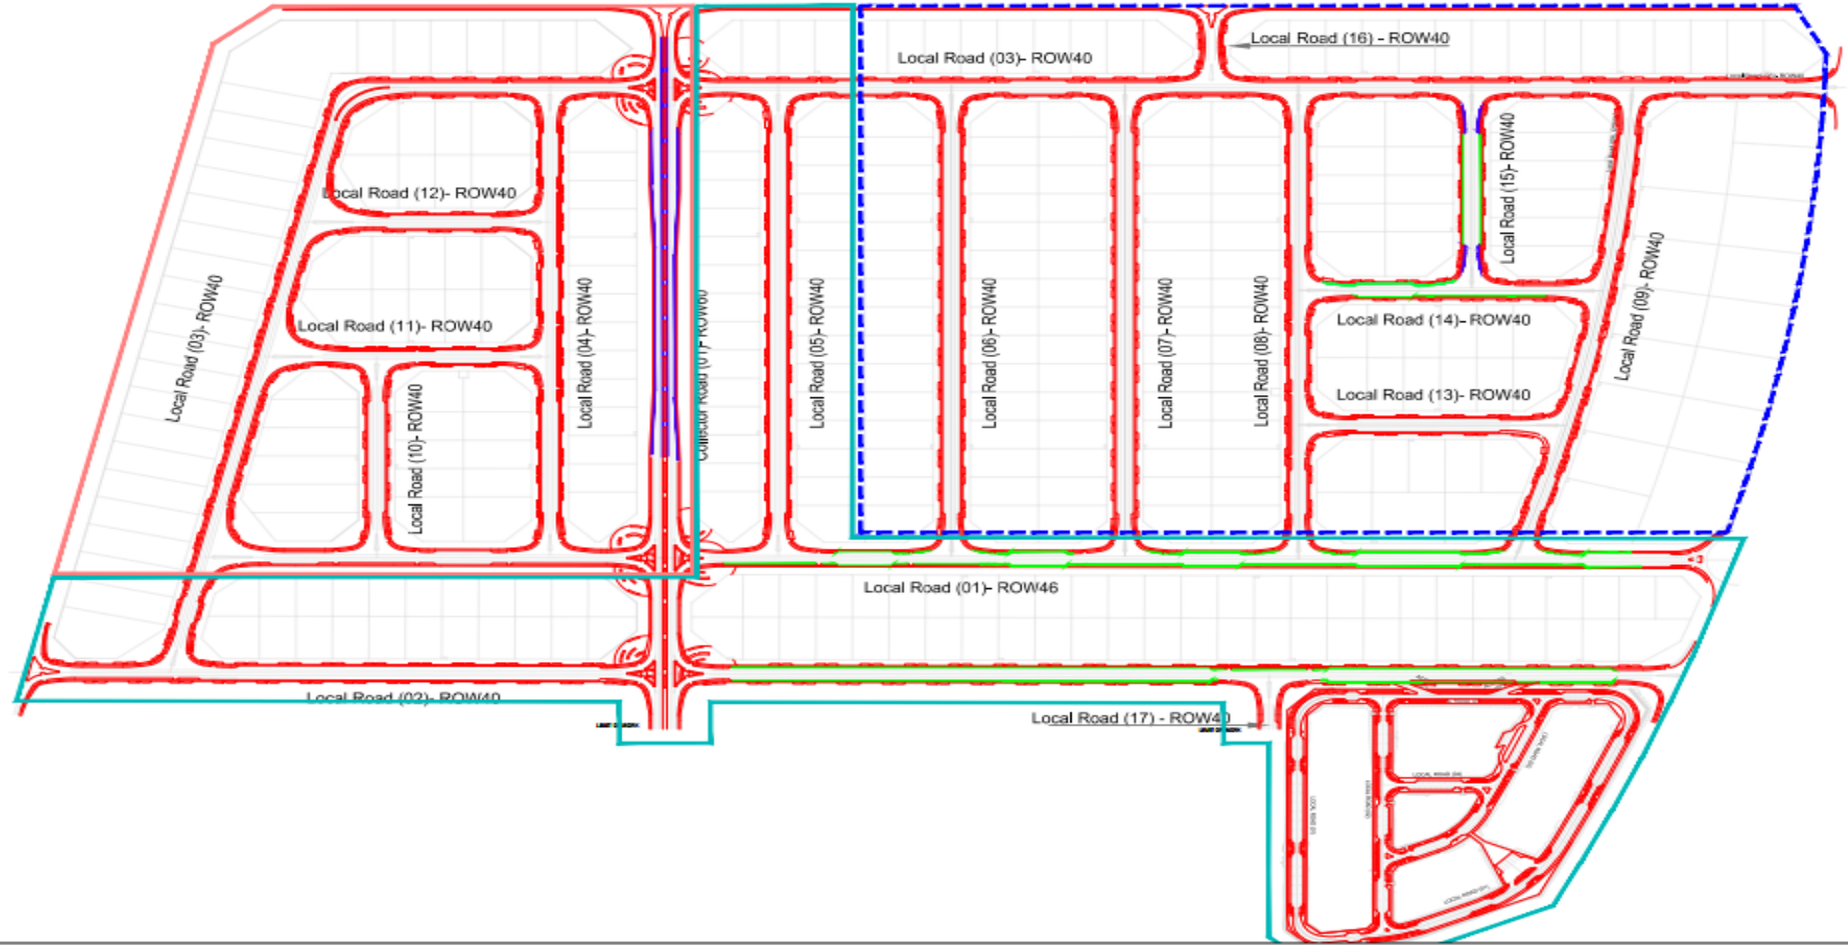



Legend

- Excavation
- Blinding
- Installation
- Remaining

0 10 20 30 40 50 100 METERS
SCALE (A1) 1:1000

REFERENCE DRAWINGS

REVISIONS TABLE

PURPOSE OF ISSUE: FOR APPROVAL


Weekly Progress


CURBSTONE PROGRESS LAYOUT-ZONE A

SCALE 1:1000

CURBSTONE PROGRESS LAYOUT ZONE-B

ZONE B (Curbstone)				
ITEM	Total Quantity (LM)	Excuted Quantity (LM)	Remaining Quantity (LM)	Percentage %
Excavation	74,108.65	4332.563	69776.087	5.85%
Blinding	74,108.65	4332.563	69776.087	5.85%
Installation	74,108.65	4332.563	69776.087	5.85%

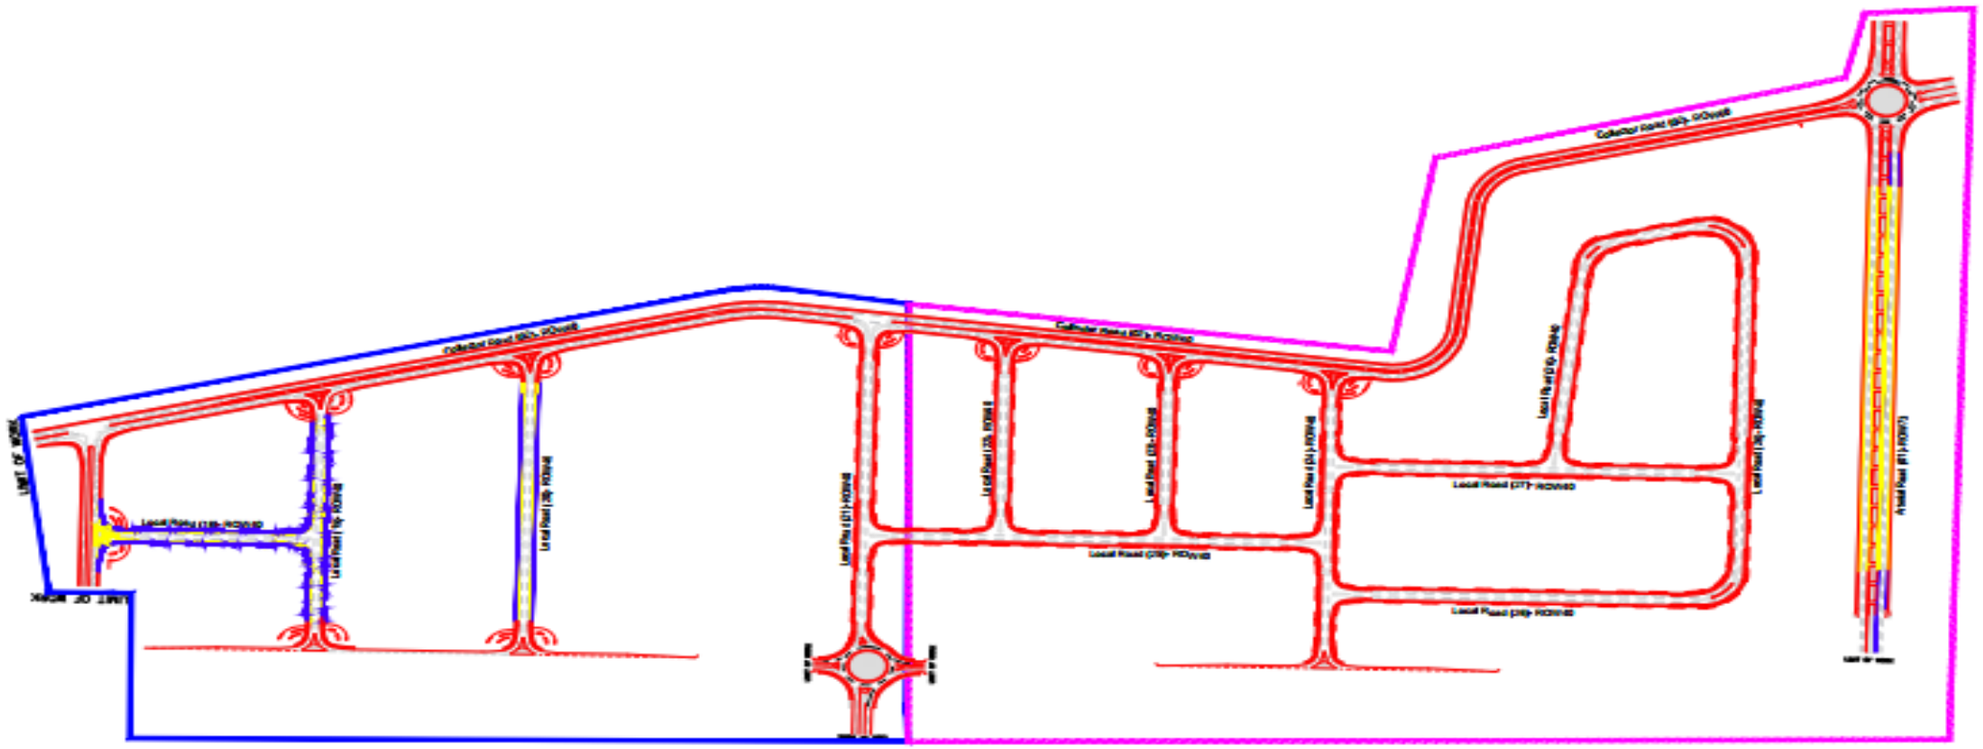

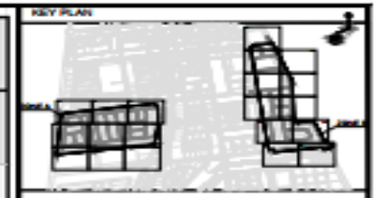

Legend

Excavation

Blinding

Installation

Remaining

REFERENCE DRAWINGS

REVISIONS TABLE


PURPOSE OF ISSUE: FOR APPROVAL

Weekly Progress

CURBSTONE LAYOUT-ZONE B

INTERLOCK PROGRESS LAYOUT ZONE-A

ZONE A (Interlock)				
ITEM	Total Quantity (SQ.M)	Excuted Quantity (SQ.M)	Remaining Quantity (SQ.M	Percentage %
Backfilling	71,537.70	0.000	71537.701	0.00%
Bedding	71,537.70	0.000	71537.701	0.00%
Installation	71,537.70	0.000	71537.701	0.00%

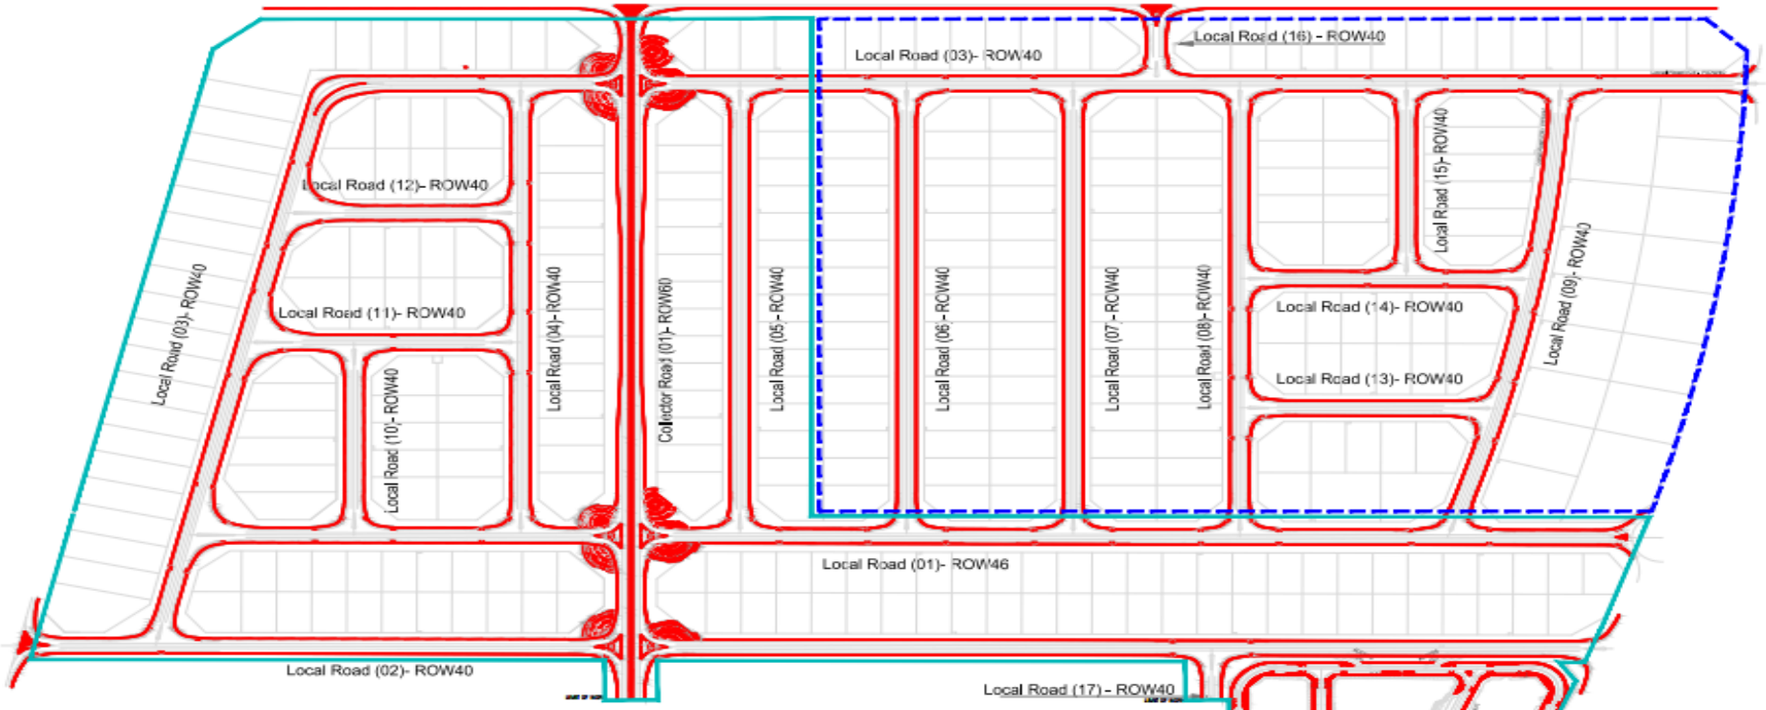

KEY PLAN



Legend

- Backfilling
- Bedding
- Installation
- Remaining

0 10 20 30 40 50 100 METERS
SCALE (A1) 1:1000

REFERENCE DRAWINGS

REVISIONS TABLE

REV	DESCRIPTION	DATE

PURPOSE OF ISSUE: FOR APPROVAL

MODON - UPDATED CONCEPT MASTER PLAN AND INFRASTRUCTURE DESIGNS FOR AL-KHARJ INDUSTRIAL CITY

Weekly Progress


CURBSTONE PROGRESS LAYOUT-ZONE A

SCALE 1:1000

Date 06/06/2026

INTERLOCK PROGRESS LAYOUT ZONE-B

ZONE B (Interlock)				
ITEM	Total Quantity (SQ.M)	Excuted Quantity (SQ.M)	Remaining Quantity (SQ.M)	Percentage %
Backfilling	68,821.68	0.000	68821.675	0.00%
Bedding	68,821.68	0.000	68821.675	0.00%
Installation	68,821.68	0.000	68821.675	0.00%

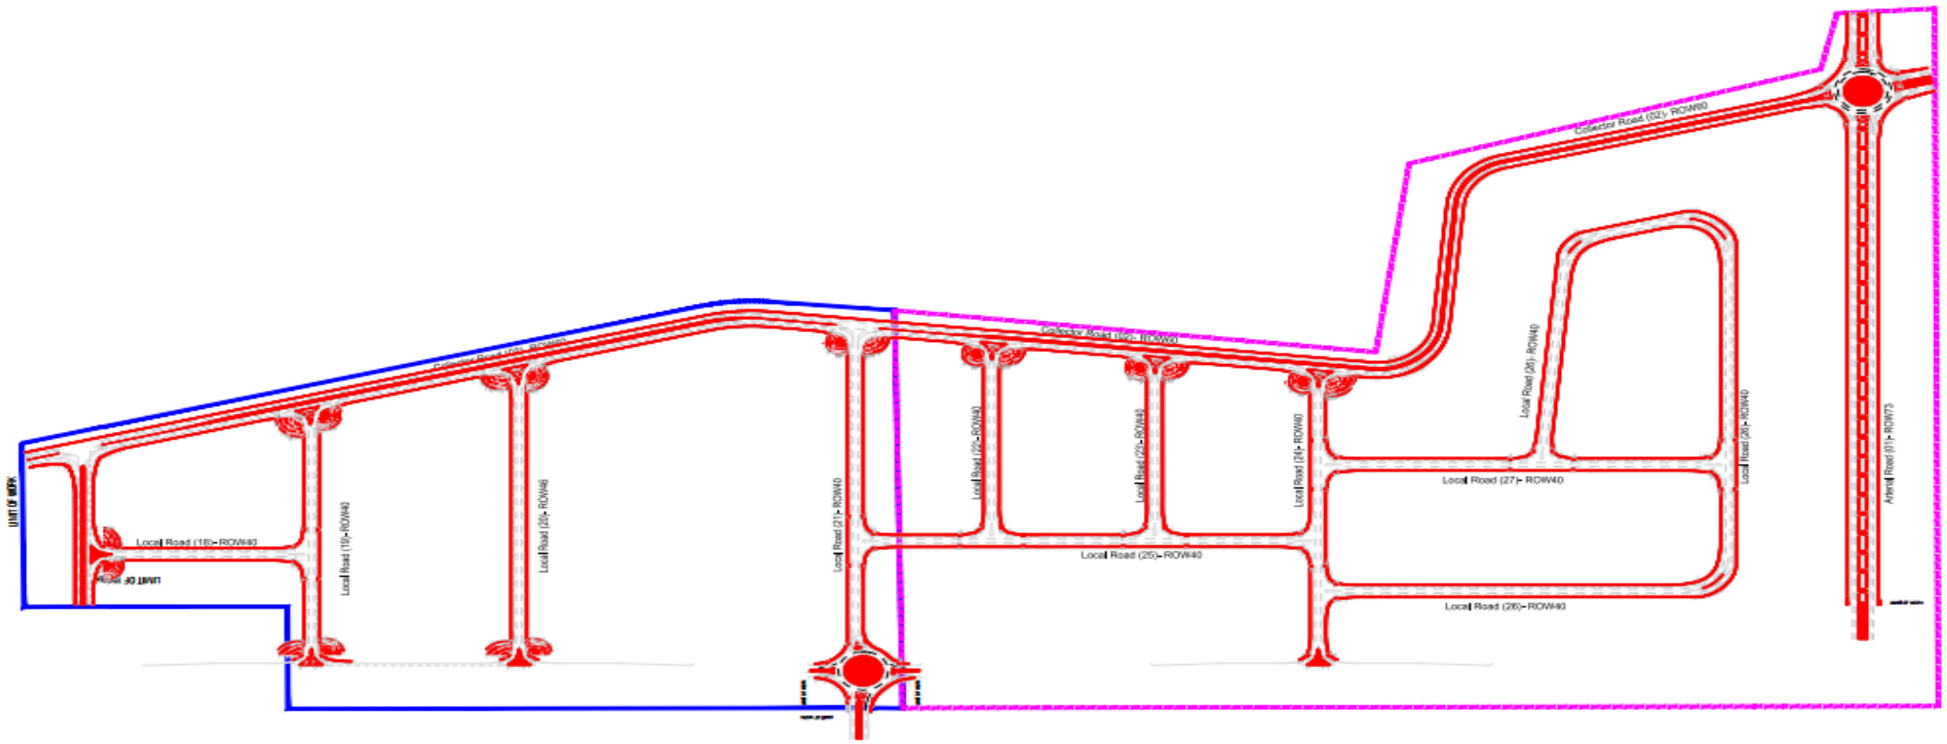

KEY PLAN



Legend

- Backfilling
- Bedding
- Installation
- Remaining

0 10 20 30 40 50 100 METERS
SCALE (A1) 1:1000

REFERENCE DRAWINGS

REVISIONS TABLE

REV	DESCRIPTION	DATE

PURPOSE OF ISSUE: FOR APPROVAL

MODON

egis

MOFARREH GROUP ENGINEERING & CONSTRUCTION


Weekly Progress

INTERLOCK LAYOUT-ZONE B


SCALE 1:1000 Date

CULVERT PROGRESS-ZONE B

CULVERT PROGRESS LAYOUT

SHEET 01 OF 02

Culvert NO.01 _ Local Road 19
Demolish RipRap: Done (1644.9 M²)
Excavation : Done (164.637 M³)
All Precasts Delivered on site 37 from 37
Lean : Done (107 M)
Installation : Done

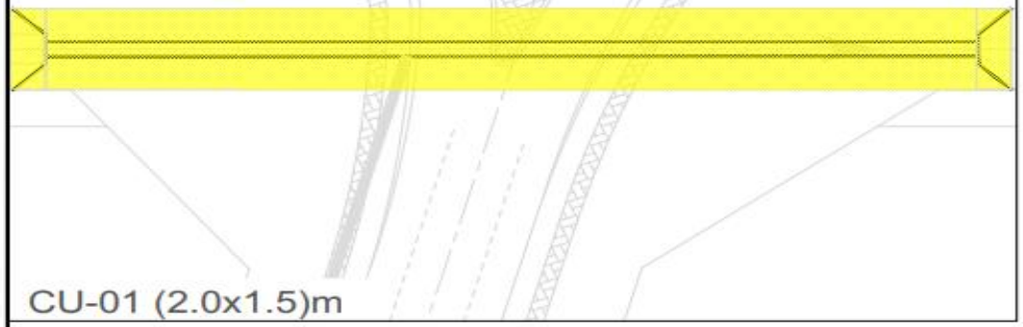


CU-01 (2.0x1.5)m

Culvert NO.02 _ Local Road 20
Demolish RipRap: Done (1003.24 M²)
Excavation : Done (184.568 M³)
All Precasts Delivered on site 37 from 37
Lean : Done (107 M)
Installation: Done




CU-02 2(1.5x1.5)m

Culvert NO.03 _ Local Road 21
Demolish RipRap: Done (2148.6 M²)
Excavation : Done (116.856 M³)
All Precasts Delivered on site 35 from 35
Lean : Done (101 M)
Installation: 35Pcs

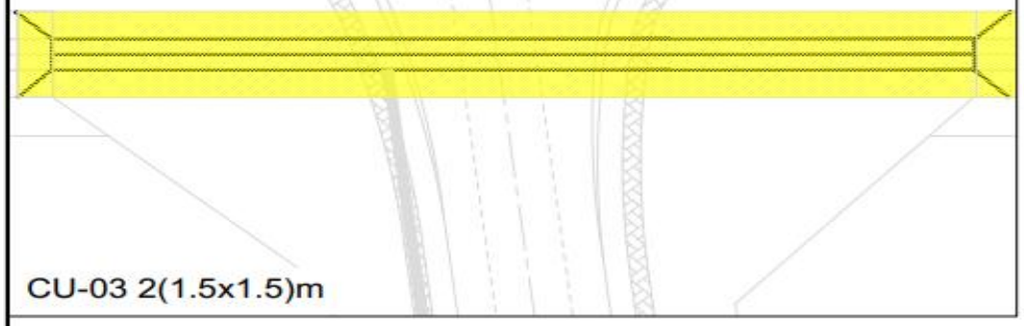

CU-03 2(1.5x1.5)m

Culvert NO.04 _ Local Road 22
Demolish RipRap: Done (2353.1 M²)
Excavation : Done (176.791 M³)
Precast's Deliver on site 35 from 35
Lean : Done (103M)
Installation :35Pcs

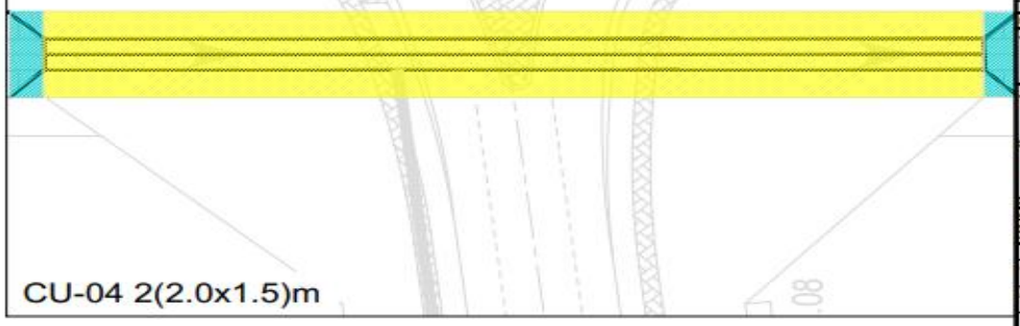

CU-04 2(2.0x1.5)m

KEY PLAN



Legend

- Excavation
- Blinding
- Installation
- Backfilling
- Wing Wall Activity
- Ongoing
- Remaining

0 10 20 30 40 50 100 METERS

SCALE (A1) 1:1000

REFERENCE DRAWINGS

REVISIONS TABLE

PURPOSE OF ISSUE: FOR APPROVAL

MODON

egis

MOFARREH GROUP

Weekly Progress


Culvert Progress


SCALE 1:1000


CULVERT PROGRESS-ZONE B

CULVERT PROGRESS LAYOUT

SHEET 02 OF 02

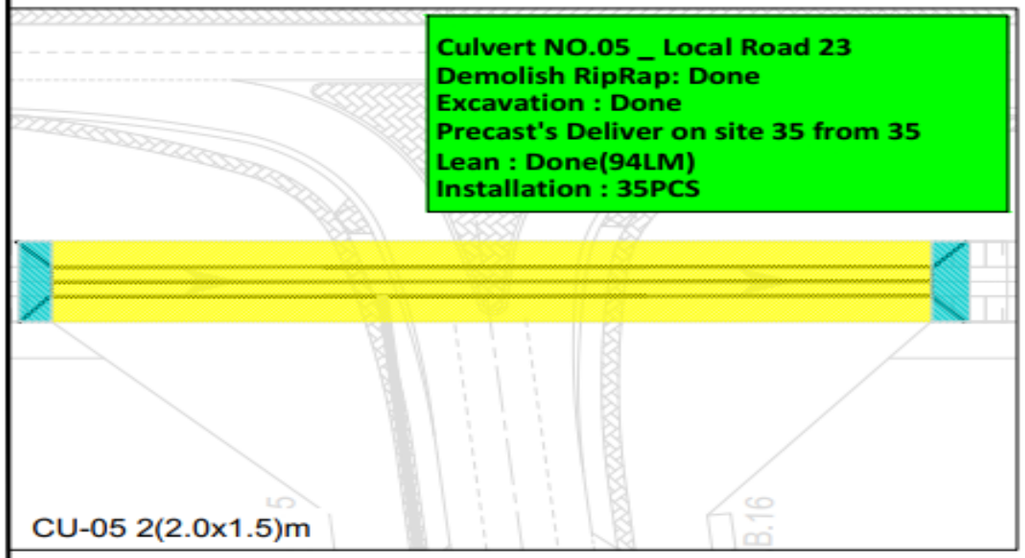

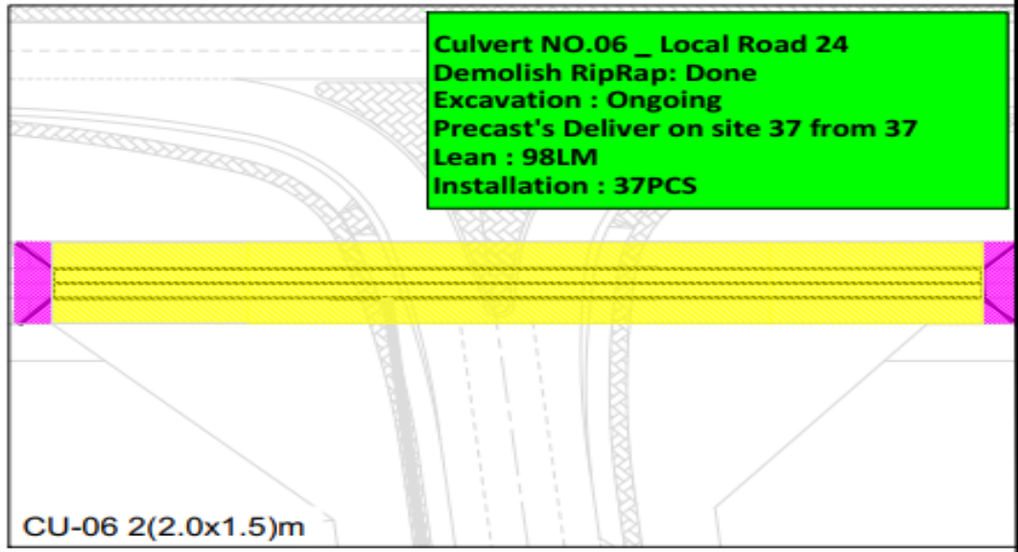

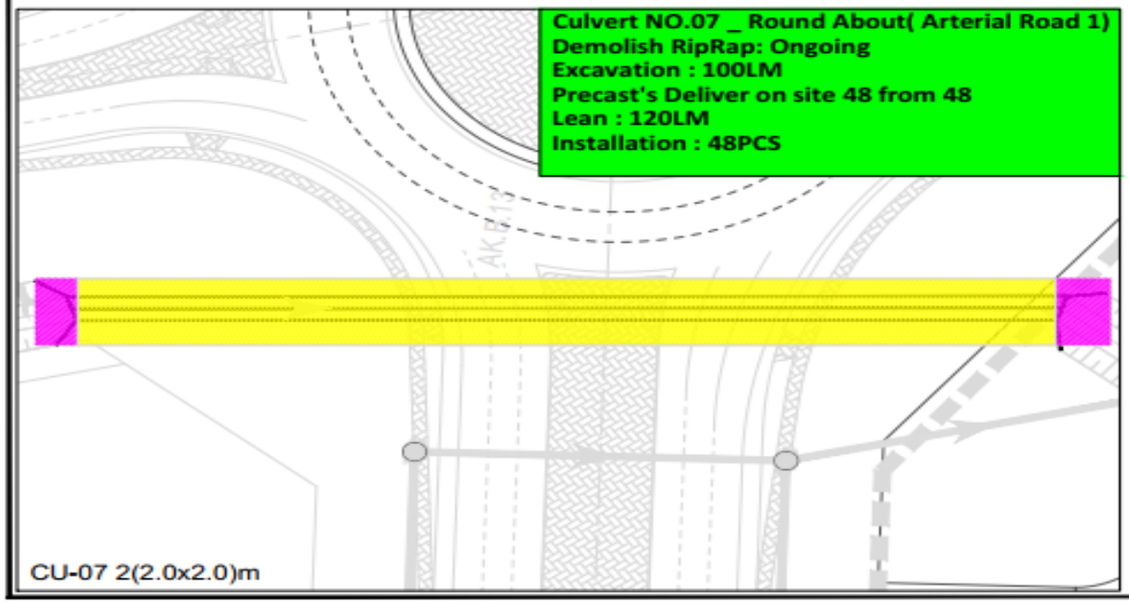



Legend

- Excavation
- Blinding
- Installation
- Backfilling
- Remaining

SCALE (AT) 1:1000 METERS

REFERENCE DRAWINGS

REVISIONS TABLE


PURPOSE OF ISSUE: FOR APPROVAL

Weekly Progress

Culvert Progress

BOX COUNDUIT PROGRESS LAYOUT ZONE-A

ZONE A (BOX CONDUIT)				
ITEM	**Total Quantity (LM)**	**Excuted Quantity (LM)**	**Remaining Quantity (LM)**	**Percentage %**
Excavation	**1500**	**627.000**	**873.000**	**41.80%**
Blinding	**1500**	**627.000**	**873.000**	**41.80%**
Installation	**1500**	**532.000**	**968.000**	**35.47%**
Backfilling	**1500**	**0.000**	**1500.000**	**0.00%**

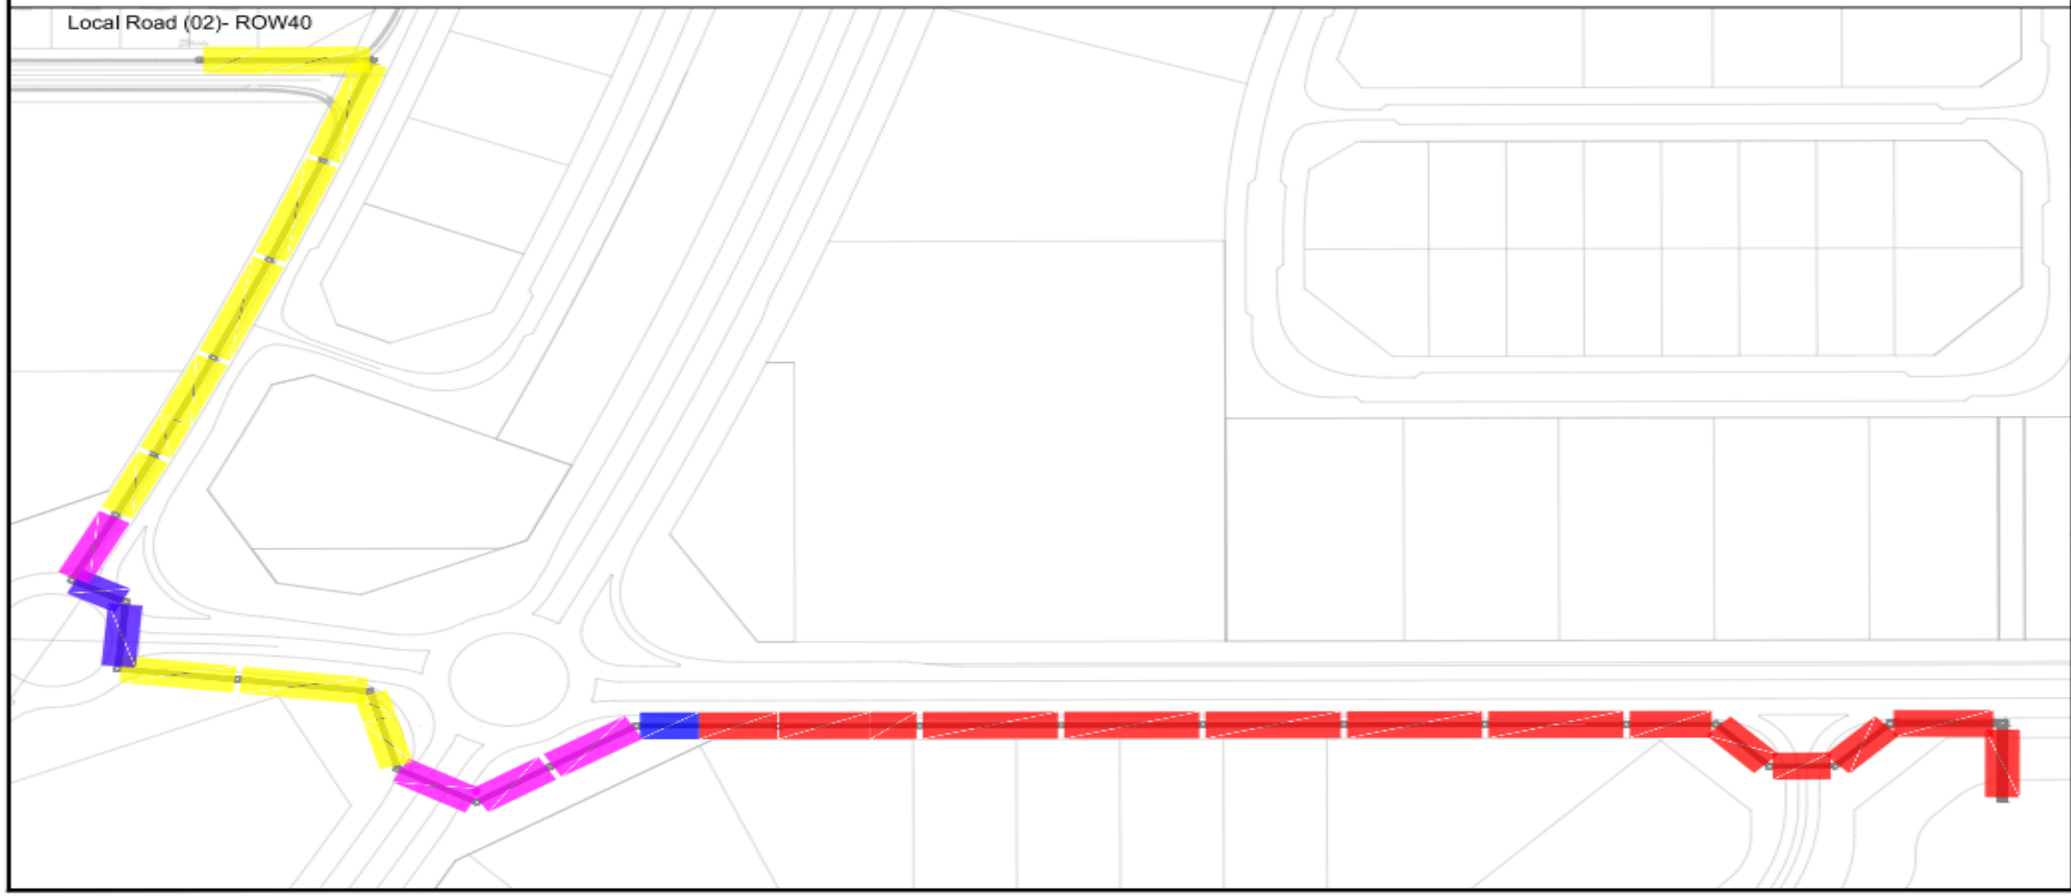

KEY PLAN



Legend

- Excavation
- Blinding
- Installation
- Backfilling
- Remaining

REFERENCE DRAWINGS

REVISIONS TABLE

PURPOSE OF ISSUE: FOR APPROVAL


Box Conduit Layout Plan-Zone A

SCALE 1:1000

SHEET

STREET LIGHTING POLES PROGRESS LAYOUT ZONE-A

ZONE A Street Lighting (Poles)				
ITEM	Total Quantity (LM)	Excuted Quantity (EA)	Remaining Quantity (LM)	Percentage %
Excavation	509.00	109.000	400.000	21.41%
Base Installation	509.00	68.000	441.000	13.36%
Backfilling	509.00	0.000	509.000	0.00%

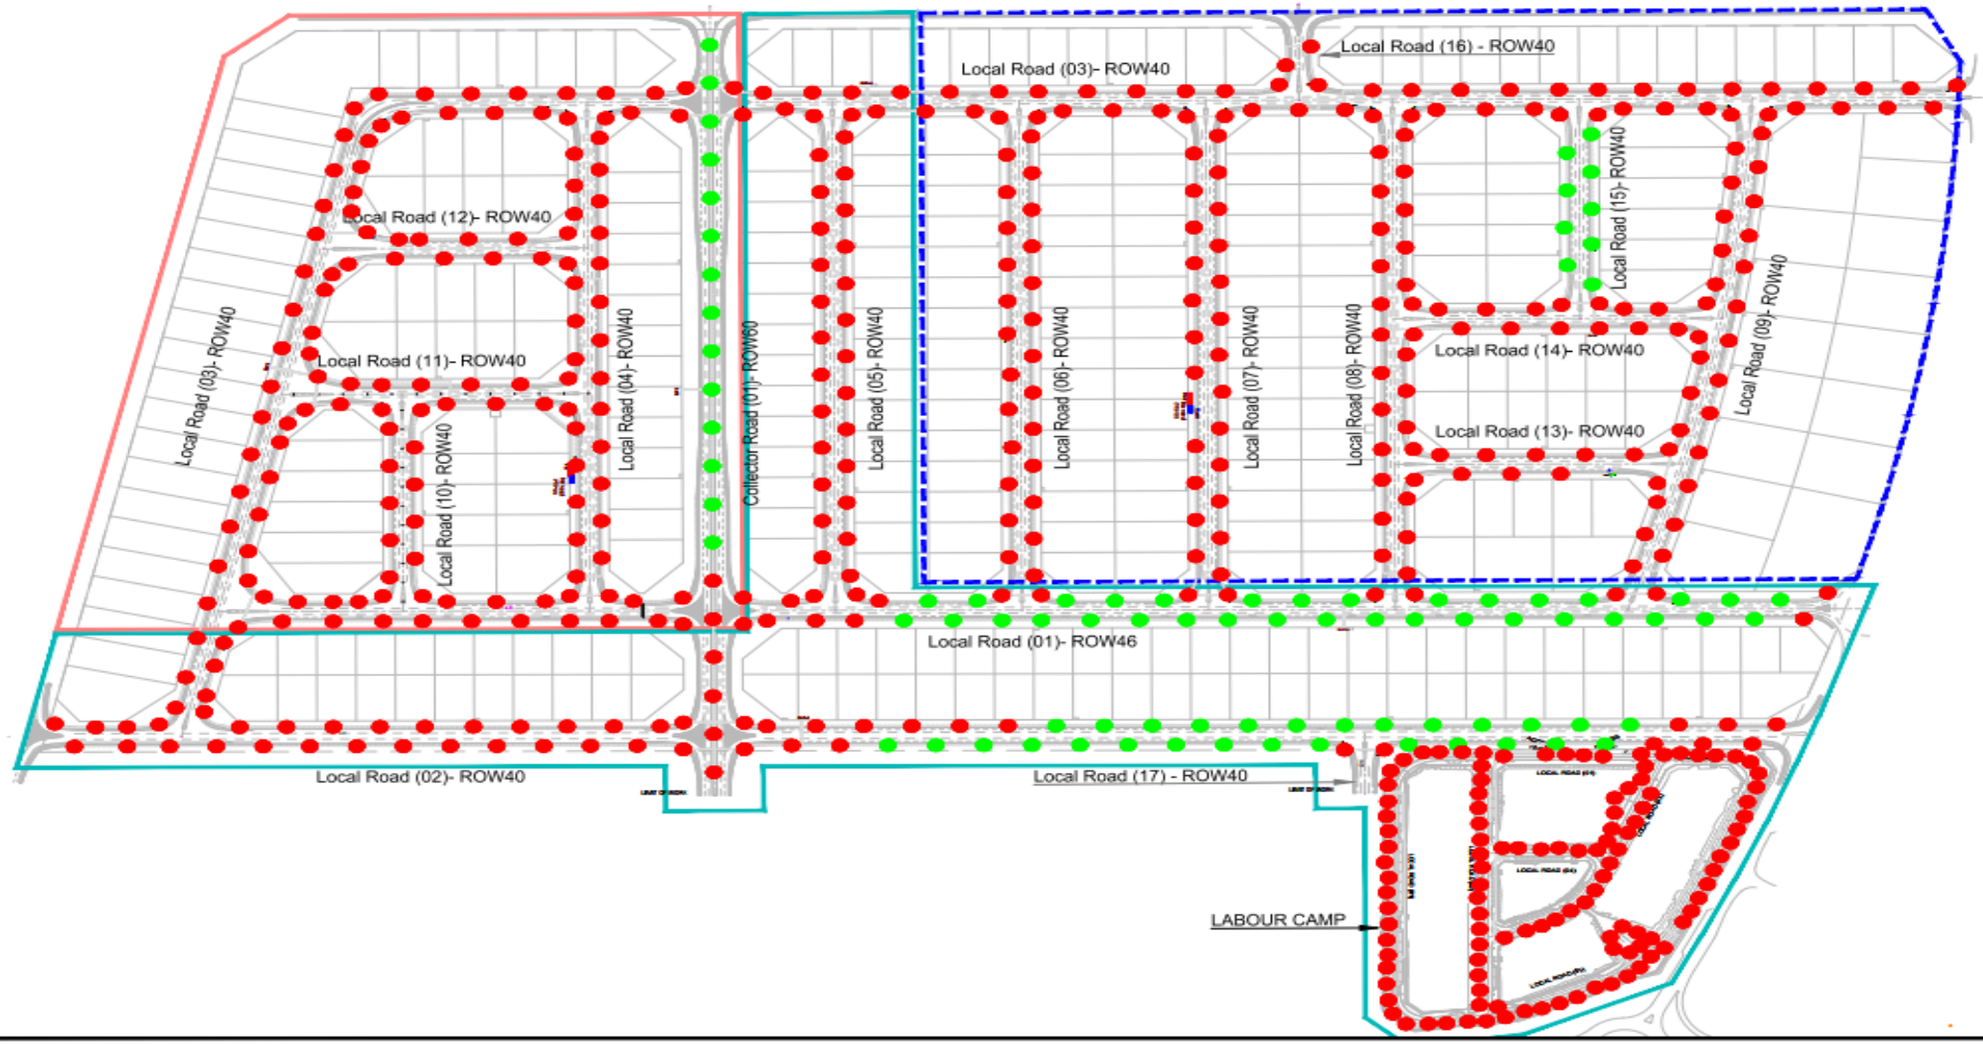



Legend

- Excavation
- Base Installation
- Backfilling
- Remaining

REFERENCE DRAWINGS

REVISIONS TABLE

PURPOSE OF ISSUE: FOR APPROVAL

MODON

egis

MOFARREH GROUP ENGINEERING & CONSTRUCTION


SEWER NETWORK SYSTEM

STREET LIGHTING POLE PROGRESS LAYOUT ZONE-A

SCALE 1:1000

STREET LIGHTING POLES PROGRESS LAYOUT ZONE-B

ZONE B Street Lighting (Poles)				
ITEM	Total Quantity (LM)	Excuted Quantity	Remaining Quantity (LM)	Percentage %
Excavation	353.00	94	259	26.63%
Foundation Installation	353.00	66	287	18.81%
Backfilling	353.00	71	282	20.06%

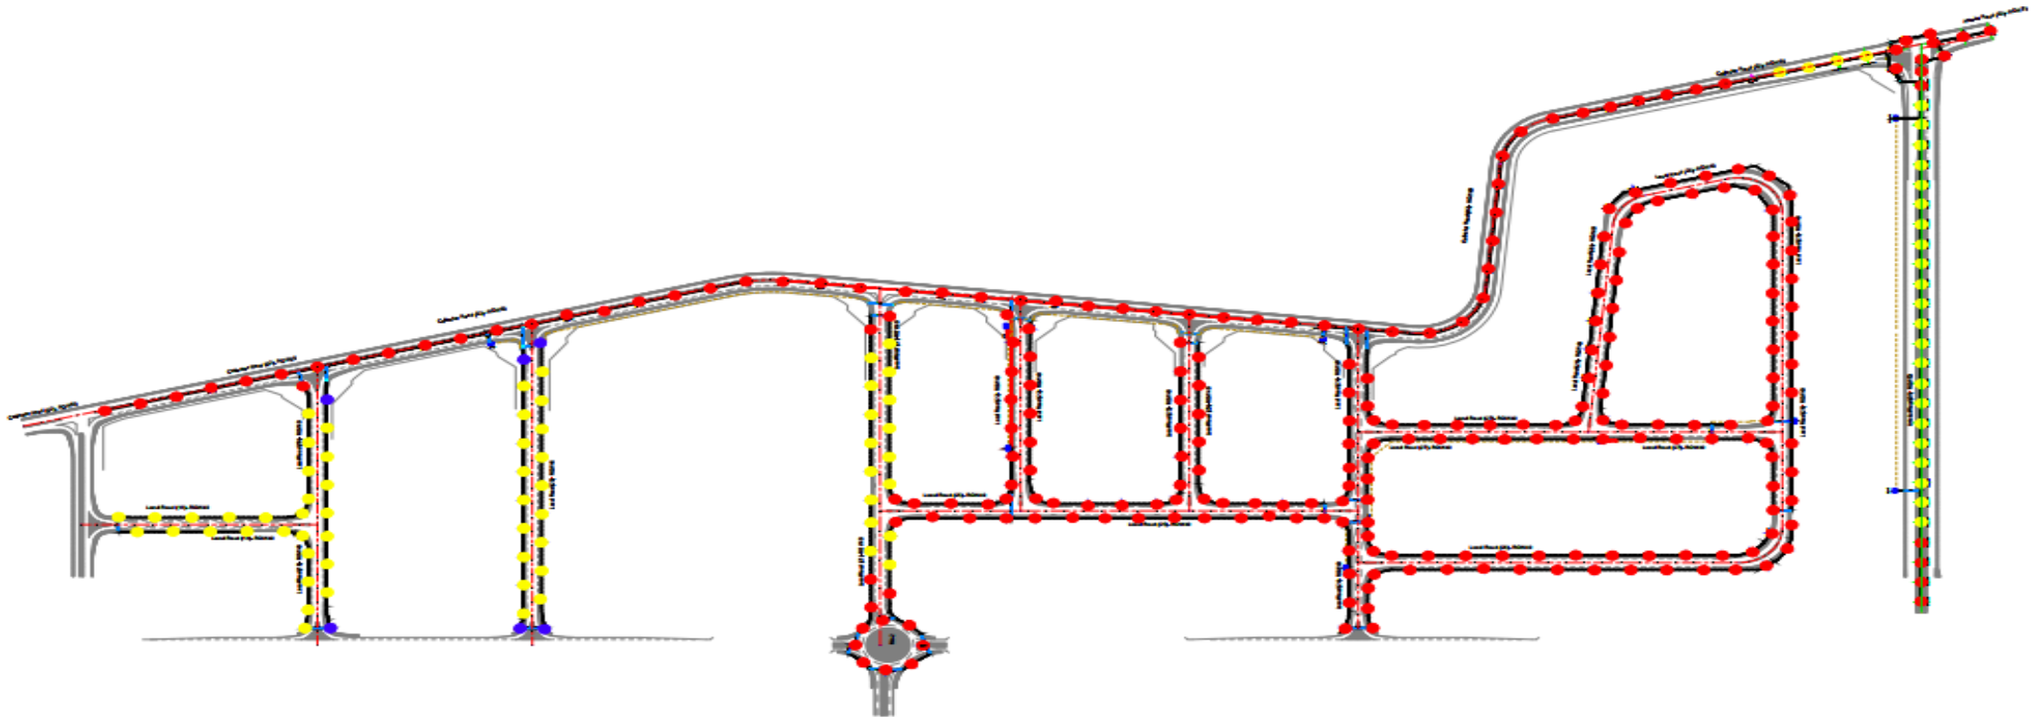

KEY PLAN



Legend

- Excavation
- Foundation Installation
- Backfilling
- Remaining

REFERENCE DRAWINGS

REVISIONS TABLE

PURPOSE OF ISSUE: FOR APPROVAL

MODON · UPDATED CONCEPT MASTER PLAN AND INFRASTRUCTURE DESIGNS FOR AL-OOWALI INDUSTRIAL CITY

ELECTRICAL NETWORK SYSTEM


STREET LIGHTING NETWORK LAYOUT ZONE-B

SCALE

SHEET

STREET LIGHTING CABLE PROGRESS LAYOUT ZONE-A

ZONE A (STREET LIGHT NETWORK) CABLE				
ITEM	Total Quantity (LM)	Excuted Quantity (LM)	Remaining Quantity (LM)	Percentage %
Excavation	26093.42	1830.980	24262.435	7.02%
Bedding	26093.42	1830.980	24262.435	7.02%
Installation	26093.42	1830.980	24262.435	7.02%
Backfilling	26093.42	1830.980	24262.435	7.02%

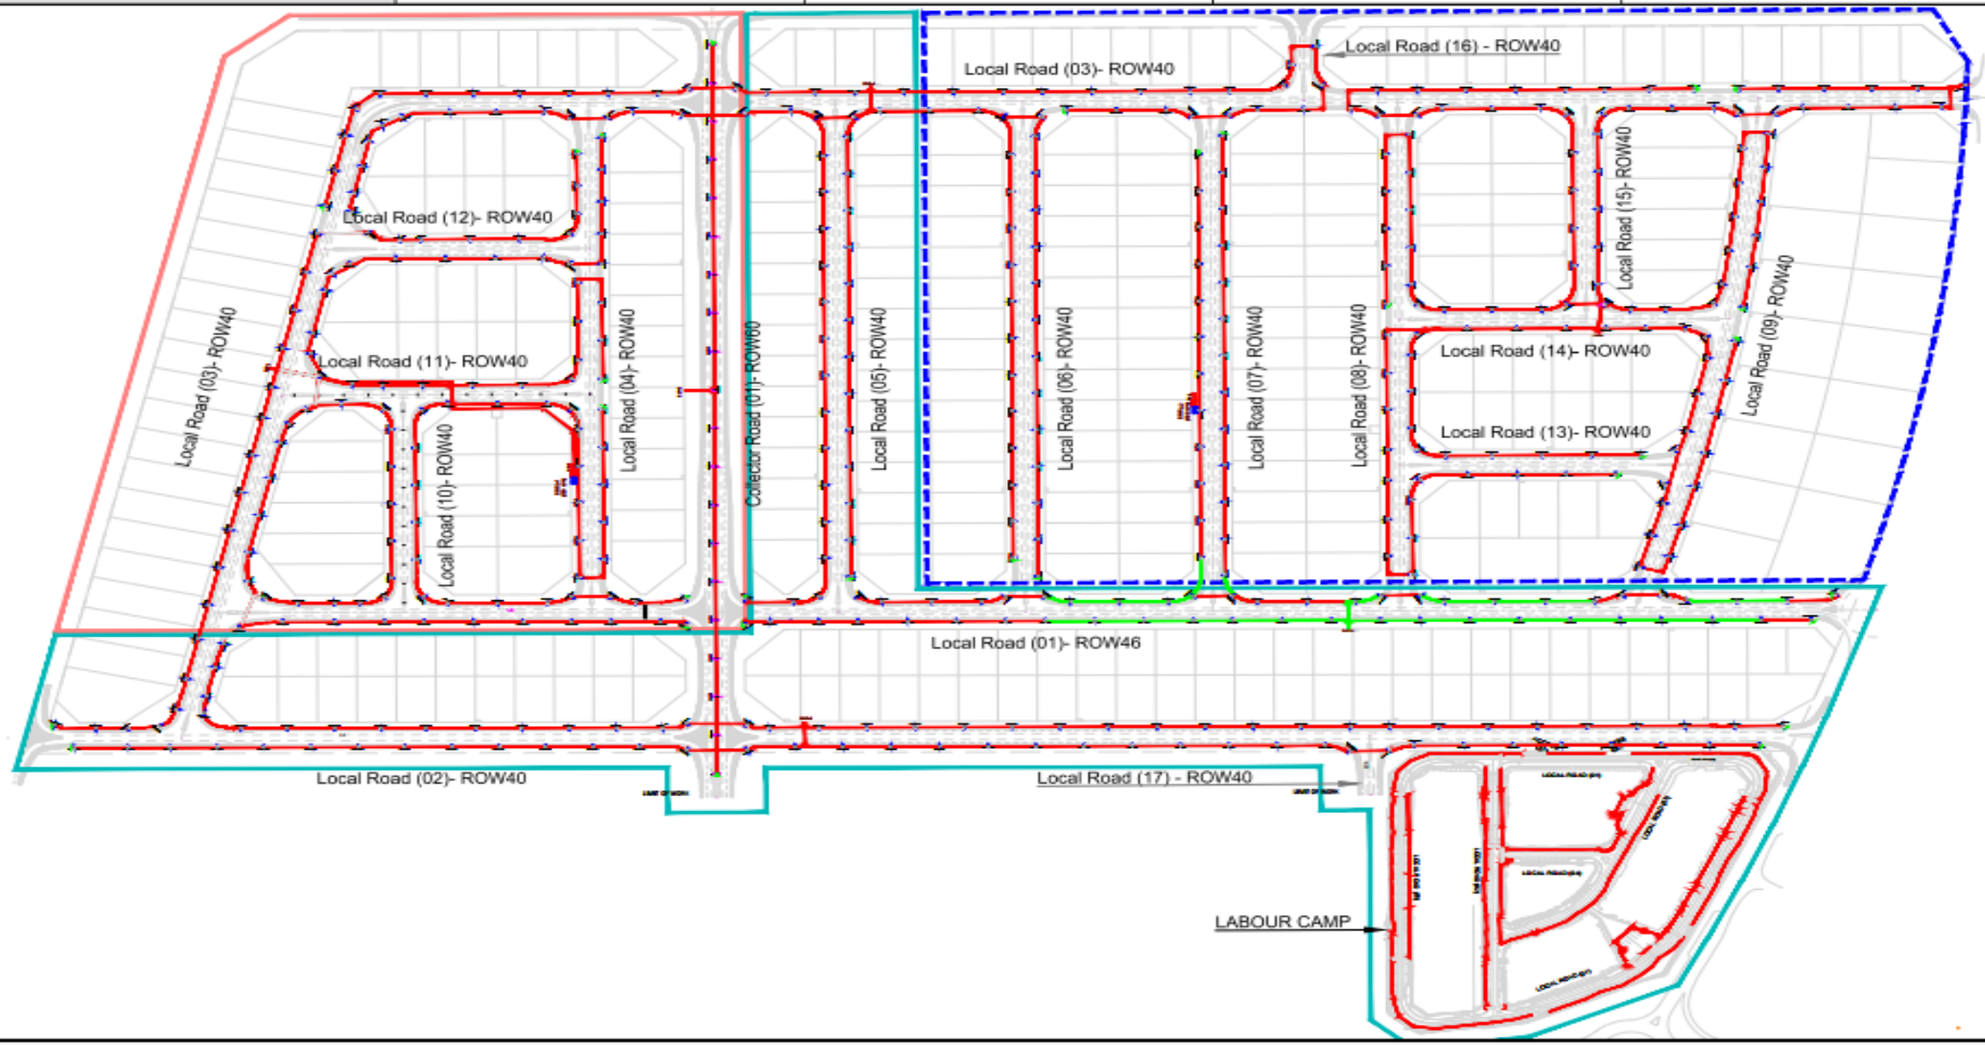



Legend

- Excavation
- Sand Bedding
- Installation
- Backfilling
- Remaining

REFERENCE DRAWINGS

REVISIONS TABLE


PURPOSE OF ISSUE: FOR APPROVAL

MODON egis MOFARREH GROUP

SCALE

STREET LIGHTING CABLE PROGRESS LAYOUT ZONE-B

ZONE B (STREET LIGHT NETWORK) CABLE				
ITEM	Total Quantity (LM)	Excuted Quantity (LM)	Remaining Quantity (LM)	Percentage %
Excavation	18,276.50	2403.018	15873.485	13.15%
Bedding	18,276.50	2403.018	15873.485	13.15%
Installation	18,276.50	2403.018	15873.485	13.15%
Backfilling	18,276.50	2248.716	16027.787	12.30%

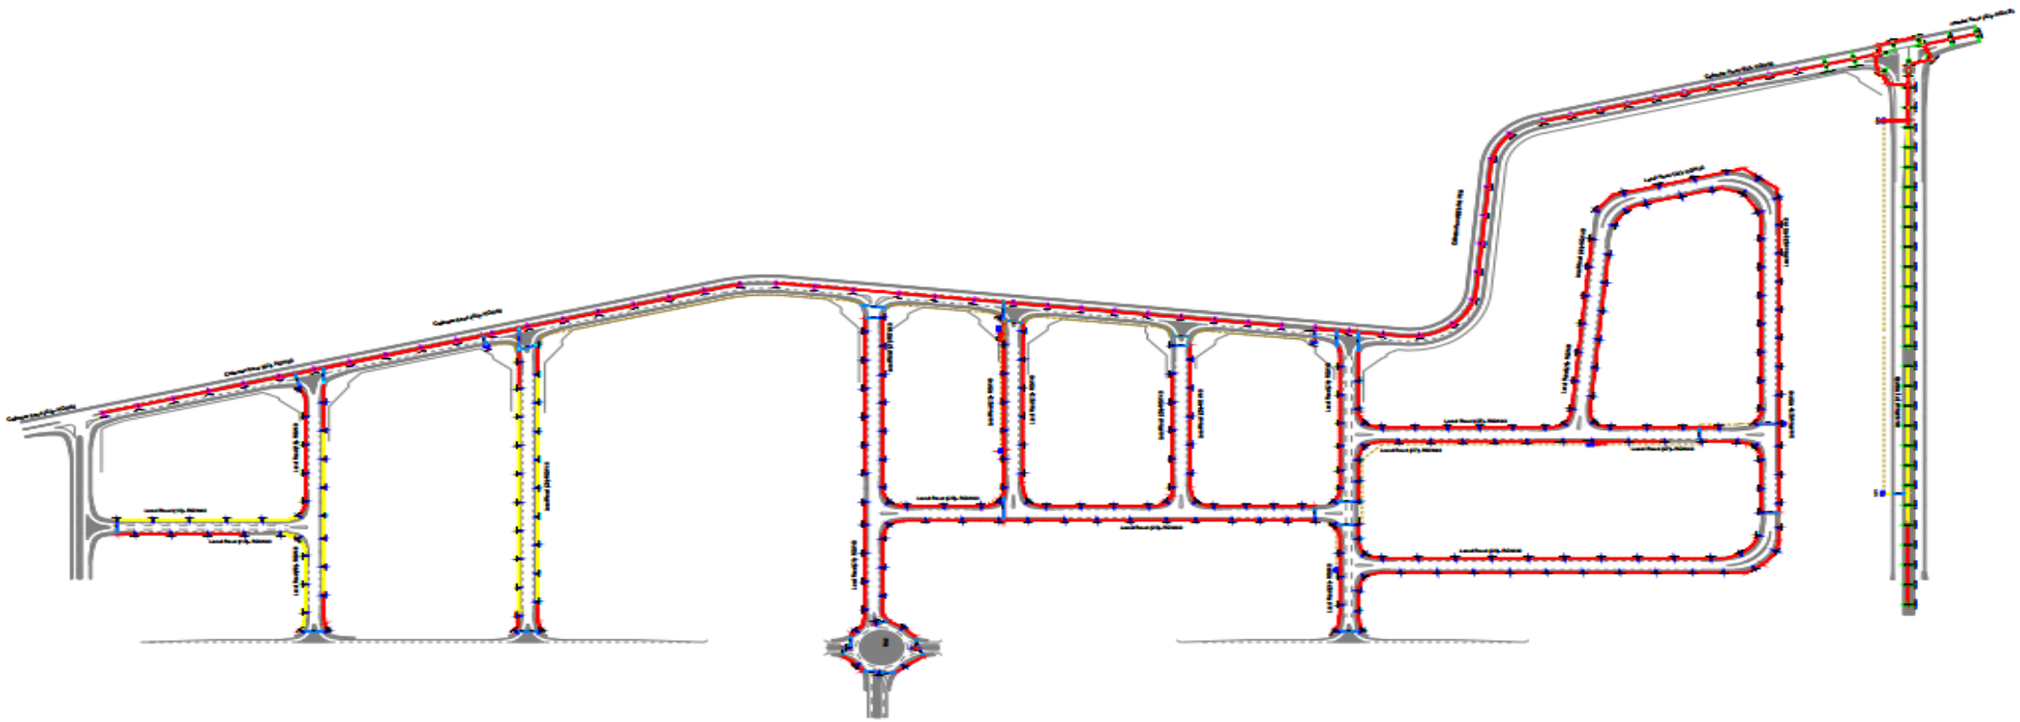

KEY PLAN



Legend

- Excavation
- Foundation Installation
- Backfilling
- Remaining

REFERENCE DRAWINGS

REVISIONS TABLE

REV	DESCRIPTION	DATE

PURPOSE OF ISSUE: FOR APPROVAL

MODON

egis

MOFARREH GROUP

MODON - UPDATED CONCEPT MASTER PLAN AND INFRASTRUCTURE DESIGNS FOR ALKHARJ INDUSTRIAL CITY

DISCIPLINE: ELECTRICAL NETWORK SYSTEM


DRAWING TITLE: STREET LIGHTING NETWORK LAYOUT ZONE-B

SCALE

SHEET

MV NETWORK PROGRESS LAYOUT ZONE-A

ZONE A (MV NETWORK) CABLE				
ITEM	Total Quantity (LM)	Excuted Quantity (LM)	Remaining Quantity (LM)	Percentage %
Excavation	27225.00	5312.940	21912.060	19.51%
Bedding	27225.00	5312.940	21912.060	19.51%
Installation	27225.00	5312.940	21912.060	19.51%
Backfilling	27225.00	0.000	27225.000	0.00%

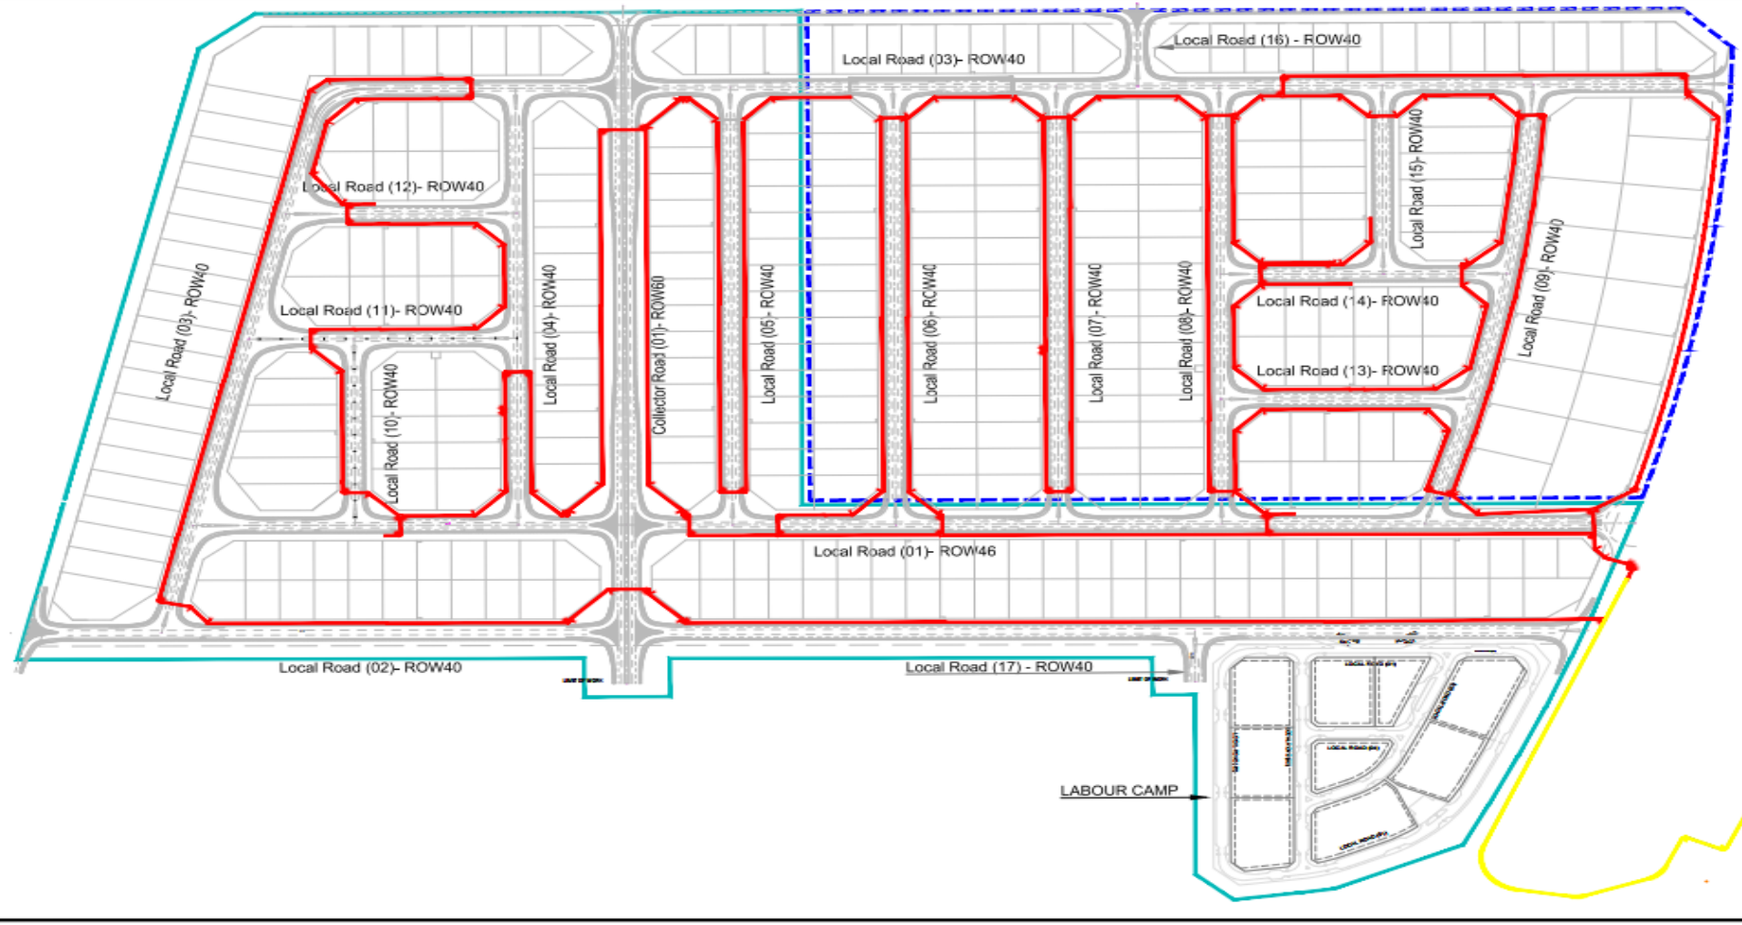

KEY PLAN



Legend

- Excavation
- Sand Bedding
- Cable Installation
- Backfilling
- Remaining

REFERENCE DRAWINGS

REVISIONS TABLE

PURPOSE OF ISSUE: FOR APPROVAL


MODON - UPDATED CONCEPT MASTER PLAN AND INFRASTRUCTURE DESIGNS FOR AL-KHARJ INDUSTRIAL CITY

MV PROGRESS LAYOUT ZONE-A

SCALE 1:1000

MV NETWORK PROGRESS LAYOUT ZONE-B

ZONE B (MV NETWORK) CABLE				
ITEM	Total Quantity (LM)	Excuted Quantity	Remaining Quantity (LM)	Percentage %
Excavation	44775.21	21604.040	23171.170	48.25%
Bedding	44775.21	21024.040	23751.170	46.95%
Installation	44775.21	21024.040	23751.170	46.95%
Backfilling	44775.21	0.000	44775.210	0.00%

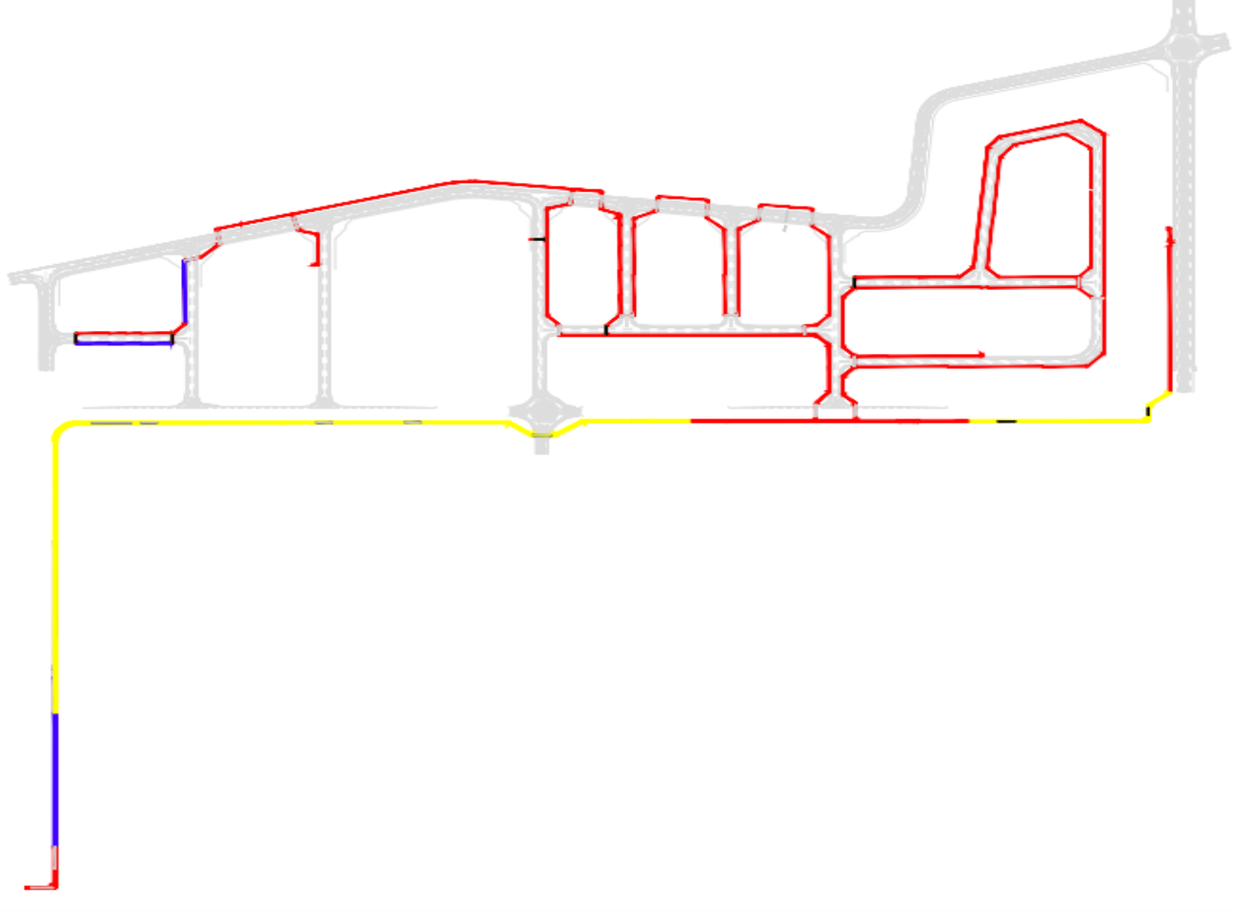



Excavation
Installation
Backfilling
Remaining

0 10 20 30 40 50 100 METERS
SCALE (A1) 1:1000

REFERENCE DRAWINGS

REVISIONS TABLE

PURPOSE OF ISSUE: FOR APPROVAL


Weekly Progress

MV NETWORK LAYOUT-ZONE B

SCALE 1:1000

TELECOM NETWORK PROGRESS LAYOUT ZONE-A

ZONE A (TEL NETWORK) PROGRESS				
ITEM	Total Quantity (LM)	Excuted Quantity (LM)	Remaining Quantity (LM)	Percentage %
Excavation	155000.00	0.000	155000.000	0.00%
Bedding	155000.00	0.000	155000.000	0.00%
Installation	155000.00	0.000	155000.000	0.00%
Backfilling	155000.00	0.000	155000.000	0.00%

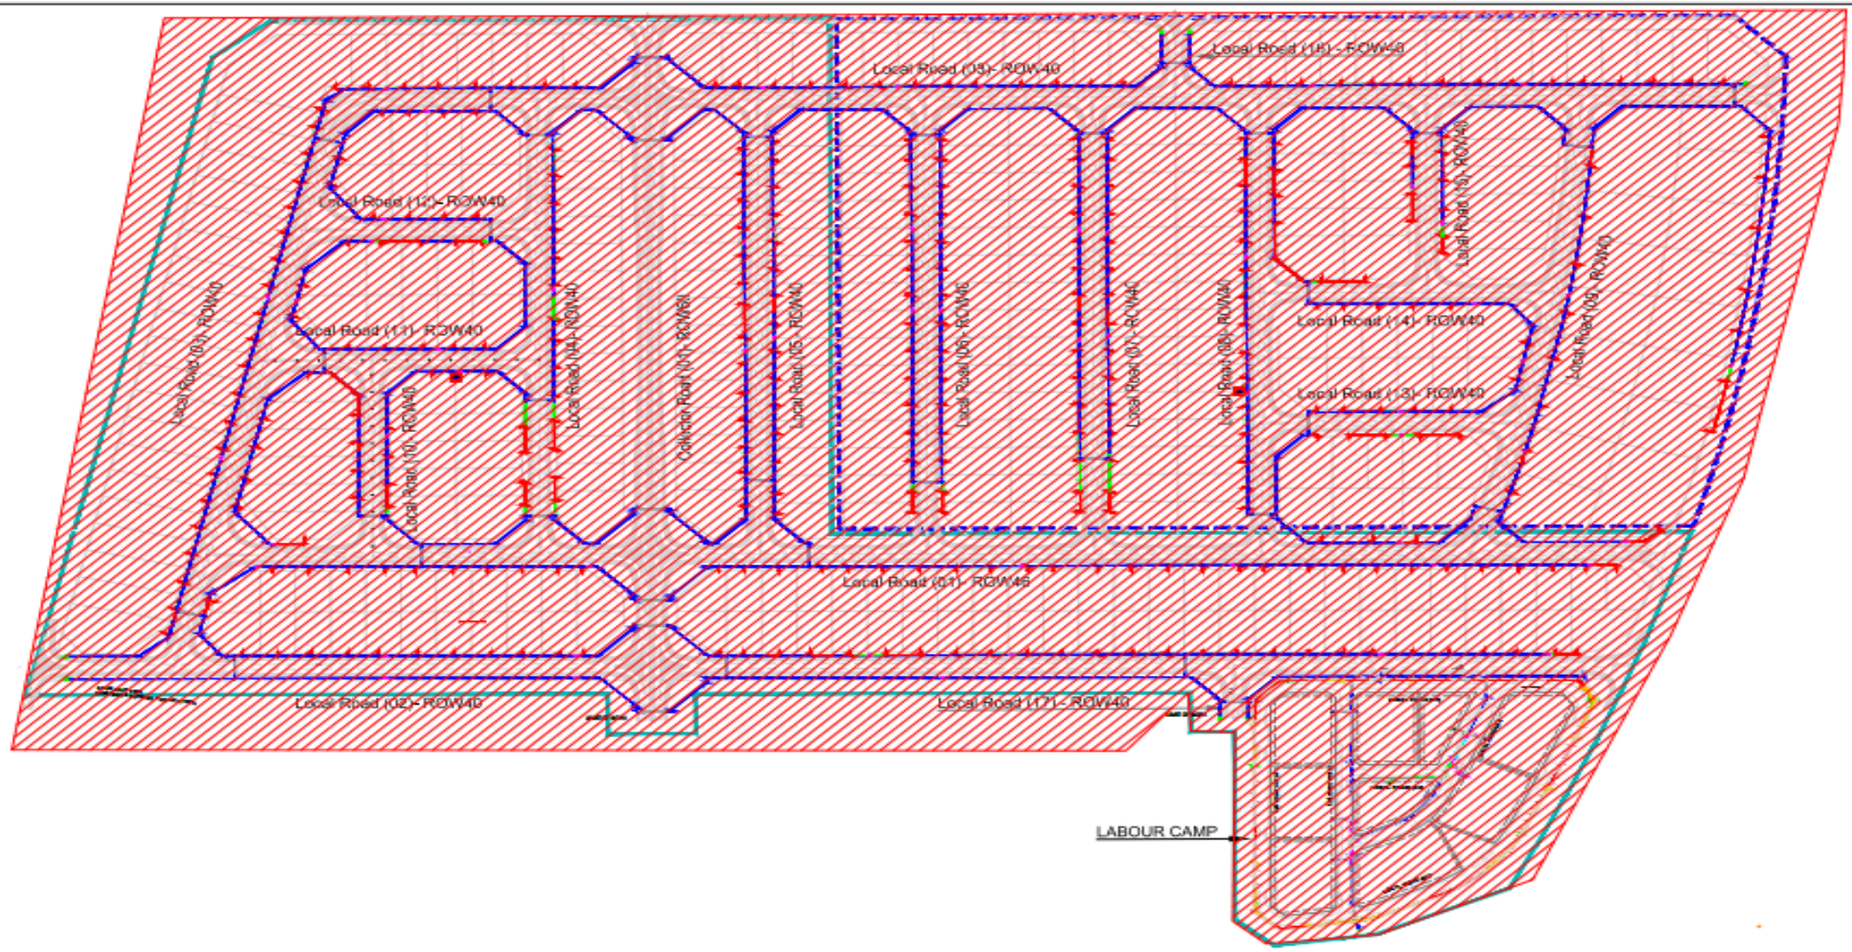

KEY PLAN



Legend

- Excavation
- Base Installation
- Backfilling
- Remaining

REFERENCE DRAWINGS

REVISIONS TABLE

PURPOSE OF ISSUE: FOR APPROVAL

MODON

egis

MOFARREH GROUP


ENGINEERING & CONSTRUCTION

TELECOM PROGRESS LAYOUT ZONE-A

SCALE 1 : 2000

TELECOM NETWORK PROGRESS LAYOUT ZONE-B

ZONE B (TEL NETWORK) PROGRESS (2X32 mm + 6X50 mm)				
ITEM	Total Quantity (LM)	Excuted Quantity	Remaining Quantity (LM)	Percentage %
Excavation	20299.28	1042.153	19257.129	5.13%
Bedding	20299.28	1042.153	19257.129	5.13%
Installation	20299.28	1042.153	19257.129	5.13%
Backfilling	20299.28	0.000	20299.282	0.00%

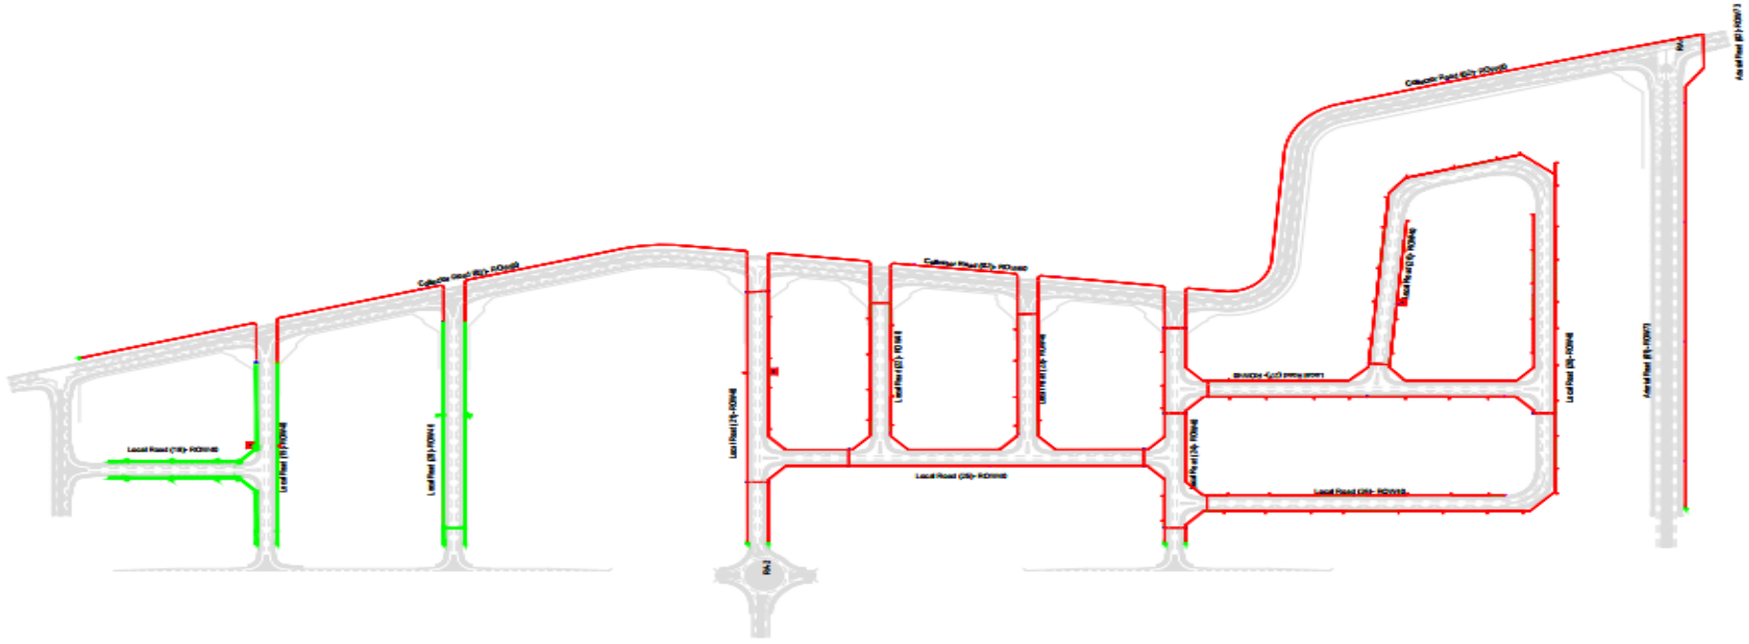

KEY PLAN



Legend

- Excavation
- Bedding
- Installation
- Backfilling
- Remaining

REFERENCE DRAWINGS

REVISIONS TABLE

PURPOSE OF ISSUE: FOR APPROVAL


TELCOM NETWORK SYSTEM

TELCOM NETWORK LAYOUT ZONE B

SCALE

CULVERT PROGRESS-ZONE B

Culverts Statue.						
SN	Culverts Name	Statue.	Recivied Date	Qauntity By Earth Work	Total	Notes
1	Culvert 01	Cut	4/15/2026	164.637		m3
2	Culvert 02	Cut	4/15/2026	184.568		m3
3	Culvert 03	Cut	4/15/2026	116.856		m3
4	Culvert 04	Cut	4/15/2026	176.791	1962.752	m3
5	Culvert 05	Cut	4/15/2026	140.752		m3
6	Culvert 06	Cut	4/15/2026	198.241		m3
7	Culvert 07	Cut	4/15/2026	980.907		m3


Page 1

Culverts Statue.						
SN	Culverts Name	Statue.	Recivied Date	Qauntity By Earth Work	Total	Notes
8	Culvert 01	Demolition	4/15/2026	1644.9		m2
9	Culvert 02	Demolition	4/15/2026	1003.24		m2
10	Culvert 03	Demolition	4/15/2026	2148.6		m2
11	Culvert 04	Demolition	4/15/2026	2353.1	12680.14	m2
12	Culvert 05	Demolition	4/15/2026	2365.18		m2
13	Culvert 06	Demolition	4/15/2026	2286.37		m2
14	Culvert 07	Demolition	4/15/2026	878.75		m2


Page 1

SN	Culverts Name	Statue.	Total Qauntity (m3)	Ex . Qauntity (m3)	Notes
1	Culvert 01	Lean Concrete	50.08202	49.0	Volume Body
2	Culvert 02	Lean Concrete	65.83282	65.9	Volume Body
3	Culvert 03	Lean Concrete	63.37282	62.292	Volume Body
4	Culvert 04	Lean Concrete	76.88832	68.986	Volume Body
5	Culvert 05	Lean Concrete	76.88902	35.711	Volume Body
6	Culvert 06	Lean Concrete	78.96442		
7	Culvert 07	Lean Concrete	96.59872		

MOSQUE PROGRESS LAYOUT

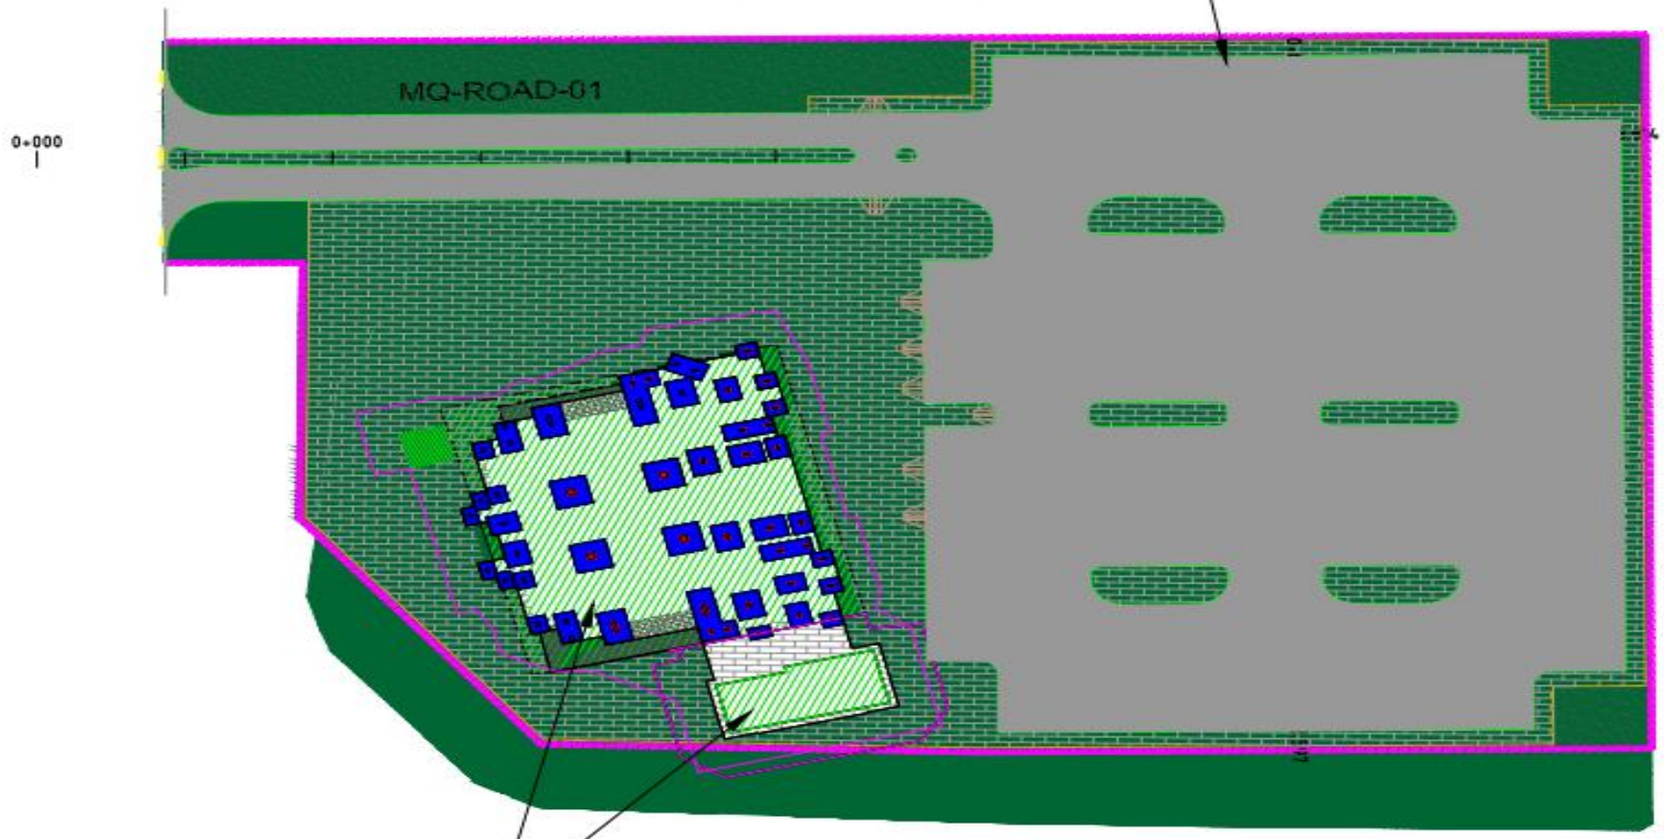

KEY PLAN

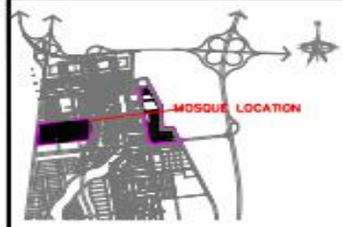

NOTES:

1. COORDINATES SYSTEM IS BASED ON UTM - WGS84-ZONE 38N
2. ALL LEVELS ARE IN METERS AND DIMENSIONS ARE IN METRES UNLESS STATED OTHERWISE.

LEGENDS

MOSQUE AREA WORK

1. PC FOUNDATION (DONE)
2. RC FOUNDATION (DONE)
3. BACK FILL FOUNDATION DONE
4. COLUMN NECK DONE
5. GRADE BEAM DONE
6. COLUMN STEEL ON GOING

BATH ROOM AREA WORK

1. PC FOUNDATION (DONE)
2. RC FOUNDATION (DONE)
3. BACK FILL FOUNDATION DONE
4. COLUMN (DONE)
5. GRADE BEAM (DONE)
6. SLAB AND BEAM (DONE)

Earth Work

REFERENCE DRAWINGS

REVISIONS TABLE

PURPOSE OF ISSUE: FOR APPROVAL

MODON egis MOFARREH GROUP



MOSQUE LAYOUT PLAN

TRANSPORTATION

SCALE

SHEET

PORTA CABIN LAYOUT

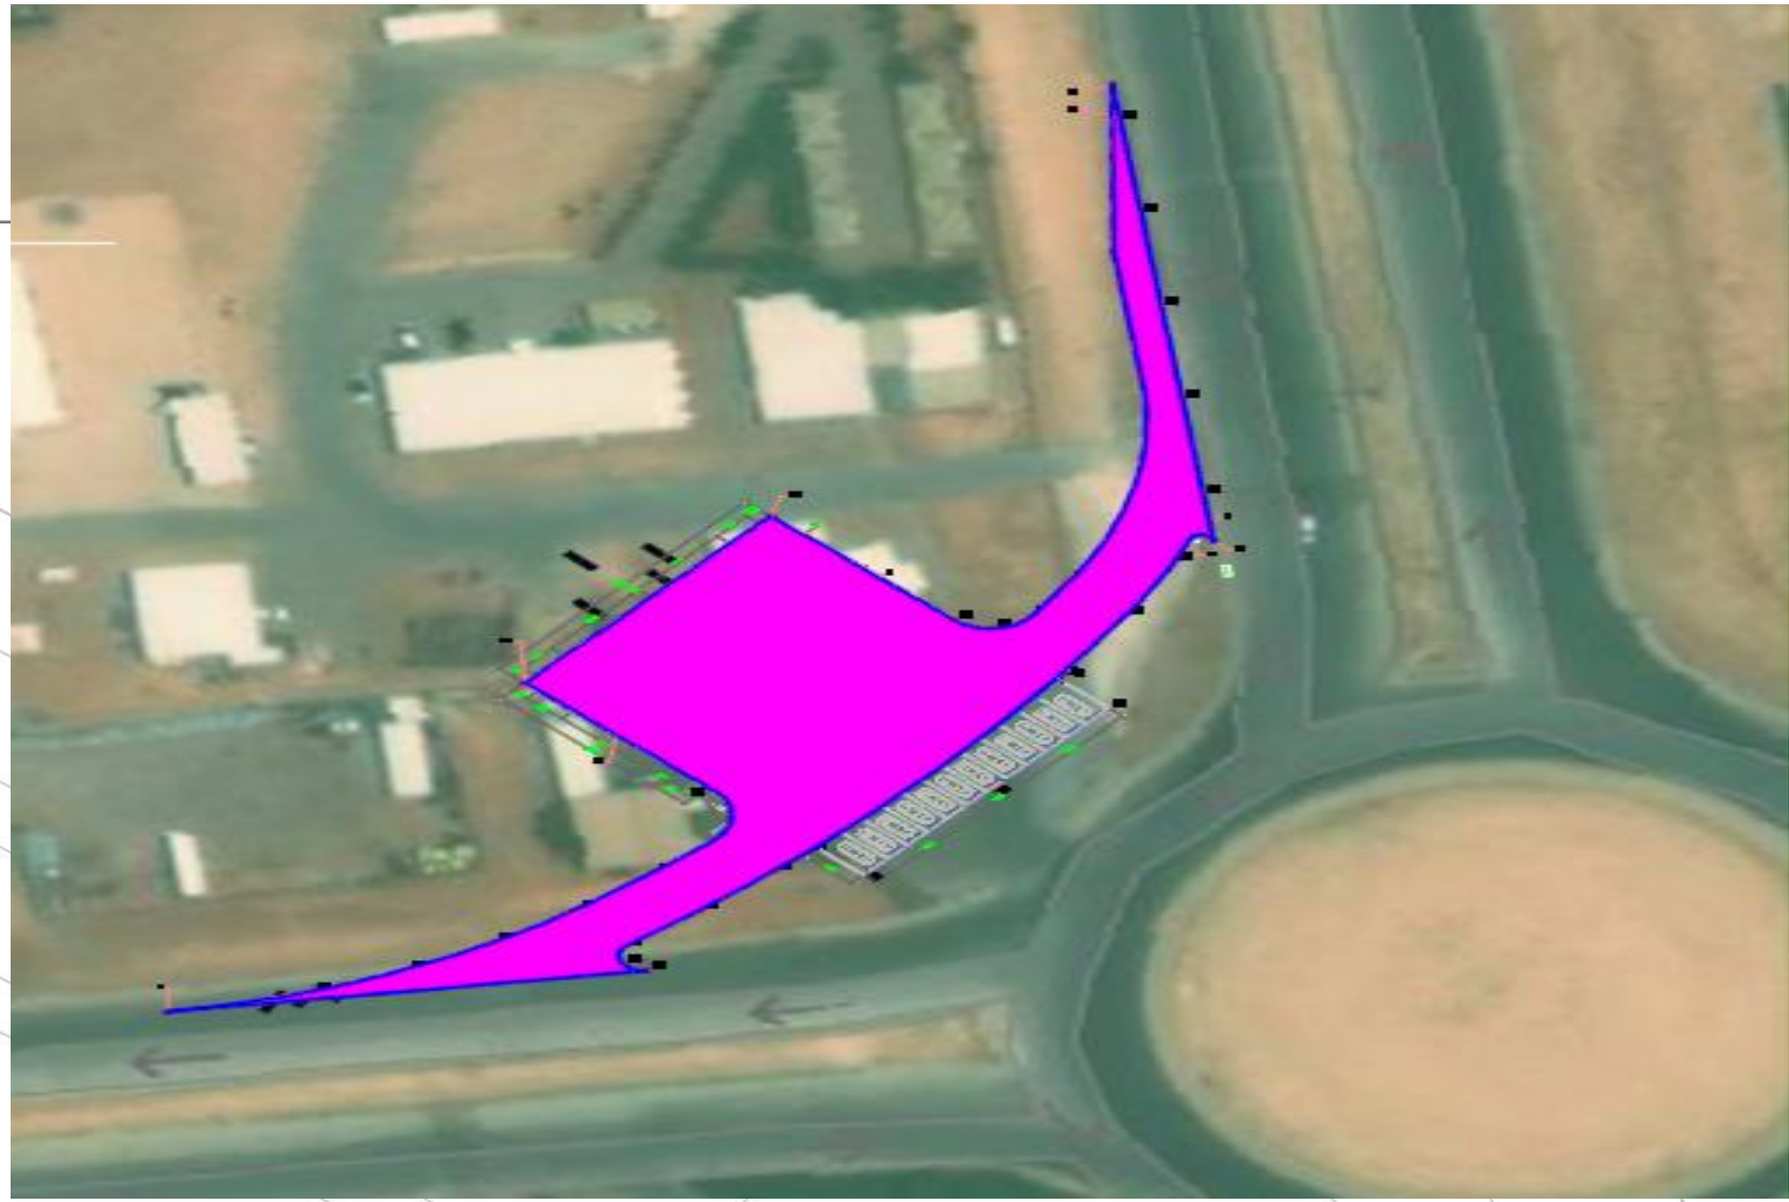

KEY PLAN



Legend

Fill

Cut

Remaining

0 10 20 30 40 50 500 METERS

SCALE (A1) 1:1000

REFERENCE DRAWINGS

REVISIONS TABLE

REV.	DESCRIPTION	DATE

PURPOSE OF ISSUE: FOR APPROVAL

MODON مدن

egis

MOFARREH GROUP

ENGINEERING & CONSTRUCTION

CONTRACTOR:		REVIEW:	
DRAWN:	RKZ	CHECKED:	
CHECKED:	MAA	APPROVED:	
APPROVED:	KTW	SHEET SIZE:	A1

PROJECT: UPDATED CONCEPT MASTER PLANNING OF RESIDENCE DEBBAN FOR ALKHAEJ INDUSTRIAL CITY


DISCIPLINE: Weekly Progress

DRAWING TITLE: Porta Cabin Layout

DRAWING NUMBER:

SCALE	Date
1:1000	27/05/2026

REHABLITATION ROAD LAYOUT -FACTORY AREA

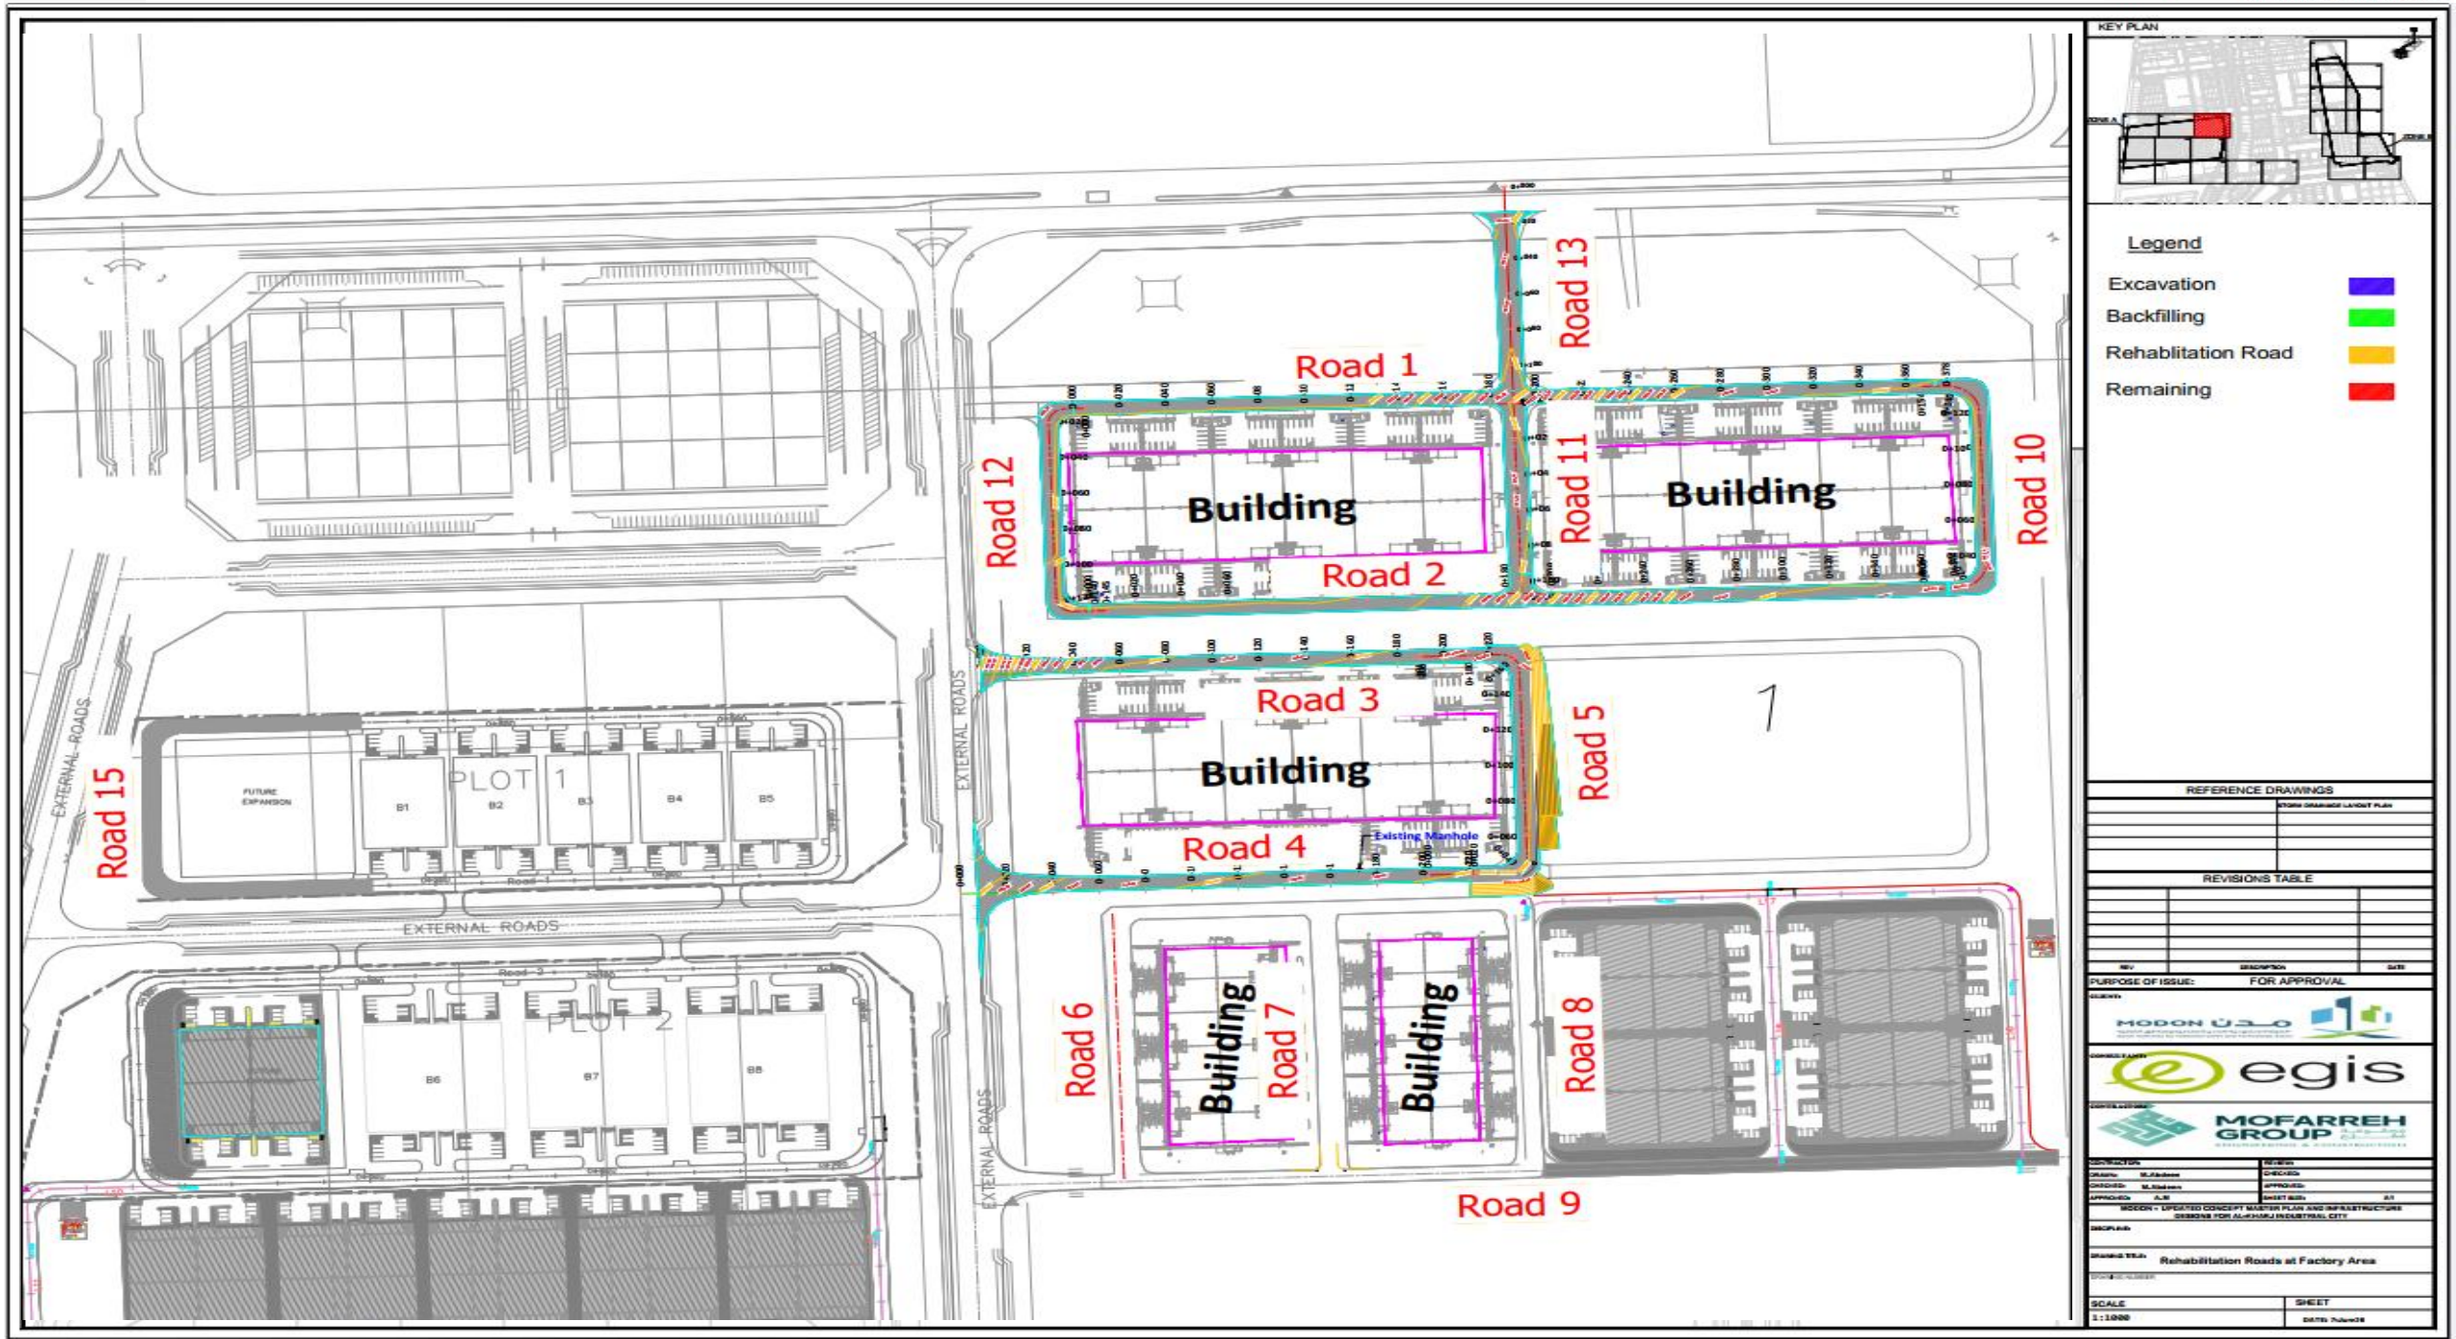

MATERIAL PROGRESS SHEET

Potable Network materials status							
SR	MATERIAL	UNIT	TOTAL QTY	DELIVERED	% DELIVERED	REMAINING QTY	% REMIAINING
1	HDPE PIPE DIA 160 mm	L.M	9,565.00	7,587.00	79.32%	1978	20.68%
2	HDPE PIPE DIA 200 mm	L.M	11,490.00	9,396.00	81.78%	2094	18.22%
3	HDPE PIPE DIA 250 mm	L.M	8,764.00	8,052.00	91.88%	712	8.12%
4	HDPE PIPE DIA 315 mm	L.M	372.00	372.00	100.00%	0	0.00%
5	HDPE PIPE DIA 355 mm	L.M	72.00	72.00	100.00%	0	0.00%
6	DI VALVES	EA	306.00	213.00	69.61%	93	100.00%
7	Fire hydrant	EA	310.00	82.00	26.45%	228	200.00%
TSE Network materials status							
SR	MATERIAL	UNIT	TOTAL QTY	DELIVERED	% DELIVERED	REMAINING QTY	% REMIAINING
1	HDPE PIPE DIA 110 mm	L.M	27,889.00	27,756.00	99.52%	133	0.48%
2	HDPE PIPE DIA 160 mm	L.M	357.00	0.00	0.00%	357	100.00%
3	DI VALVES	EA	211.00	50.00	23.70%	161	76.30%
Secondary Irrigation Network materials status							
SR	MATERIAL	UNIT	TOTAL QTY	DELIVERED	% DELIVERED	REMAINING QTY	% REMIAINING
1	HDPE PIPE DIA 90 mm	L.M	1,126.00	900.00	79.93%	226.00	0.20
2	HDPE PIPE DIA 75 mm	L.M	247.00	0.00	0.00%	247.00	1.00
3	HDPE PIPE DIA 63 mm	L.M	1,254.00	0.00	0.00%	1,254.00	100.00%
4	HDPE PIPE DIA 50 mm	L.M	10,859.00	0.00	0.00%	10,859.00	100.00%
5	HDPE PIPE DIA 32 mm	L.M	37,259.00	0.00	0.00%	37,259.00	100.00%
6	UPVC PIPE 32 MM	L.M	27,800.00	24,684.00	88.79%	3,116.00	11.21%
Telecom Network materials status							
SR	MATERIAL	UNIT	TOTAL QTY	DELIVERED	% DELIVERED	REMAINING QTY	% REMIAINING
1	HDPE PIPE DIA 50 mm	L.M	224,688.00	209,792.00	93.37%	14896	6.63%
2	HDPE PIPE DIA 32 mm	L.M	66,692.00	66,962.00	100.40%	-270	-0.40%
3	HDPE PIPE DIA 16 mm	L.M	900.00	900.00	100.00%	0	0.00%
Electrical Network materials status							
SR	MATERIAL	UNIT	TOTAL QTY	DELIVERED	% DELIVERED	REMAINING QTY	% REMIAINING
1	UPVC PIPE DIA 150 mm	L.M	9,643.00	9,643.00	100.00%	0	0.00%
2	HDPE PIPE DIA 110 mm	L.M	66,692.00	0.00	0.00%	66692	100.00%
3	HDPE PIPE DIA 16 mm	L.M	900.00	0.00	0.00%	900	100.00%
4	UPVC PIPE 110 MM	L.M	4800	4,800.00	100.00%	0	0.00%
5	MV cable (3CX500mm²)	L.M	72000	40,500.00	56.25%	31500	43.75%
6	Foundation for Street Light Poles	EA	981	680.00	69.32%	301	30.68%
5	LV cable (4CX16mm²+4CX95mm²)	L.M	51082	9,800.00	19.18%	41282	80.82%

ENGINEERING STATUS

Shop Drawings Status

15/10/2026

Row Labels	A	B	C	D	UR	Grand Submitted Total	Total Required shd	Remainig	Req. As built	Actual remaing Remarks
ARC	38	37	0	0	7	82	82	0	75	DONE
CBC	50	23	0	0	0	73	73	0	73	DONE
CIV	3	5	0	0	0	8	8	0	8	DONE
ELE	30	48	4	0	0	82	82	0	82	DONE
MV	0	40	0	0	0	40	40	0	40	SUBMITTED TO EGIS For Information
HVA	0	9	0	0	0	9	9	0	9	DONE
IRR	35	137	0	0	0	172	172	0	172	DONE
LOG	0	3	0	0	0	3	3	0	0	DONE
LSC	23	28	0	0	0	51	56	5	56	DONE
MEP	8	11	0	0	0	19	19	0	19	DONE
POT	40	118	0	0	0	158	158	0	158	DONE
ROD	20	1036	0	0	0	1056	1078	22	500	DONE
SEW	0	93	0	0	0	93	93	0	93	DONE
ST	26	118	0	0	0	144	144	0	111	DONE
STR	23	128	0	0	0	151	151	0	151	DONE
TEL	11	17	0	0	0	28	28	0	28	DONE
FFS	0	11	0	0	0	11	11	0	11	DONE
Grand Total	307	1862	4	0	7	2180	2207	27	1586	
Percentage	14%	84%	0%	0%	0%	99%		1%		

Regarding the As-Built drawings, we have already prepared 179 DWGs for As-Built. However, the site is not yet ready for their official submission.