egis / MOFARREH GROUP	Document Title:	**DOCUMENT SUBMISSION FORM**		MODON
	Project Name:	Development of Infrastructure in Alkharj Industrial City.	Project Contractor:	MOFARREH GROUP
	Project Number:	KHJ1-02-007	Project Consultant:	EGIS
	Project Program Manager:		Document Reference No.:	KHJ1-02-007-MAH-TS9-1-PRM-WPR-0043-00

DOCUMENT ISSUED BY		DOCUMENT RECEIVED BY	
Issued By	Hassan Salam	Received By	
Position / Company	Project Manager	Position / Company	
Signature		Signature	
	October 28 2026 Time 09:30 AM	Date	Time

CPP MODON (2025.13) KHJ1-02-007

RECEIVED 28 OCT 2026

DOCUMENT SUBMISSION TYPE *(Tick relevant Box)*

	As Built		Material Sample		Bill of Quantities
	Certificate		Manual		Schedule
	Drawing		Pre-qualification		Shop Drawing
	Engineering Calculation		Procedure/Methodology		Bank Warranty
	Job Order		Product Data		Letter
■	Report		Test Report		Other

PURPOSE FOR DOCUMENT SUBMISSION				DATE RESPONSE REQUIRED BY
FOR INFORMATION ☐	FOR REVIEW & APPROVAL ■	AS REQUESTED ☐	OTHER *(As Noted)* ☐	*Indicate Date*

SUBMITTED DOCUMENTS REFERENCE NUMBERS

#	Document Reference No.	Document Description	Rev.	Hard Copy	Soft Copy
1	KHJ1-02-007-MAH-TS9-1-PRM-WPR-0043	Weekly Progress Report (October 26, 2026)	00		

To continue List - use "Submittal Continuation Form"(MOD-DOC-10.0-002)

RESPONSE STATUS

APPROVED AS SUBMITTED (APP)	APPROVED AS NOTED (APN)	REJECTED / RE-SUBMIT (RRS)
☐	■	☐

COMMENTS

Contractor has to comply comments sheet (CRS) attached.

To continue Comments - use "Submittal Continuation Form"(MOD-DOC-10.0-002)

RESPONSE ISSUED BY		RESPONSE RECEIVED BY	
Issued By		Received By	
Position / Company		Position / Company	
Signature		Signature	
Date	Time	Date	Time

Egis Saudi Engineering Consultancy C.R.1010596943

RECEIVED 28 OCT 2026 MAH

DAR CM Team	Action 1 (Initials)	Date / Time	Action 2 (Initials)	Date / Time	Action 3 (Initials)	Date / Time	Action 4 (Initials)	Date / Time	DAR CM Target Response - Work Days

KHJ1-02-007-MAH-TS9-1-PRM-WPR-0043-00

CRS Industrial City Weekly Report Oct 26, 2026.

1. The Issues log shows Contract Milestones as Open with an expected closure date of 30/08/2026, which has passed. The Overall delay against approved baseline issue is marked Closed, while Milestones shows forecast delays of 36 days for road works and 29 days for the medium-voltage network.

2. For October 2026, planned manpower is 677 versus actual 529, a shortfall of 148 people (approximately 21.9% below plan). In Weekly Manpower, Actual values are pulled by HLOOKUP from the monthly manpower table, causing the same monthly value to repeat across weeks rather than showing independent weekly measurements.

3. Material delivery dates are inconsistent or chronologically invalid. For example, some rows start on 15/03/2026 and end on 08/01/2026, so the end date precedes the start; other rows show 30/08/2026 as an end date despite the report date being 26/10/2026. Actual and forecast delivery dates require validation.

4. For invoice no. 1, the period start is 15 December 2026 while the end date is 25 March 2026; the start is approximately 265 days after the end. Both dates require verification.

5. Project progress is inconsistent across worksheets. Quality-Stat reports cumulative planned/actual progress of 34.2%/35.2%, while Weekly Progress Report and SPI report 34.87%/35.91%. The differences are 0.67 and 0.71 percentage points respectively...

Yasser El naggar

Egis Saudi Engineering Consultancy C.R:1010596943


Data sensitivity - Public

Weekly Progress Report - Construction Projects	26-Oct-26
Contract General Information	
Project Name	Development Industrial City-Alkharj
Project ID	3121
Contractor	Moffreh Group
Consultant	EGIS
Stage	46th Week
Modon PM	Rakan Alotaibi
Key Dates	
Contract Award Date	09-Nov-25
Contract Sign Date	16-Nov-25
Site Handover Date	03-Dec-25
Original Completion	02-Dec-27
Contract Award Date (Hijri)	18/05/1447
Contract Sign Date (Hijri)	25/05/1447
Site Handover Date (Hijri)	12/06/1447
Original Completion (Hijri)	04/07/1449
Revised Completion Date	02-Dec-27
Committed Completion Date	02-Dec-27
Forecast Completion	02-Dec-27
Variance	0

Data sensitivity - Public

CUT & FILL LAYOUT ZONE-A

ZONE A(Cumulative Qty)				
ITEM	Total Quantity (m3)	Excuted Quantity (m3)	Remaining Quantity (m3)	Percentage %
Fill	357335	268632	88703	75.18%
Cut	97475	89831	7644	92.16%

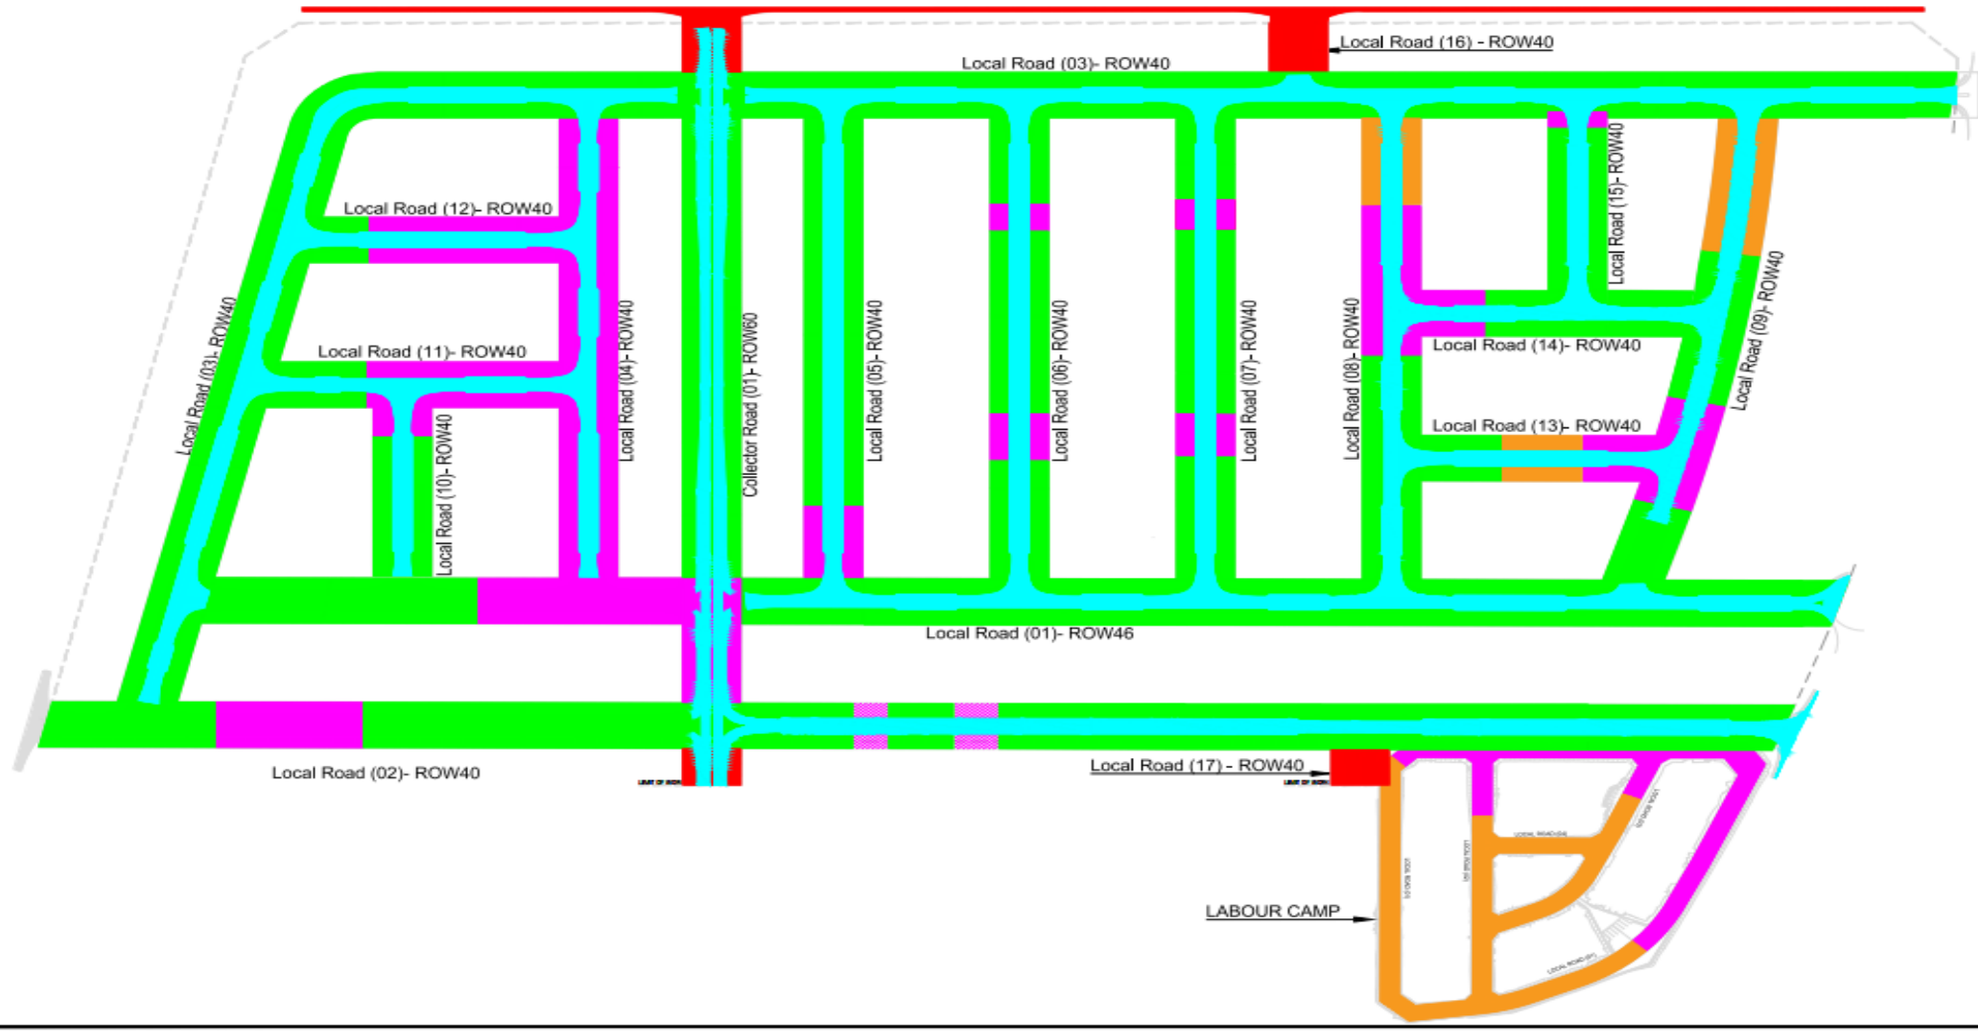

KEY PLAN



Legend

- Excuted Fill
- Excuted Cut
- Remaining Cut
- Remaining Fill
- Bottom Subgrade

0 10 20 30 40 50 100 METERS
SCALE (A1) 1:1000

REFERENCE DRAWINGS

REVISIONS TABLE

REV	DESCRIPTION	DATE

PURPOSE OF ISSUE: FOR APPROVAL

MODON

egis

MOFARREH GROUP

CONTRACTOR		REVIEW	
DRAWN	RBZ	CHECKED	
CHECKED	NAA	APPROVED	
APPROVED	KTW	SHEET SIZE	A1

DESIGN, UPDATES, CONCEPTUAL AND DETAILED DESIGNS FOR ALKHAFJI INDUSTRIAL CITY

DISCIPLINE: Weekly Progress

DRAWING TITLE: FILL-ZONE A


DRAWING NUMBER:

SCALE	Date
1:1000	

BACKFILLING LAYOUT ZONE-B

ZONE B (CUT&FILL) PROGRESS

ITEM	Total Quantity (m3)	Excuted Quantity (m3)	Remaining Quantity (m3)	Percentage %
Fill	499555	300000	199555	60.05%
Cut	40190	36189	4001	90.04%

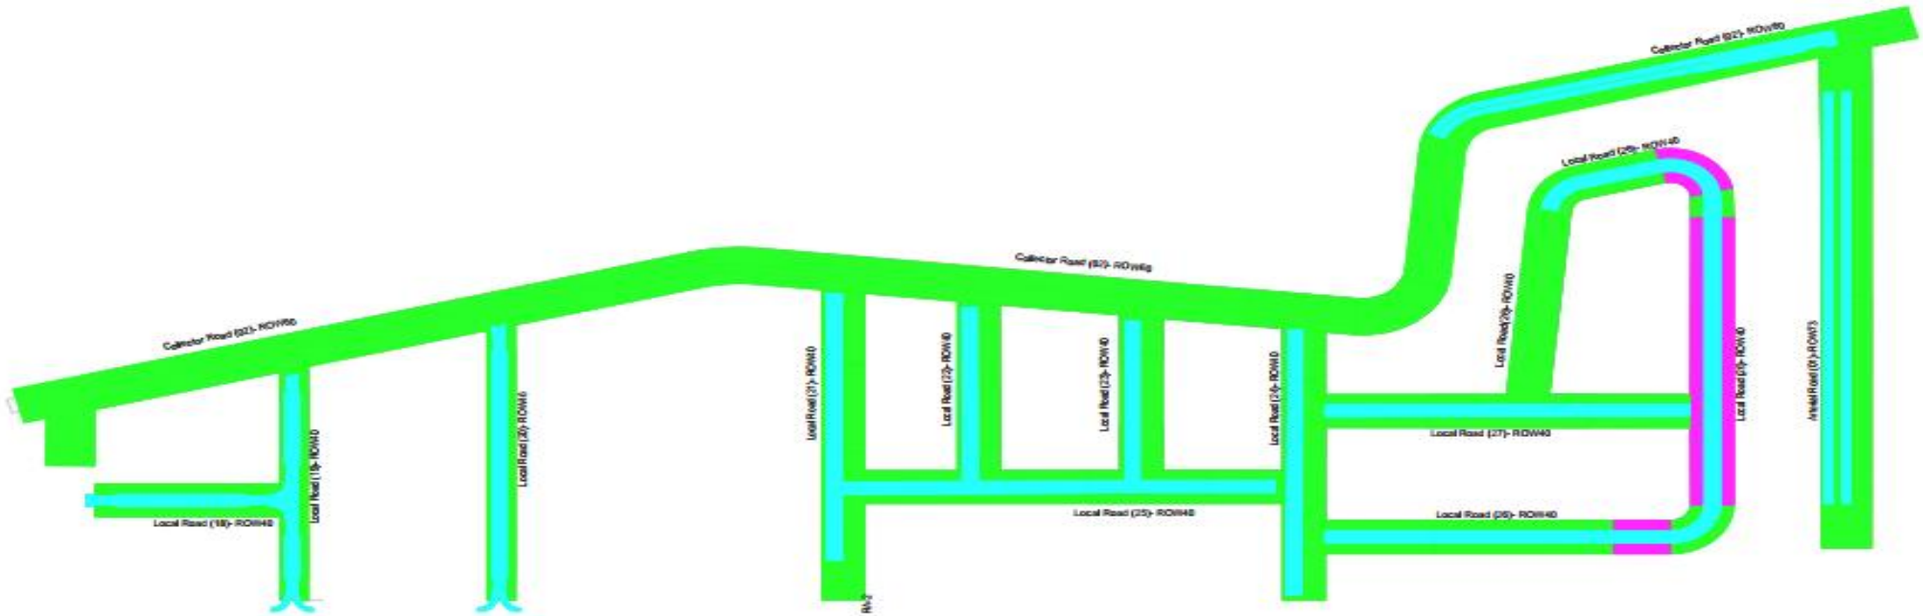

KEY PLAN



Legend

- Executed Fill
- Executed Cut
- Remaing Fill
- Bottom Subgrade

0 10 20 30 40 50 100 METERS

SCALE (A1) 1:1000

REFERENCE DRAWINGS

REVISIONS TABLE

PURPOSE OF ISSUE: FOR APPROVAL

Weekly Progress


Layout - Zone B

SCALE 1:1000

Date

ROAD LAYOUT ZONE-A

ZONE A				
ITEM	Total Quantity (m3)	Excuted Quantity (m3)	Remaining Quantity (m3)	Percentage %
Subgrade	82330.47	73996.000	8334.472	89.88%
Aggregate BaseCourse	52379.08	35604.000	16775.078	67.97%
Asphalt Binder Course	19244.50	12211.000	7033.498	63.45%
Asphalt Wearing Course	12399.96	0.000	12399.958	0.00%

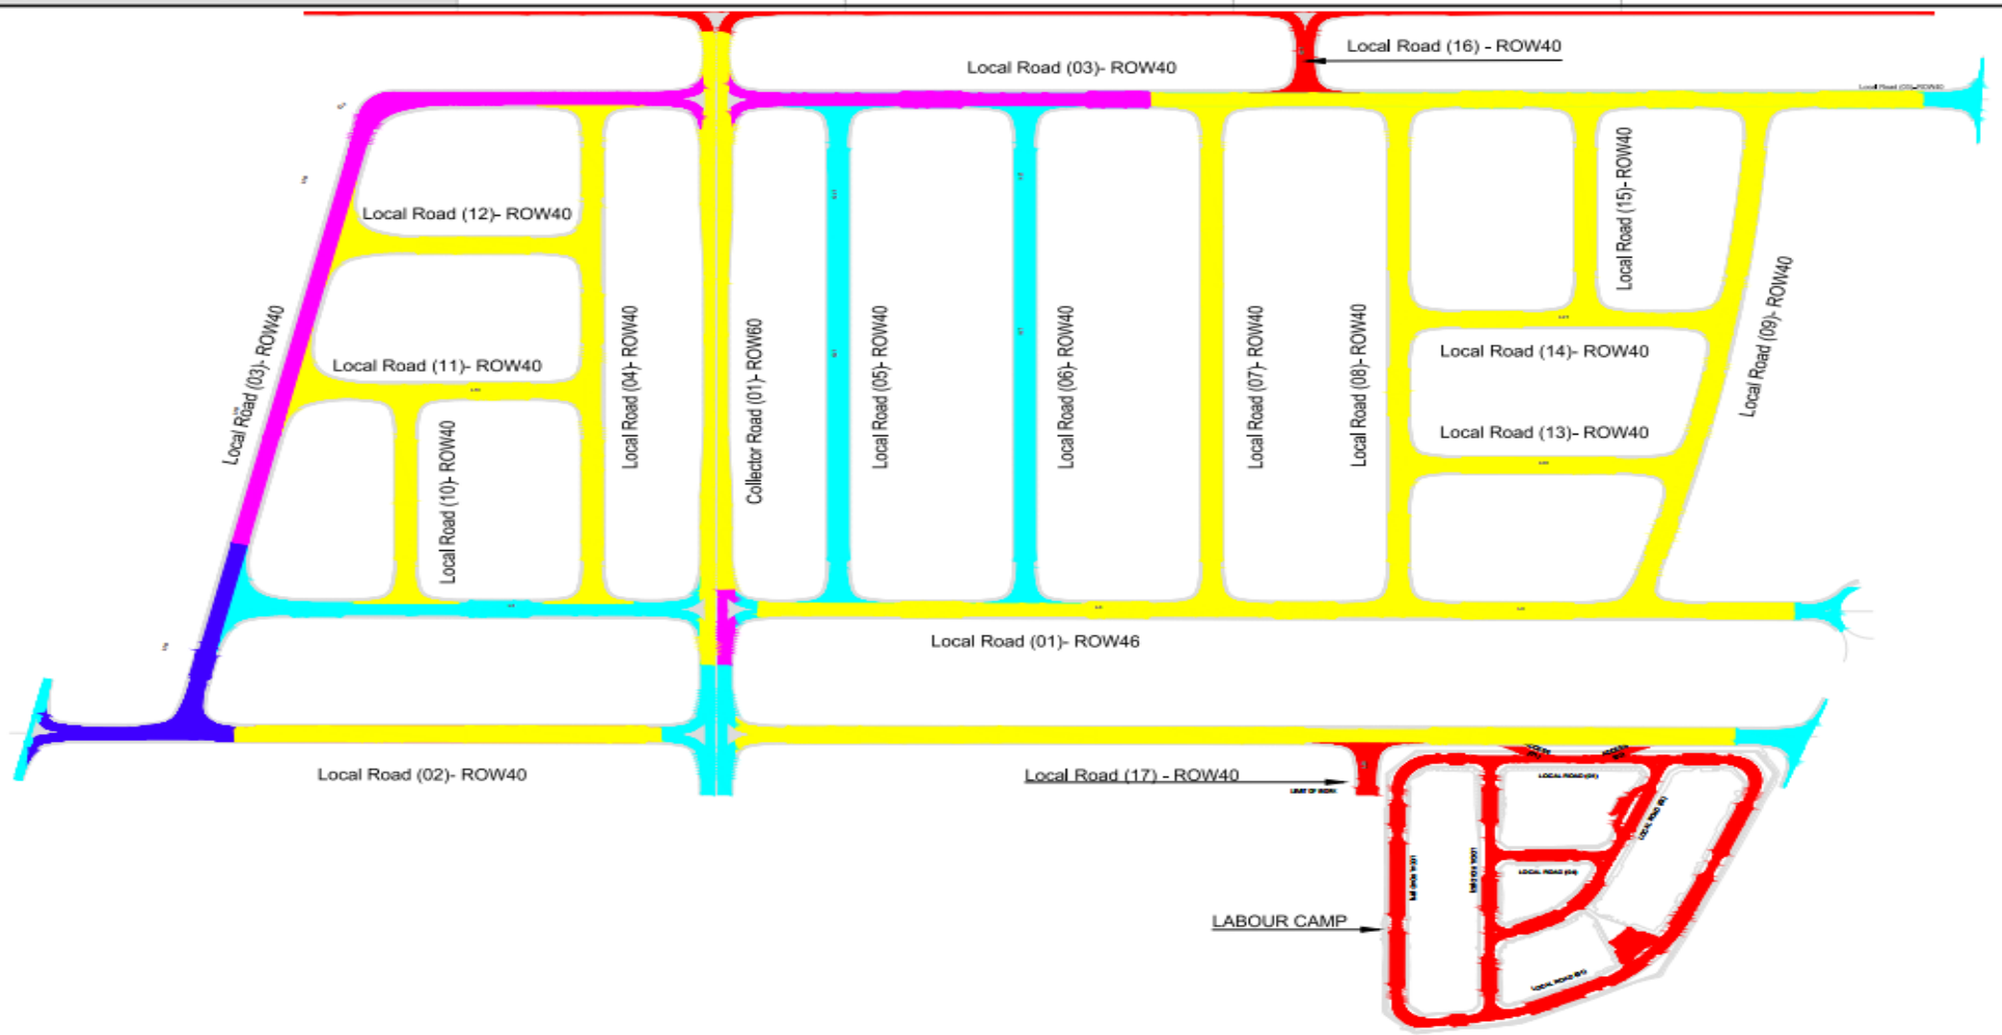

KEY PLAN



Legend

- Bottom Subgrade
- Subgrade
- Aggregate Base Course
- Asphalt Binder Course
- Asphalt Wearing Couse
- Remaining

0 10 20 30 40 50 100 METERS

SCALE (A1) 1:1000

REFERENCE DRAWINGS

REVISIONS TABLE

REV.	DESCRIPTION	DATE

PURPOSE OF ISSUE: FOR APPROVAL

MODON

egis

MOFARREH GROUP


Weekly Progress

ROAD PROGRESS LAYOUT-ZONE A

SCALE 1:1000

ROAD LAYOUT ZONE-B

ROAD ACTIVATES PROGRESS ZONE B				
ITEM	Total Quantity	Excuted Quantity	Remaining Quantity	Percentage %
Subgrade(M3)	78595.25	70682.000	7913.246	89.93%
Aggregate BaseCourse(M3)	47537.25	34715.000	12822.252	73.03%
Asphalt Binder Course + MC(M3)	24947.75	16303.000	8644.748	65.35%
Asphalt Wearing Course + RC (M3)	11204.81	0.000	11204.809	0.00%

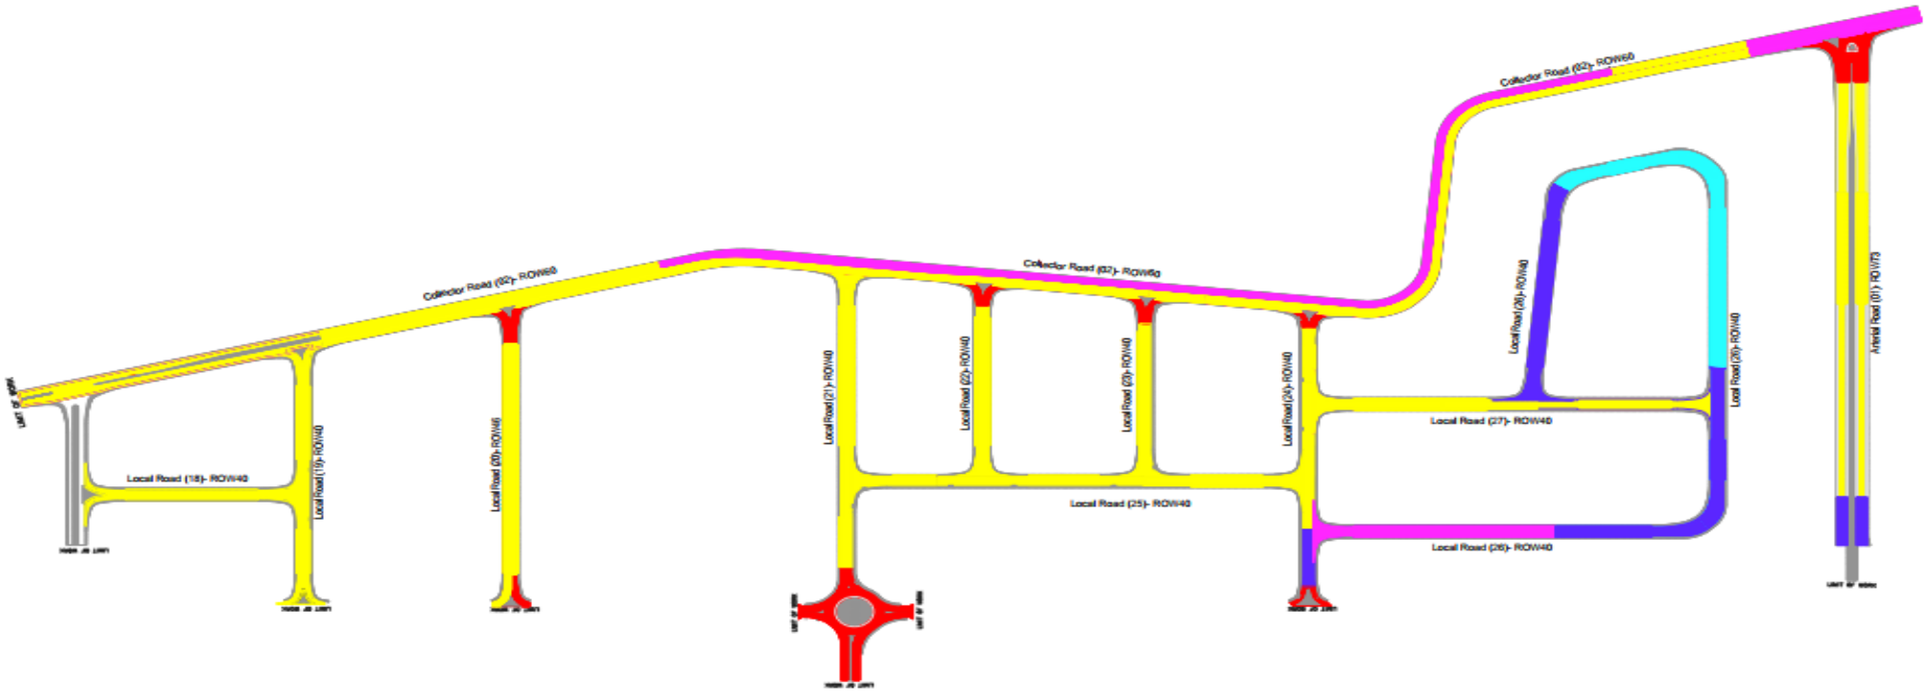

KEY PLAN



Legend

- Bottem Subgrade
- Subgrade
- Aggregate Base Course
- Asphalt Binder Course
- Asphalt Wearing Course
- Work Remaining

REFERENCE DRAWINGS

REVISIONS TABLE

REV	DESCRIPTION	DATE

PURPOSE OF ISSUE: FOR APPROVAL

CLIENT: MODON

CONSULTANT: egis

CONTRACTOR: MOFARREH GROUP

CONTRACTOR		SIGNATURE	
CREATED	RIZ	CHECKED	
CHECKED	NAA	APPROVED	
APPROVED	KTW	SHEET SIZE	A1

MODON - UPDATE TO CONCEPTUAL MASTER PLAN AND INFRASTRUCTURE DESIGNS FOR AL-KHARJ INDUSTRIAL CITY

DISCIPLINE: Weekly Progress

DRAWING TITLE: LAYOUT-ZONE B

DRAWING NUMBER:

SCALE: 1:1000

Date:

SEWER NETWORK PROGRESS LAYOUT ZONE-A

ZONE A (Sewer)				
ITEM	Total Quantity (LM)	Executed Quantity (LM)	Remaining Quantity (LM)	Percentage %
Excavation	14307.84	13805.589	502.251	96.49%
Bedding	14307.84	12837.480	1470.360	89.72%
Installation	14307.84	11540.609	2767.231	80.66%
Backfilling	14307.84	7258.389	7049.451	50.73%



KEY PLAN



Legend

- Excavation
- Bedding
- Installation
- Backfilling
- Remaining

REFERENCE DRAWINGS

REVISIONS TABLE

REV.	DESCRIPTION	DATE

PURPOSE OF ISSUE: FOR APPROVAL

MODON

egis

MOFARREH GROUP ENGINEERING & CONSTRUCTION

CONTRACTOR:	REVIEW:
DRAWN: M.Nadeem	CHECKED:
CHECKED: M.Nadeem	APPROVED:
APPROVED: A.M	SHEET SIZE: A1

MODON - SPECIFIC CONCEPT MASTER PLANNING AND INFRASTRUCTURE DESIGNS FOR AL-KHALIJ INDUSTRIAL CITY

DISCIPLINE: SEWER NETWORK SYSTEM

DRAWING TITLE: SEWER NETWORK LAYOUT ZONE A


DRAWING NUMBER:

SCALE: 1:1000

DATE:

SEWER NETWORK PROGRESS LAYOUT ZONE-B

(SEWER) PIPE PROGRESS ZONE B				
ITEM	Total Quantity (LM)	Excuted Quantity (LM)	Remaining Quantity (LM)	Percentage %
Excavation	7539	5946.07	1592.93	78.87%
Bedding	7539	5946.07	1592.93	78.87%
Installation	7539	5927.88	1611.12	78.63%
Backfilling	7398	4833.53	2564.47	65.34%

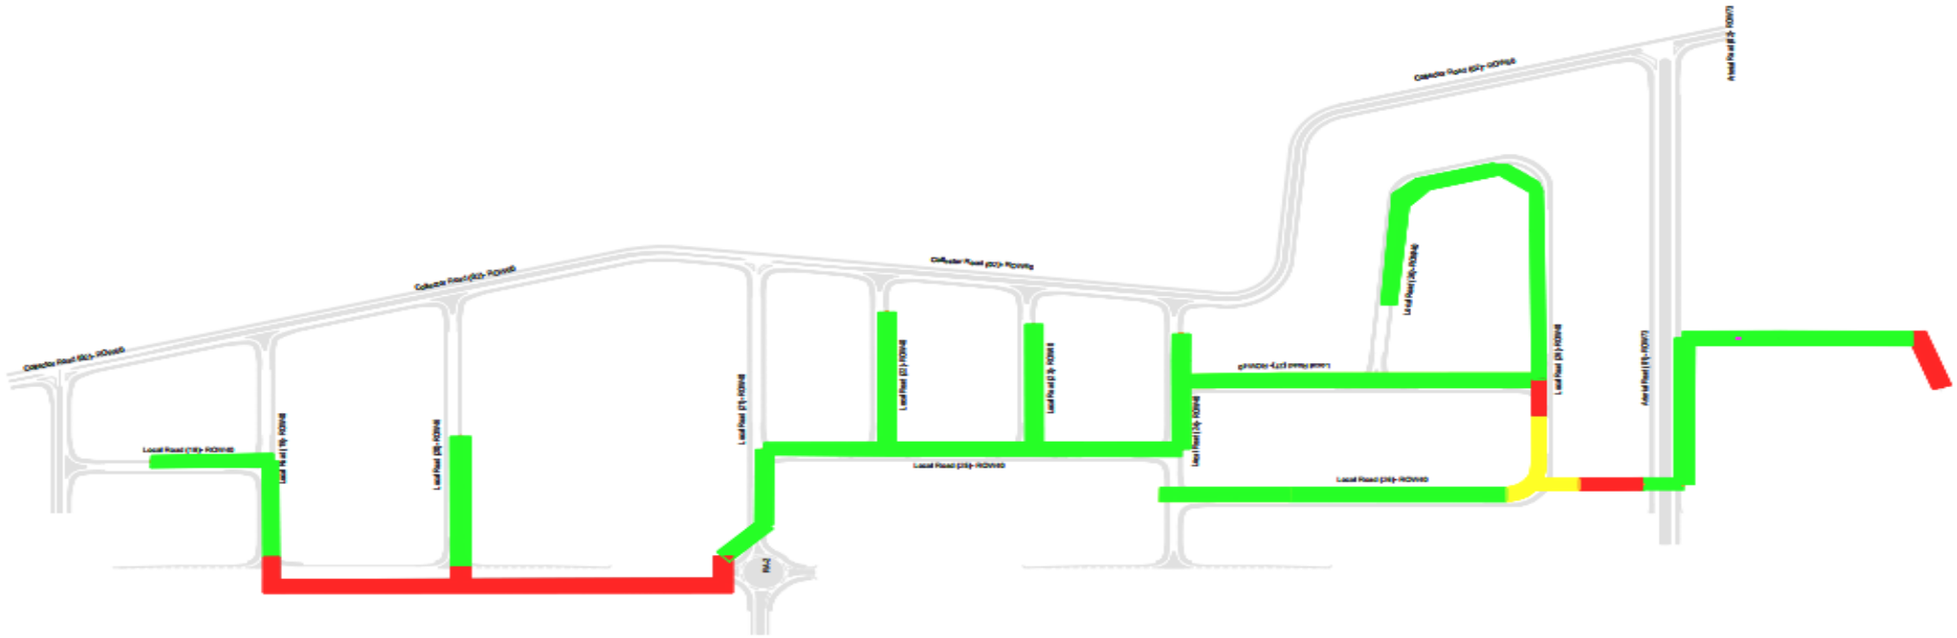

KEY PLAN



Legend

- Excavation
- Bedding
- Installation
- Backfilling
- Remaining


REFERENCE DRAWINGS

REVISIONS TABLE

PURPOSE OF ISSUE: FOR APPROVAL

SEWER MANHOLE PROGRESS LAYOUT ZONE-A

ZONE A (Sewer Manhole)				
ITEM	Total Quantity (EA)	Executed Quantity (EA)	Remaining Quantity (EA)	Percentage %
Excavation	286	188	99	65.56%
Blinding	286	165	121	57.69%
Installation	286	160	127	55.77%
Backfilling	286	113	173	39.51%

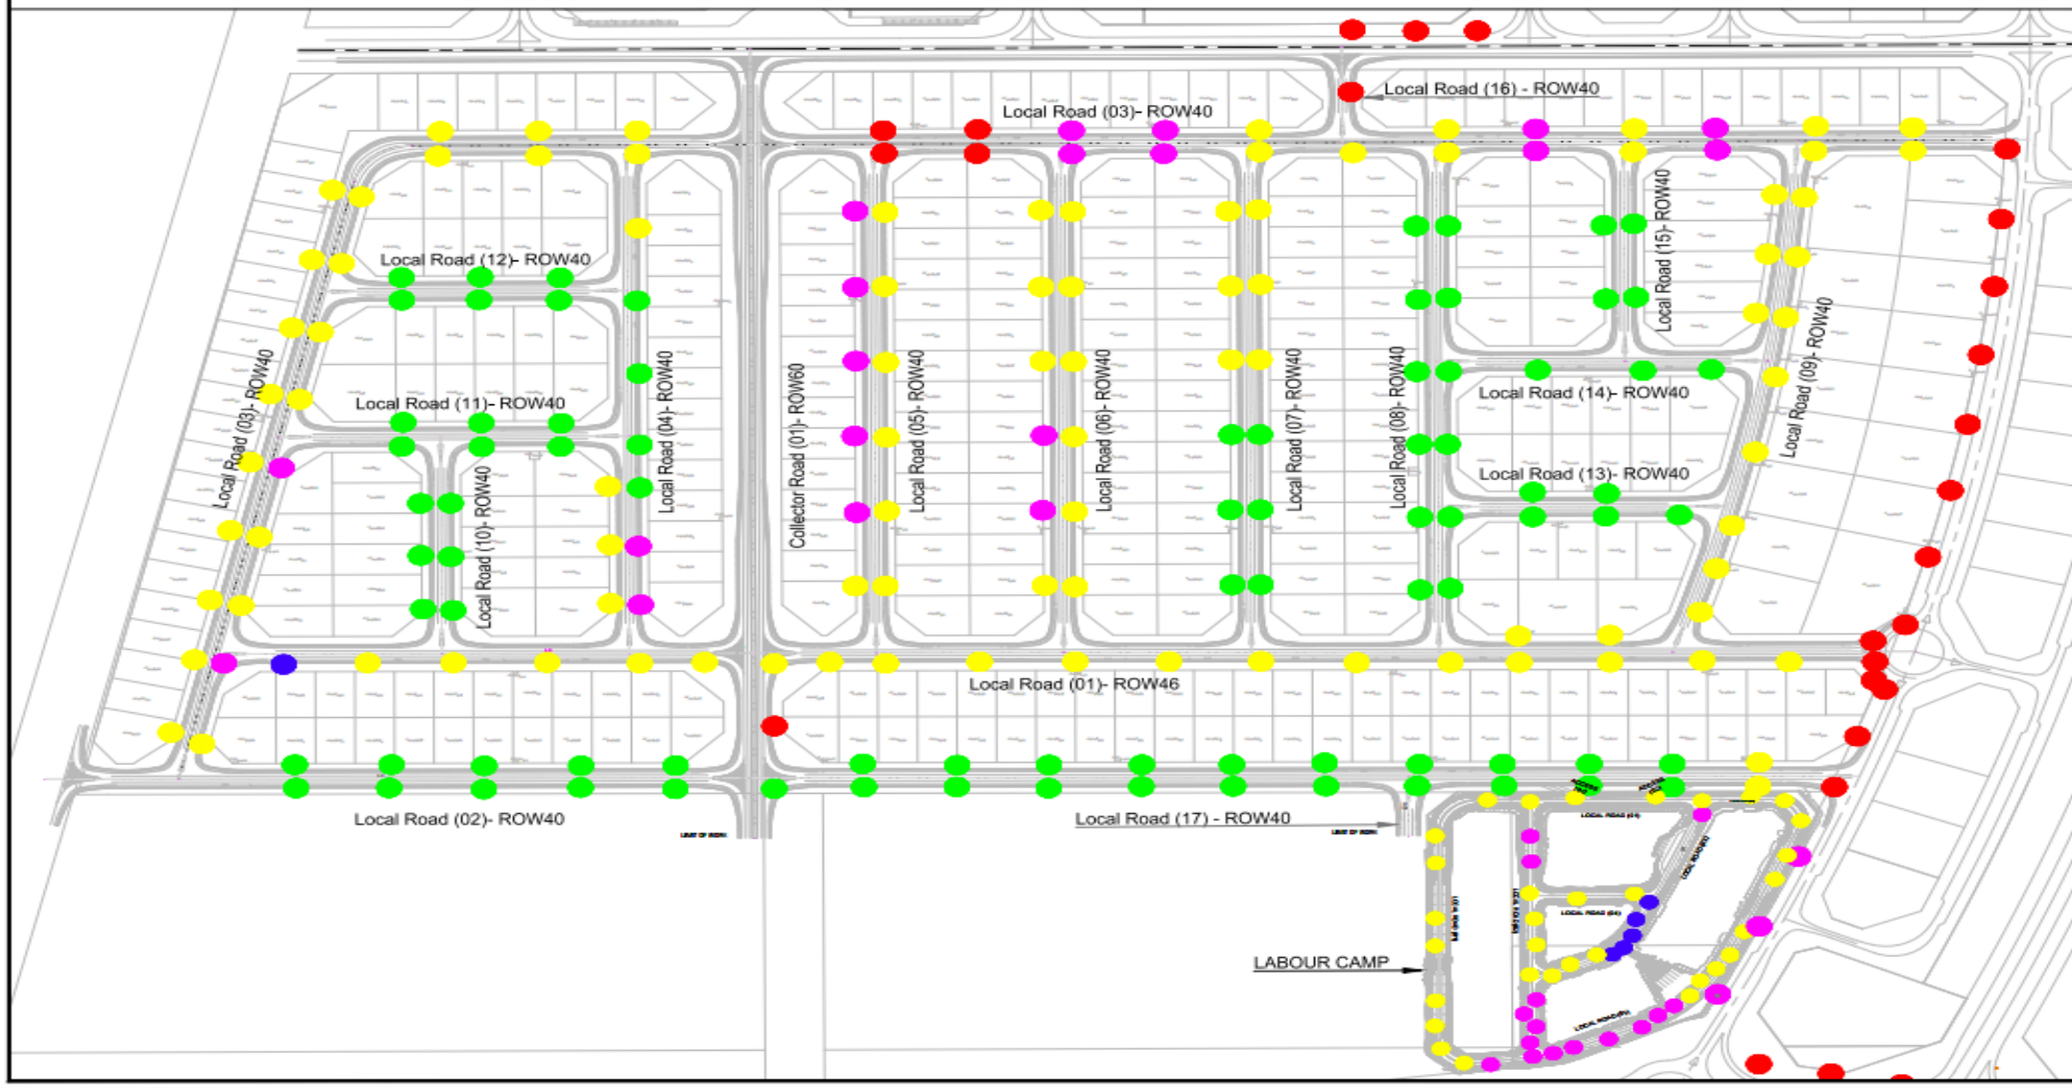



Legend

- Excavation
- Blinding
- Installation
- Backfilling
- Remaining

REFERENCE DRAWINGS

REVISIONS TABLE

PURPOSE OF ISSUE: FOR APPROVAL

MODON

egis

MOFARREH GROUP

SEWER NETWORK SYSTEM

SEWER MANHOLE PROGRESS LAYOUT ZONE-A

SCALE 1:1000

SEWER MANHOLE PROGRESS LAYOUT ZONE-B

ZONE B (Sewer Manhole) Progress				
ITEM	Total Quantity (EA)	Executed Quantity (EA)	Remaining Quantity (EA)	Percentage %
Excavation	107	93	14	86.92%
Blinding	107	83	24	77.57%
Installation	107	83	24	77.94%
Backfilling	107	19	88	17.76%



KEY PLAN



Legend

- Excavation
- Blinding
- Installation
- Backfilling
- Remaining

REFERENCE DRAWINGS

REVISIONS TABLE

PURPOSE OF ISSUE: FOR APPROVAL

MODON

egis

MOFARREH GROUP ENGINEERING & CONSTRUCTION


SEWER NETWORK SYSTEM

SEWER NETWORK LAYOUT ZONE B

SCALE

STORM NETWORK PROGRESS LAYOUT ZONE-A

ZONE A (Storm)				
ITEM	Total Quantity (LM)	Excuted Quantity (LM)	Remaining Quantity (LM)	Percentage %
Excavation	14482	11417.411	3064.589	78.84%
Bedding	14482	11147.048	3334.952	76.97%
Installation	14482	10911.192	3570.808	75.34%
Backfilling	14482	7588	6894	52.39%

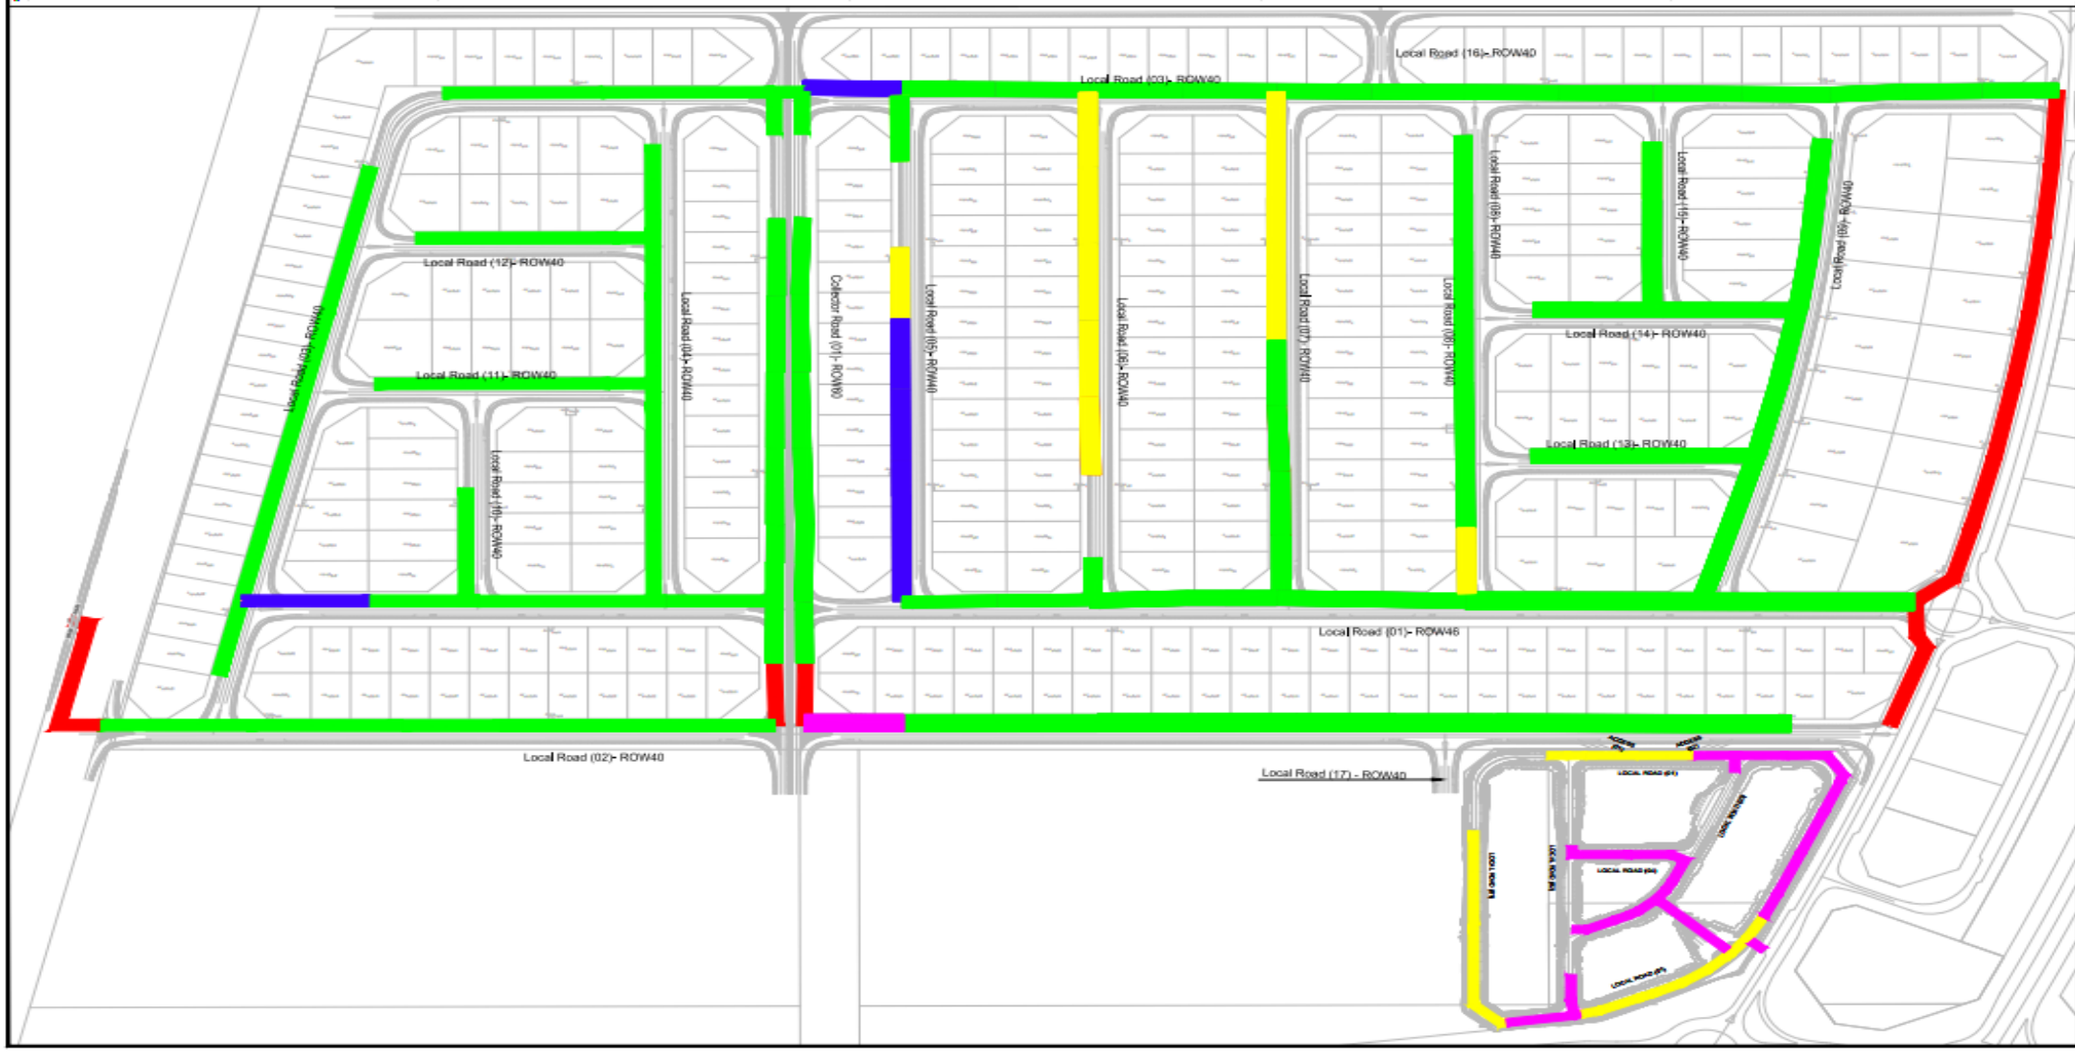

KEY PLAN



Legend

- Excavation
- Bedding
- Installation
- Backfilling
- Remaining

REFERENCE DRAWINGS

REVISIONS TABLE

PURPOSE OF ISSUE: FOR APPROVAL

MODON

egis


MOFARREH GROUP

SCALE 1:1000

SHEET

STORM NETWORK PROGRESS LAYOUT ZONE-B

(STORM) PIPE PROGRESS ZONE B				
ITEM	Total Quantity (LM)	Excuted Quantity (LM)	Remaining Quantity (LM)	Percentage %
Excavation	8544.19	7975.618	568.572	93.35%
Bedding	8544.19	7406.350	1137.840	86.68%
Installation	8544.19	6567.551	1976.639	76.87%
Backfilling	8544.19	3813.072	4731.118	44.63%

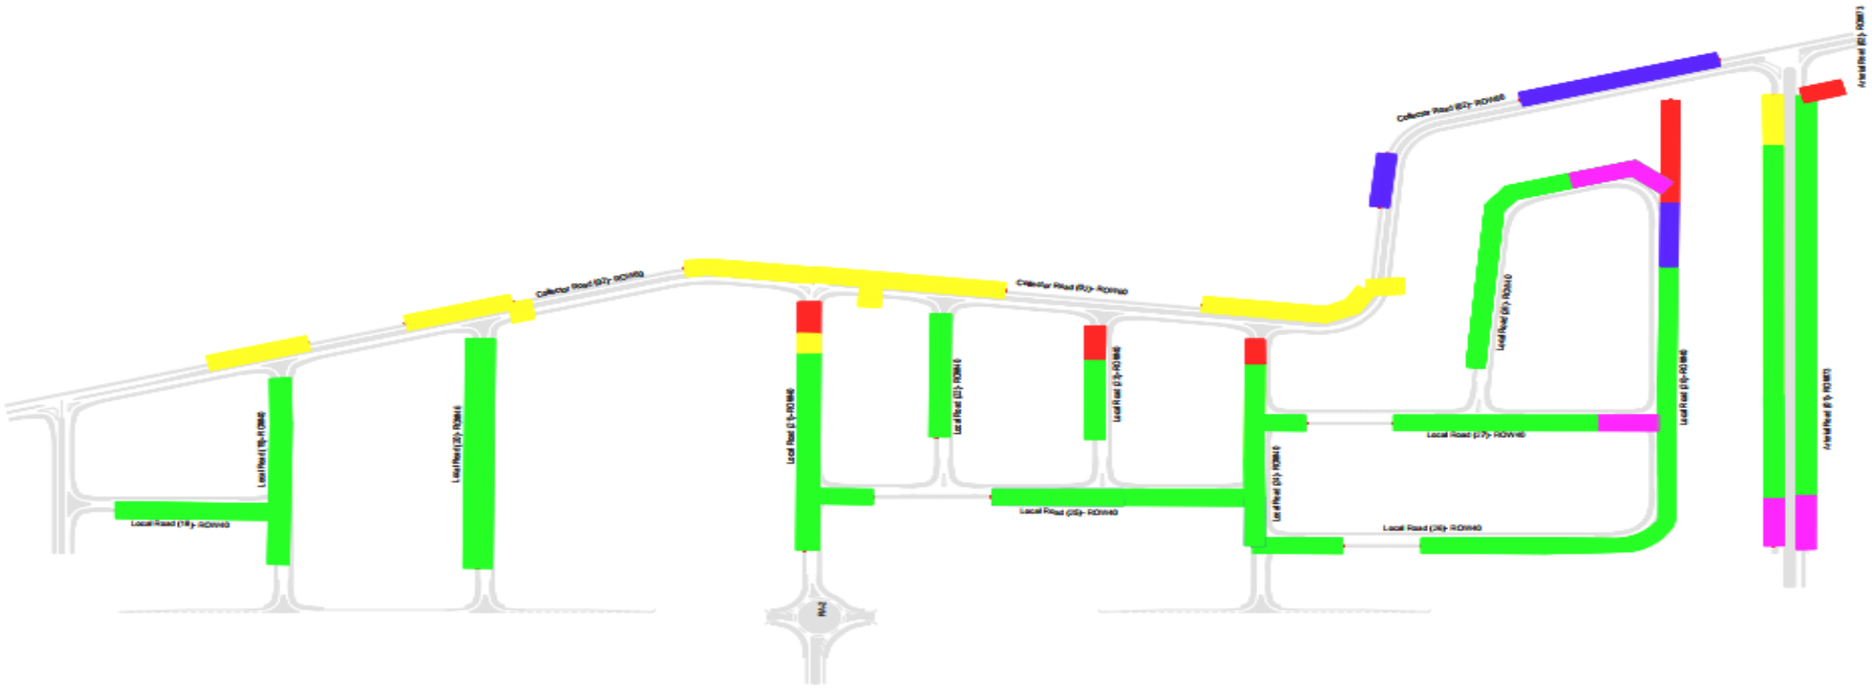

KEY PLAN



Legend

- Excavation
- Bedding
- Installation
- Backfilling

REFERENCE DRAWINGS

REVISIONS TABLE


PURPOSE OF ISSUE: FOR APPROVAL

SCALE 1:1000

SHEET of 0852

STORM MANHOLE PROGRESS LAYOUT ZONE-A

ZONE A + Labor Camp (Storm Manhole)				
ITEM	Total Quantity (EA)	Executed Quantity (EA)	Remaining Quantity (EA)	Percentage %
Excavation	194	134	60	69.07%
Blinding	194	127	67	65.46%
Installation	194	124	71	63.66%
Backfilling	194	65	129	33.51%

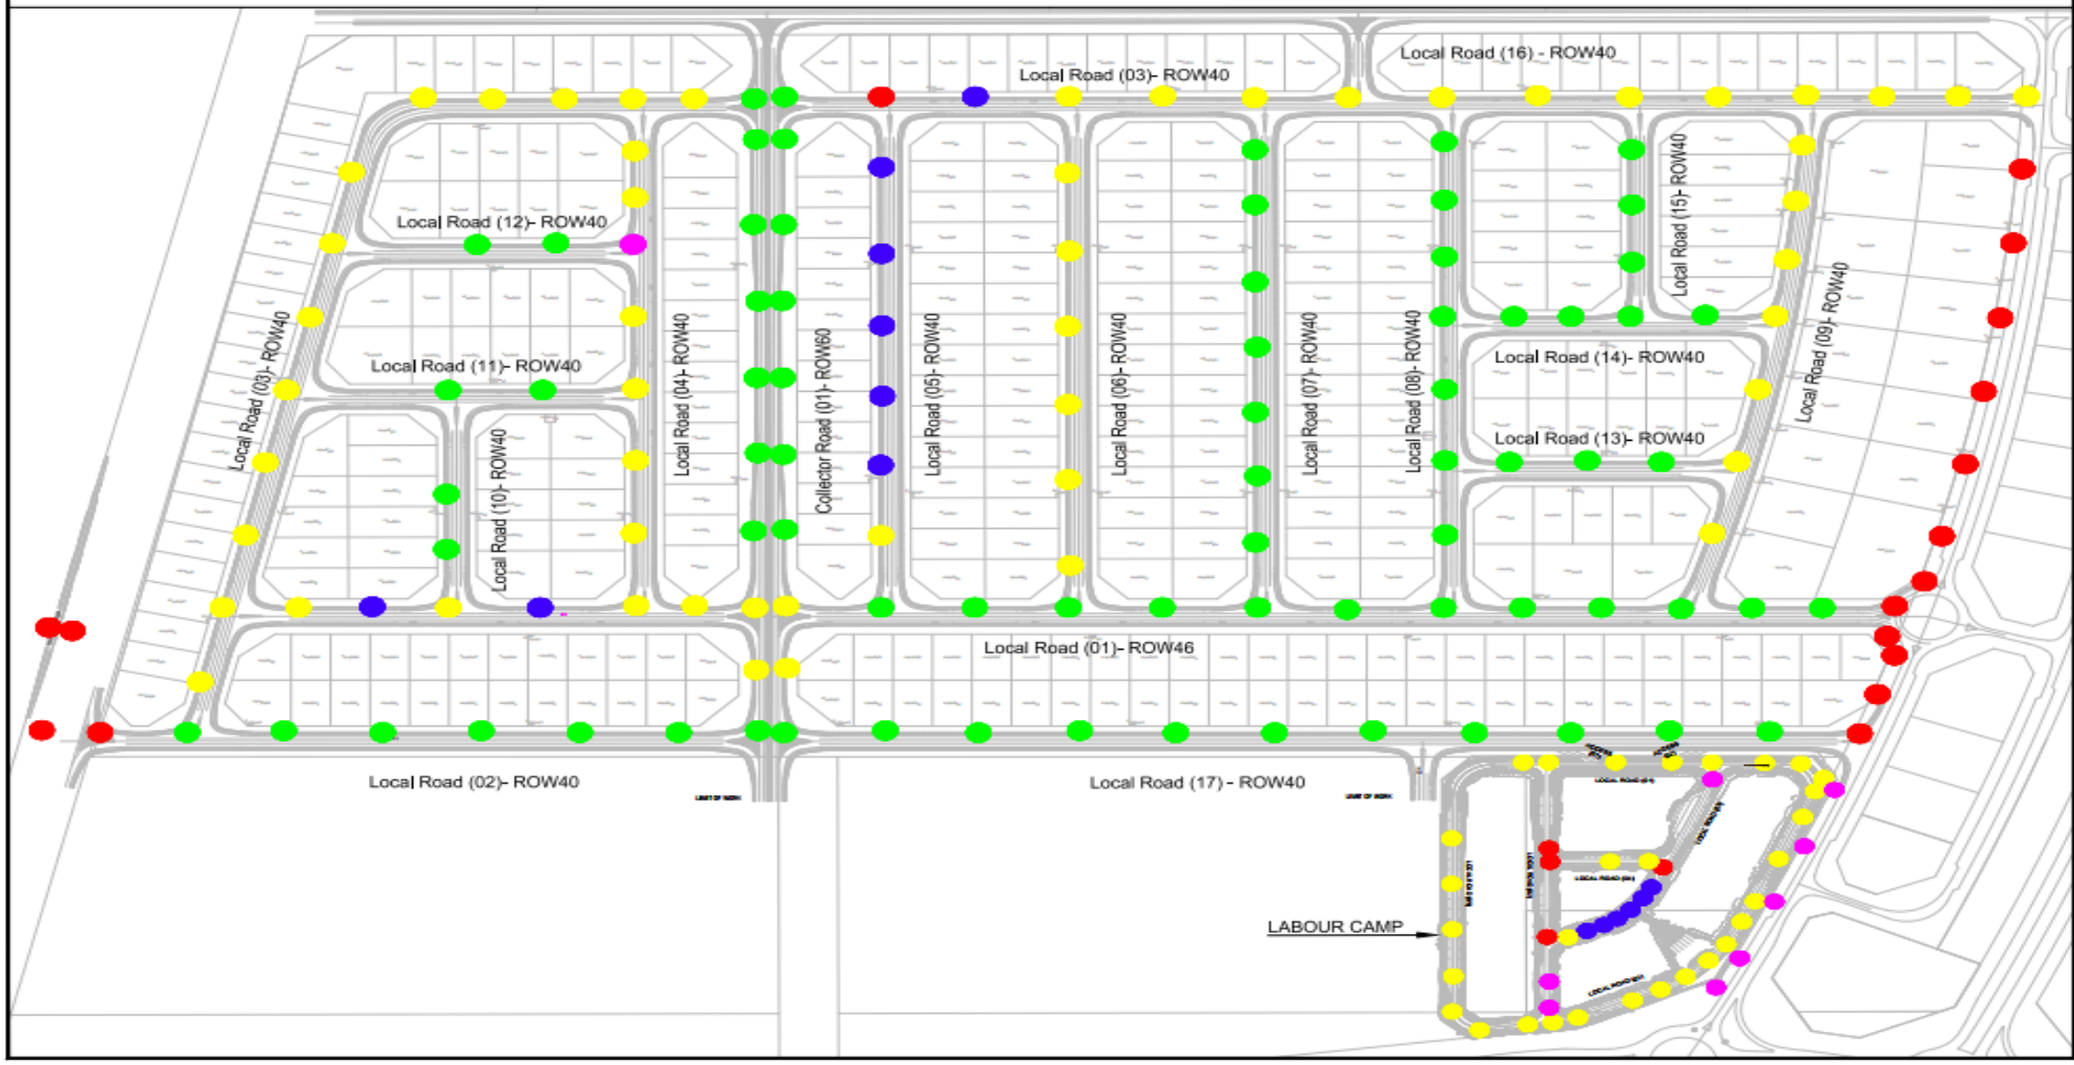



Legend

- Excavation
- Blinding
- Installation
- Backfilling
- Remaining

REFERENCE DRAWINGS

REVISIONS TABLE


PURPOSE OF ISSUE: FOR APPROVAL

SCALE 1:1000

SHEET

STORM MANHOLE PROGRESS LAYOUT ZONE-B

ZONE B (Storm Manhole) Progress				
ITEM	Total Quantity (EA)	Executed Quantity (EA)	Remaining Quantity (EA)	Percentage %
Excavation	104	94	10	90.38%
Blinding	104	88	16	84.62%
Installation	104	85	19	82.02%
Backfilling	104	25	79	24.04%

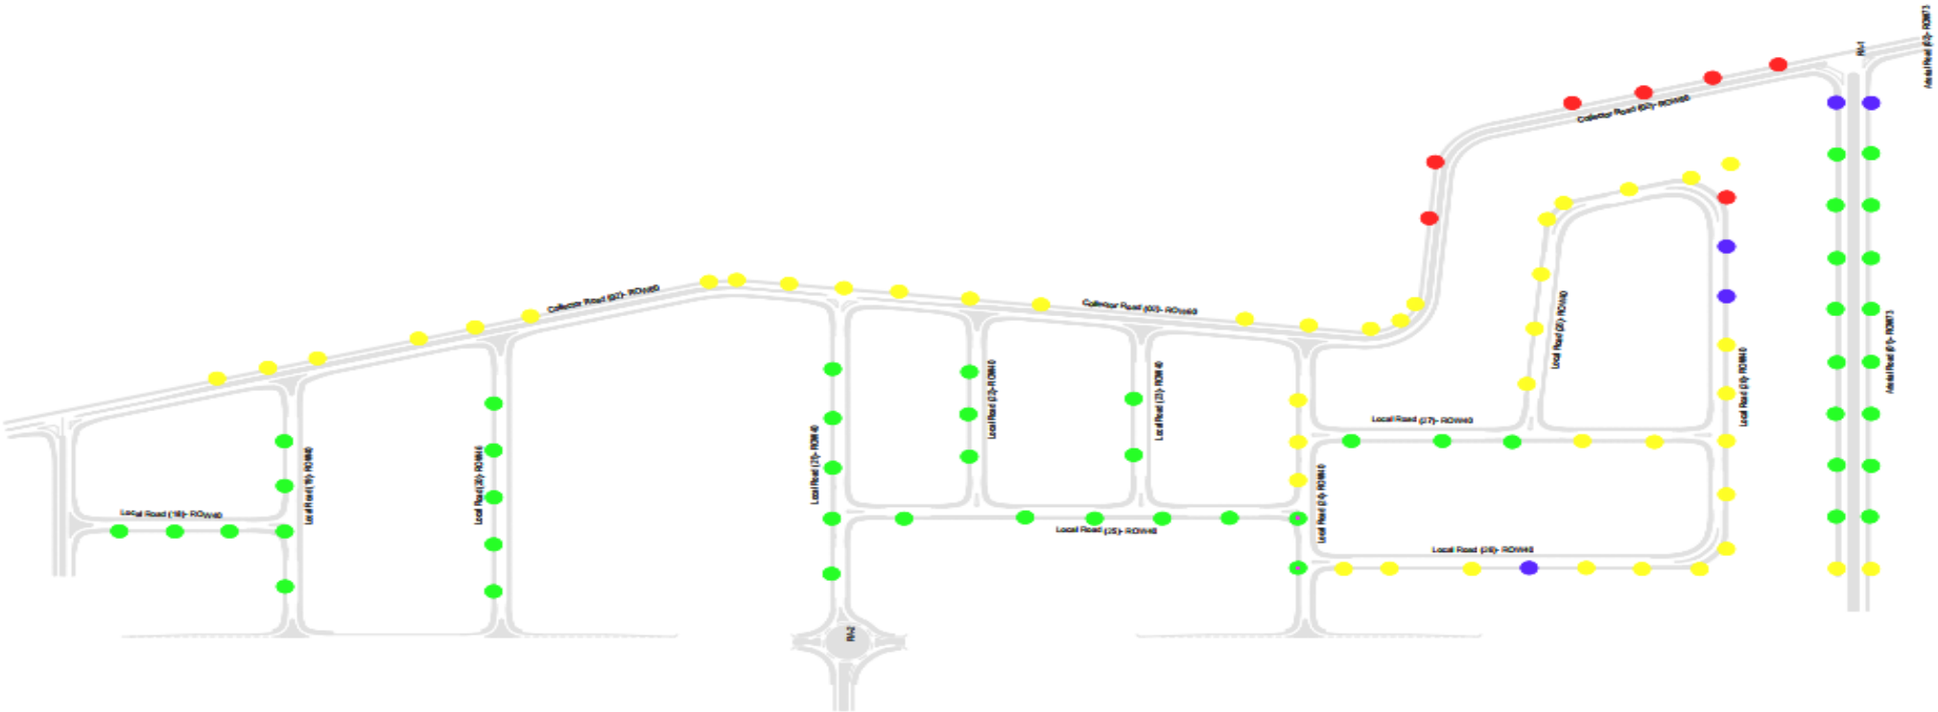

KEY PLAN



Legend

- Excavation
- Blinding
- Installation
- Backfilling
- Remaining

REFERENCE DRAWINGS

REVISIONS TABLE

REV	DESCRIPTION	DATE

PURPOSE OF ISSUE: FOR APPROVAL

CONTRACTOR:	
Drawn: M.Abdeen	CHECKED:
CHECKED: M.Abdeen	APPROVED:
APPROVED: A.M	SHEET SIZE: A1


DISCIPLINE: STORM DRAINAGE SYSTEM


DRAWING TITLE: STORM DRAINAGE LAYOUT PLAN ZONE B

DRAWING NUMBER: KKIC1-02-DRT-MSH-TSS-1-REP-DMS-SD-00-2016 B-02

SCALE	SHEET
1:1000	of 0052

STORM SECONDARY NETWORK PROGRESS LAYOUT ZONE-A

ZONE A (Storm Secondary)				
ITEM	Total Quantity (LM)	Excuted Quantity (LM)	Remaining Quantity (LM)	Percentage %
Excavation	7206.5	4803.691	2402.809	66.66%
Bedding	7206.5	4679.105	2527.395	64.93%
Installation	7206.5	4543.522	2662.978	63.05%
Backfilling	7206.5	3199.102	4007.398	44.39%

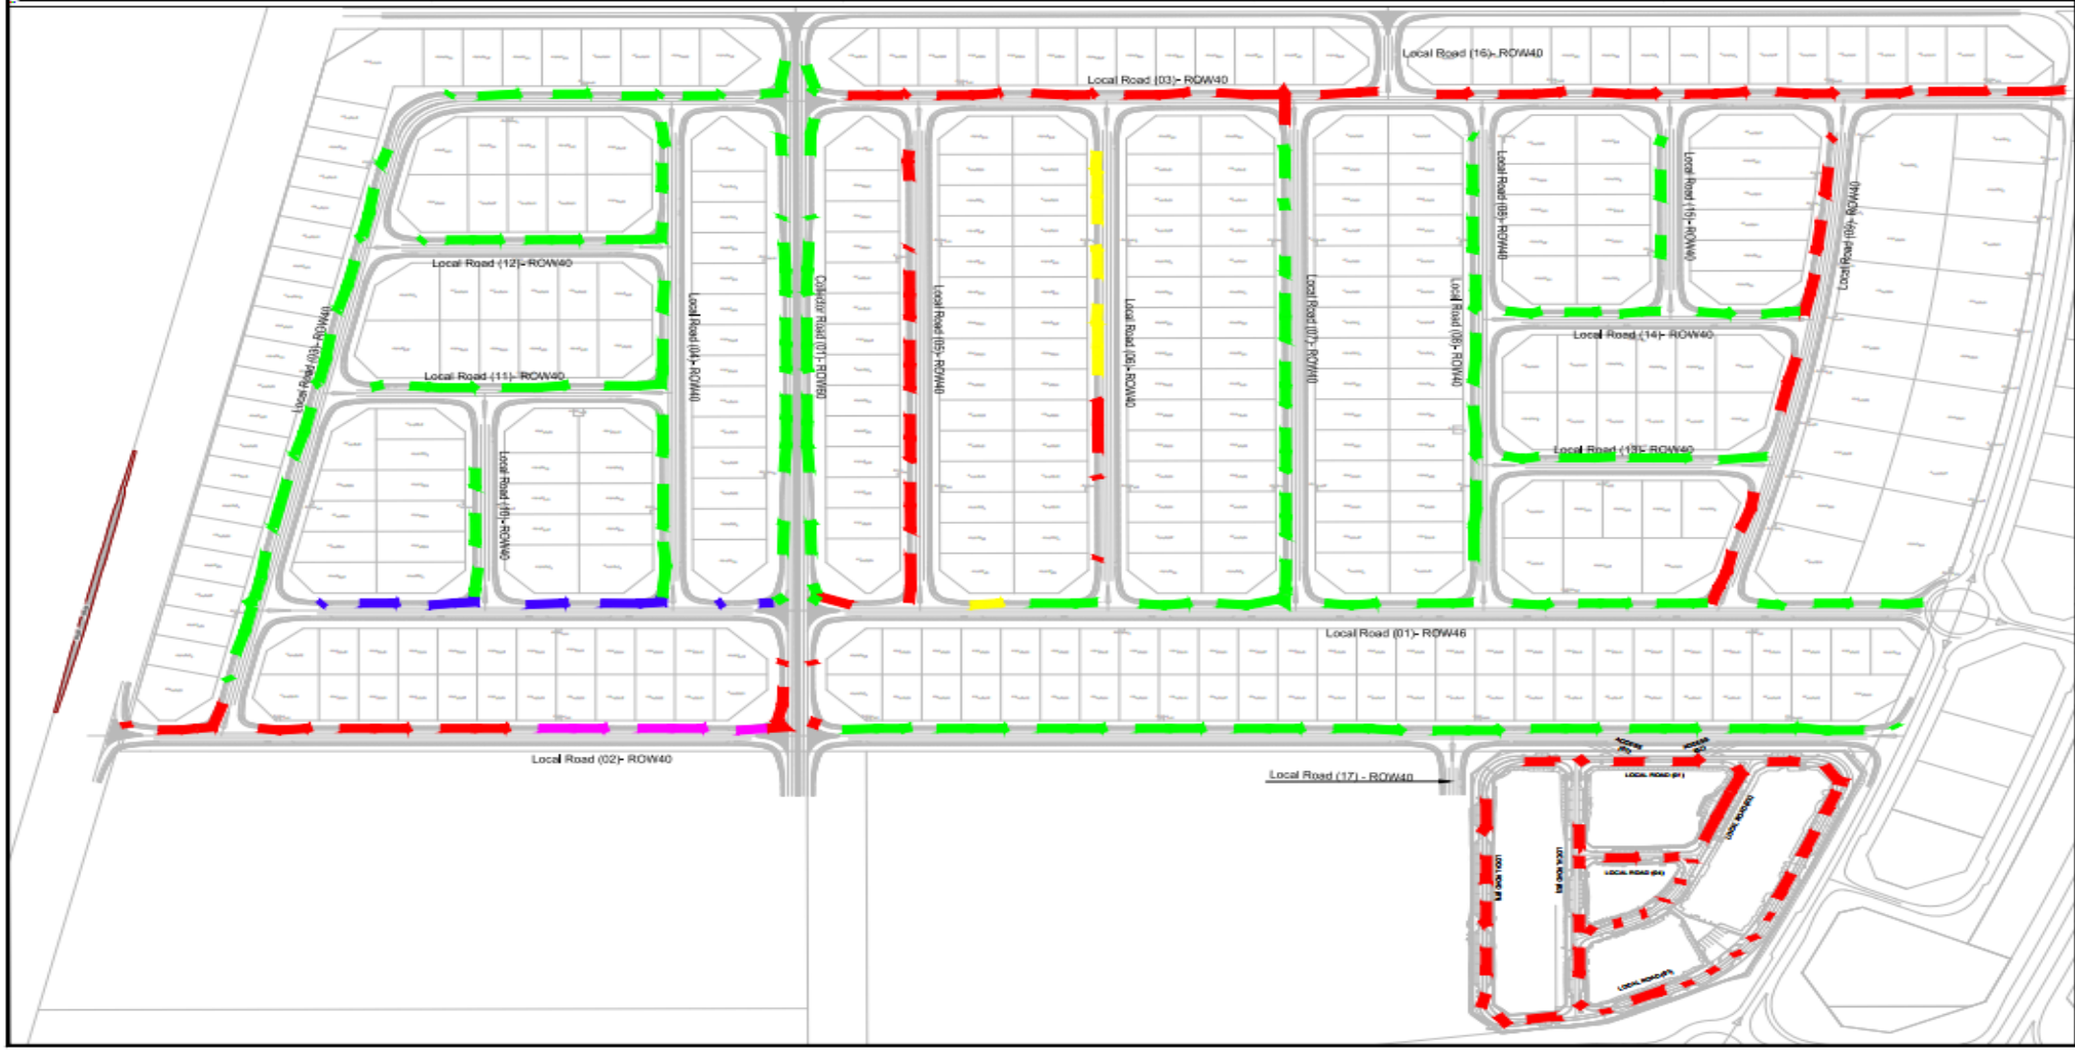

KEY PLAN



Legend

- Excavation
- Bedding
- Installation
- Backfilling
- Remaining

REFERENCE DRAWINGS

REVISIONS TABLE

REV	DESCRIPTION	DATE

PURPOSE OF ISSUE: FOR APPROVAL

MODON

egis

MOFARREH GROUP

ENGINEERING & CONSTRUCTION



STORM DRAINAGE SYSTEM

STORM SECONDARY NETWORK ZONE -A

SCALE	SHEET
1:1000	

SECONDARY STORM NETWORK PROGRESS LAYOUT ZONE-B

ZONE B (Storm Secondary) Pipes				
ITEM	Total Quantity (LM)	Excuted Quantity (LM)	Remaining Quantity (LM)	Percentage %
Excavation	5322.62	3350.742	1971.878	62.95%
Bedding	5322.62	3291.344	2031.276	61.84%
Installation	5322.62	3161.563	2161.057	59.40%
Backfilling	5322.62	739.601	4583.019	13.90%

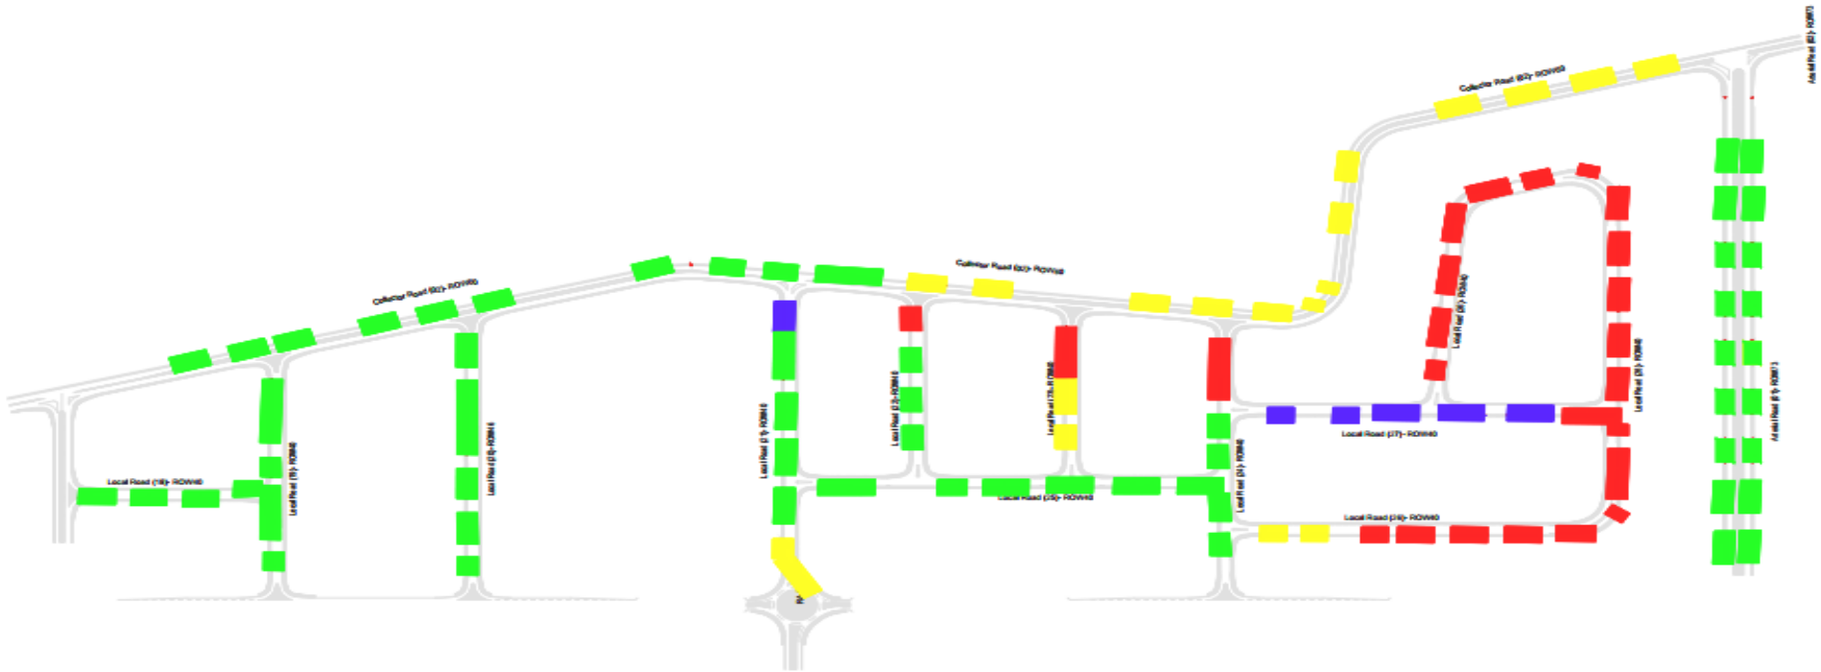

KEY PLAN



Legend

- Excavation
- Bedding
- Installation
- Backfilling
- Remaining

REFERENCE DRAWINGS

REVISIONS TABLE

PURPOSE OF ISSUE: FOR APPROVAL

MODON

egis

MOFARREH GROUP ENGINEERING & CONSTRUCTION


STORM DRAINAGE SYSTEM


STORM DRAINAGE SECONDARY LAYOUT PLAN ZONE B

SCALE

SHEET

SECONDARY STORM CATCH BASIN PROGRESS LAYOUT ZONE-A

ZONE A (Catch Basin)				
ITEM	Total Quantity (EA)	Executed Quantity (EA)	Remaining Quantity (EA)	Percentage %
Excavation	416	237	179	56.97%
Blinding	416	224	192	53.85%
Installation	416	221	195	53.20%
Backfilling	416	106	310	25.48%

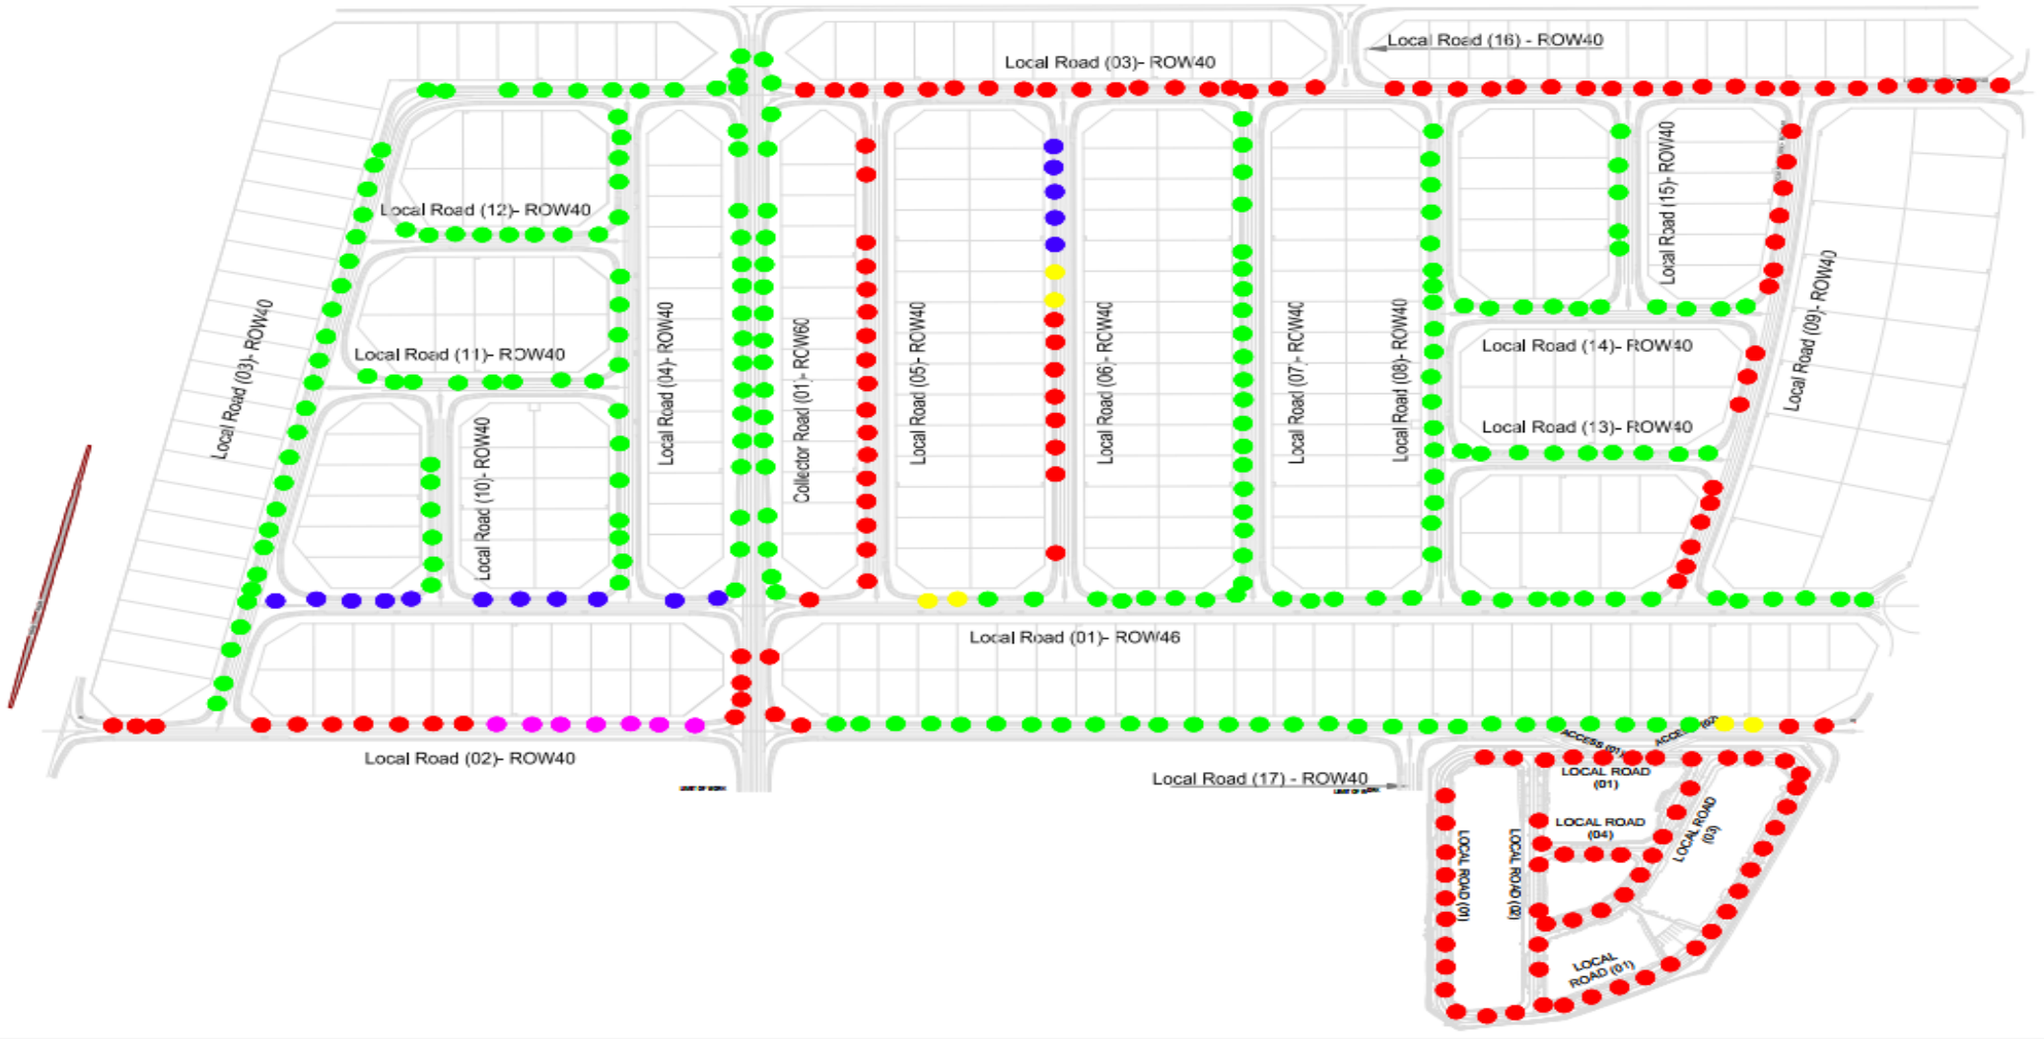

KEY PLAN



Legend

- Excavation
- Blinding
- Installation
- Backfilling
- Remaining

REFERENCE DRAWINGS

REVISIONS TABLE

REV	DESCRIPTION	DATE

PURPOSE OF ISSUE: FOR APPROVAL

CONTRACTOR | REVIEWED
DRAWN | CHECKED
DESIGNED | APPROVED
APPROVED | SHEET SIZE: A1


DISCIPLINE: STORM DRAINAGE SYSTEM


DRAWING TITLE: CATCH BASIN LAYOUT ZONE-A

DRAWING NUMBER

SCALE: 1:1000 | SHEET | DATE

SECONDARY STORM CATCH BASIN PROGRESS LAYOUT ZONE-B

STORM SECONDARY CATCH BASIN PROGRESS (ZONE B)				
ITEM	Total Quantity (EA)	Executed Quantity (EA)	Remaining Quantity (EA)	Percentage %
Excavation	257	157	100	61.09%
Blinding	257	155	102	60.31%
Installation	257	179	78	69.49%
Backfilling	257	58	199	22.57%

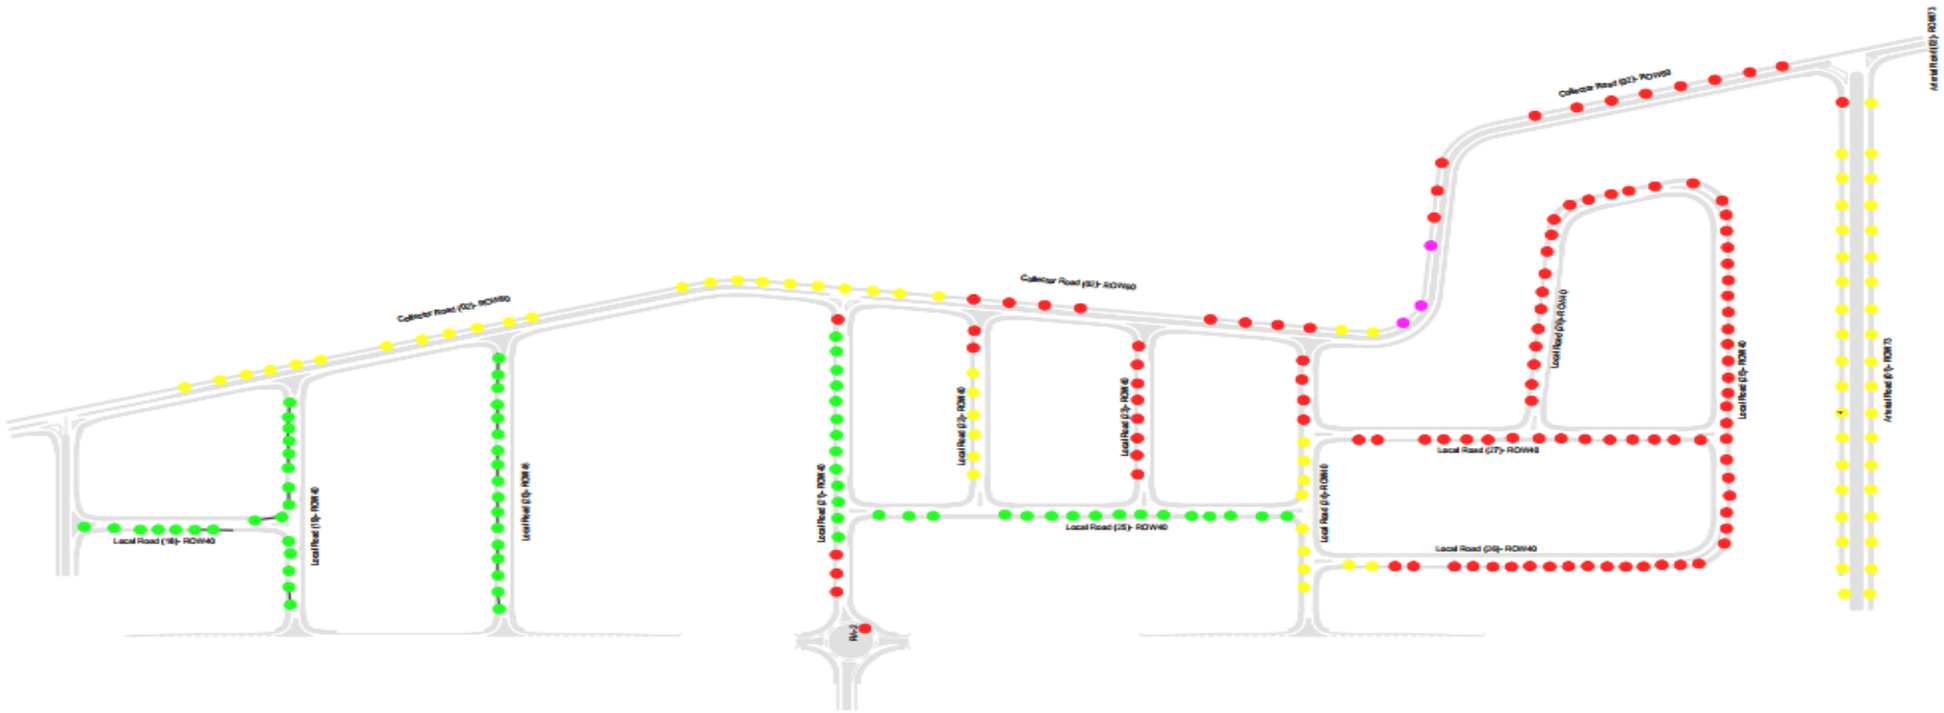

KEY PLAN



Legend

- Excavation
- Blinding
- Installation
- Backfilling
- Remaining

REFERENCE DRAWINGS

REVISIONS TABLE

PURPOSE OF ISSUE: FOR APPROVAL



STORM DRAINAGE SYSTEM

STORM DRAINAGE SECONDARY LAYOUT PLAN ZONE B

SCALE

SHEET

STORM NETWORK PROGRESS LAYOUT FACTORY AREA

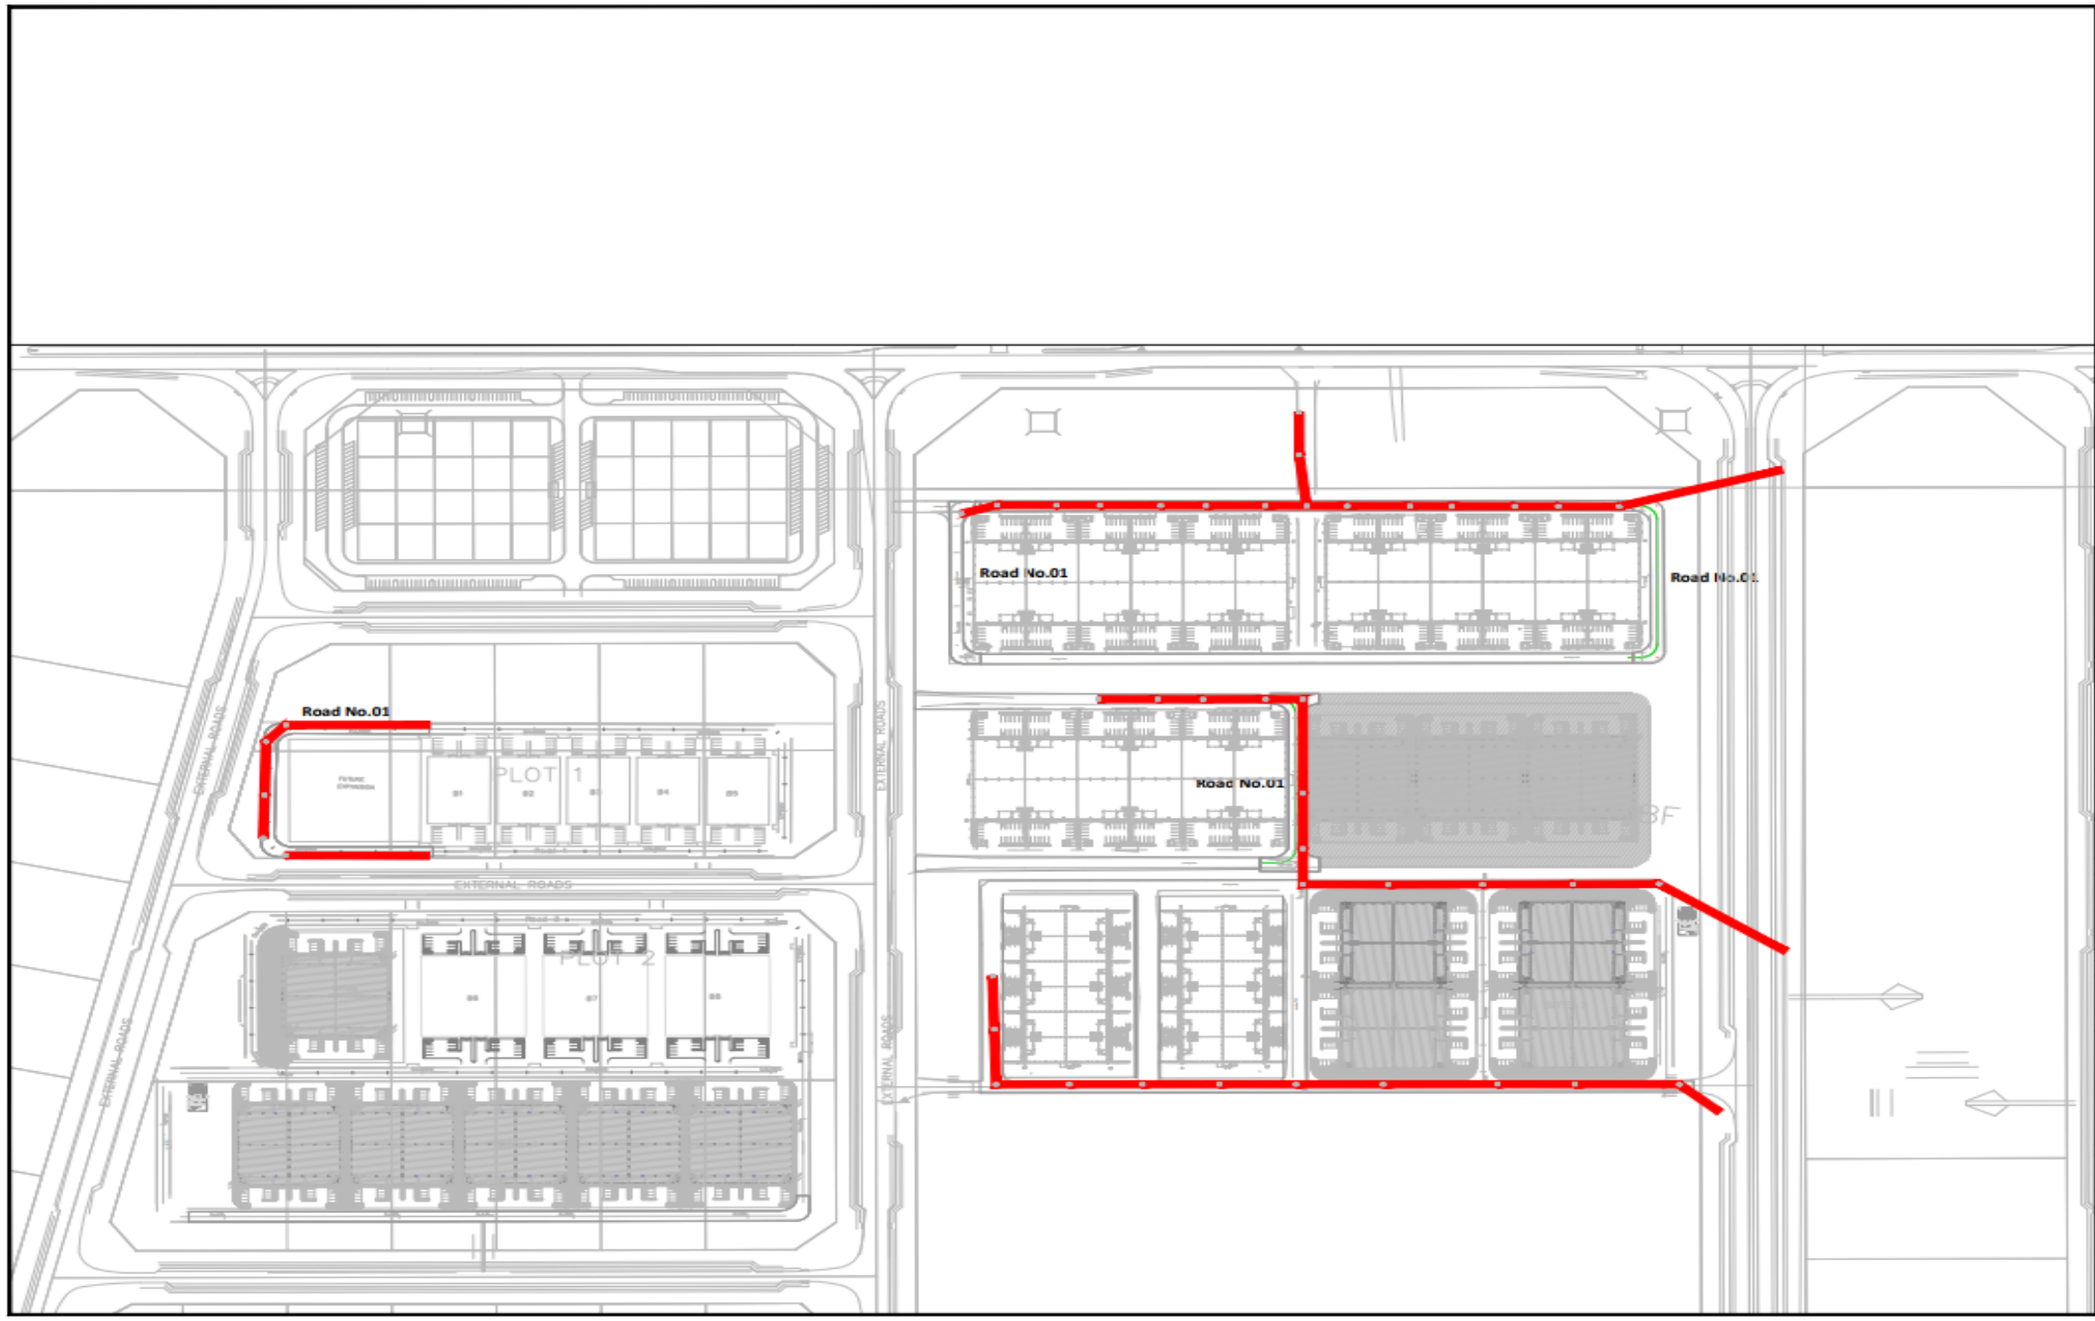

KEY PLAN



Legend

- Excavation
- Sand Bedding
- Installation
- Backfilling
- Remaining

REFERENCE DRAWINGS

REVISIONS TABLE

PURPOSE OF ISSUE: FOR APPROVAL


Storm Network Progress layout at Factory Area

SCALE 1:1000

SHEET


DATE:

STORM MANHOLE PROGRESS LAYOUT FACTORY AREA



POTABLE WATER NETWORK PROGRESS LAYOUT ZONE-A

ZONE A + Labor Camp (Potable)				
ITEM	Total Quantity (LM)	Excuted Quantity (LM)	Remaining Quantity (LM)	Percentage %
Excavation	20475.00	2529.520	17945.480	12.35%
Bedding	20475.00	2444.520	18030.480	11.94%
Installation	20475.00	2444.520	18030.480	11.94%
Backfilling	20475.00	290.000	20185.000	1.42%

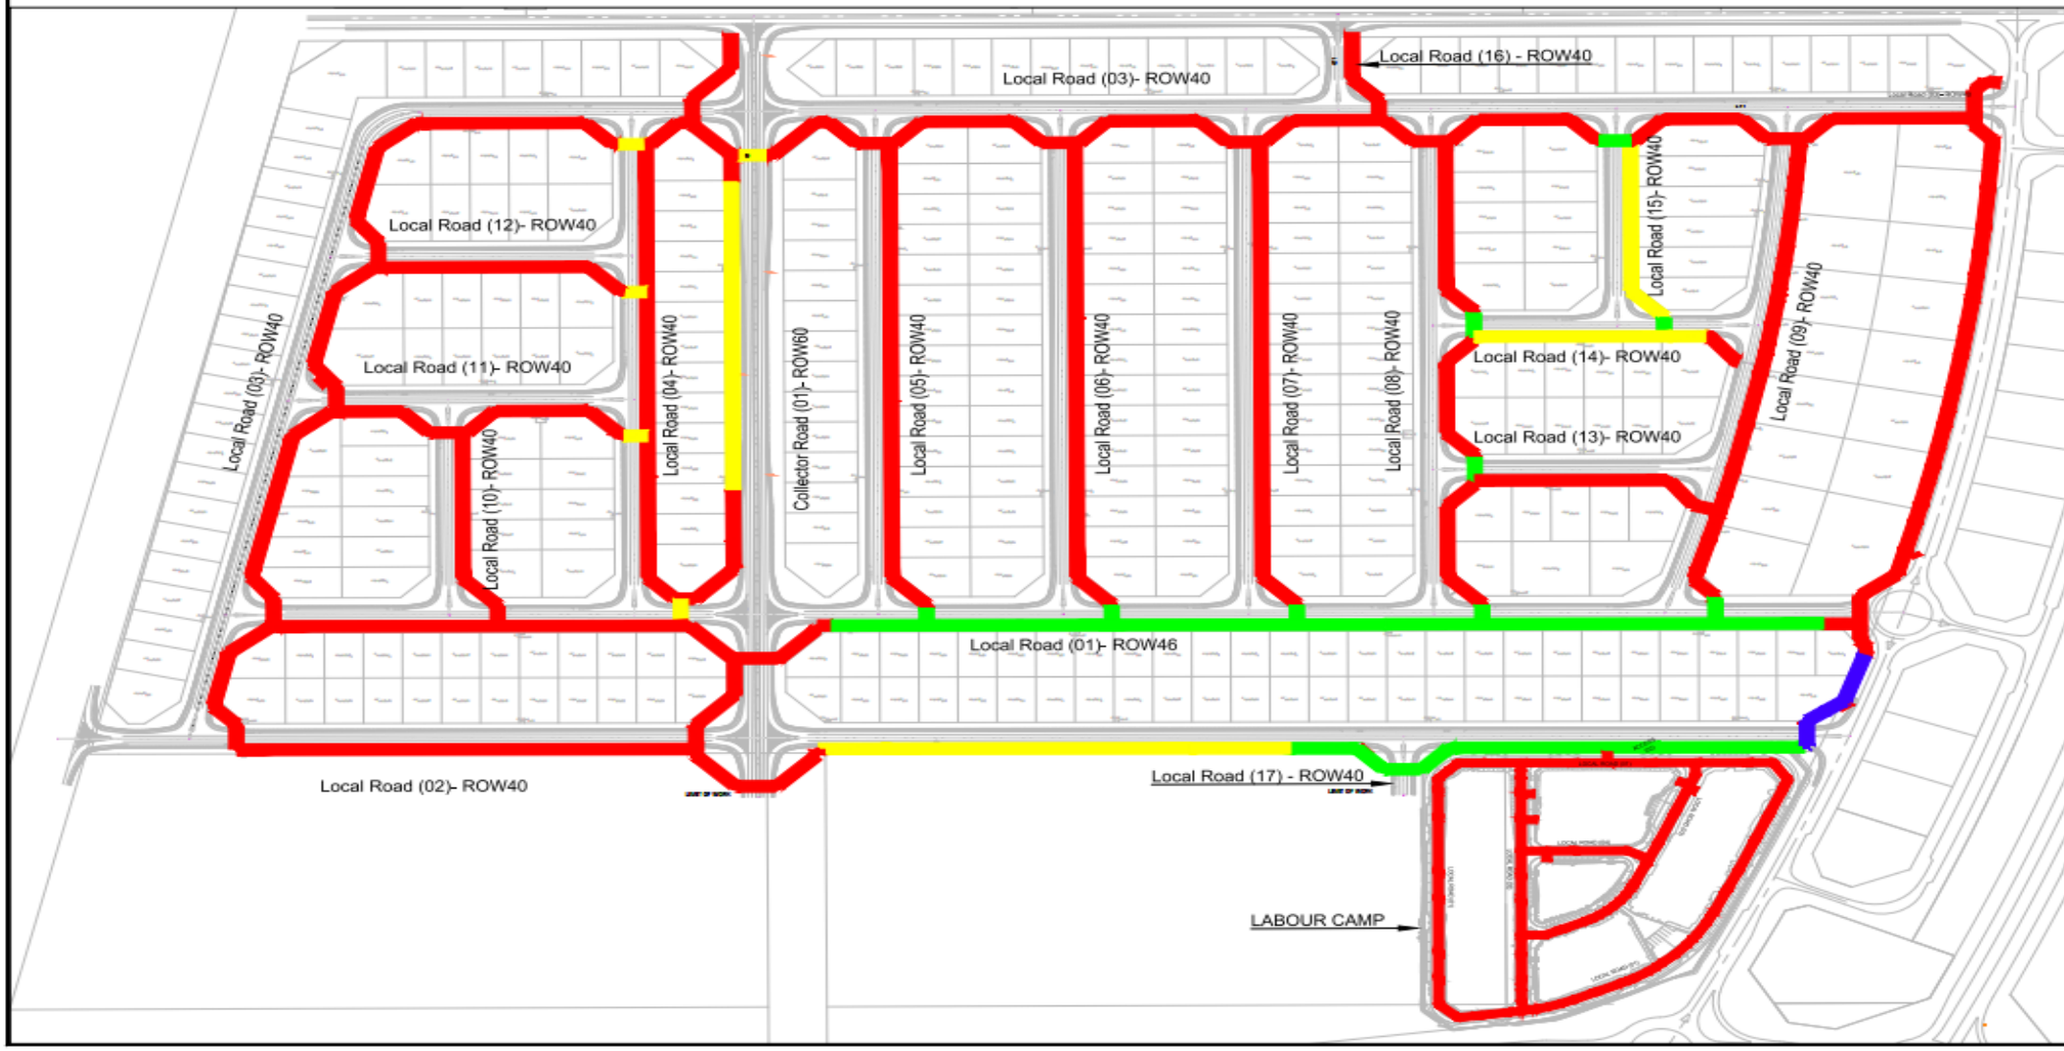



Legend

- Excavation
- Bedding
- Installation
- Backfilling
- Remaining

REFERENCE DRAWINGS

REVISIONS TABLE

PURPOSE OF ISSUE: FOR APPROVAL



POTABLE WATER NETWORK

POTABLE WATER NETWORK LAYOUT ZONE A

SCALE 1:1000

POTABLE WATER NETWORK PROGRESS LAYOUT ZONE-B

ZONE B (Potable) Pipes				
ITEM	Total Quantity (LM)	Excuted Quantity (LM)	Remaining Quantity (LM)	Percentage %
Excavation	10308.00	6334.66	3973.34	61.45%
Bedding	10308.00	6309.66	3998.34	61.21%
Installation	10308.00	6309.66	3998.34	61.21%
Backfilling	10308.00	1675.00	8633.00	16.25%

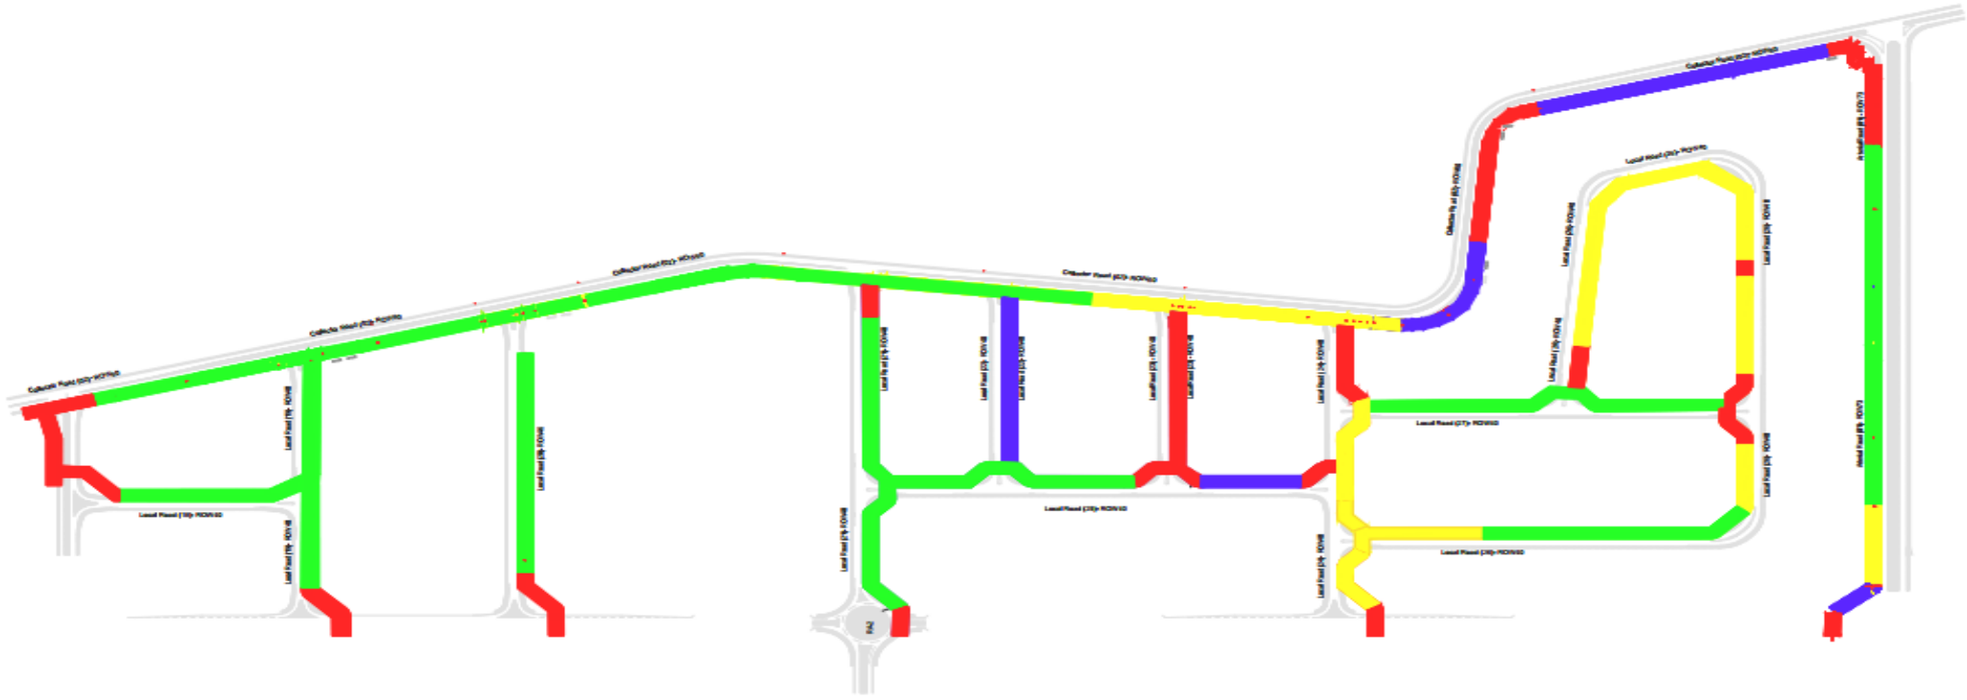

KEY PLAN



Legend

- Excavation
- Bedding
- Installation
- Backfilling
- Remaining


REFERENCE DRAWINGS

REVISIONS TABLE

PURPOSE OF ISSUE: FOR APPROVAL

POTABLE FIRE HYDRANT PROGRESS LAYOUT ZONE-A

ZONE A FireHydrant Progress				
ITEM	Total Quantity (EA)	Excuted Quantity (LM)	Remaining Quantity (LM)	Percentage %
Excavation	170	13	157	7.65%
Blinding	170	2	168	1.18%
Installation	170	3	167	1.76%
Backfilling	170	2	168	1.18%

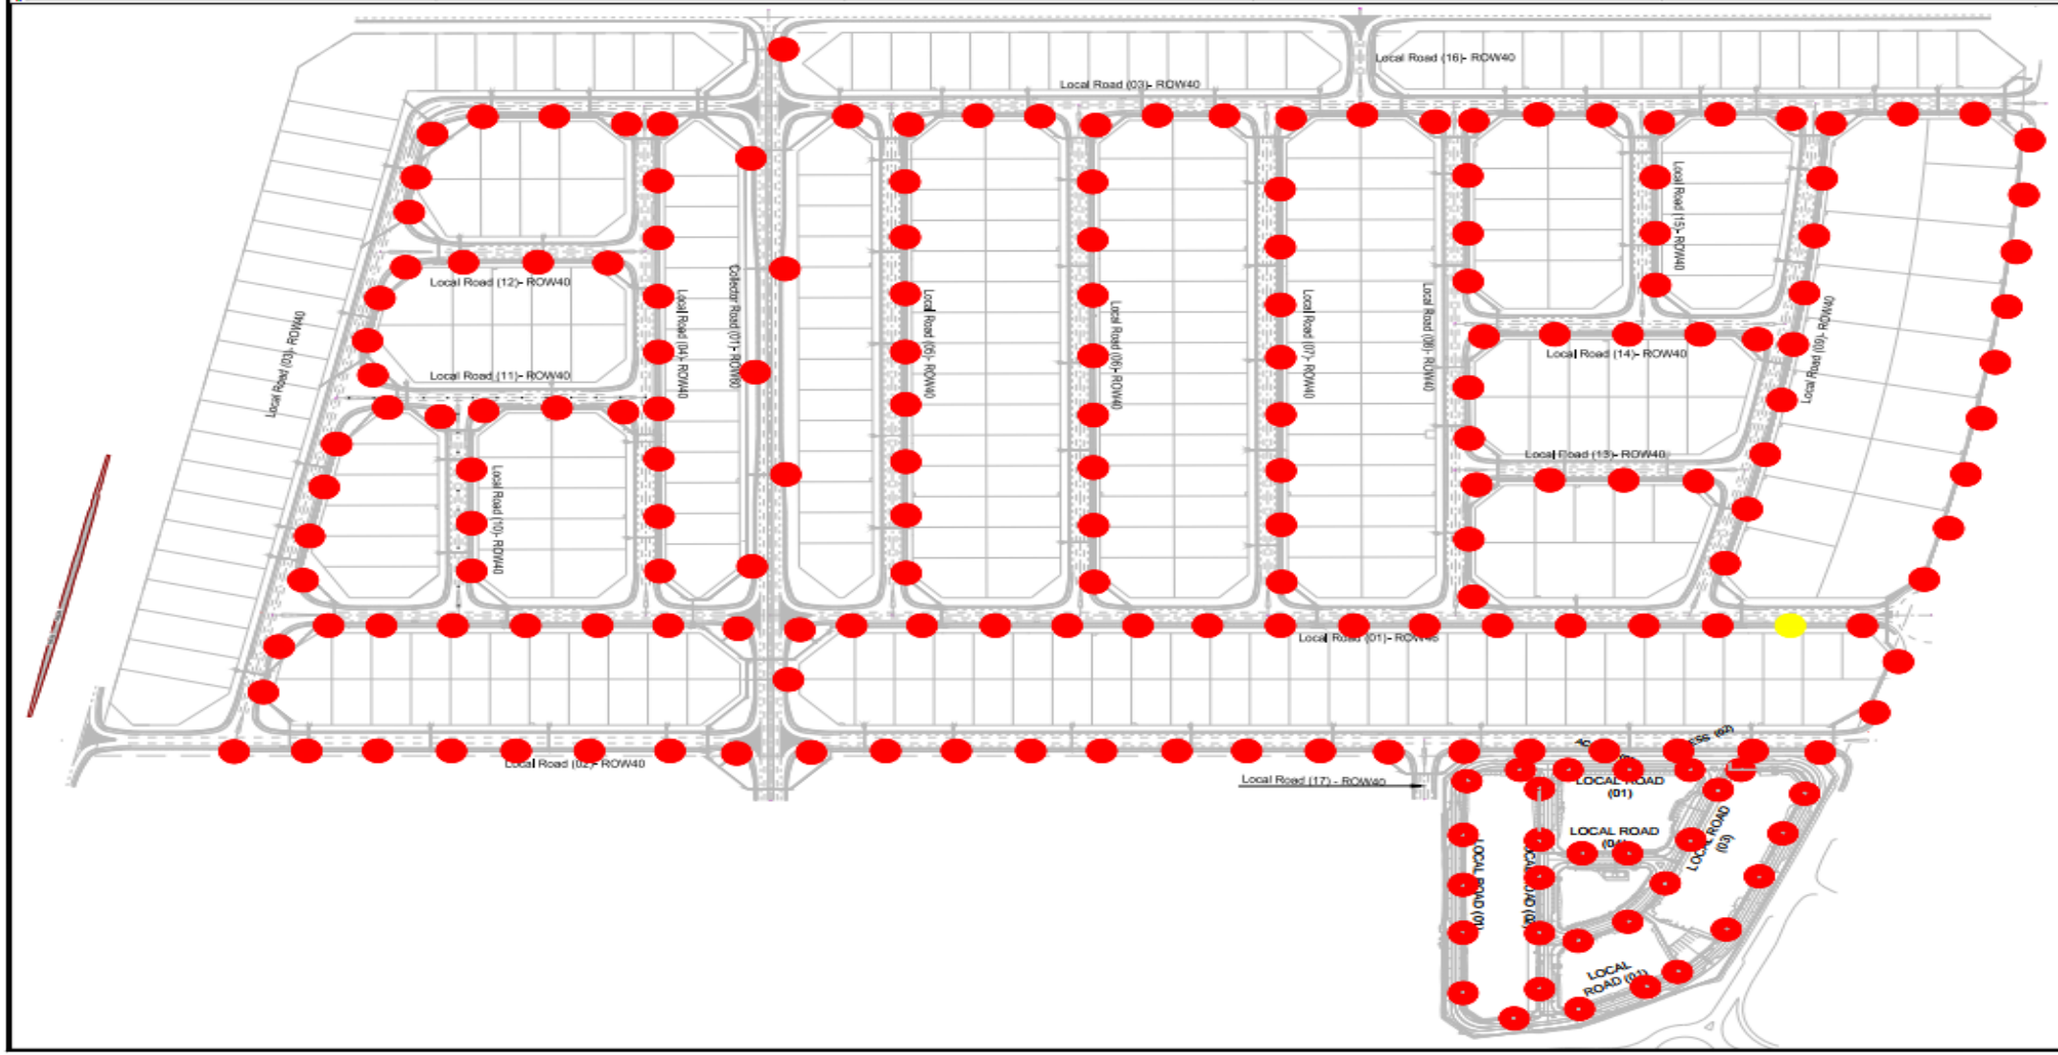

KEY PLAN



Legend

- Excavation
- Blinding
- Installation
- Backfilling
- Remaining

REFERENCE DRAWINGS

REVISIONS TABLE

PURPOSE OF ISSUE: FOR APPROVAL


FIRE HYDRANT LAYOUT ZONE-A

SCALE 1:1000

SHEET

POTABLE FIRE HYDRANT PROGRESS LAYOUT ZONE-B

ZONE B FireHydrant Progress				
ITEM	Total Quantity (EA)	Excuted Quantity	Remaining Quantity (LM)	Percentage %
Excavation	110.00	4	106	3.64%
Blinding	110.00	4	106	3.64%
Installation	110.00	4	106	3.64%
Backfilling	110.00	0	110	0.00%

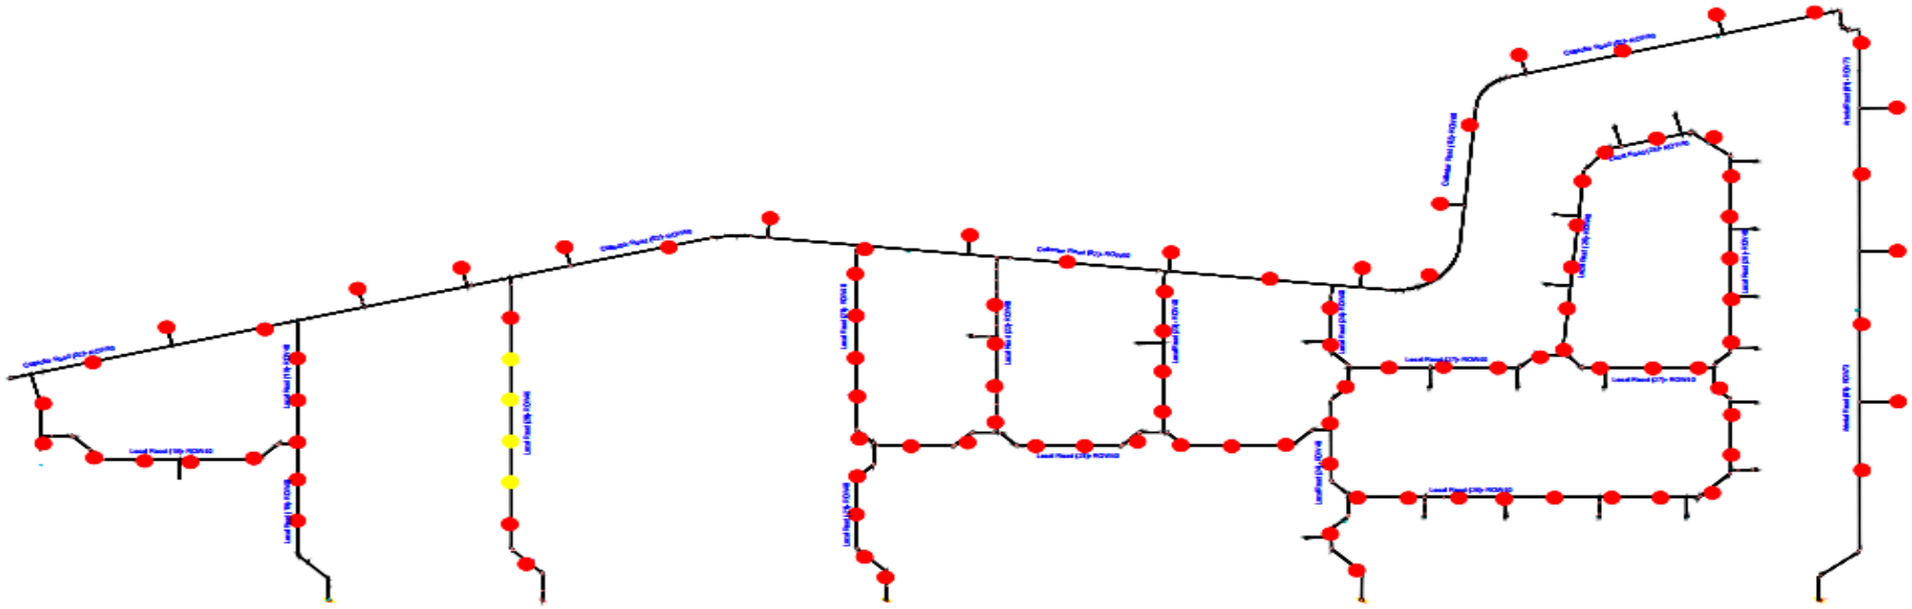

KEY PLAN



Legend

- Excavation
- Blinding
- Installation
- Backfilling
- Remaining

REFERENCE DRAWINGS

REVISIONS TABLE

PURPOSE OF ISSUE: FOR APPROVAL

MODON

egis

MOFARREH GROUP ENGINEERING & CONSTRUCTION

DESIGNS FOR AL-KHARJ INDUSTRIAL CITY

POTABLE SYSTEM


POTABLE LAYOUT PLAN ZONE B

SCALE

SHEET

TSE WATER NETWORK PROGRESS LAYOUT ZONE-A

(TSE) PIPE PROGRESS ZONE A				
ITEM	Total Quantity (LM)	Excuted Quantity (LM)	Remaining Quantity (LM)	Percentage %
Excavation	13023	515.000	12508.000	3.95%
Bedding	13023	155.000	12868.000	1.19%
Installation	13023	130.000	12893.000	1.00%
Backfilling	13023	0.000	13023.000	0.00%

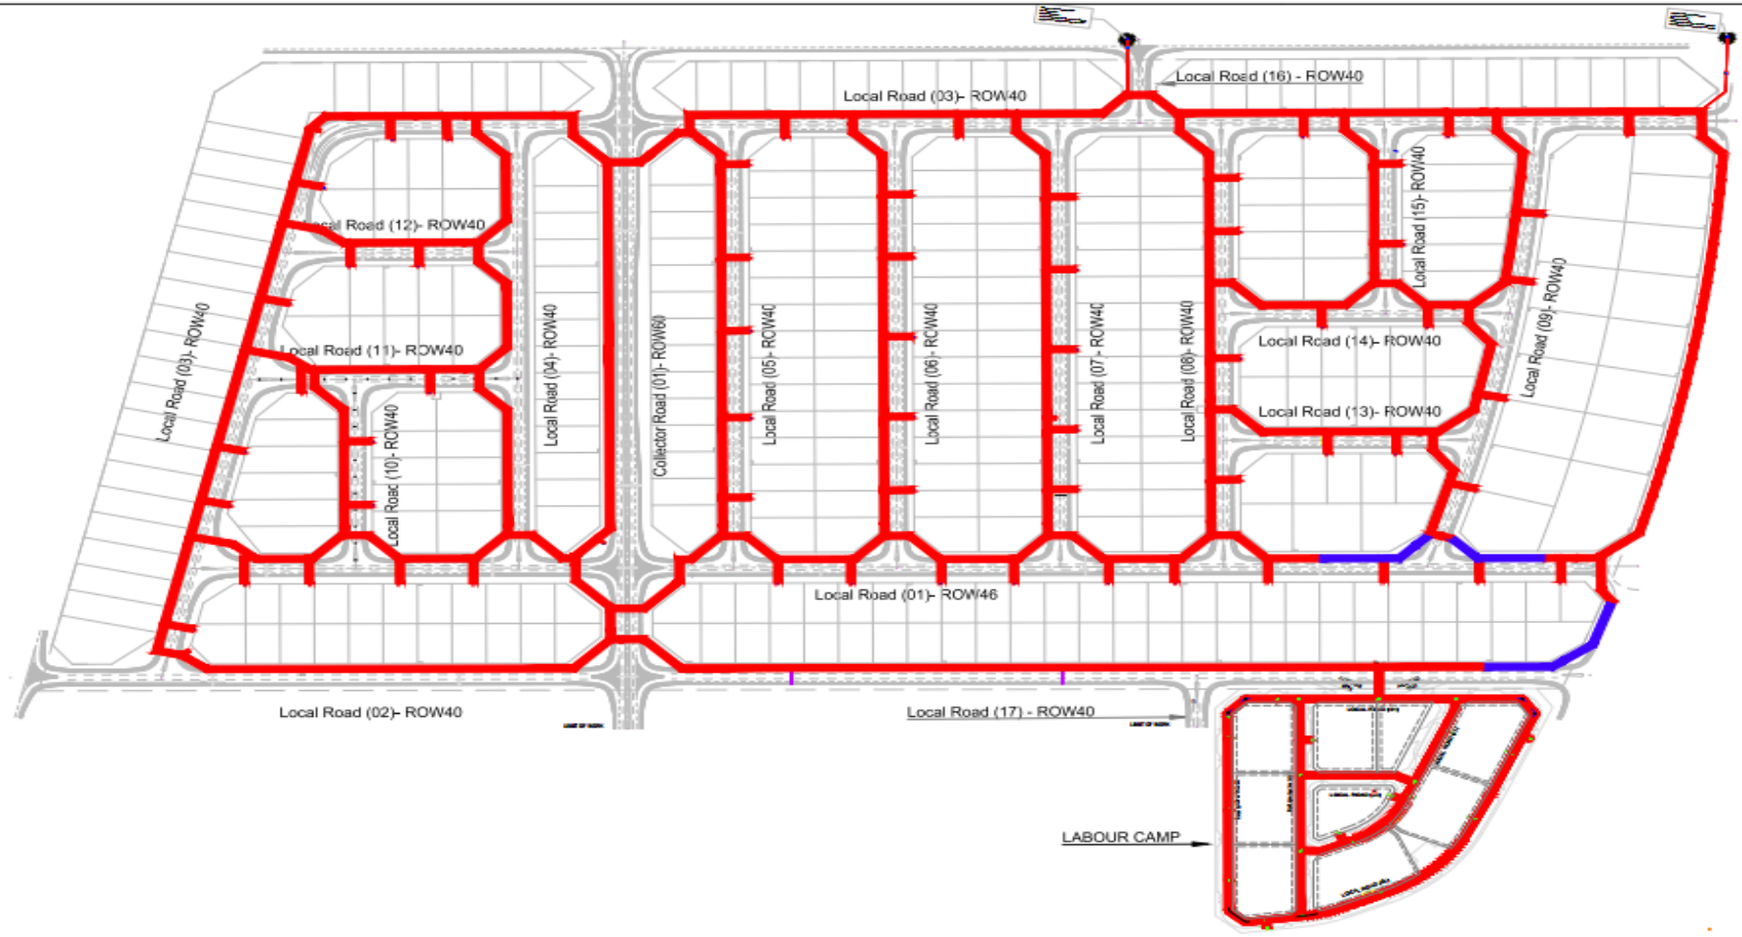

KEY PLAN



Legend

- Excavation
- Base Installation
- Backfilling
- Remaining

REFERENCE DRAWINGS

REVISIONS TABLE

REV	DESCRIPTION	DATE

PURPOSE OF ISSUE: FOR APPROVAL

DRAWN	REVIEWED
DESIGNED	CHECKED
CHECKED	APPROVED
APPROVED	SHEET SIZE: A1


DISCIPLINE:

DRAWING TITLE: TSE PROGRESS LAYOUT ZONE-A

DRAWING NUMBER:

SCALE: 1:1000

DATE:

TSE WATER NETWORK PROGRESS LAYOUT ZONE-B

(TSE) PIPE PROGRESS ZONE B				
ITEM	Total Quantity (LM)	Excuted Quantity (LM)	Remaining Quantity (LM)	Percentage %
Excavation	10991	4310.780	6680.220	39.22%
Bedding	10991	4310.780	6680.220	39.22%
Installation	10991	4166.780	6824.220	37.91%
Backfilling	10991	2770.780	8220.220	25.21%



KEY PLAN



Legend

- Excavation
- Bedding
- Installation
- Backfilling
- Remaining

REFERENCE DRAWINGS


REVISIONS TABLE

PURPOSE OF ISSUE: FOR APPROVAL

CROSSING PROGRESS LAYOUT-ZONE A



KEY PLAN

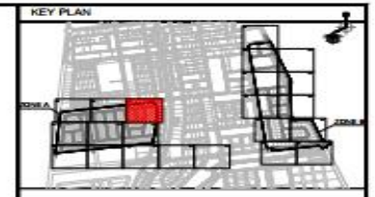

Legend

- Excavation
- Blinding
- Installation
- Backfilling
- Remaining

REFERENCE DRAWINGS

	STORM DRAINAGE LAYOUT PLAN

REVISIONS TABLE

REV	DESCRIPTION	DATE

PURPOSE OF ISSUE: FOR APPROVAL


CROSSINGS FOR ZONE A

SCALE 1:1000

SHEET


DATE:

CROSSING PROGRESS LAYOUT ZONE-B

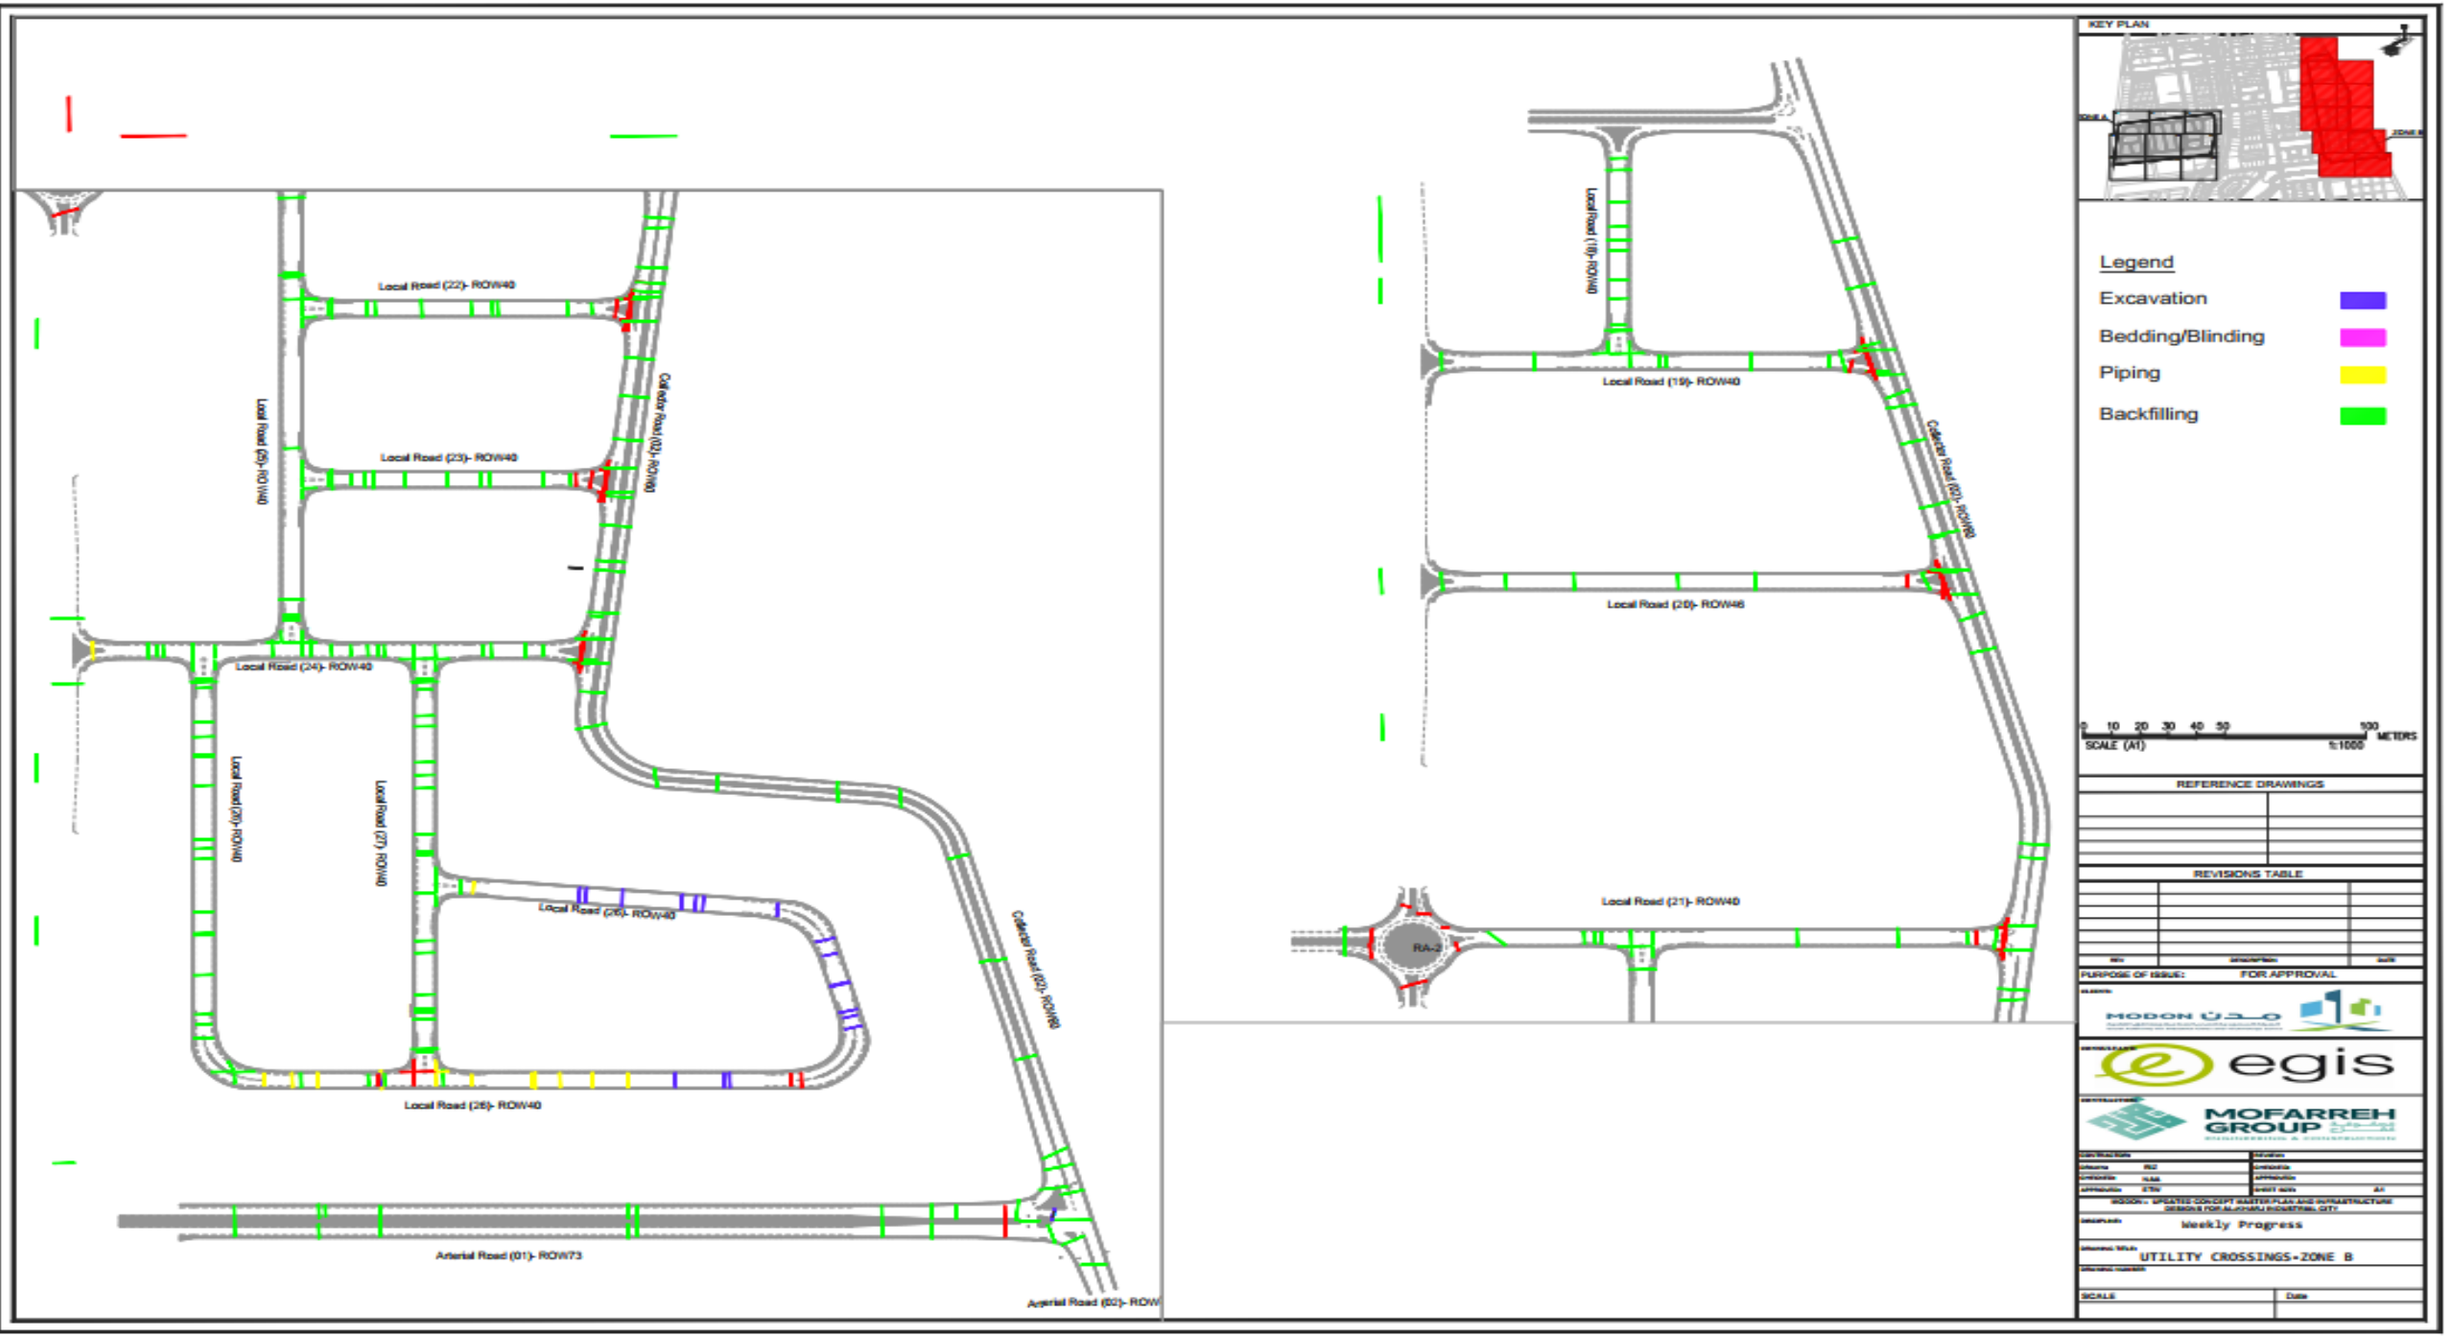

CURBSTONE PROGRESS LAYOUT ZONE-A

ZONE A (Curbstone)				
ITEM	Total Quantity (LM)	Excuted Quantity (LM)	Remaining Quantity (LM)	Percentage %
Excavation	81,767.97	7959.930	73808.040	9.73%
Blinding	81,767.97	1041.000	80726.970	1.27%
Installation	81,767.97	1041.000	80726.970	1.27%

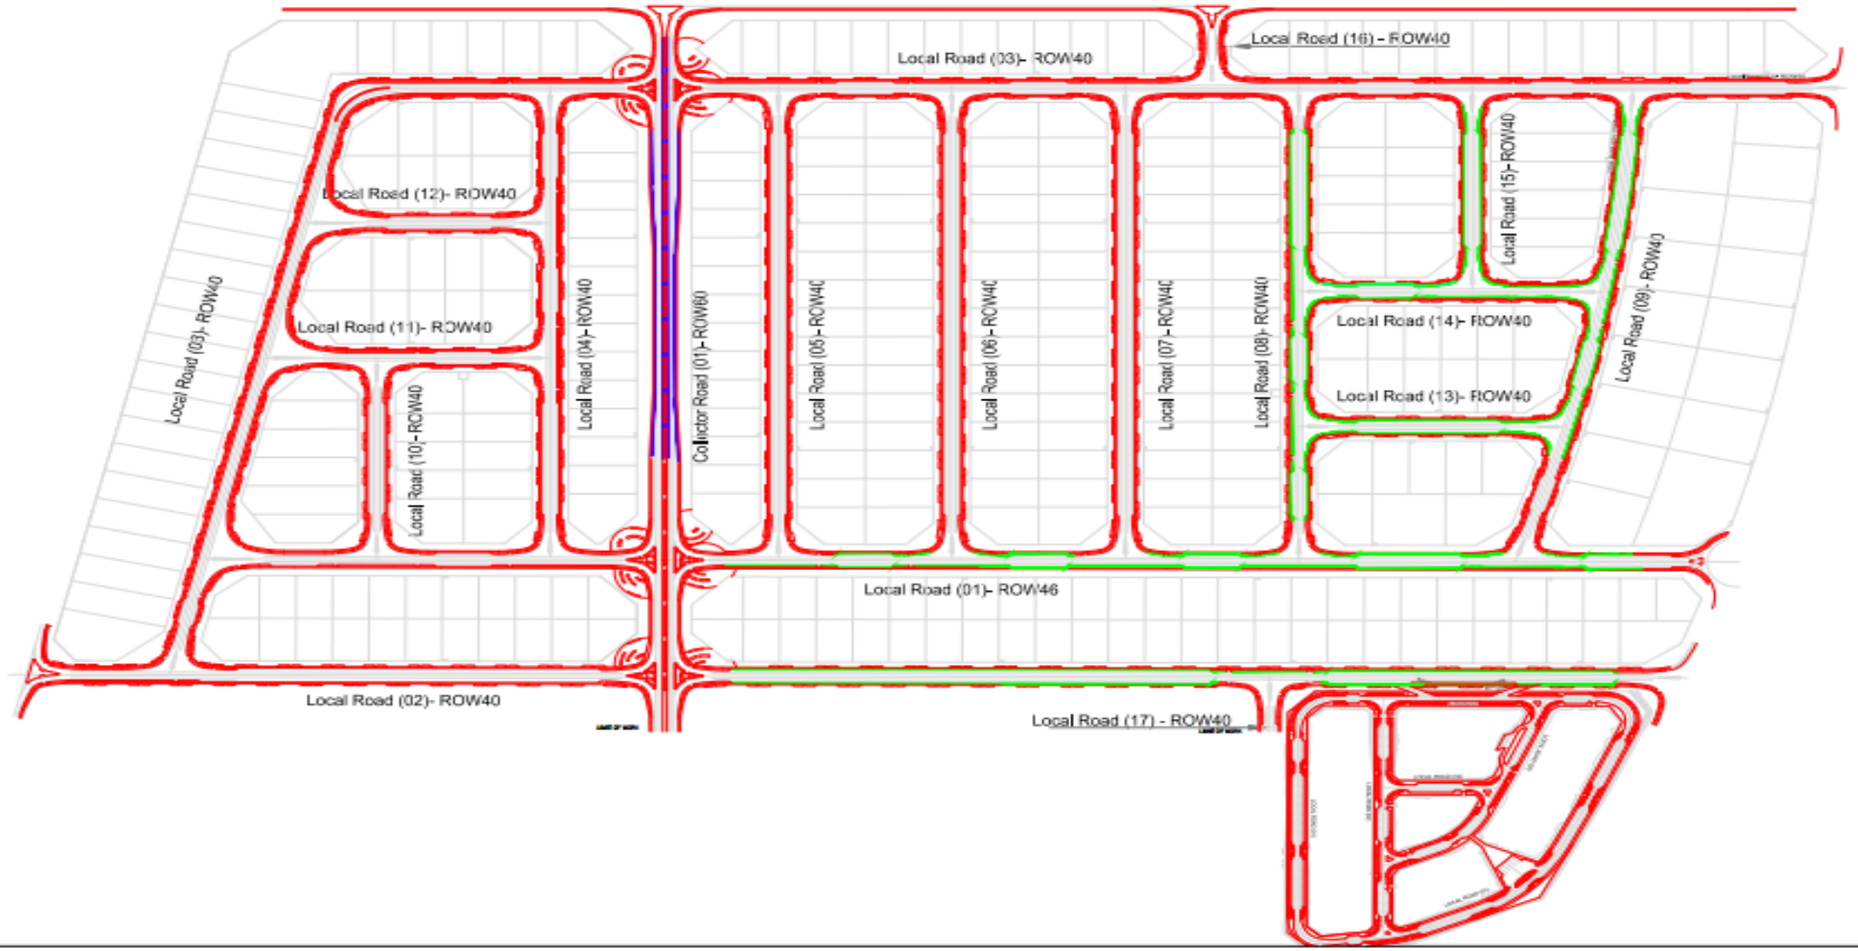



Legend

- Excavation
- Blinding
- Installation
- Remaining

SCALE (A1) 1:1000 METERS

REFERENCE DRAWINGS

REVISIONS TABLE


PURPOSE OF ISSUE: FOR APPROVAL

Weekly Progress

CURBSTONE PROGRESS LAYOUT-ZONE A

CURBSTONE PROGRESS LAYOUT ZONE-B

ZONE B (Curbstone)				
ITEM	Total Quantity (LM)	Excuted Quantity (LM)	Remaining Quantity (LM)	Percentage %
Excavation	74,108.65	4332.563	69776.087	5.85%
Blinding	74,108.65	4332.563	69776.087	5.85%
Installation	74,108.65	4332.563	69776.087	5.85%

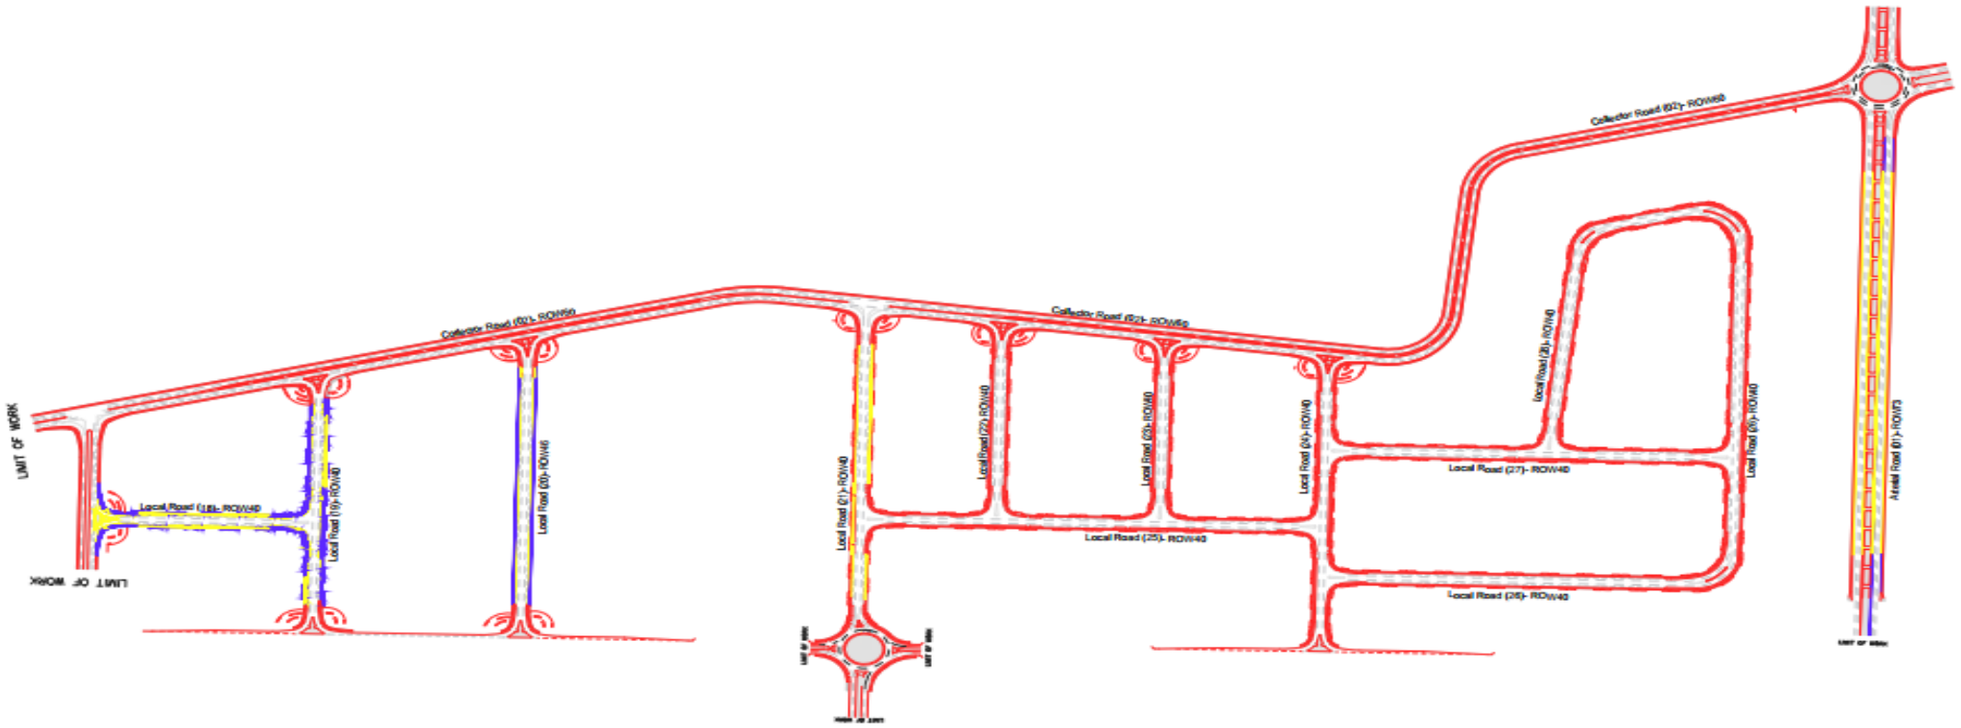

KEY PLAN



Legend

- Excavation
- Blinding
- Installation
- Remaining

0 10 20 30 40 50 100 METERS
SCALE (A1) 1:1000

REFERENCE DRAWINGS

REVISIONS TABLE

REV	DESCRIPTION	DATE

PURPOSE OF ISSUE: FOR APPROVAL

MODON

egis

MOFARREH GROUP ENGINEERING & CONSTRUCTION

MODON - UPDATED CONCEPT MASTER PLAN AND INFRASTRUCTURE DESIGNS FOR AL-KHARJ INDUSTRIAL CITY


Weekly Progress

CURBSTONE LAYOUT - ZONE B

SCALE 1:1000 Date

INTERLOCK PROGRESS LAYOUT ZONE-A

ZONE A (Interlock)				
ITEM	Total Quantity (SQ.M)	Excuted Quantity (SQ.M)	Remaining Quantity (SQ.M)	Percentage %
Backfilling	71,537.70	0.000	71537.701	0.00%
Bedding	71,537.70	0.000	71537.701	0.00%
Installation	71,537.70	0.000	71537.701	0.00%

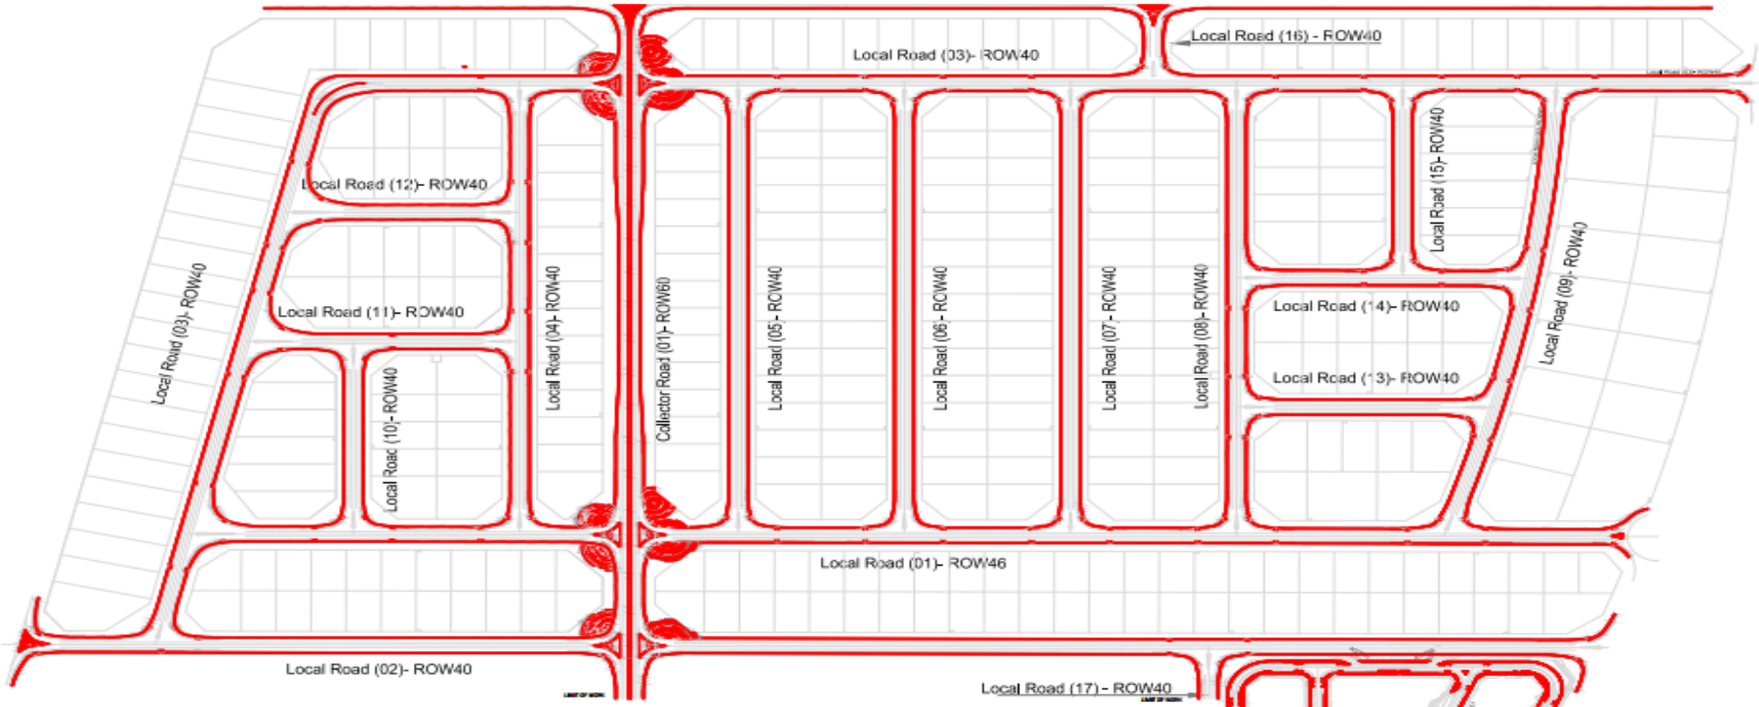



Legend

- Backfilling
- Bedding
- Installation
- Remaining

0 10 20 30 40 50 100 METERS
SCALE (A1) 1:1000

REFERENCE DRAWINGS

REVISIONS TABLE

PURPOSE OF ISSUE: FOR APPROVAL



Weekly Progress


CURBSTONE PROGRESS LAYOUT-ZONE A

SCALE 1:1000

INTERLOCK LAYOUT PROGRESS LAYOUT ZONE-B

ZONE B (Interlock)				
ITEM	Total Quantity (SQ.M)	Excuted Quantity (SQ.M)	Remaining Quantity (SQ.M)	Percentage %
Backfilling	68,821.68	1205.520	67616.155	1.75%
Bedding	68,821.68	1205.520	67616.155	1.75%
Installation	68,821.68	1205.520	67616.155	1.75%

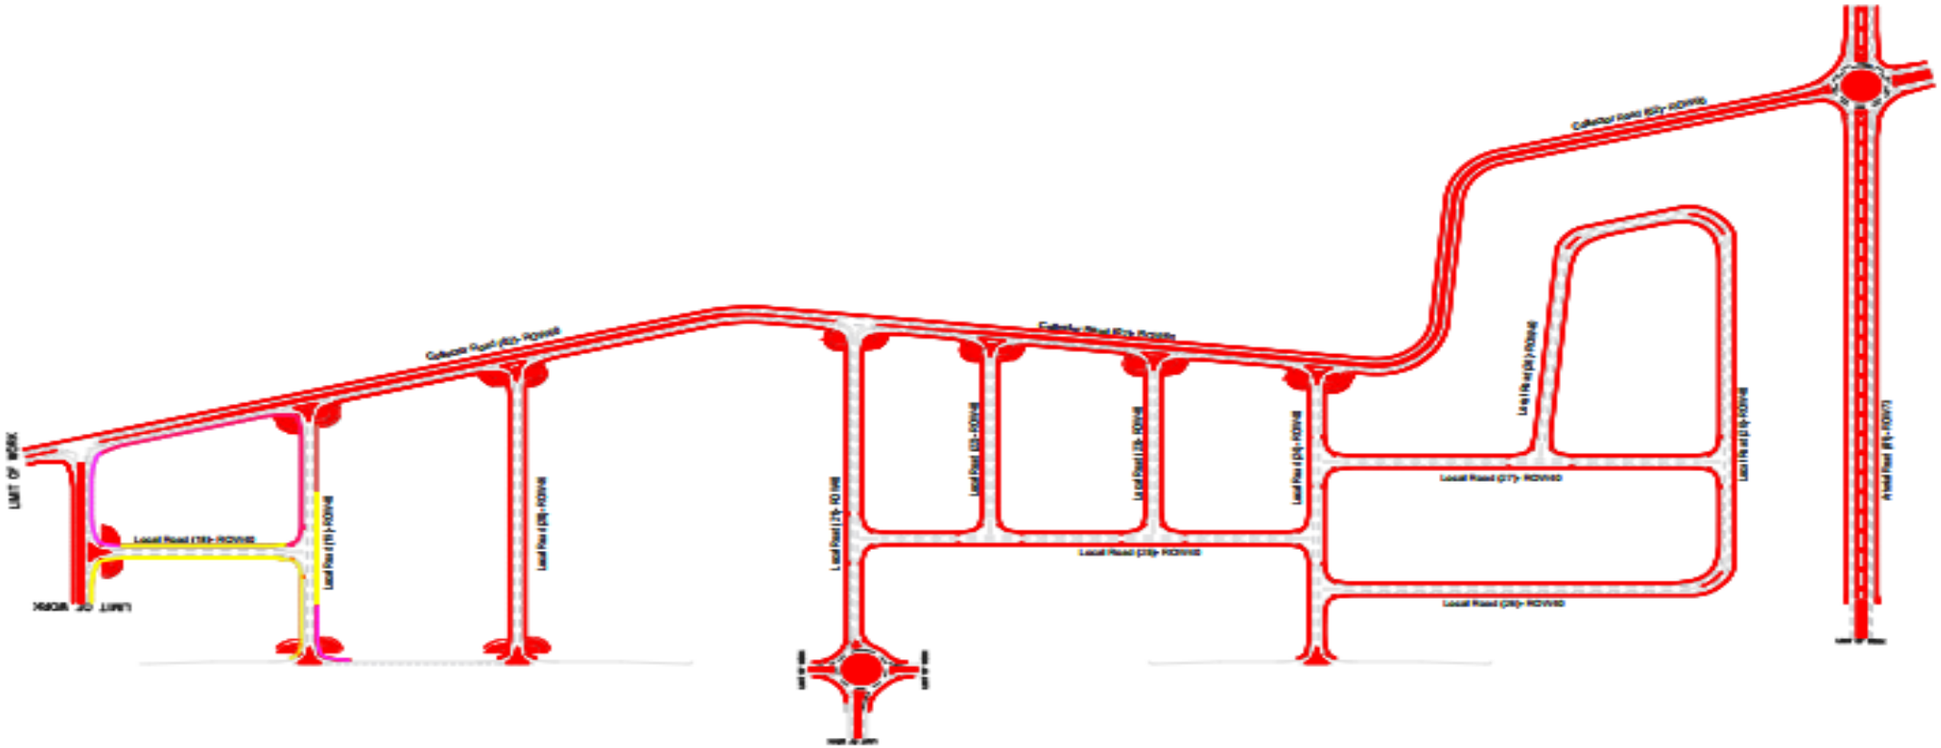

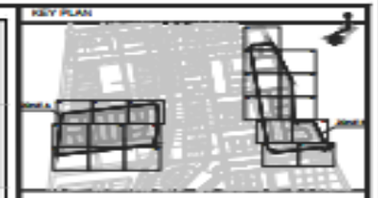

Legend

- Backfilling
- Bedding
- Installation
- Remaining

0 10 20 30 40 50 100 METERS

SCALE (H) 1:1000

REFERENCE DRAWINGS

REVISIONS TABLE

PURPOSE OF ISSUE: FOR APPROVAL

MODON egis MOFARREH GROUP

Weekly Progress

INTERLOCK LAYOUT-ZONE B


SCALE 1:10000 Date:

CULVERT PROGRESS-ZONE B

CULVERT PROGRESS LAYOUT

SHEET 01 OF 02

Culvert NO.01 _ Local Road 19
Demolish RipRap: Done (1644.9 M²)
Excavation : Done (164.637 M³)
All Precasts Delivered on site 37 from 37
Lean : Done (107 M)
Installation : Done

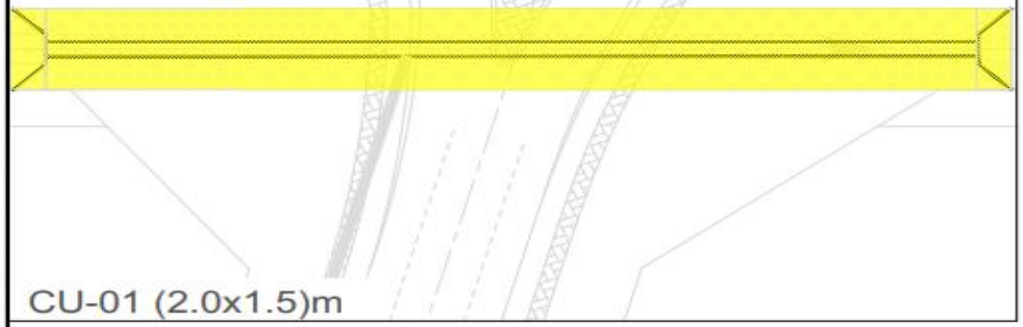


CU-01 (2.0x1.5)m

Culvert NO.02 _ Local Road 20
Demolish RipRap: Done (1003.24 M²)
Excavation : Done (184.568 M³)
All Precasts Delivered on site 37 from 37
Lean : Done (107 M)
Installation: Done




CU-02 2(1.5x1.5)m

Culvert NO.03 _ Local Road 21
Demolish RipRap: Done (2148.6 M²)
Excavation : Done (116.856 M³)
All Precasts Delivered on site 35 from 35
Lean : Done (101 M)
Installation: 35Pcs

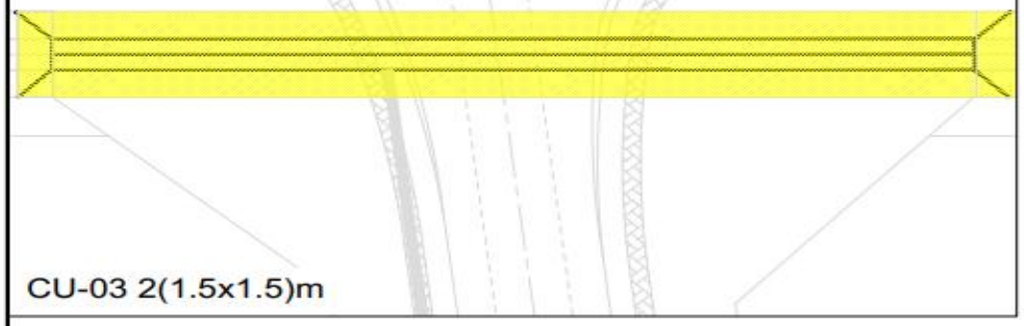

CU-03 2(1.5x1.5)m

Culvert NO.04 _ Local Road 22
Demolish RipRap: Done (2353.1 M²)
Excavation : Done (176.791 M³)
Precast's Deliver on site 35 from 35
Lean : Done (103M)
Installation :35Pcs

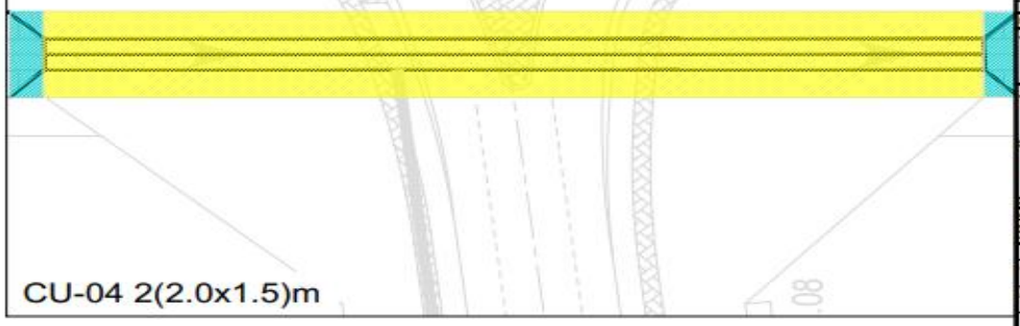

CU-04 2(2.0x1.5)m

KEY PLAN



Legend

- Excavation
- Blinding
- Installation
- Backfilling
- Wing Wall Activity
- Ongoing
- Remaining

0 10 20 30 40 50 100 METERS

SCALE (A1) 1:1000

REFERENCE DRAWINGS

REVISIONS TABLE

PURPOSE OF ISSUE: FOR APPROVAL

MODON

egis

MOFARREH GROUP

Weekly Progress


Culvert Progress


SCALE 1:1000


CULVERT PROGRESS-ZONE B

CULVERT PROGRESS LAYOUT

SHEET 02 OF 02

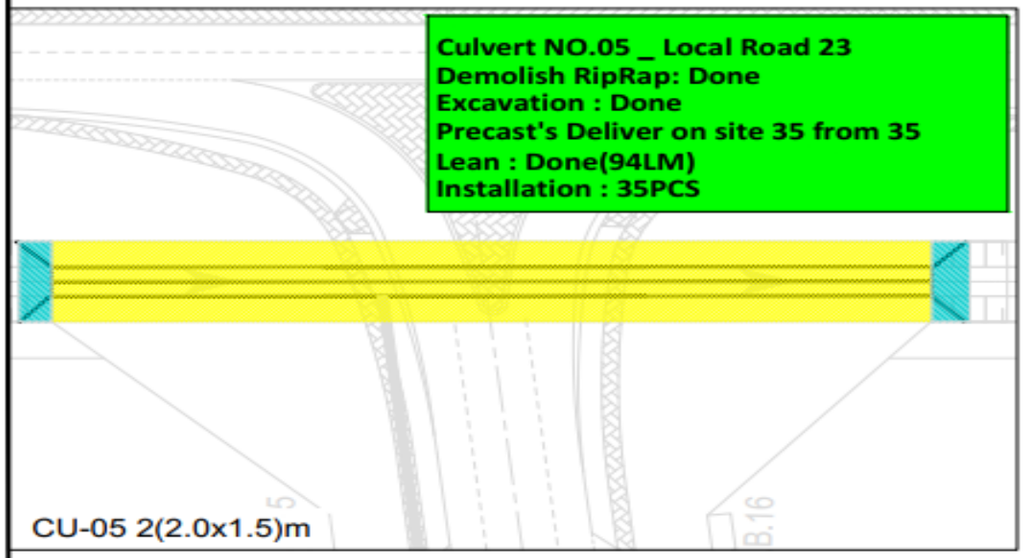

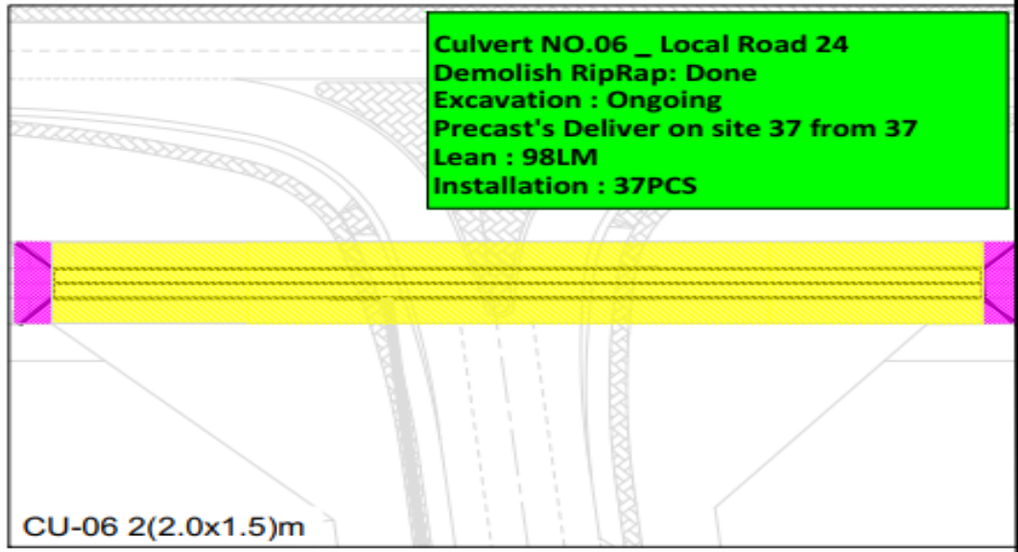

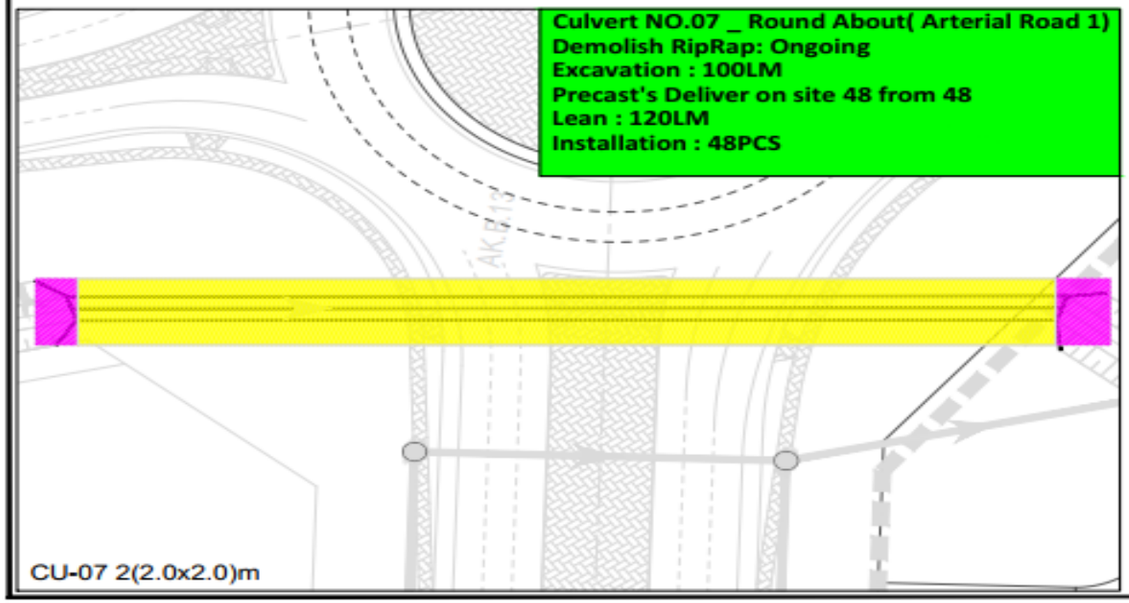



Legend

- Excavation
- Blinding
- Installation
- Backfilling
- Remaining

SCALE (AT) 1:1000 METERS

REFERENCE DRAWINGS

REVISIONS TABLE


PURPOSE OF ISSUE: FOR APPROVAL

Weekly Progress

Culvert Progress

BOX COUNDUIT PROGRESS LAYOUT ZONE-A

ZONE A (BOX CONDUIT)				
ITEM	**Total Quantity (LM)**	**Excuted Quantity (LM)**	**Remaining Quantity (LM)**	**Percentage %**
Excavation	**1500**	**627.000**	**873.000**	**41.80%**
Blinding	**1500**	**627.000**	**873.000**	**41.80%**
Installation	**1500**	**532.000**	**968.000**	**35.47%**
Backfilling	**1500**	**0.000**	**1500.000**	**0.00%**

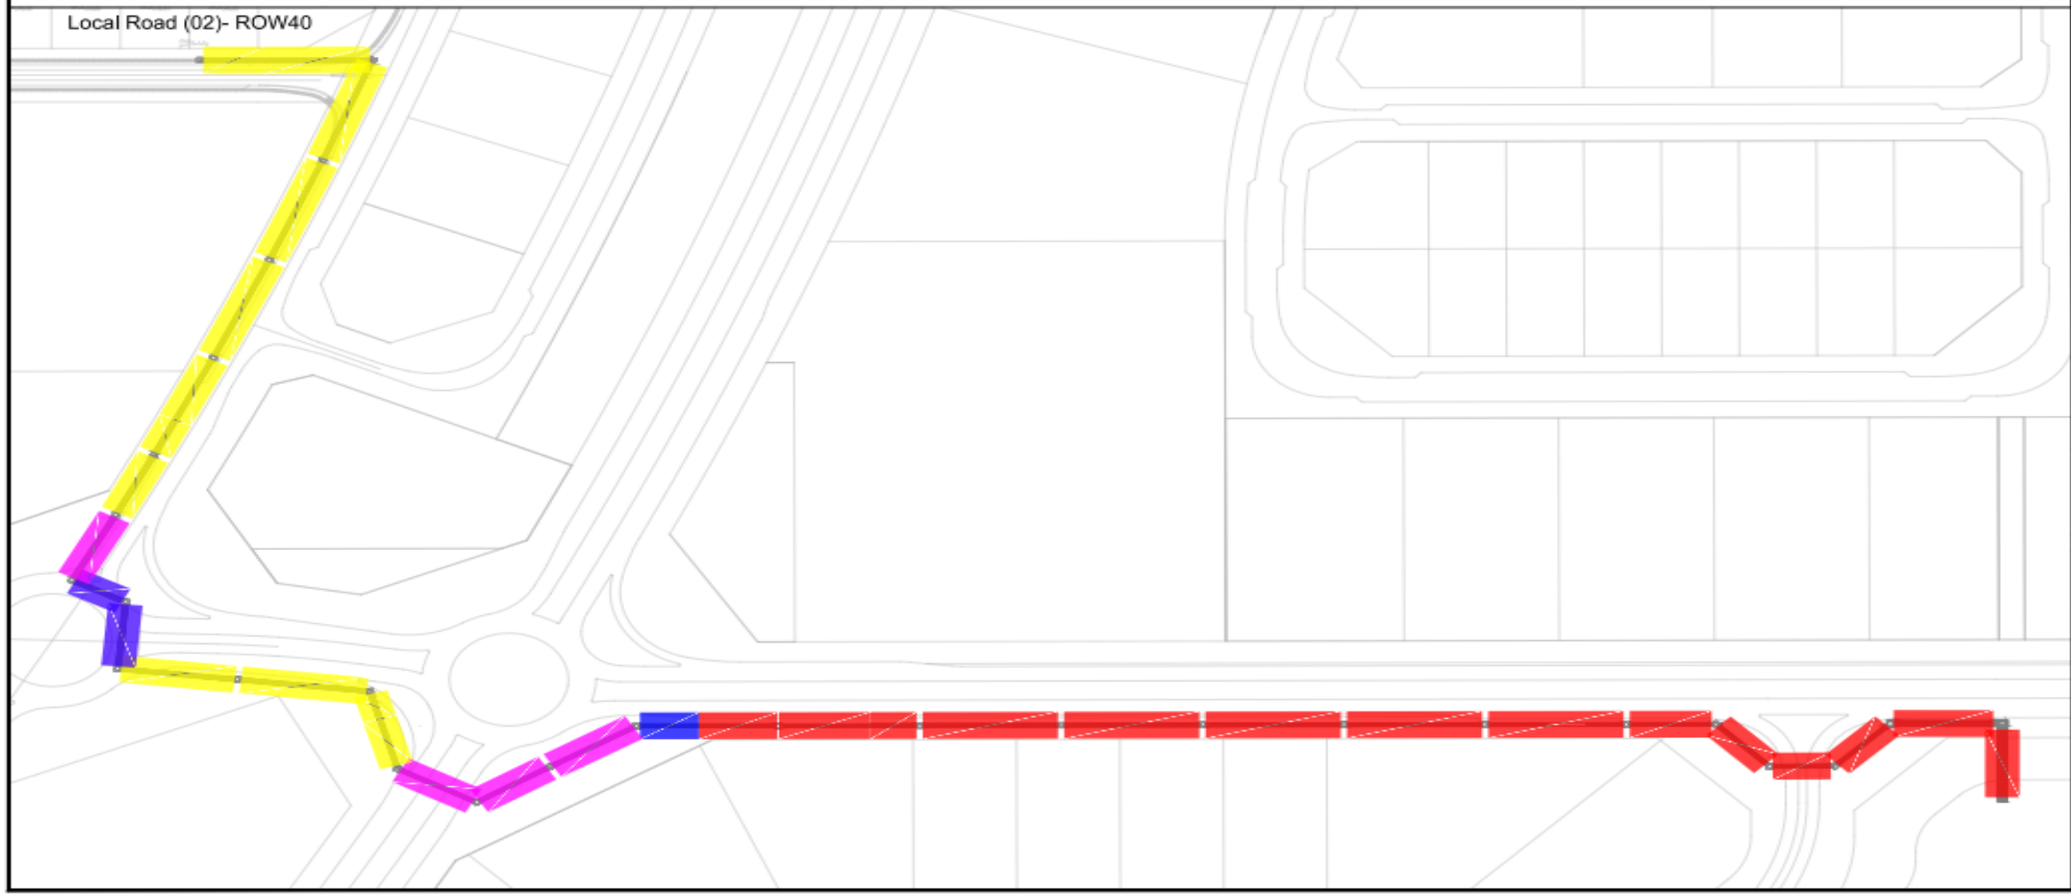

KEY PLAN



Legend

- Excavation
- Blinding
- Installation
- Backfilling
- Remaining

REFERENCE DRAWINGS

REVISIONS TABLE

PURPOSE OF ISSUE: FOR APPROVAL


Box Conduit Layout Plan-Zone A

SCALE 1:1000

SHEET

STREET LIGHTING POLES PROGRESS LAYOUT ZONE-A

ZONE A Street Lighting (Poles)				
ITEM	Total Quantity (LM)	Excuted Quantity (EA)	Remaining Quantity (LM)	Percentage %
Excavation	509.00	109.000	400.000	21.41%
Base Installation	509.00	68.000	441.000	13.36%
Backfilling	509.00	0.000	509.000	0.00%

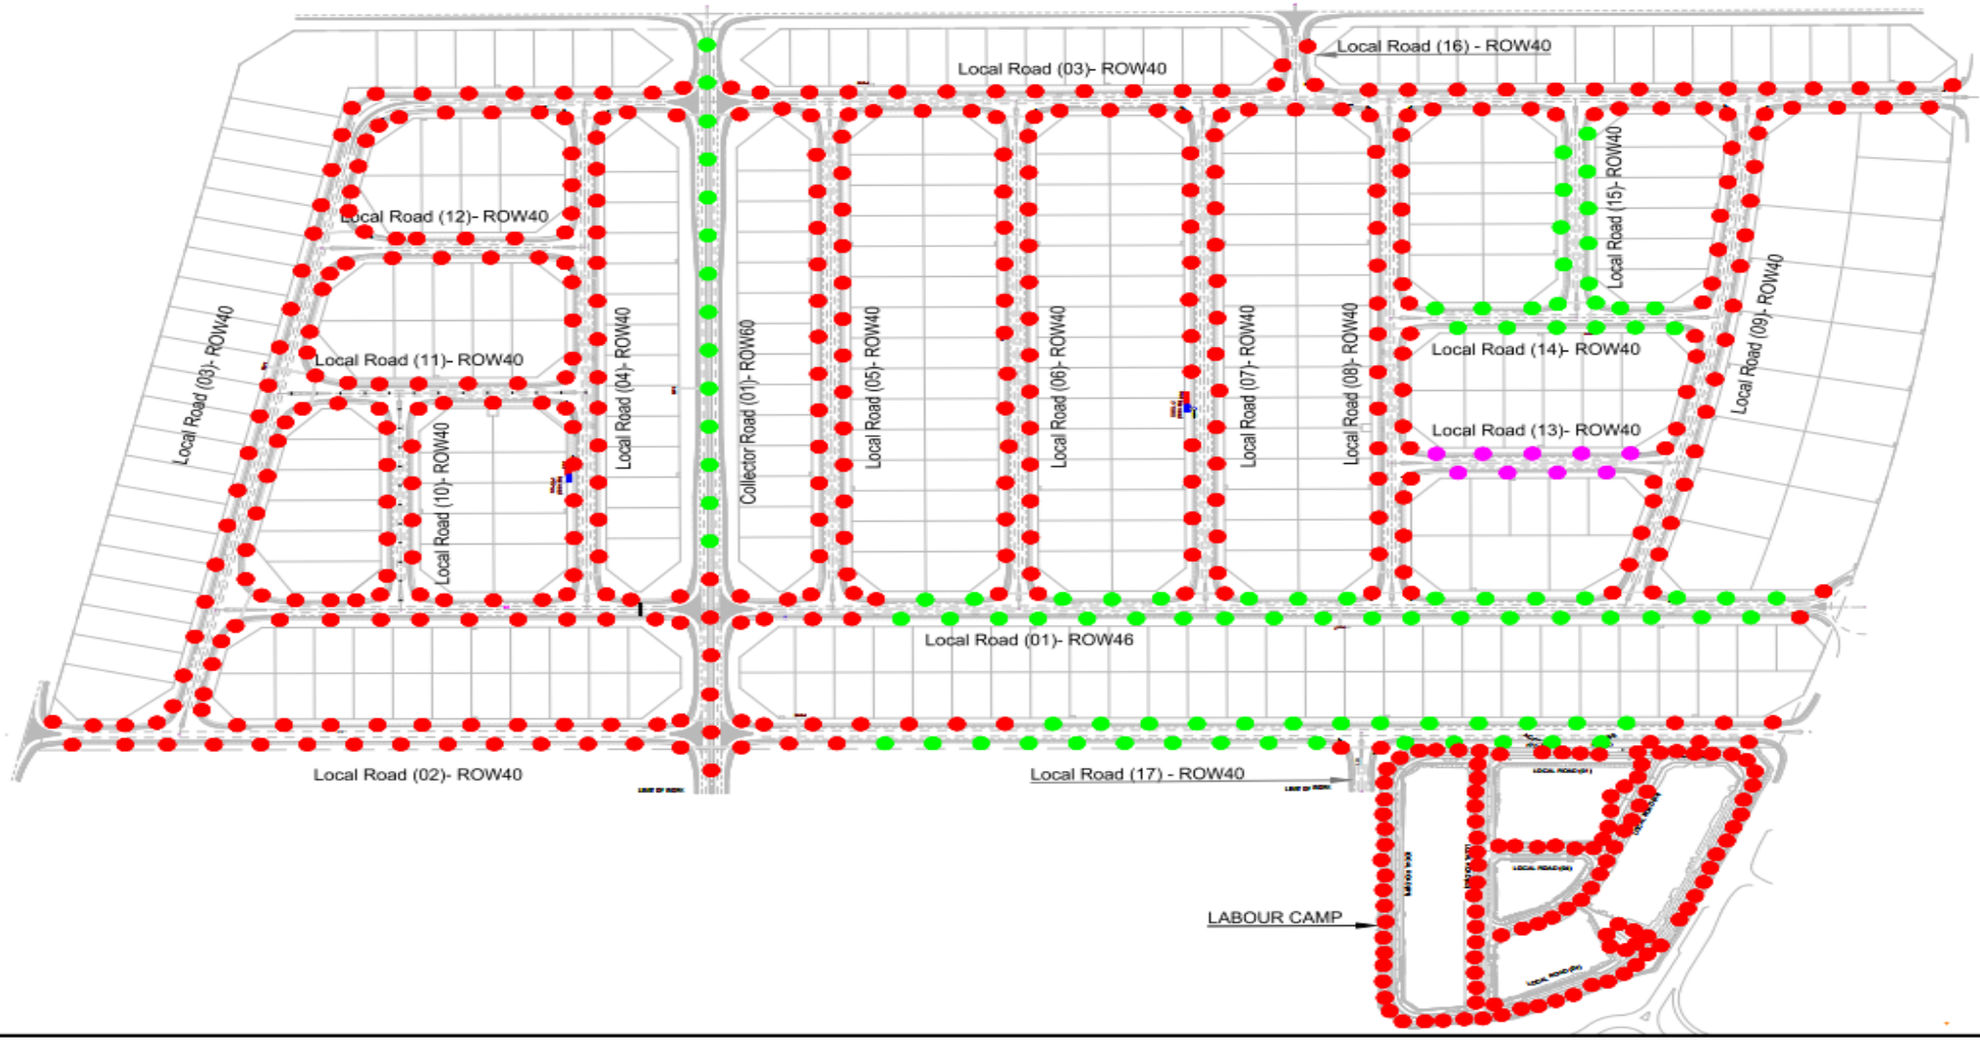

KEY PLAN



Legend

- Excavation
- Base Installation
- Backfilling
- Remaining

REFERENCE DRAWINGS

REVISIONS TABLE

PURPOSE OF ISSUE: FOR APPROVAL

MODON


egis

MOFARREH GROUP

SCALE 1:1000

STREET LIGHTING POLES PROGRESS LAYOUT ZONE-B

ZONE B Street Lighting (Poles)				
ITEM	Total Quantity (LM)	Excuted Quantity	Remaining Quantity (LM)	Percentage %
Excavation	353.00	94	259	26.63%
Foundation Installation	353.00	66	287	18.81%
Backfilling	353.00	82	271	23.29%

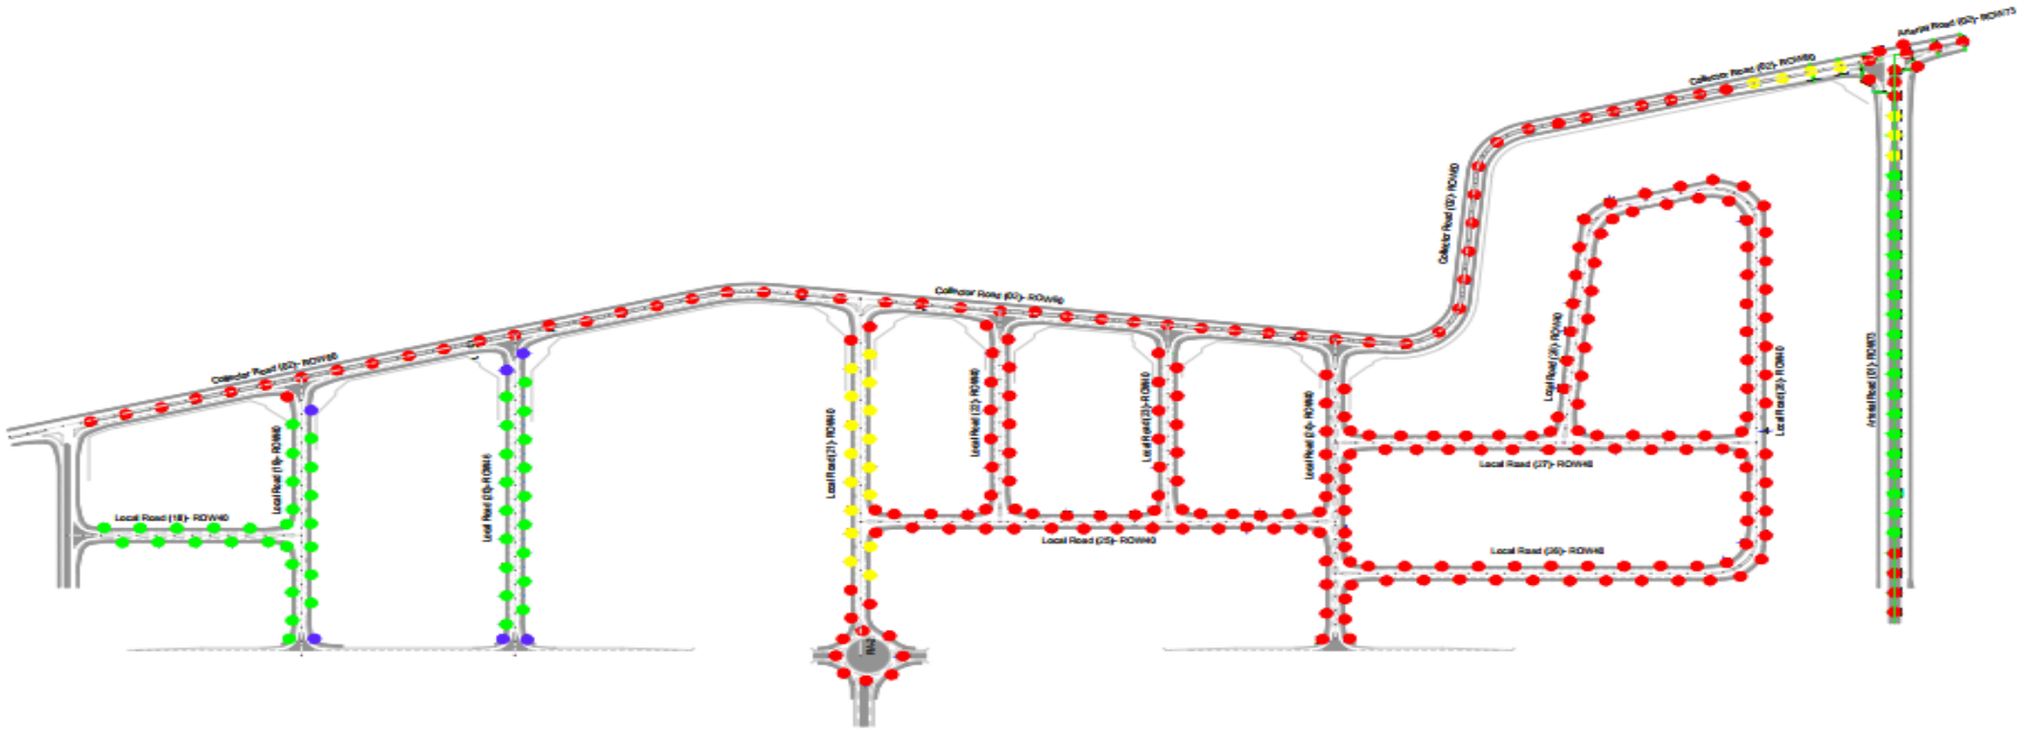

KEY PLAN



Legend

- Excavation
- Foundation Installation
- Backfilling
- Remaining

REFERENCE DRAWINGS

REVISIONS TABLE

PURPOSE OF ISSUE: FOR APPROVAL

MODON

egis

MOFARREH GROUP

ELECTRICAL NETWORK SYSTEM


STREET LIGHTING NETWORK LAYOUT ZONE-B

SCALE:

SHEET

STREET LIGHTING CABLE PROGRESS LAYOUT ZONE-A

ZONE A (STREET LIGHT NETWORK) CABLE				
ITEM	Total Quantity (LM)	Excuted Quantity (LM)	Remaining Quantity (LM)	Percentage %
Excavation	26093.42	1830.980	24262.435	7.02%
Bedding	26093.42	1830.980	24262.435	7.02%
Installation	26093.42	1830.980	24262.435	7.02%
Backfilling	26093.42	1830.980	24262.435	7.02%

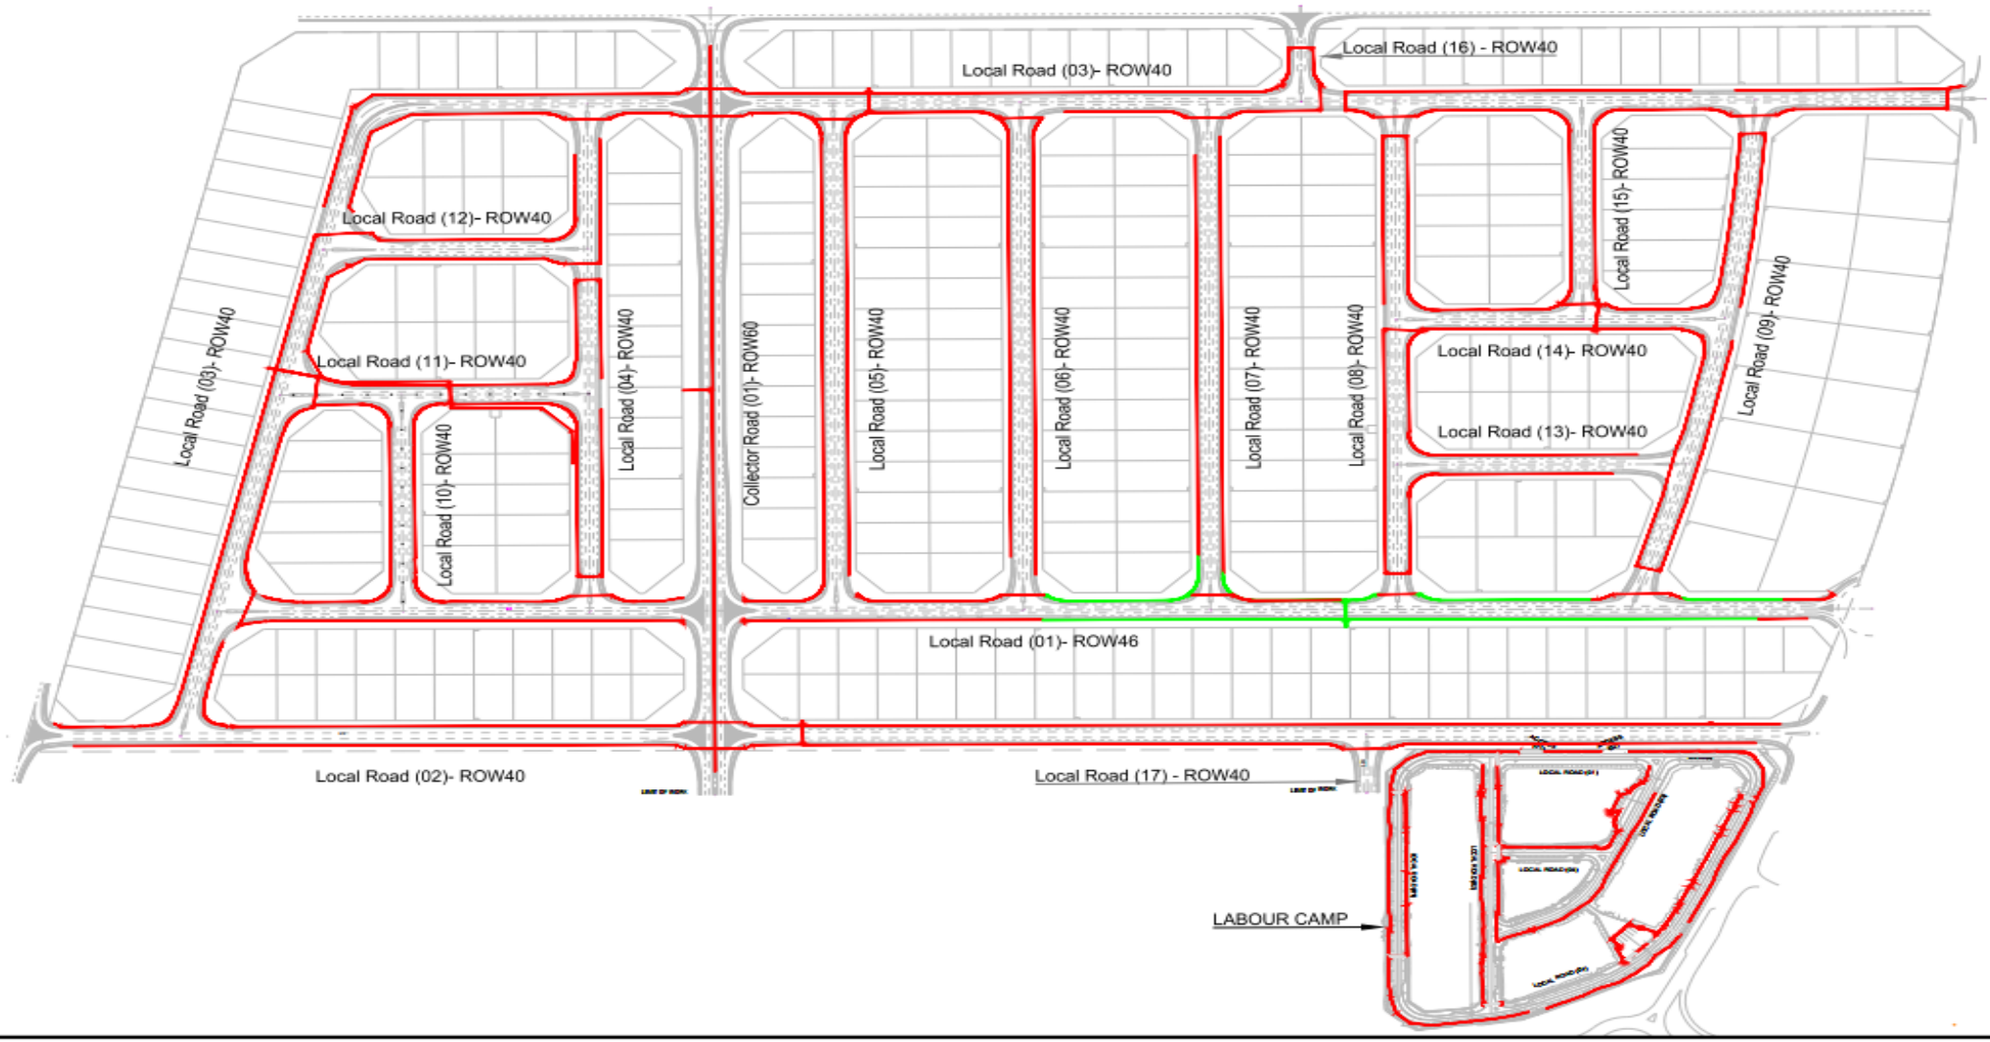

KEY PLAN



Legend

- Excavation
- Sand Bedding
- Installation
- Backfilling
- Remaining

REFERENCE DRAWINGS

REVISIONS TABLE

REV.	DESCRIPTION	DATE

PURPOSE OF ISSUE: FOR APPROVAL

MODON

egis

MOFARREH GROUP



SEWER NETWORK SYSTEM

STREET LIGHTING CABLE PROGRESS LAYOUT ZONE-A

SCALE 1:1000

STREET LIGHTING CABLE PROGRESS LAYOUT ZONE-B

ZONE B (STREET LIGHT NETWORK) CABLE				
ITEM	Total Quantity (LM)	Excuted Quantity (LM)	Remaining Quantity (LM)	Percentage %
Excavation	18,276.50	2403.018	15873.485	13.15%
Bedding	18,276.50	2403.018	15873.485	13.15%
Installation	18,276.50	2403.018	15873.485	13.15%
Backfilling	18,276.50	2248.716	16027.787	12.30%

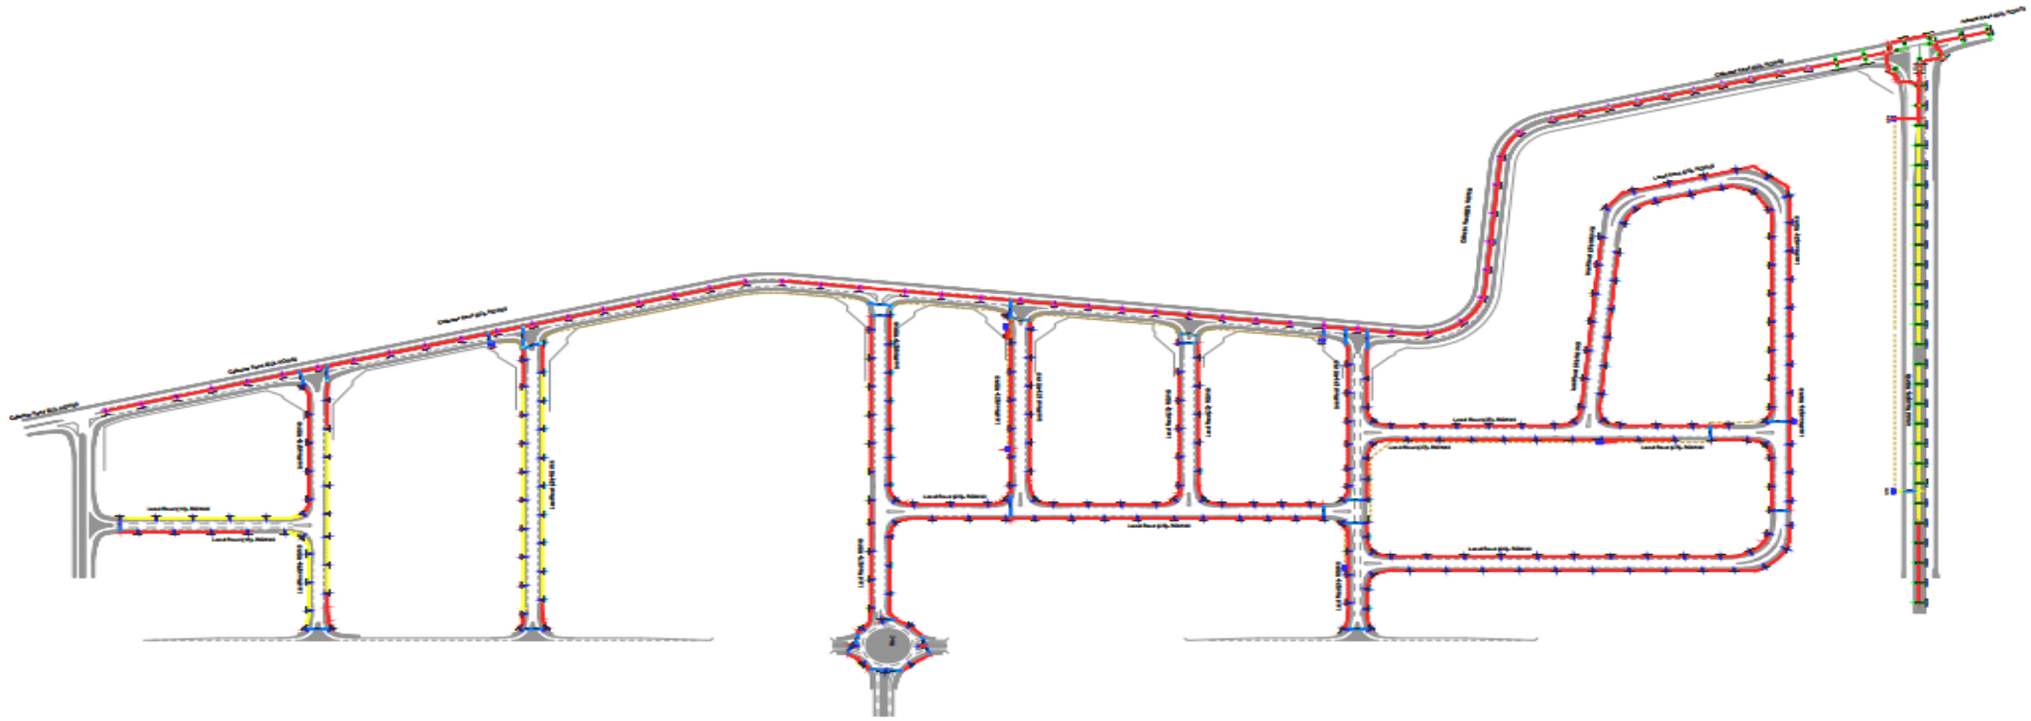

KEY PLAN



Legend

- Excavation
- Foundation Installation
- Backfilling
- Remaining

REFERENCE DRAWINGS

REVISIONS TABLE

PURPOSE OF ISSUE: FOR APPROVAL

ELECTRICAL NETWORK SYSTEM


STREET LIGHTING NETWORK LAYOUT ZONE-B

SCALE

SHEET

MV NETWORK PROGRESS LAYOUT ZONE-A

ZONE A (MV NETWORK) CABLE				
ITEM	Total Quantity (LM)	Excuted Quantity (LM)	Remaining Quantity (LM)	Percentage %
Excavation	27225.00	5312.940	21912.060	19.51%
Bedding	27225.00	5312.940	21912.060	19.51%
Installation	27225.00	5312.940	21912.060	19.51%
Backfilling	27225.00	0.000	27225.000	0.00%

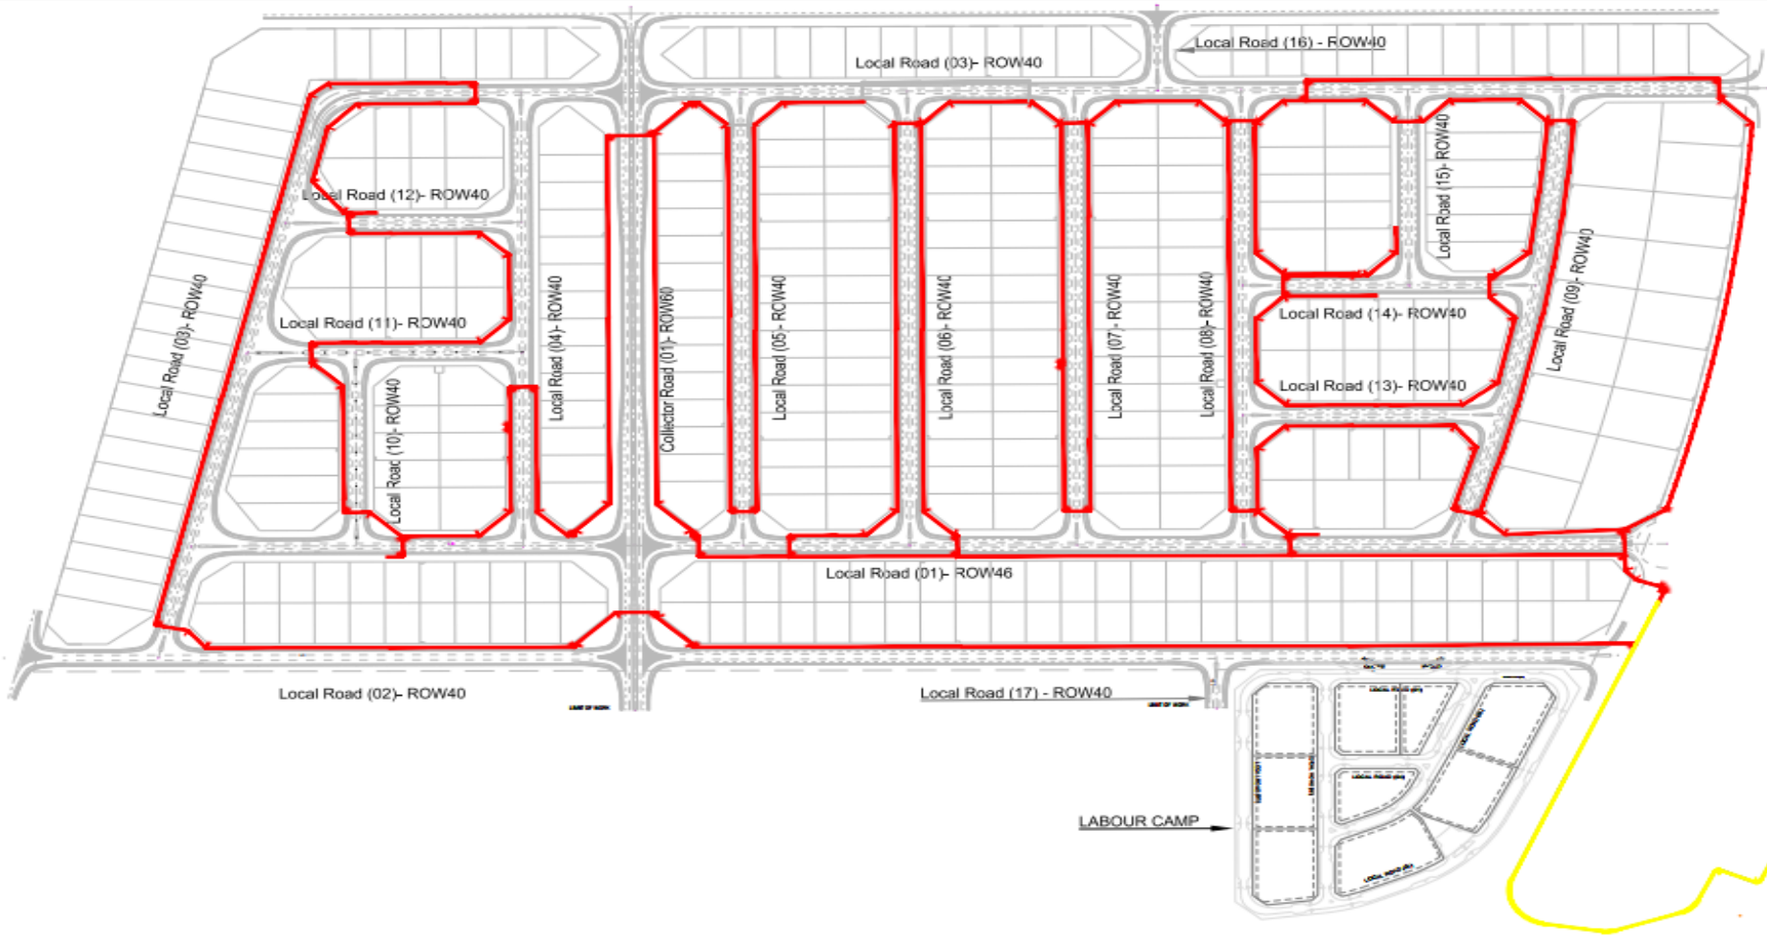



Legend

- Excavation
- Sand Bedding
- Cable Installation
- Backfilling
- Remaining

REFERENCE DRAWINGS

REVISIONS TABLE

PURPOSE OF ISSUE: FOR APPROVAL



MV PROGRESS LAYOUT ZONE-A

SCALE 1:1000

MV NETWORK PROGRESS LAYOUT ZONE-B

ZONE B (MV NETWORK) CABLE				
ITEM	Total Quantity (LM)	Excuted Quantity	Remaining Quantity (LM)	Percentage %
Excavation	44775.21	21604.040	23171.170	48.25%
Bedding	44775.21	21024.040	23751.170	46.95%
Installation	44775.21	21024.040	23751.170	46.95%
Backfilling	44775.21	0.000	44775.210	0.00%

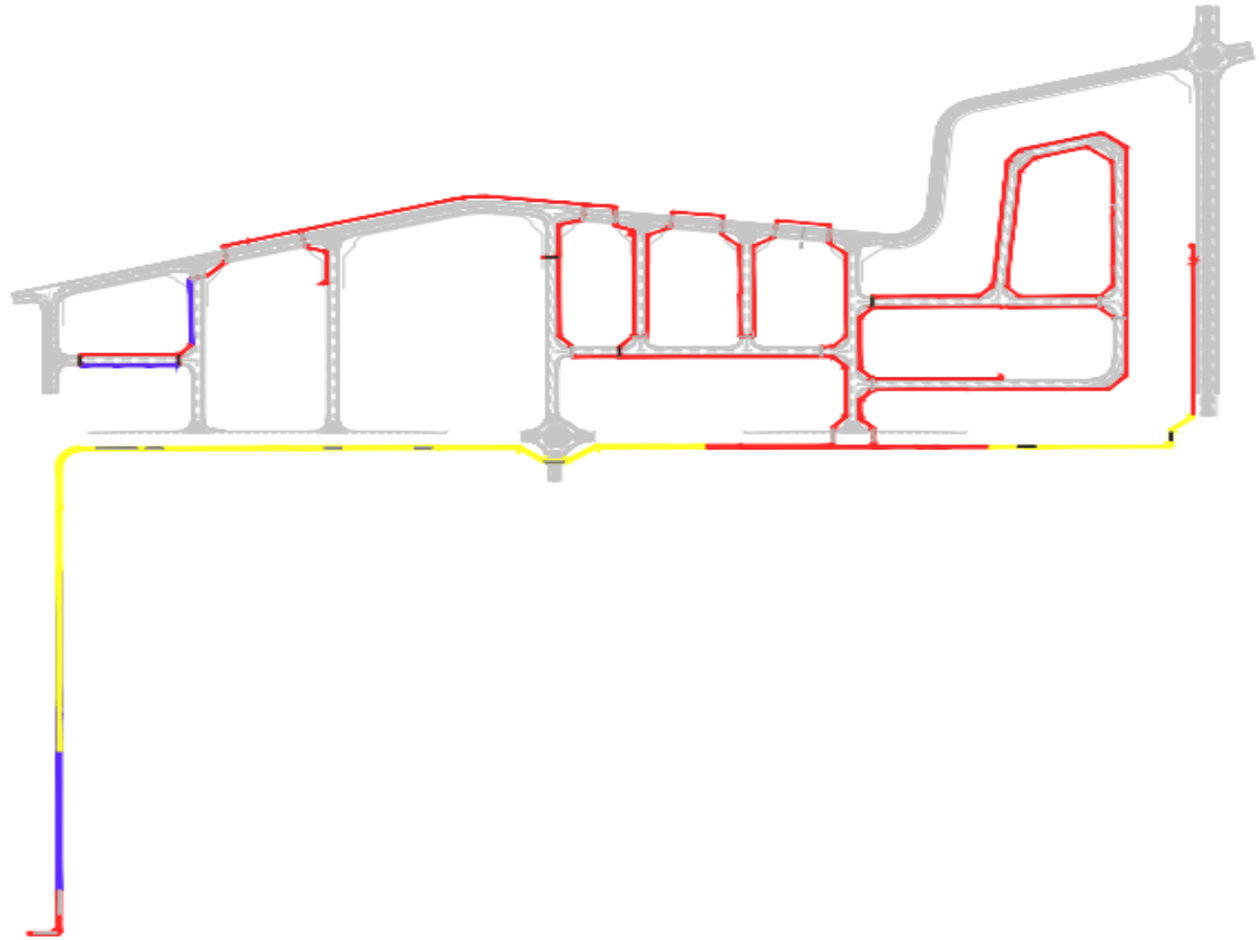

KEY PLAN



Excavation

Installation

Backfilling

Remaining

0 10 20 30 40 50 100 METERS

SCALE (A1) 1:1000

REFERENCE DRAWINGS

REVISIONS TABLE

PURPOSE OF ISSUE: FOR APPROVAL

MODON

egis

MOFARREH GROUP


Weekly Progress

MV NETWORK LAYOUT - ZONE B

SCALE 1:1000 Date

TELECOM NETWORK PROGRESS LAYOUT ZONE-A

ZONE A (TEL NETWORK) PROGRESS (2X32 mm + 6X50 mm)				
ITEM	Total Quantity (LM)	Excuted Quantity (LM)	Remaining Quantity (LM)	Percentage %
Excavation	34149.18	0.000	34149.181	0.00%
Bedding	34149.18	0.000	34149.181	0.00%
Installation	34149.18	0.000	34149.181	0.00%
Backfilling	34149.18	0.000	34149.181	0.00%

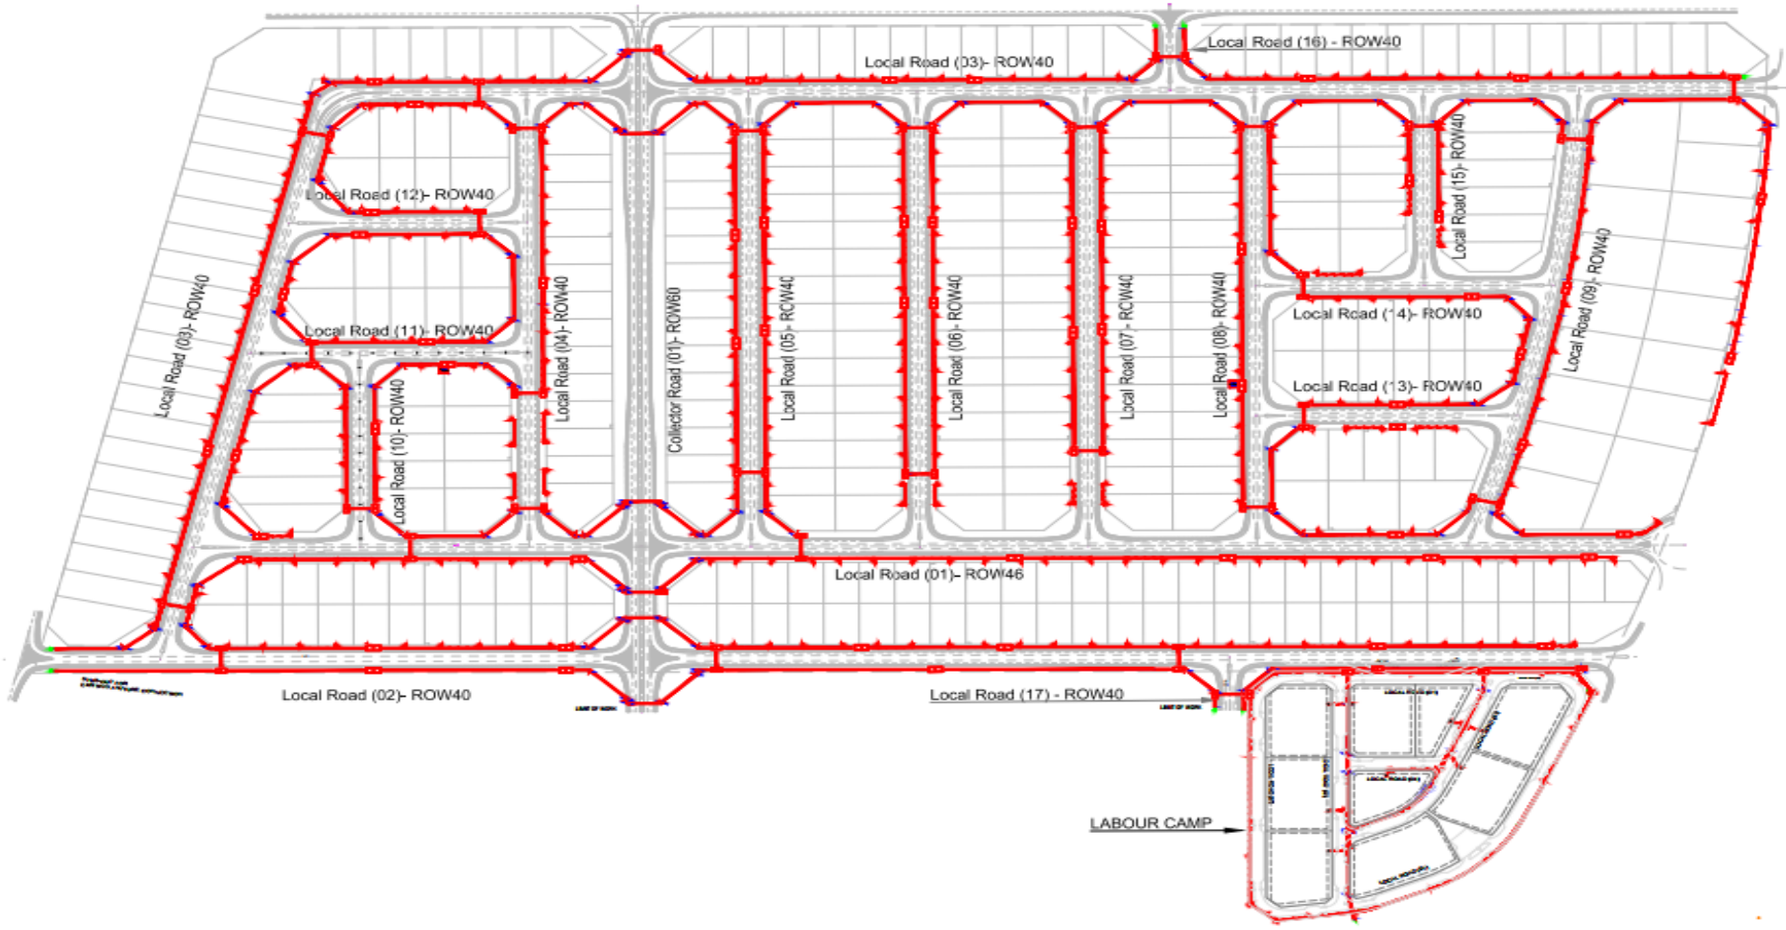

KEY PLAN



Legend

- Excavation
- Sand Bedding
- Installation
- Backfilling
- Remaining

REFERENCE DRAWINGS

REVISIONS TABLE

REV	DESCRIPTION	DATE

PURPOSE OF ISSUE: FOR APPROVAL



TELECOM PROGRESS LAYOUT ZONE-A

SCALE 1:1000

DATE:

TELECOM NETWORK PROGRESS LAYOUT ZONE-B

ZONE B (TEL NETWORK) PROGRESS (2X32 mm + 6X50 mm)				
ITEM	Total Quantity (LM)	Excuted Quantity	Remaining Quantity (LM)	Percentage %
Excavation	20299.28	1042.153	19257.129	5.13%
Bedding	20299.28	1042.153	19257.129	5.13%
Installation	20299.28	1042.153	19257.129	5.13%
Backfilling	20299.28	0.000	20299.282	0.00%

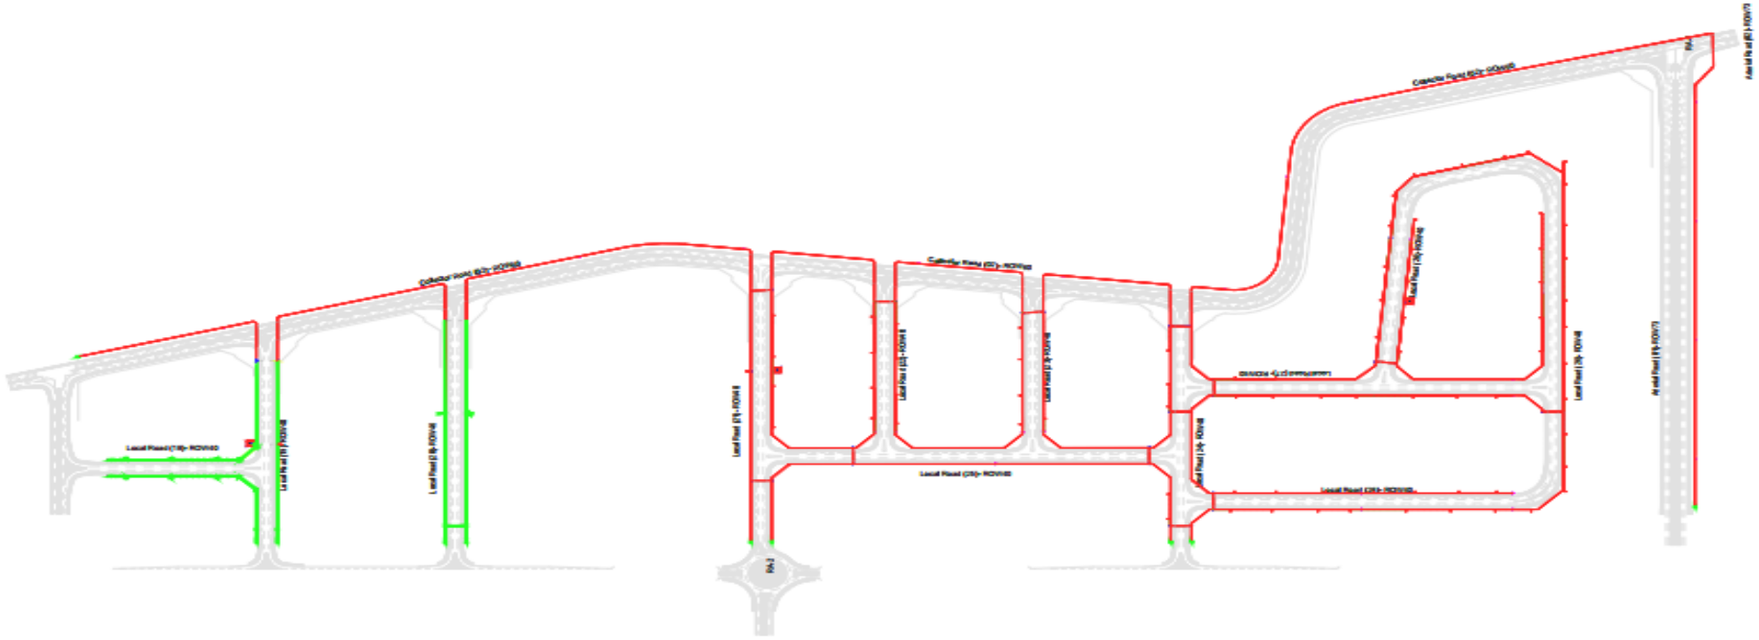

KEY PLAN



Legend

- Excavation
- Bedding
- Installation
- Backfilling
- Remaining

REFERENCE DRAWINGS

REVISIONS TABLE

PURPOSE OF ISSUE: FOR APPROVAL


TELECOM NETWORK SYSTEM


TELECOM NETWORK LAYOUT ZONE B

SCALE

0 10 20 30 40 50 100 METERS

SCALE (A1) 1:1000

MOSQUE PROGRESS LAYOUT

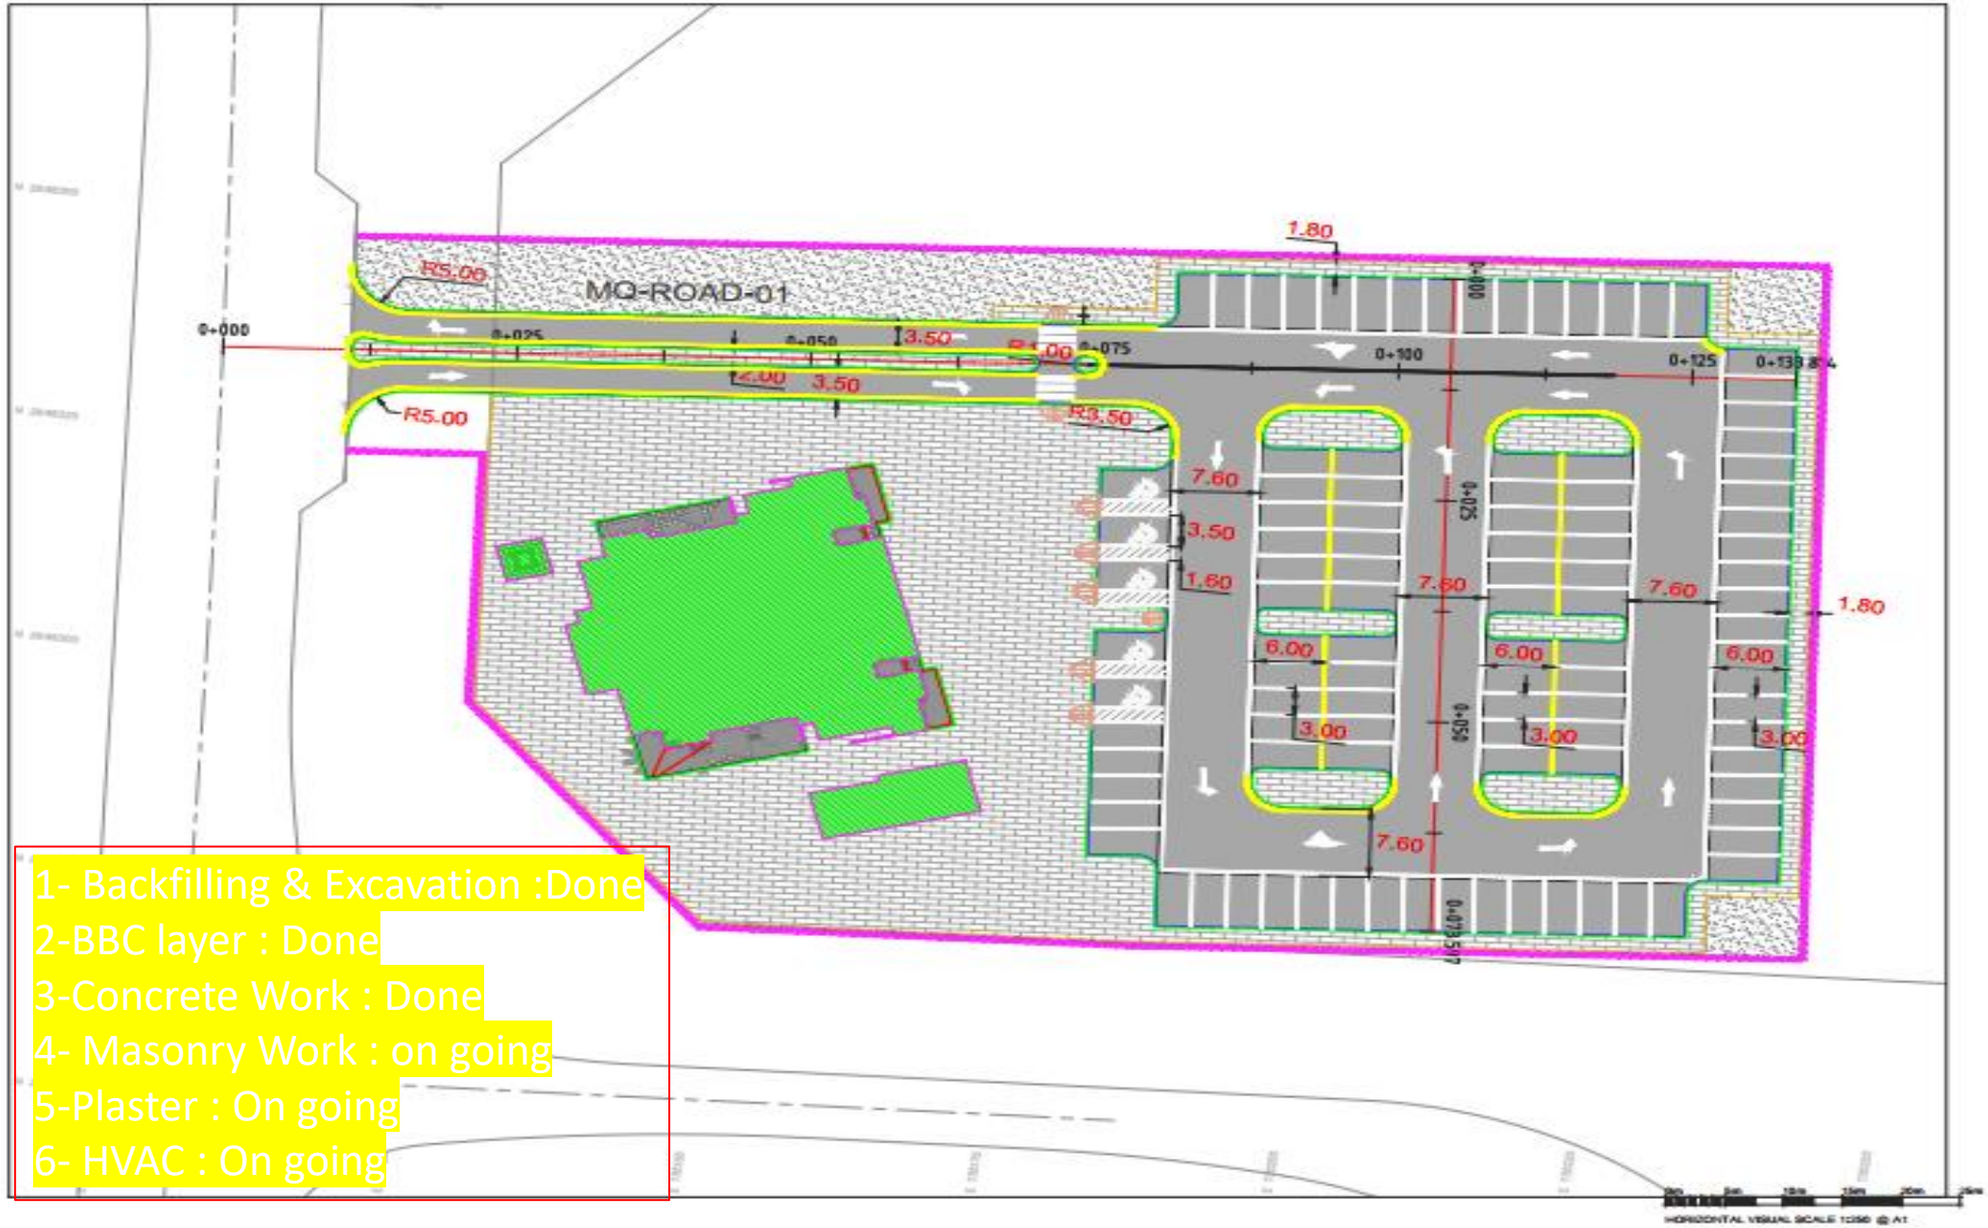

1- Backfilling & Excavation :Done
2-BBC layer : Done
3-Concrete Work : Done
4- Masonry Work : on going
5-Plaster : On going
6- HVAC : On going

ENGINEERING STATUS

Shop Drawings Status							15/10/2026		Asbuilt Status								
Row Labels	A	B	C	D	UR	Grand Submitted Total	Total Required shd	Remainig	A	B	C	D	Under Review	Total Submited	Grand Total	Remaining	Actual remaing Remarks
ARC	38	37	0	0	7	82	82	0						0	65	65	DONE
CBC	50	23	0	0	0	73	73	0					8	8	82	74	DONE
CIV	3	5	0	0	0	8	8	0						0	3	3	DONE
ELE	30	48	4	0	0	82	82	0						0	71	71	DONE
MV	0	40	0	0	0	40	40	0						0	40	40	SUBMITTED TO EGIS For Information
HVA	0	9	0	0	0	9	9	0						0	9	9	DONE
IRR	35	137	0	0	0	172	172	0						0	130	130	DONE
LOG	0	3	0	0	0	3	3	0						0	0	0	DONE
LSC	23	28	0	0	0	51	56	5						0	51	51	DONE
MEP	8	11	0	0	0	19	19	0						0	14	14	DONE
POT	40	118	0	0	0	158	158	0						0	116	116	DONE
ROD	20	1036	0	0	0	1056	1078	22						0	167	167	DONE
SEW	0	93	0	0	0	93	93	0						0	77	77	DONE
ST	26	118	0	0	0	144	144	0						0	117	117	DONE
STR	23	128	0	0	0	151	151	0					52	52	126	74	DONE
TEL	11	17	0	0	0	28	28	0						0	26	26	DONE
FFS	0	11	0	0	0	11	11	0						0	11	11	DONE
Grand Total	307	1862	4	0	7	2180	2207	27						60	1105	1045	
Percentage	14%	84%	0%	0%	0%	99%		1%						5%			

SEWER NETWORK PROCUREMENT PROGRESS LAYOUT (ZONE-A,B & LABOUR CAMP)

Sewer Network materials status

SR	MATERIAL	UNIT	TOTAL QTY	DELIVERED	% DELIVERED	REMAINING QTY	% REMIAINING
1	GRP PIPE DIA 150 mm	L.M	4,111.00	4,111.00	100.00%	0	0.00%
2	GRP PIPE DIA 200 mm	L.M	12,824.00	11,787.00	91.91%	1037	8.09%
3	GRP PIPE DIA 250 mm	L.M	2,310.00	2,310.00	100.00%	0	0.00%
4	GRP PIPE DIA 300 mm	L.M	2,700.00	2,700.00	100.00%	0	0.00%
5	GRP PIPE DIA 400 mm	L.M	2,086.00	2,086.00	100.00%	0	0.00%
6	GRP PIPE DIA 500 mm	L.M	1,164.00	1,164.00	100.00%	0	0.00%
7	GRP PIPE DIA 600 mm	L.M	1,792.00	1,692.00	94.42%	100	5.58%
8	Sewege Manhole	EA	393.00	390.00	99.24%	3	0.76%
9	Warning tape	Roll	926.00	450.00	48.60%	476	51.40%

STORM NETWORK PROCUREMENT PROGRESS LAYOUT (ZONE-A,B & LABOUR CAMP)


Updated till 23-10-2026							
Storm Network materials status							
SR	MATERIAL	UNIT	TOTAL QTY	DELIVERED QTY	% DELIVERED	REMAINING QTY	% REMIAINING
	GRP PIPE DIA 300 mm	L.M	204.00	0.00	0.00%	204.00	100.00%
1	GRP PIPE DIA 400 mm	L.M	12,695.00	9,970.00	78.53%	2,725.00	21.47%
2	GRP PIPE DIA 800 mm	L.M	1,850.00	1,572.00	84.97%	278.00	15.03%
3	GRP PIPE DIA 500 mm	L.M	2,605.00	1,860.00	71.40%	745.00	28.60%
4	GRP PIPE DIA 600 mm	L.M	2,578.00	2,796.00	108.46%	-218.00	-8.46%
5	GRP PIPE DIA 700 mm	L.M	1,245.00	1,064.00	85.46%	181.00	14.54%
6	GRP PIPE DIA 900 mm	L.M	870.00	754.00	86.67%	116.00	13.33%
7	GRP PIPE DIA 1000 mm	L.M	765.00	568.00	74.25%	197.00	25.75%
8	GRP PIPE DIA 1200 mm	L.M	1,690.00	1,690.00	100.00%	0.00	0.00%
9	Storm Manhole	EA	298.00	297.00	99.66%	1.00	0.34%
10	Box culvert	EA (2.5 M)	264.00	264.00	100.00%	0.00	0.00%
11	Box Conduit	EA (2.5 M)	799.00	298.00	37.30%	501.00	62.70%
12	Catch basin	EA	668.00	610.00	91.32%	58.00	8.68%
13	UPVC pipe dia 200 mm	L.M	1,818.00	1,500.00	82.51%	318.00	17.49%
14	UPVC pipe dia 300 mm	L.M	13,375.00	12,335.00	92.22%	1,040.00	7.78%
15	UPVC pipe dia 400 mm	L.M	915.00	738.00	80.66%	177.00	19.34%
16	Warning tape	Roll	900.00	450.00	50.00%	450.00	50.00%
17	DI COVERS FOR STORM MANHOLE & CATCH BASIN	EA	966.00	417.00	43.17%	549.00	56.83%

MATERIAL PROGRESS SHEET

Potable Network materials status							
SR	MATERIAL	UNIT	TOTAL QTY	DELIVERED	% DELIVERED	REMAINING QTY	% REMIAINING
1	HDPE PIPE DIA 160 mm	L.M	9,565.00	7,587.00	79.32%	1978	20.68%
2	HDPE PIPE DIA 200 mm	L.M	11,490.00	9,396.00	81.78%	2094	18.22%
3	HDPE PIPE DIA 250 mm	L.M	8,764.00	8,052.00	91.88%	712	8.12%
4	HDPE PIPE DIA 315 mm	L.M	372.00	372.00	100.00%	0	0.00%
5	HDPE PIPE DIA 355 mm	L.M	72.00	72.00	100.00%	0	0.00%
6	DI VALVES	EA	306.00	213.00	69.61%	93	100.00%
7	Fire hydrant	EA	310.00	82.00	26.45%	228	200.00%
TSE Network materials status							
SR	MATERIAL	UNIT	TOTAL QTY	DELIVERED	% DELIVERED	REMAINING QTY	% REMIAINING
1	HDPE PIPE DIA 110 mm	L.M	27,889.00	27,756.00	99.52%	133	0.48%
2	HDPE PIPE DIA 160 mm	L.M	357.00	0.00	0.00%	357	100.00%
3	DI VALVES	EA	211.00	50.00	23.70%	161	76.30%
Secondary Irrigation Network materials status							
SR	MATERIAL	UNIT	TOTAL QTY	DELIVERED	% DELIVERED	REMAINING QTY	% REMIAINING
1	HDPE PIPE DIA 90 mm	L.M	1,126.00	900.00	79.93%	226.00	0.20
2	HDPE PIPE DIA 75 mm	L.M	247.00	0.00	0.00%	247.00	1.00
3	HDPE PIPE DIA 63 mm	L.M	1,254.00	0.00	0.00%	1,254.00	100.00%
4	HDPE PIPE DIA 50 mm	L.M	10,859.00	0.00	0.00%	10,859.00	100.00%
5	HDPE PIPE DIA 32 mm	L.M	37,259.00	0.00	0.00%	37,259.00	100.00%
6	UPVC PIPE 32 MM	L.M	27,800.00	24,684.00	88.79%	3,116.00	11.21%
Telecom Network materials status							
SR	MATERIAL	UNIT	TOTAL QTY	DELIVERED	% DELIVERED	REMAINING QTY	% REMIAINING
1	HDPE PIPE DIA 50 mm	L.M	224,688.00	209,792.00	93.37%	14896	6.63%
2	HDPE PIPE DIA 32 mm	L.M	66,692.00	66,962.00	100.40%	-270	-0.40%
3	HDPE PIPE DIA 16 mm	L.M	900.00	900.00	100.00%	0	0.00%
Electrical Network materials status							
SR	MATERIAL	UNIT	TOTAL QTY	DELIVERED	% DELIVERED	REMAINING QTY	% REMIAINING
1	UPVC PIPE DIA 150 mm	L.M	9,643.00	9,643.00	100.00%	0	0.00%
2	HDPE PIPE DIA 110 mm	L.M	66,692.00	0.00	0.00%	66692	100.00%
3	HDPE PIPE DIA 16 mm	L.M	900.00	0.00	0.00%	900	100.00%
4	UPVC PIPE 110 MM	L.M	4800	4,800.00	100.00%	0	0.00%
5	MV cable (3CX500mm²)	L.M	72000	58,500.00	81.25%	13500	18.75%
6	Foundation for Street Light Poles	EA	981	680.00	69.32%	301	30.68%
5	LV cable (4CX16mm²+4CX95mm²)	L.M	51082	9,800.00	19.18%	41282	80.82%

PORTA CABIN LAYOUT

-Excavation and Backfilling Works: Ongoing.
2-Material Delivery: Not yet started.
3-Asphalt Works: Not yet started.
4-Mechanical Works: Not yet started.

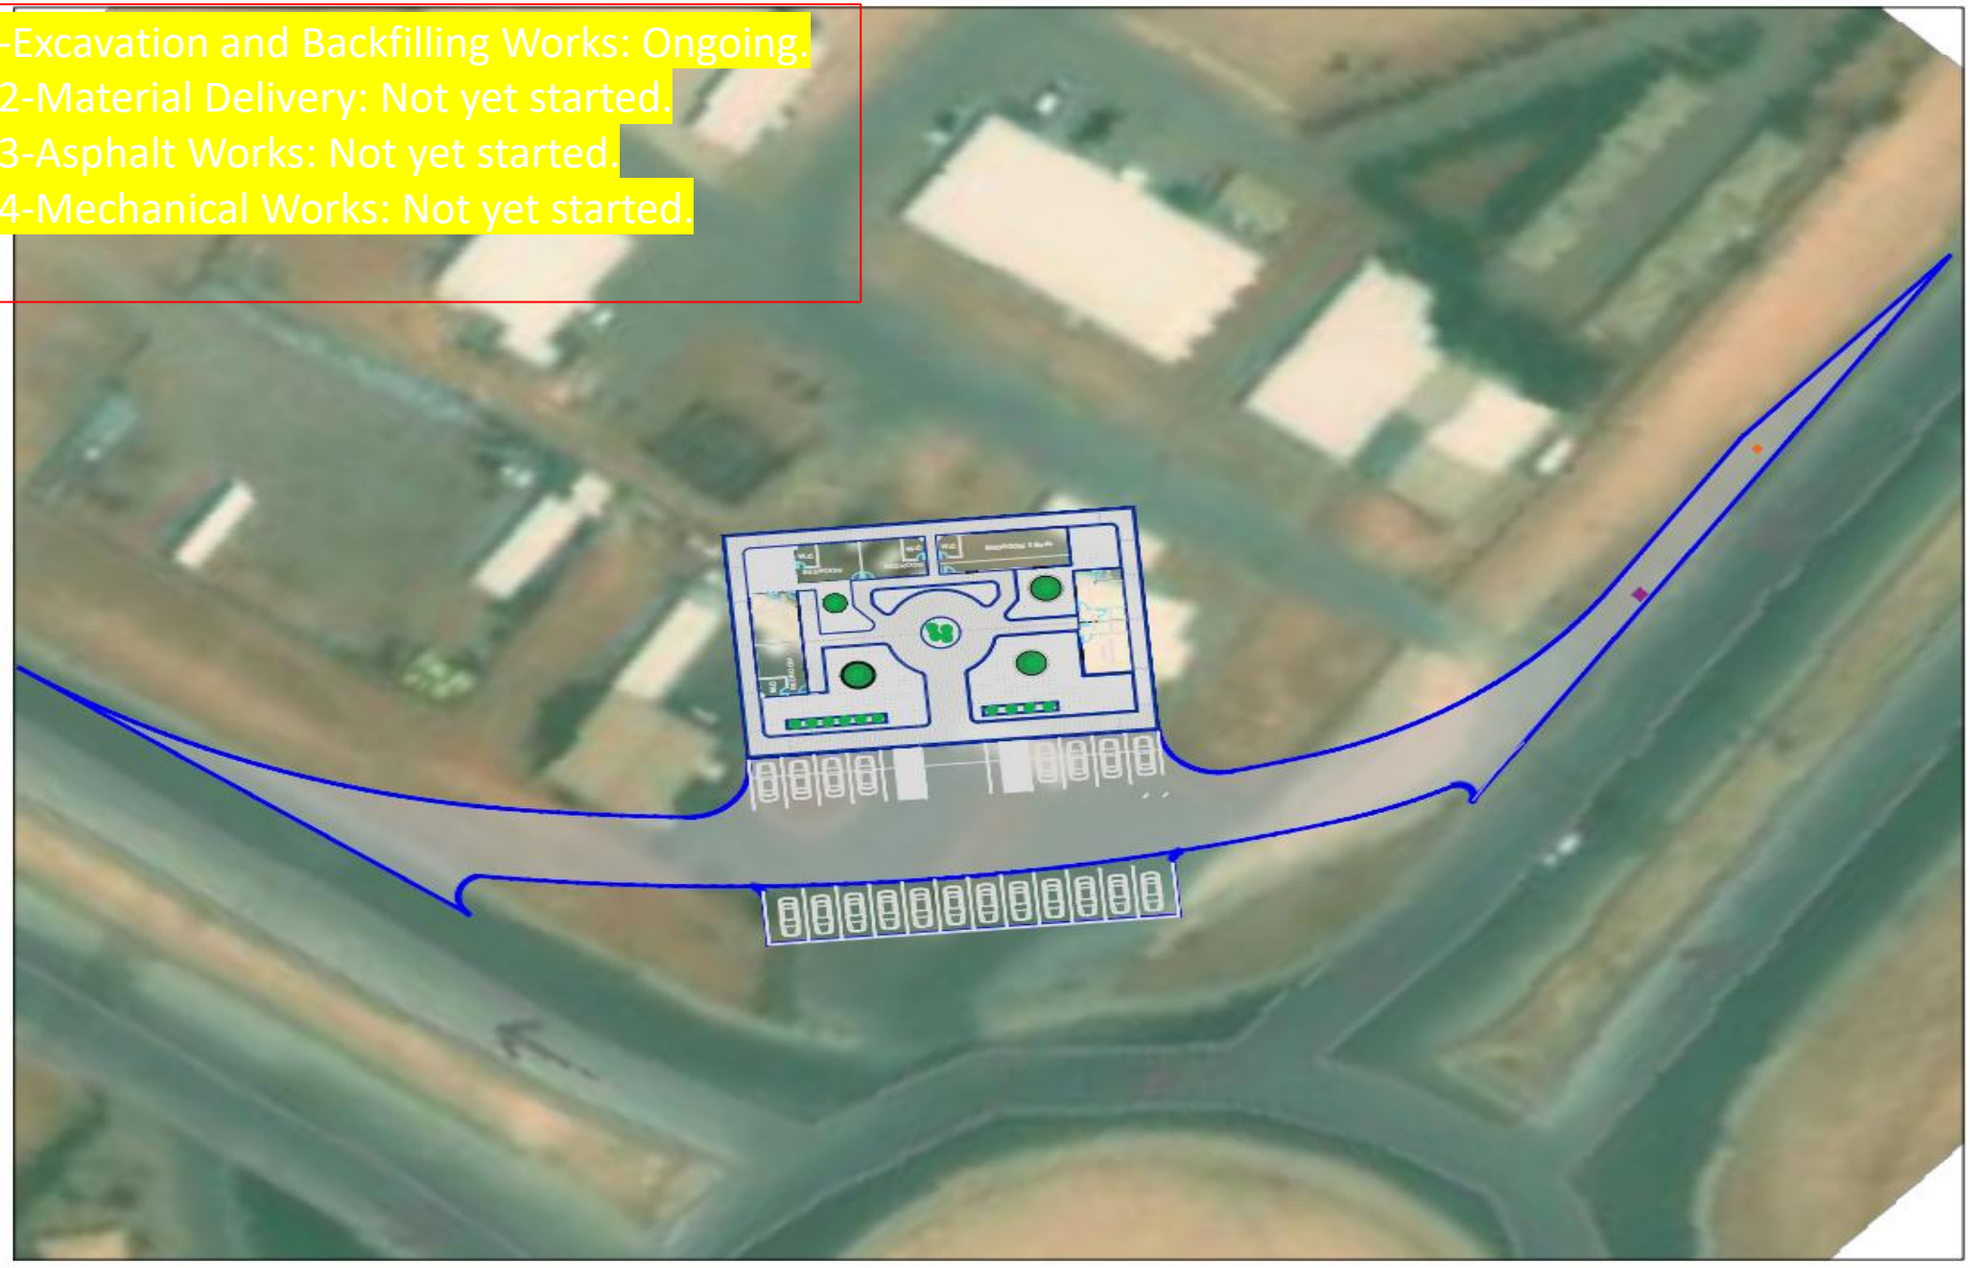

KEY PLAN

NOTES:

1- COORDINATES SYSTEM IS BASED ON UTM - WGS84-ZONE 38

2- ALL LEVELS ARE IN METERS AND DIMENSIONS ARE IN MILLIMETRES UNLESS STATED OTHERWISE.

LEGENDS

- Existing Septic tank
- Existing Water tank
- Existing Storm Manhole
- Existing Electrical Panel
- Existing Informative Signage
- Proposed Asphalt
- Existing Traffic Signage
- Existing Pole Foundation

REFERENCE DRAWINGS

REVISIONS TABLE

REV	DESCRIPTION	DATE
02		
01		
00		

PURPOSE OF ISSUE: FOR APPROVAL

MODON

egis

MOFARREH GROUP

MODON - UPDATED CONCEPT MASTER PLAN AND INFRASTRUCTURE DESIGNS FOR AL-KHARJ INDUSTRIAL CITY

PortaCabins Finish Grading Layout Plan at AL-Kharj Project

KHJ1-02-007-MAH-TS9-1-ROD-DWG-SD-00-1024-02

SCALE

SHEET 1 of 2