egis / MOFARREH GROUP	Document Title:	**DOCUMENT SUBMISSION FORM**			MODON
	Project Name:	Development of Infrastructure in Alkharj Industrial City.	Project Contractor:	MOFARREH GROUP	
	Project Number:	KHJ1-02-007	Project Consultant:	EGIS	
	Project Program Manager:		Document Reference No.:	KHJ1-02-007-MAH-TS9-1-PRM-WPR-0039-00	

DOCUMENT ISSUED BY				DOCUMENT RECEIVED BY			
Issued By	Hassan Salam			Received By			
Position / Company	Project Manager			Position / Company			
Signature				Signature			
	September 29 2026	Time	09:30 AM	Date		Time	

RECEIVED 29 SEP 2026 Egis

DOCUMENT SUBMISSION TYPE *(Tick relevant Box)*

	As Built		Material Sample		Bill of Quantities
	Certificate		Manual		Schedule
	Drawing		Pre-qualification		Shop Drawing
	Engineering Calculation		Procedure/Methodology		Bank Warranty
	Job Order		Product Data		Letter
■	Report		Test Report		Other

PURPOSE FOR DOCUMENT SUBMISSION				DATE RESPONSE REQUIRED BY
FOR INFORMATION ☐	FOR REVIEW & APPROVAL ■	AS REQUESTED ☐	OTHER *(As Noted)* ☐	*Indicate Date*

SUBMITTED DOCUMENTS REFERENCE NUMBERS

#	Document Reference No.	Document Description	Rev.	Hard Copy	Soft Copy
1	KHJ1-02-007-MAH-TS9-1-PRM-WPR-0039	Weekly Progress Report (September 28, 2026)	00		

To continue List - use "Submittal Continuation Form"(MOD-DOC-10.0-002)

RESPONSE STATUS

APPROVED AS SUBMITTED (APP)	APPROVED AS NOTED (APN)	REJECTED / RE-SUBMIT (RRS)
☐	■	☐

COMMENTS

Please find attached comments sheets (CRS) to comply

To continue Comments - use "Submittal Continuation Form"(MOD-DOC-10.0-002)

RESPONSE ISSUED BY				RESPONSE RECEIVED BY			
Issued By				Received By			
Position / Company				Position / Company			
Signature				Signature			
Date		Time		Date		Time	

RECEIVED 29 SEP 2026

Egis Saudi Engineering Consultant C.R:1010596943

DAR CM Team	Action 1 (Initial)	Date / Time	Action 2 (Initial)	Date / Time	Action 3 (Initial)	Date / Time	Action 4 (Initial)	Date / Time	DAR CM Target Response - Work Days

KHJ1-02-007-MAH-TS9-1-PRM-WPR-0039-00

CRS Industrial City Weekly Report Sep 28, 2026.

1. The Contractor shall clearly distinguish between Submitted Invoice Value and FIR Value in the Cost Summary. The submitted gross invoice value of approximately SAR 27.73M represents approximately 9.01% of the contract value, whereas SAR 39.73M represents approximately 12.90%. The current presentation may result in confusion between invoicing and FIR values.

2. Contract Milestones remains open with an expected closure date of 30-Aug-2026, which is 29 days before the current reporting date of 28-Sep-2026. The Contractor shall update the issue status and provide a revised realistic closure date and recovery action, if still applicable.

- Road Works = 02-Oct-2026 . **Not Applicable**
- MV Network = 02-Oct-2026. **Not Applicable**
- All Networks = 02-Feb-2027. On Progress
- Project Handover = 02-Dec-2027. On Progress

3. The Manpower sheet reports 659 actual non-manual personnel against 435 planned personnel for September, representing approximately 51.5% above plan. The Contractor shall provide the corresponding variance explanation and ensure that the manpower summary in the Weekly Progress Report is correctly linked to the source data.

4. Several Risk Register records contain inconsistent status/closure information. Risks marked as "Open" also contain "Closed" in the closure field, The Contractor shall review the Risk Register and reconcile status, identification/closure dates and treatment status, in additional Open issues shall include a current status, responsible party, target closure date and latest mitigation/action update. Open issues without a defined target date cannot be effectively monitored through the Weekly Project Control Report.

Yasser El naggar

Egis Saudi Engineering Consultancy C.R:1010596943


Data sensitivity - Public

Weekly Progress Report - Construction Projects	28-Sep-26
Contract General Information	
Project Name	Development Industrial City-Alkharj
Project ID	3121
Contractor	Moffreh Group
Consultant	EGIS
Stage	42nd Week
Modon PM	Rakan Alotaibi
Key Dates	
Contract Award Date	09-Nov-25
Contract Sign Date	16-Nov-25
Site Handover Date	03-Dec-25
Original Completion	02-Dec-27
Contract Award Date (Hijri)	18/05/1447
Contract Sign Date (Hijri)	25/05/1447
Site Handover Date (Hijri)	12/06/1447
Original Completion (Hijri)	04/07/1449
Revised Completion Date	02-Dec-27
Committed Completion Date	02-Dec-27
Forecast Completion	02-Dec-27
Variance	0

Data sensitivity - Public

CUT & FILL LAYOUT ZONE-A

ZONE A(Cumulative Qty)				
ITEM	Total Quantity (m3)	Excuted Quantity (m3)	Remaining Quantity (m3)	Percentage %
Fill	357335	189431	167904	53.01%
Cut	97475	89831	7644	92.16%

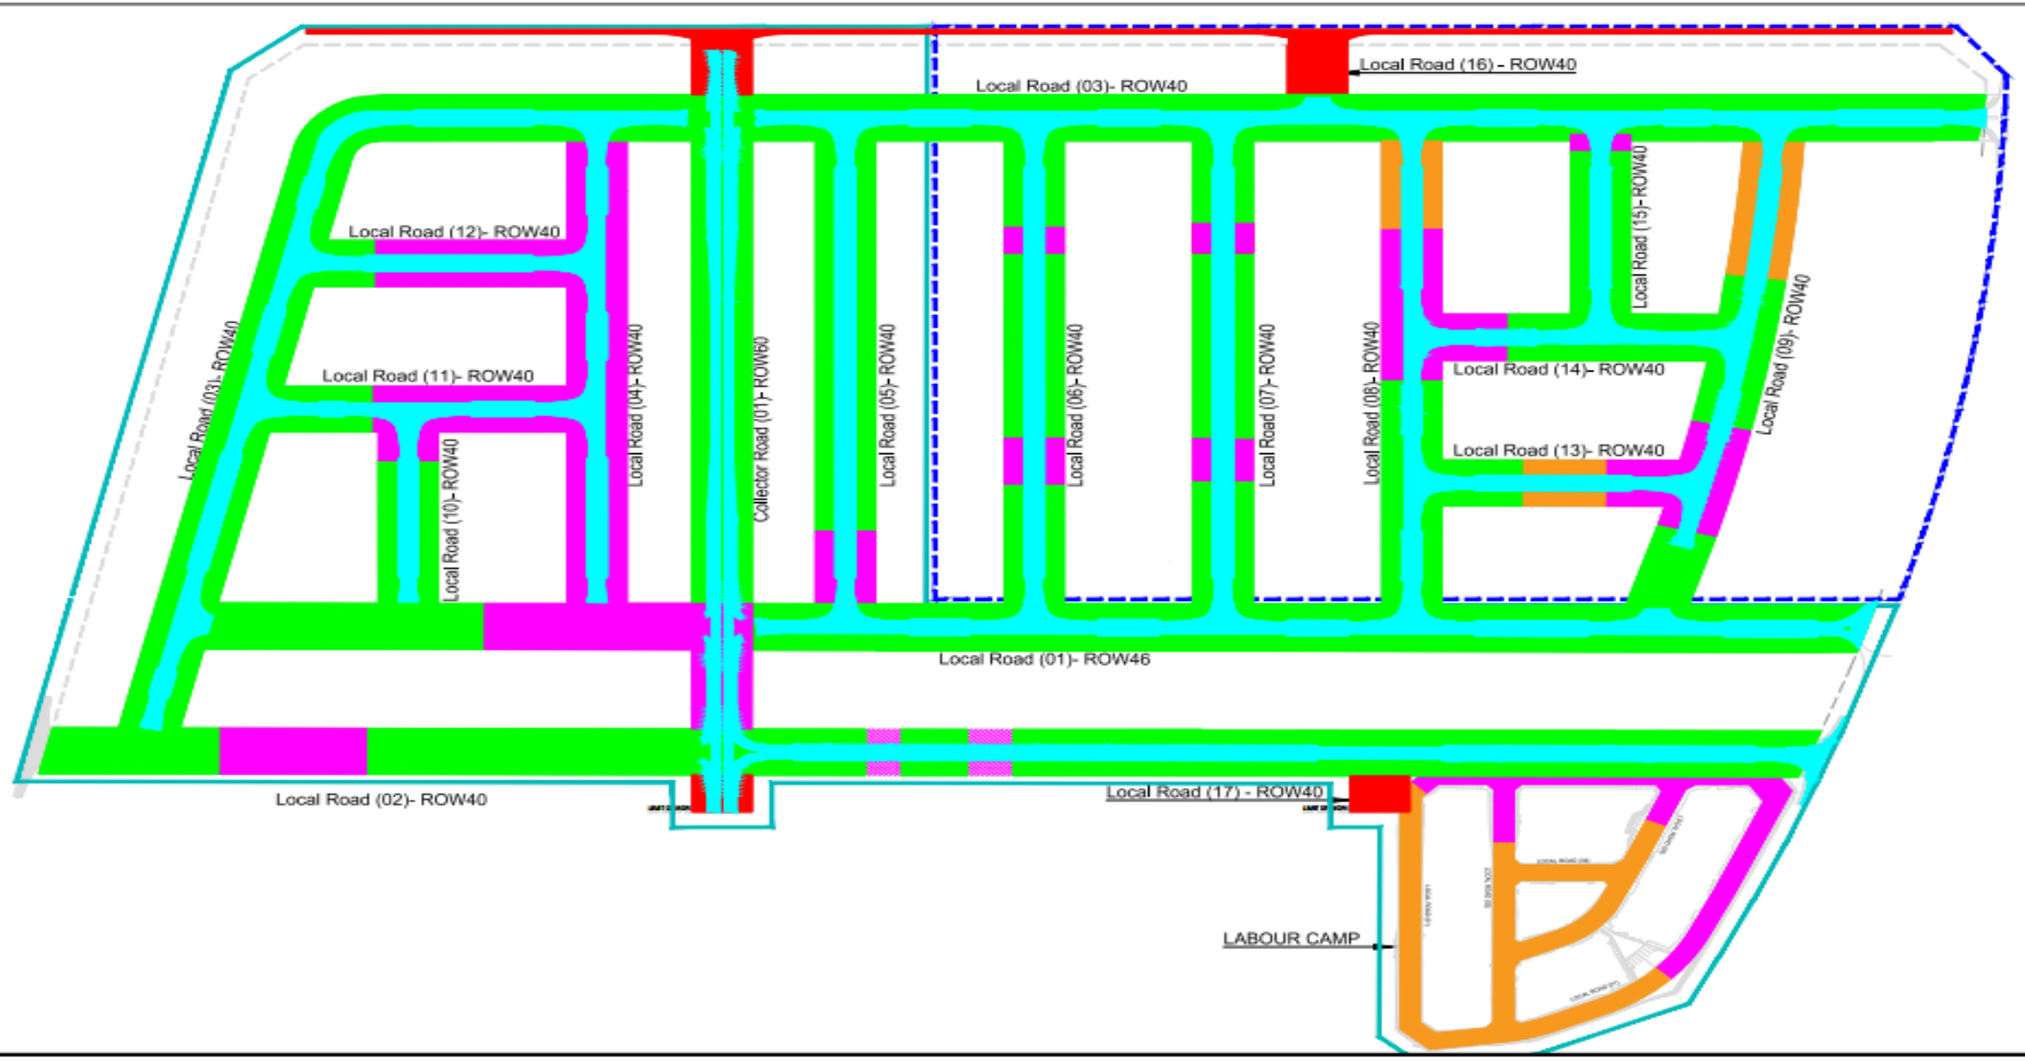



Legend

- Excuted Fill
- Excuted Cut
- Remaining Cut
- Remaining Fill
- Bottom Subgrade

Work Area

- Engr.Shamy
- Engr.Mohammed

0 10 20 30 40 50 100 METERS
SCALE (A1) 1:1000

REFERENCE DRAWINGS

REVISIONS TABLE

PURPOSE OF ISSUE: FOR APPROVAL


Weekly Progress

FILL-ZONE A

SCALE 1:1000

BACKFILLING LAYOUT ZONE-B

ZONE B (CUT&FILL) PROGRESS				
ITEM	Total Quantity (m3)	Excuted Quantity (m3)	Remaining Quantity (m3)	Percentage %
Fill	505230	194254	310976	38.45%
Cut	40190	36189	4001	90.04%

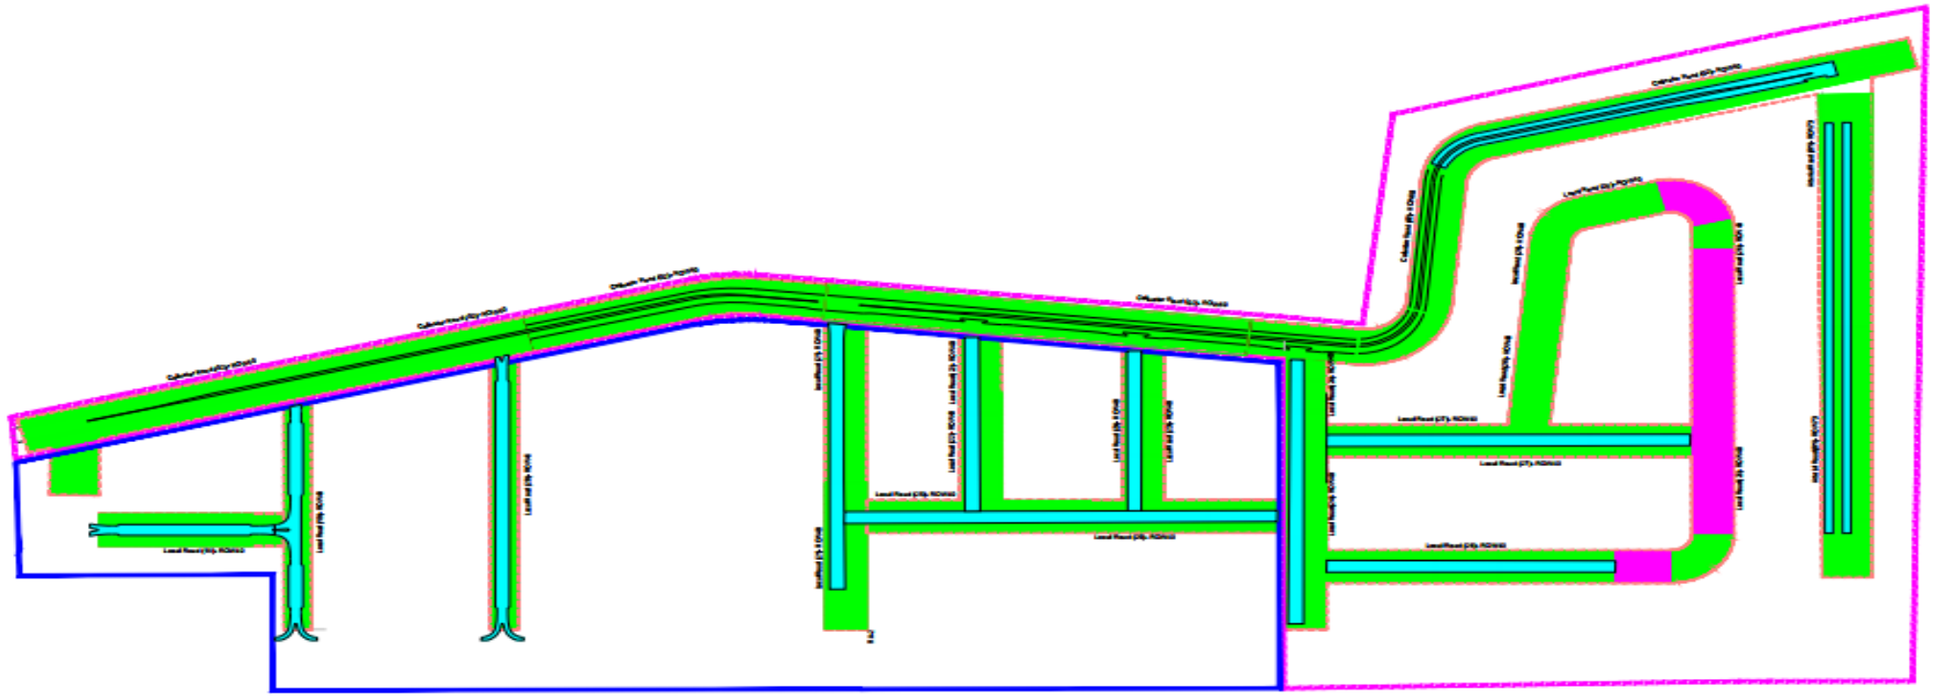

KEY PLAN



Legend

- Executed Fill
- Executed Cut
- Remaing Fill
- Bottom Subgrade

Work Area

- Eng.Bestawi
- Eng.Salem

0 10 20 30 40 60 100 METERS

SCALE (AT) 1:1000

REFERENCE DRAWINGS

REVISIONS TABLE

PURPOSE OF ISSUE: FOR APPROVAL

MODON

egis

MOFARREH GROUP

Weekly Progress


Layout-Zone B

SCALE 1:1000

Date

ROAD LAYOUT ZONE-A

ZONE A				
ITEM	Total Quantity (m3)	Excuted Quantity (m3)	Remaining Quantity (m3)	Percentage %
Subgrade	82330.47	45736.901	36593.571	55.55%
Aggregate BaseCourse	52379.08	25591.729	26787.349	48.86%
Asphalt Binder Course	19244.50	8874.722	10369.776	46.12%
Asphalt Wearing Course	12399.96	0.000	12399.958	0.00%

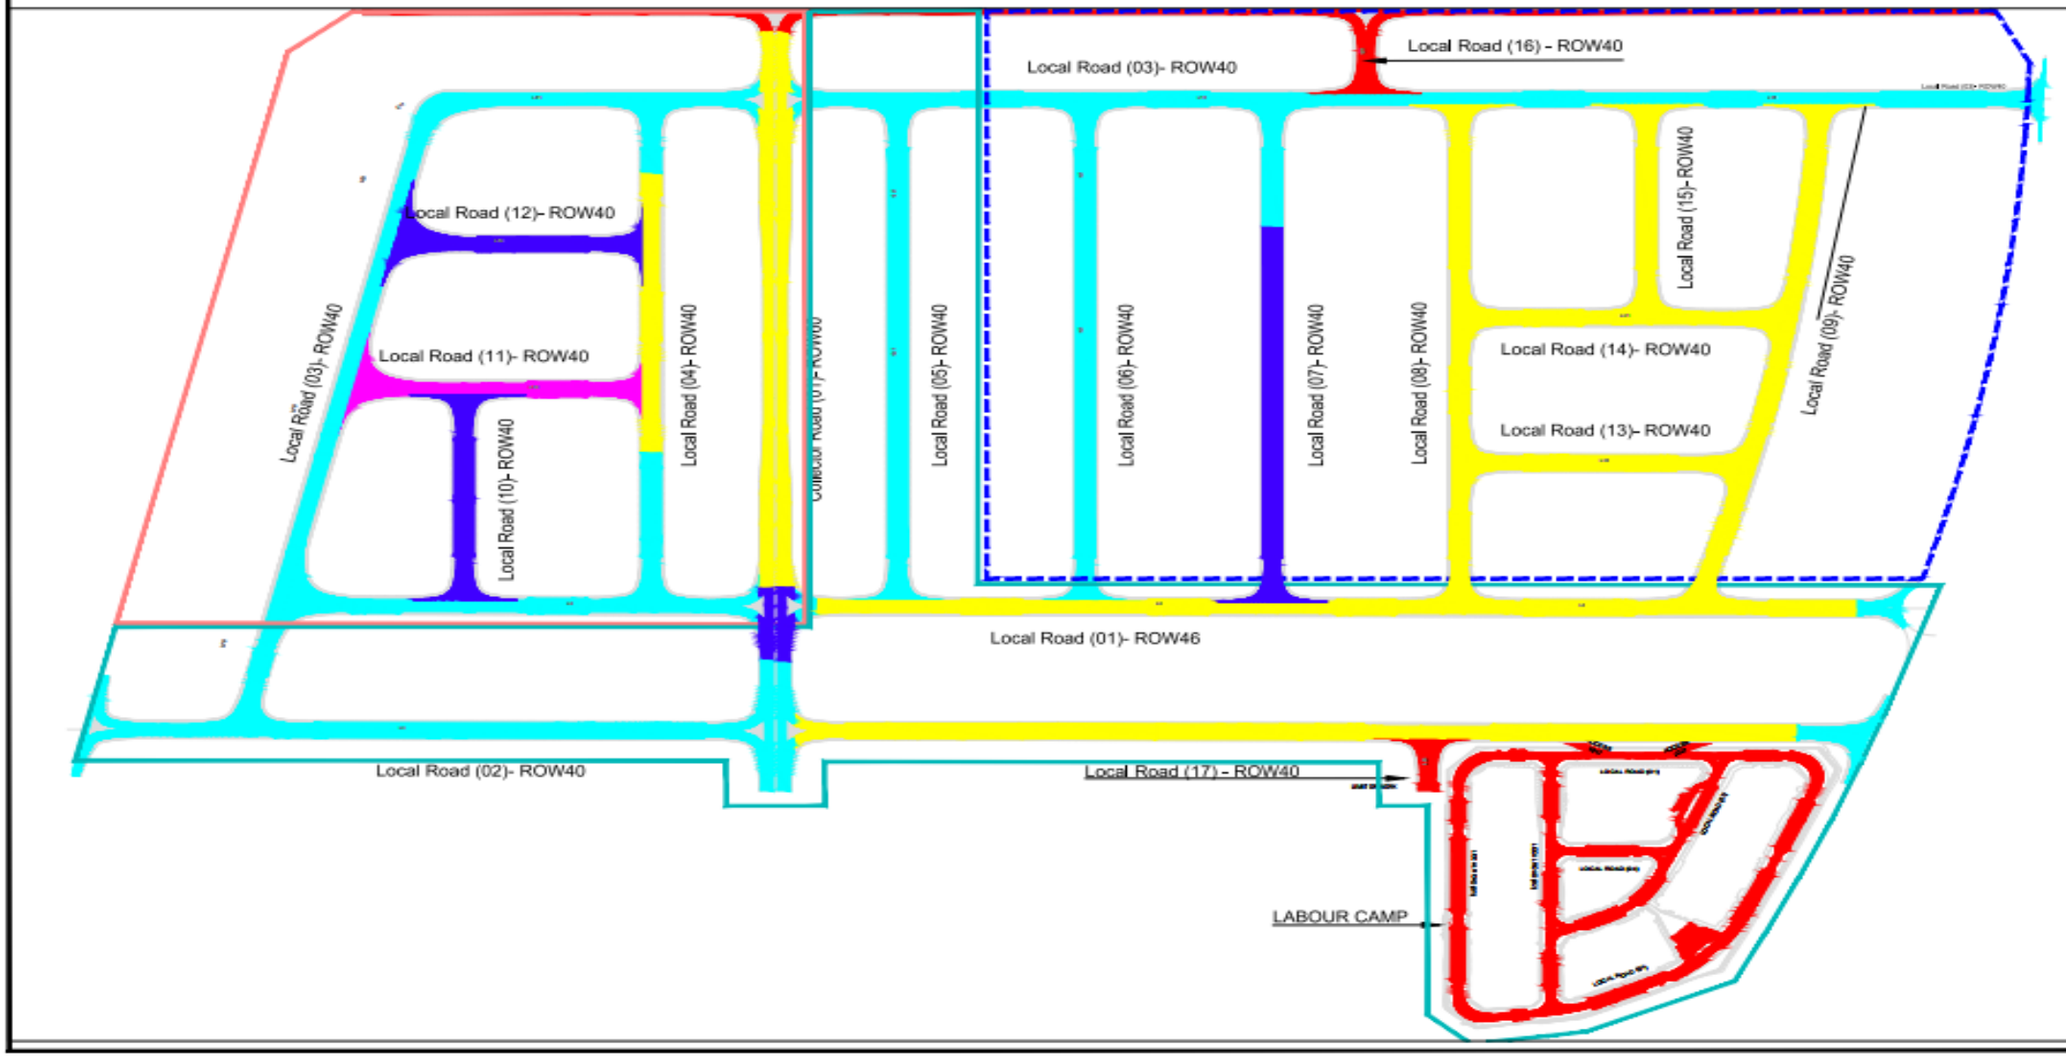



Legend

- Bottom Subgrade
- Subgrade
- Aggregate Base Course
- Asphalt Binder Course
- Asphalt Wearing Couse
- Remaining

Work Area

- Engr.Shamy
- Engr.Mohammed
- Engr.Nivin

0 10 20 30 40 50 100 METERS
SCALE (At) 1:1000

REFERENCE DRAWINGS

REVISIONS TABLE

PURPOSE OF ISSUE: FOR APPROVAL

MODON egis MOFARREH GROUP


Weekly Progress

ROAD PROGRESS LAYOUT-ZONE A

SCALE 1:1000 Date

ROAD LAYOUT ZONE-B

ROAD ACTIVATES PROGRESS ZONE B				
ITEM	Total Quantity	Excuted Quantity	Remaining Quantity	Percentage %
Subgrade(M3)	78595.25	60549.889	18045.358	77.04%
Aggregate BaseCourse(M3)	47537.25	21840.704	25696.548	45.94%
Asphalt Binder Course + MC(M3)	24947.75	11169.901	13777.847	44.77%
Asphalt Wearing Course + RC (M3)	11204.81	0.000	11204.809	0.00%

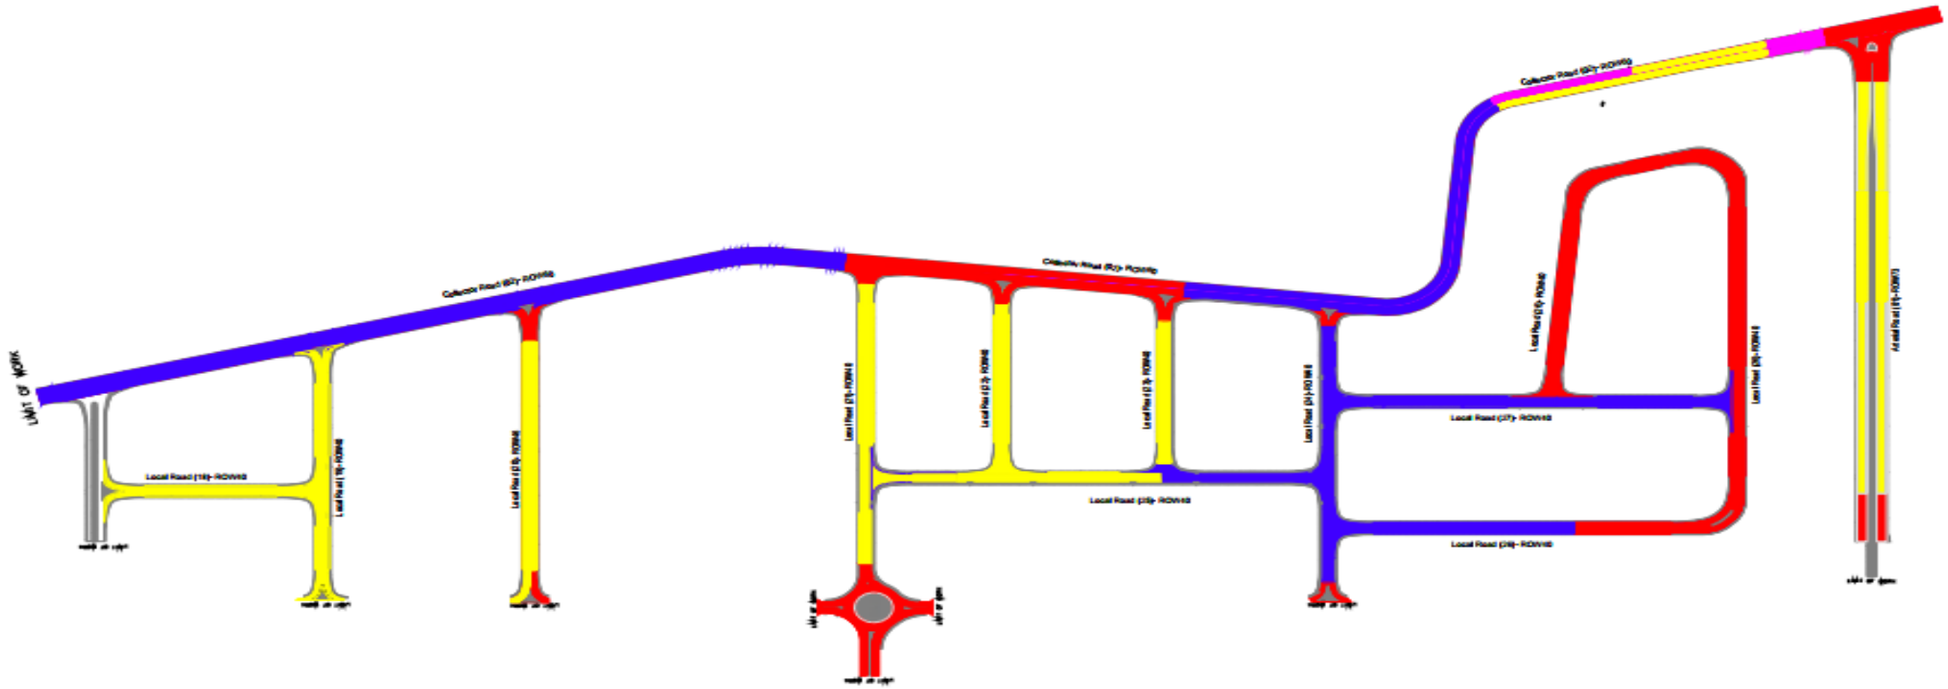

KEY PLAN



Legend

- Subgrade
- Aggregate Base Course
- Asphalt Binder Course
- Asphalt Wearing Course
- Work Remaining

Work Area

- Eng.Bestawi
- Eng.Salem

REFERENCE DRAWINGS

REVISIONS TABLE

PURPOSE OF ISSUE: FOR APPROVAL



Weekly Progress

LAYOUT - ZONE B

SCALE 1:3000

SEWER NETWORK PROGRESS LAYOUT ZONE-A

ZONE A (Sewer)				
ITEM	Total Quantity (LM)	Executed Quantity (LM)	Remaining Quantity (LM)	Percentage %
Excavation	14307.84	12104.742	2203.098	84.60%
Bedding	14307.84	10439.903	3867.938	72.97%
Installation	14307.84	10016.918	4290.922	70.01%
Backfilling	14307.84	6494.981	7812.859	45.39%

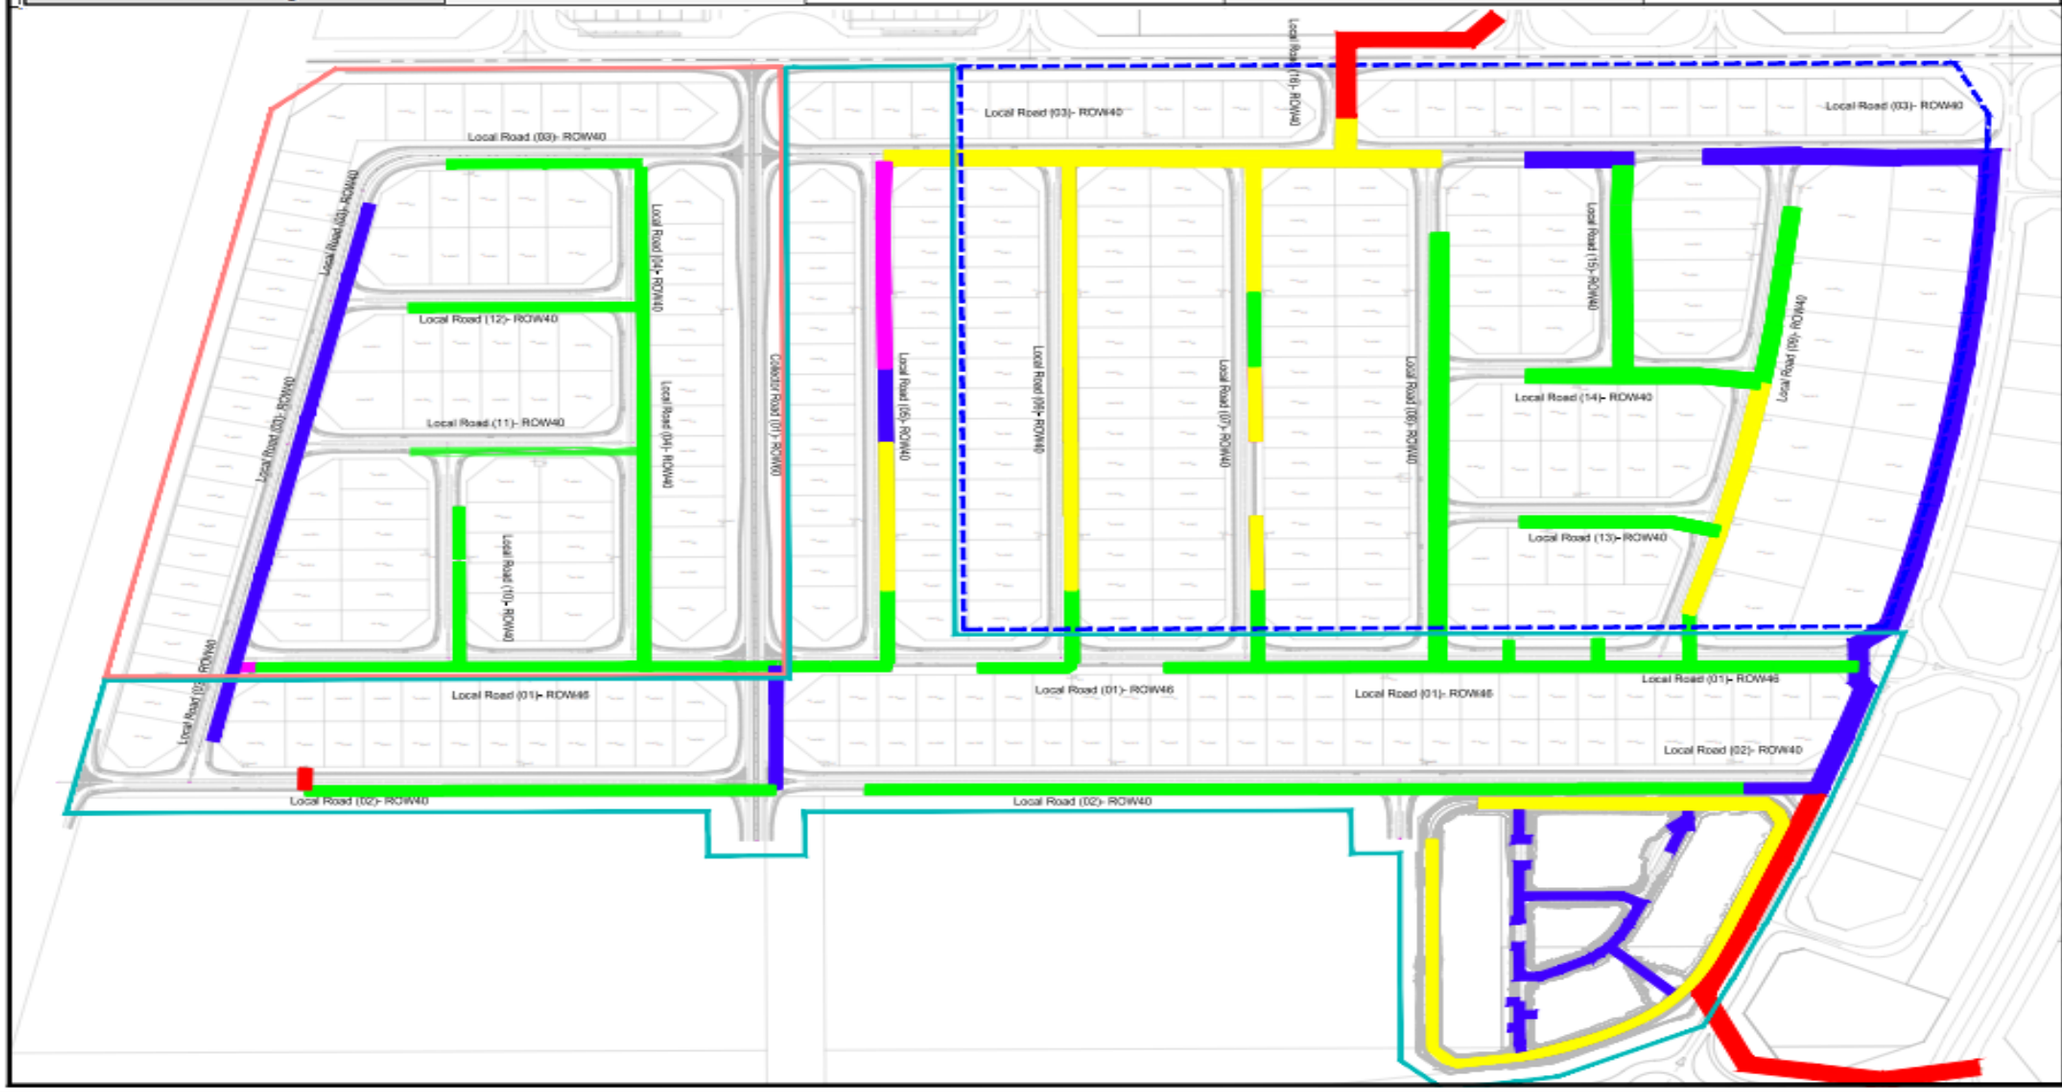

KEY PLAN



Legend

- Excavation
- Bedding
- Installation
- Backfilling
- Remaining

Work Area

- Engr.Shamy
- Engr.Mohammed
- Engr.Nivin

REFERENCE DRAWINGS

REVISIONS TABLE

PURPOSE OF ISSUE: FOR APPROVAL

MODON egis MOFARREH GROUP


SEWER NETWORK SYSTEM

SEWER NETWORK LAYOUT ZONE A

SCALE 1:1000

SEWER NETWORK PROGRESS LAYOUT ZONE-B

(SEWER) PIPE PROGRESS ZONE B				
ITEM	Total Quantity (LM)	Excuted Quantity (LM)	Remaining Quantity (LM)	Percentage %
Excavation	7539	5887.66	1651.34	78.10%
Bedding	7539	5887.66	S	78.10%
Installation	7539	5860.69	1678.31	77.74%
Backfilling	7398	4833.53	2564.47	65.34%

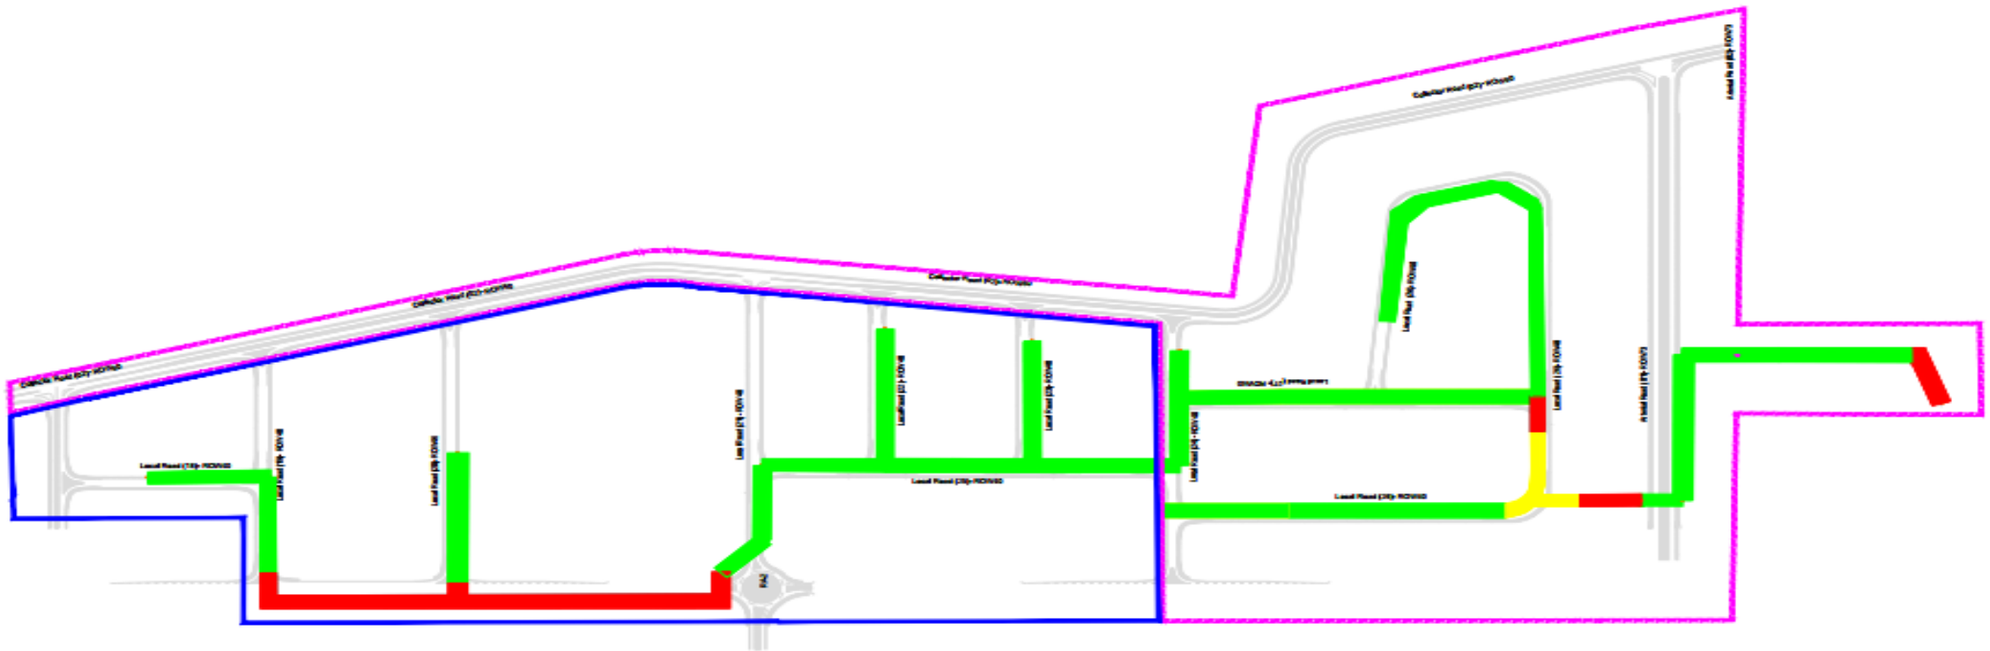

KEY PLAN



Legend

- Excavation
- Bedding
- Installation
- Backfilling
- Remaining

Work Area

- Eng.Bestawi
- Eng.Salem

REFERENCE DRAWINGS

REVISIONS TABLE

PURPOSE OF ISSUE: FOR APPROVAL


MODON

egis

MOFARREH GROUP

SEWER MANHOLE PROGRESS LAYOUT ZONE-A

ZONE A (Sewer Manhole)				
ITEM	Total Quantity (EA)	Executed Quantity (EA)	Remaining Quantity (EA)	Percentage %
Excavation	286	172	114	60.14%
Blinding	286	143	143	50.00%
Installation	286	133	153	46.54%
Backfilling	286	80	206	27.97%

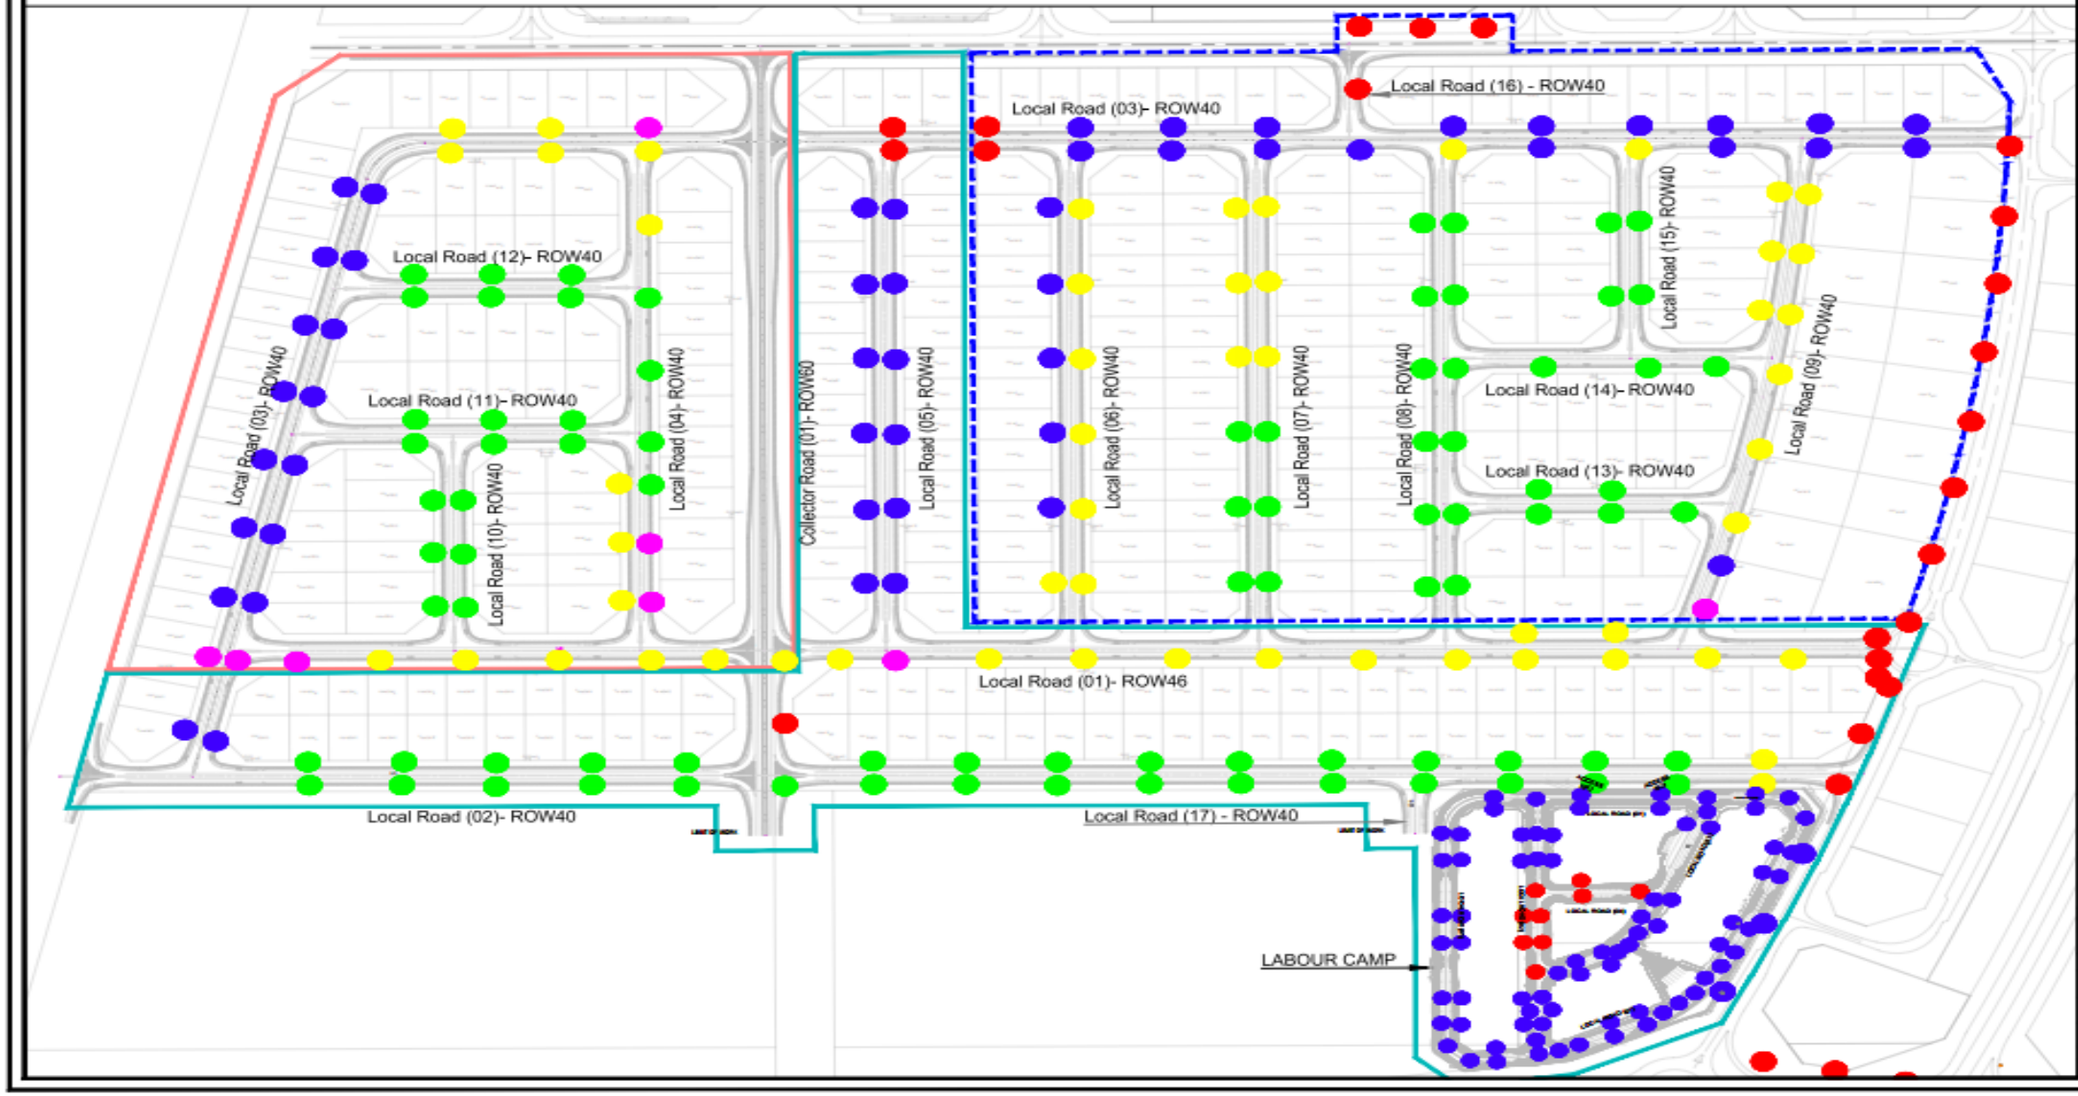

KEY PLAN



Legend

- Excavation
- Blinding
- Installation
- Backfilling
- Remaining

Work Area

- Engr.Shamy
- Engr.Mohammed
- Engr.Nivin

REFERENCE DRAWINGS

REVISIONS TABLE

PURPOSE OF ISSUE: FOR APPROVAL

MODON

egis


MOFARREH GROUP

SCALE

DATE

SEWER MANHOLE PROGRESS LAYOUT ZONE-B

ZONE B (Sewer Manhole) Progress				
ITEM	Total Quantity (EA)	Executed Quantity (EA)	Remaining Quantity (EA)	Percentage %
Excavation	107	92	15	85.98%
Blinding	107	82	25	76.64%
Installation	107	82	25	76.92%
Backfilling	107	19	88	17.76%

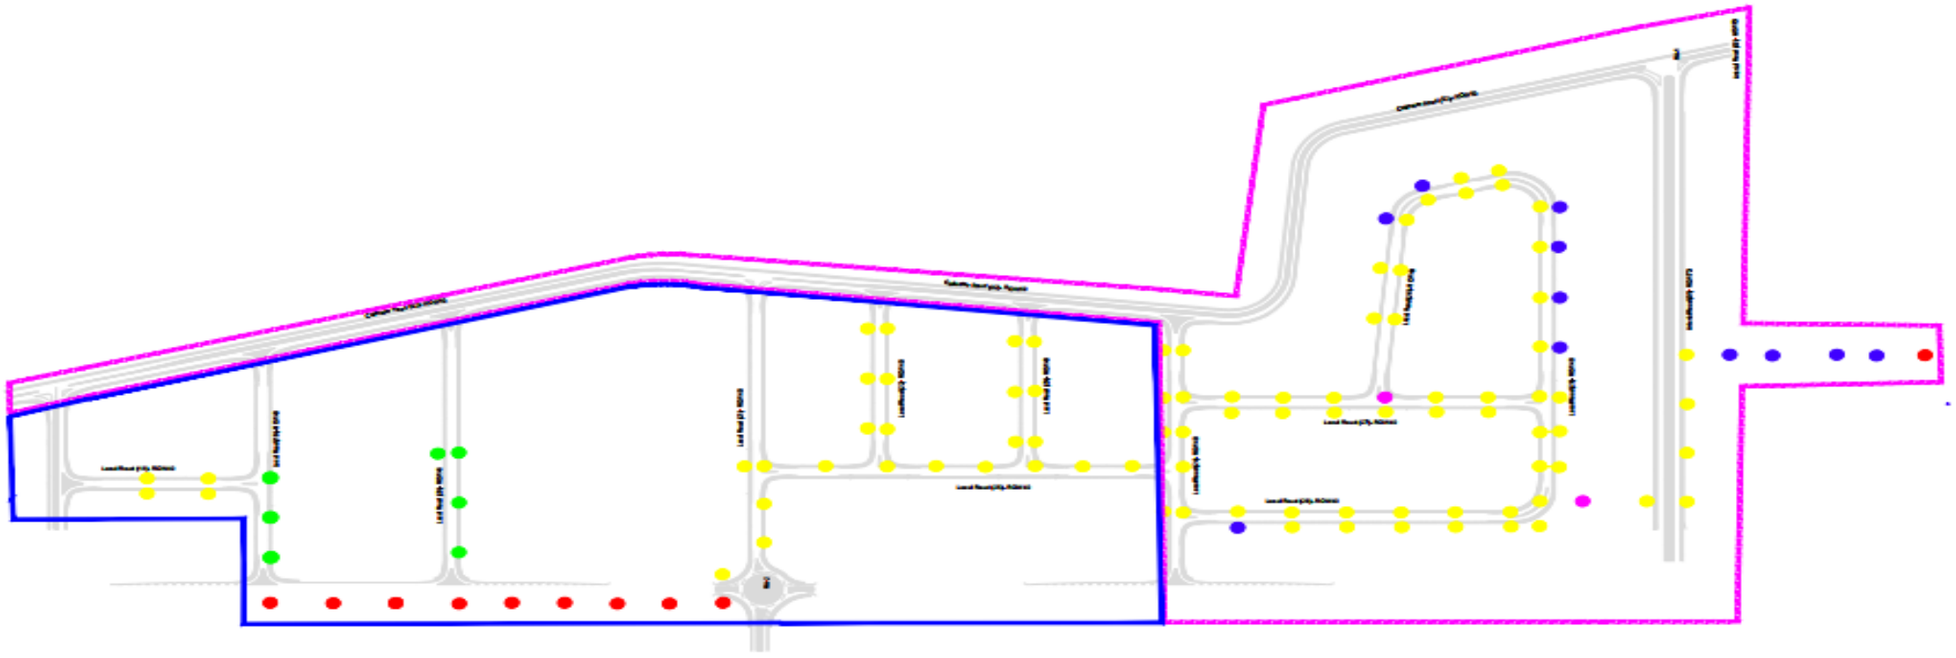

KEY PLAN



Legend

- Excavation
- Blinding
- Installation
- Backfilling
- Remaining

Work Area

- Eng.Bestawi
- Eng.Salem

REFERENCE DRAWINGS

REVISIONS TABLE

PURPOSE OF ISSUE: FOR APPROVAL


SEWER NETWORK PROCUREMENT PROGRESS LAYOUT (ZONE-A,B & LABOUR CAMP)

Sewer Network materials status

SR	MATERIAL	UNIT	TOTAL QTY	DELIVERED	% DELIVERED	REMAINING QTY	% REMIAINING
1	GRP PIPE DIA 150 mm	L.M	4,111.00	4,059.00	98.74%	52	1.26%
2	GRP PIPE DIA 200 mm	L.M	12,824.00	11,787.00	91.91%	1037	8.09%
3	GRP PIPE DIA 250 mm	L.M	2,310.00	2,310.00	100.00%	0	0.00%
4	GRP PIPE DIA 300 mm	L.M	2,700.00	2,700.00	100.00%	0	0.00%
5	GRP PIPE DIA 400 mm	L.M	2,086.00	1,300.00	62.32%	786	37.68%
6	GRP PIPE DIA 500 mm	L.M	1,164.00	1,164.00	100.00%	0	0.00%
7	GRP PIPE DIA 600 mm	L.M	1,792.00	1,692.00	94.42%	100	5.58%
8	Sewege Manhole	EA	393.00	390.00	99.24%	3	0.76%
9	Warning tape	Roll	926.00	450.00	48.60%	476	51.40%

STORM NETWORK PROGRESS LAYOUT ZONE-A

ZONE A (Storm)				
ITEM	Total Quantity (LM)	Excuted Quantity (LM)	Remaining Quantity (LM)	Percentage %
Excavation	14482	11320.798	3161.202	78.17%
Bedding	14482	10852.133	3629.867	74.94%
Installation	14482	10186.935	4295.065	70.34%
Backfilling	14482	6678	7804	46.11%

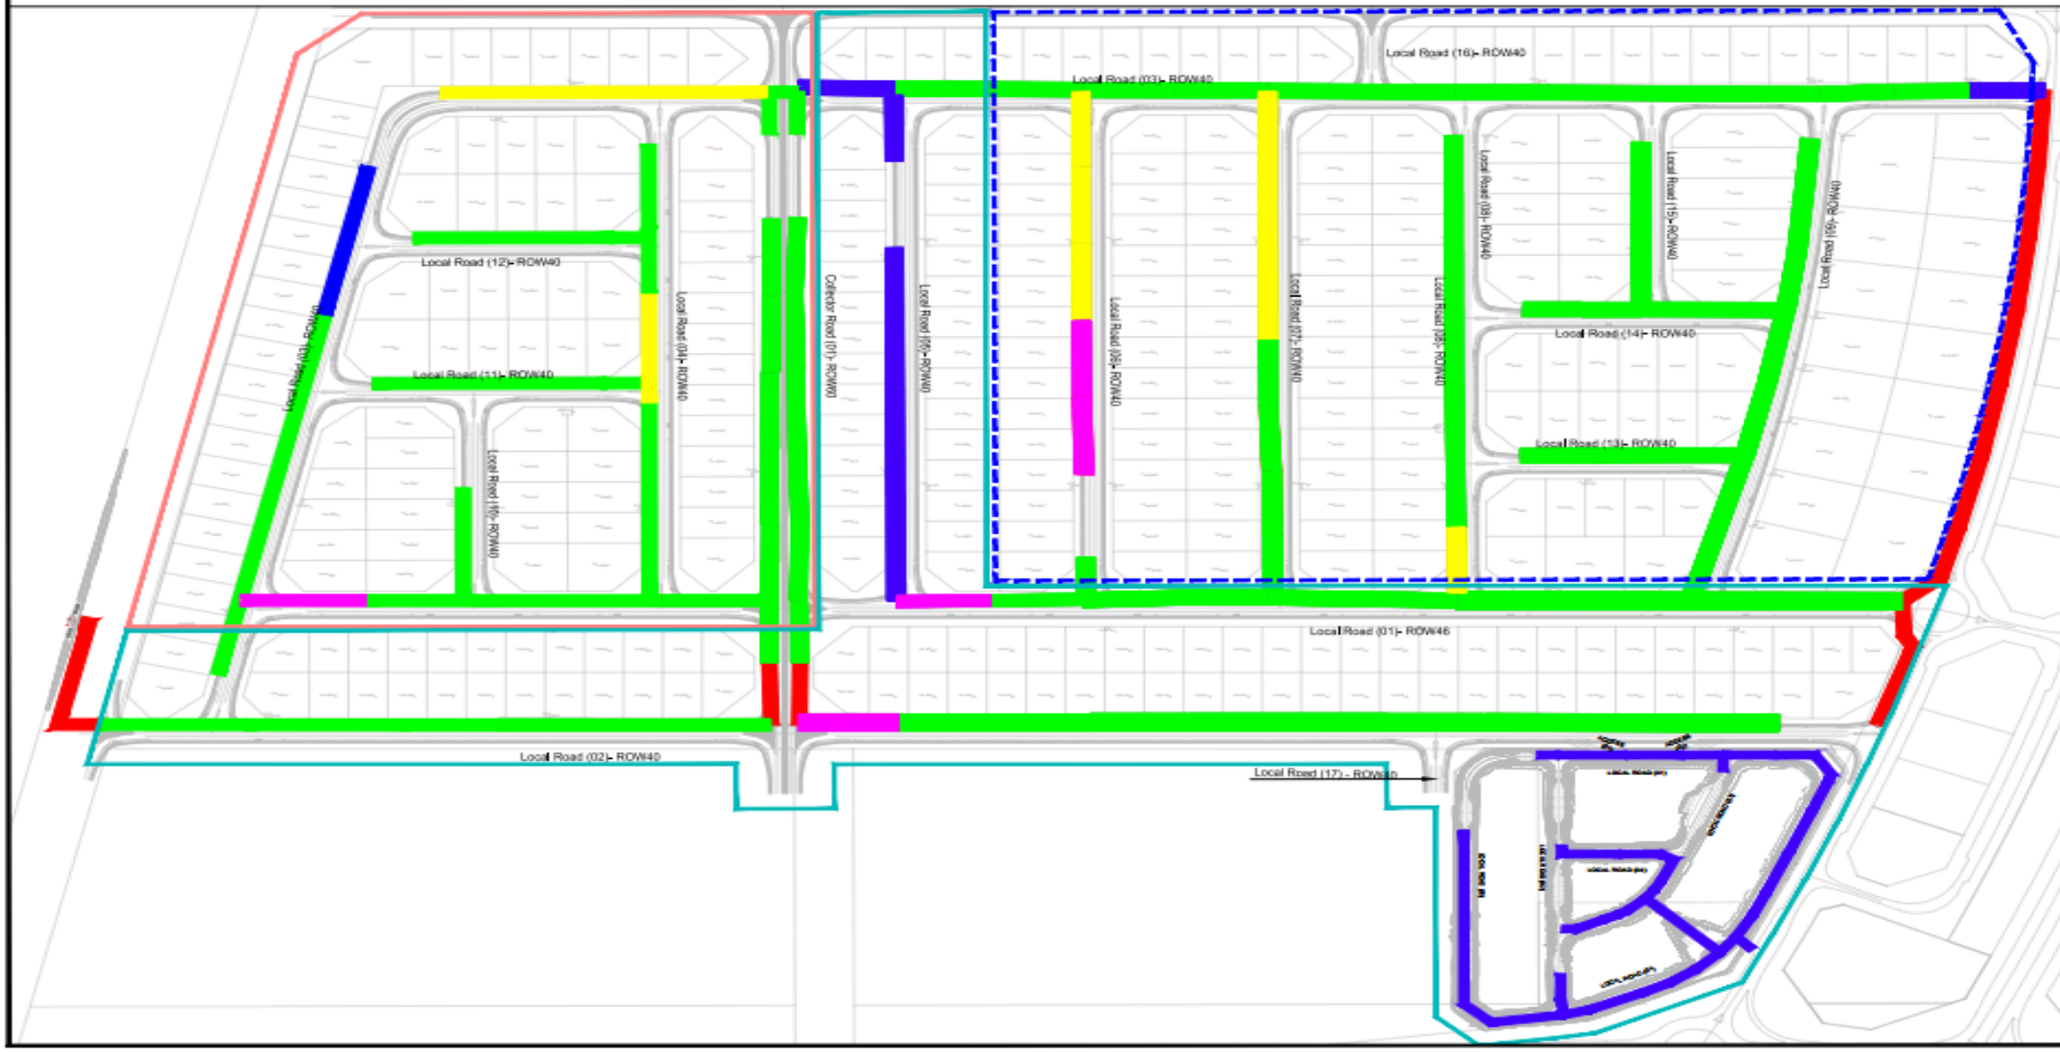



Legend

- Excavation
- Bedding
- Installation
- Backfilling
- Remaining

Work Area

- Engr.Shamy
- Engr.Mohammed
- Engr.Nivin

REFERENCE DRAWINGS

REVISIONS TABLE

PURPOSE OF ISSUE: FOR APPROVAL

MODON egis MOFARREH GROUP


STORM DRAINAGE SYSTEM

STORM DRAINAGE LAYOUT PLAN ZONE A

SCALE 1:1000 SHEET

STORM NETWORK PROGRESS LAYOUT ZONE-B

(STORM) PIPE PROGRESS ZONE B				
ITEM	Total Quantity (LM)	Excuted Quantity (LM)	Remaining Quantity (LM)	Percentage %
Excavation	8544.19	7558.205	985.985	88.46%
Bedding	8544.19	6839.157	1705.033	80.04%
Installation	8544.19	5981.218	2562.972	70.00%
Backfilling	8544.19	3813.072	4731.118	44.63%

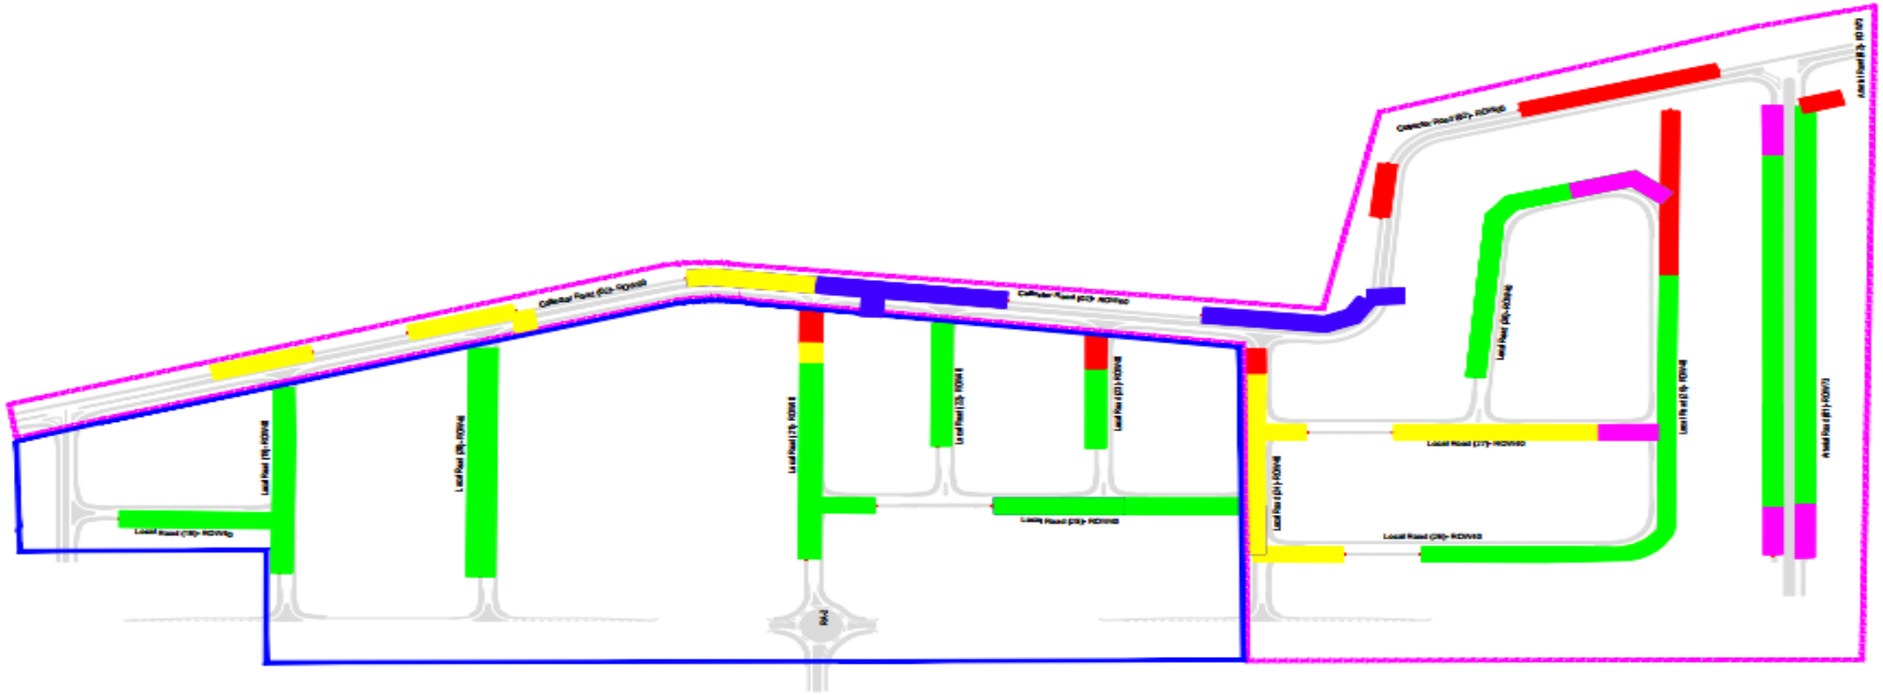

KEY PLAN



Legend

- Excavation
- Bedding
- Installation
- Backfilling

Work Area

- Eng.Bestawi
- Eng.Salem

REFERENCE DRAWINGS

REVISIONS TABLE

PURPOSE OF ISSUE: FOR APPROVAL

MODON

egis

MOFARREH GROUP

STORM DRAINAGE SYSTEM


STORM DRAINAGE LAYOUT PLAN ZONE B

SCALE

SHEET

STORM MANHOLE PROGRESS LAYOUT ZONE-A

ZONE A + Labor Camp (Storm Manhole)				
ITEM	Total Quantity (EA)	Executed Quantity (EA)	Remaining Quantity (EA)	Percentage %
Excavation	194	130	64	67.01%
Blinding	194	113	81	58.25%
Installation	194	107	87	55.10%
Backfilling	194	59	135	30.41%

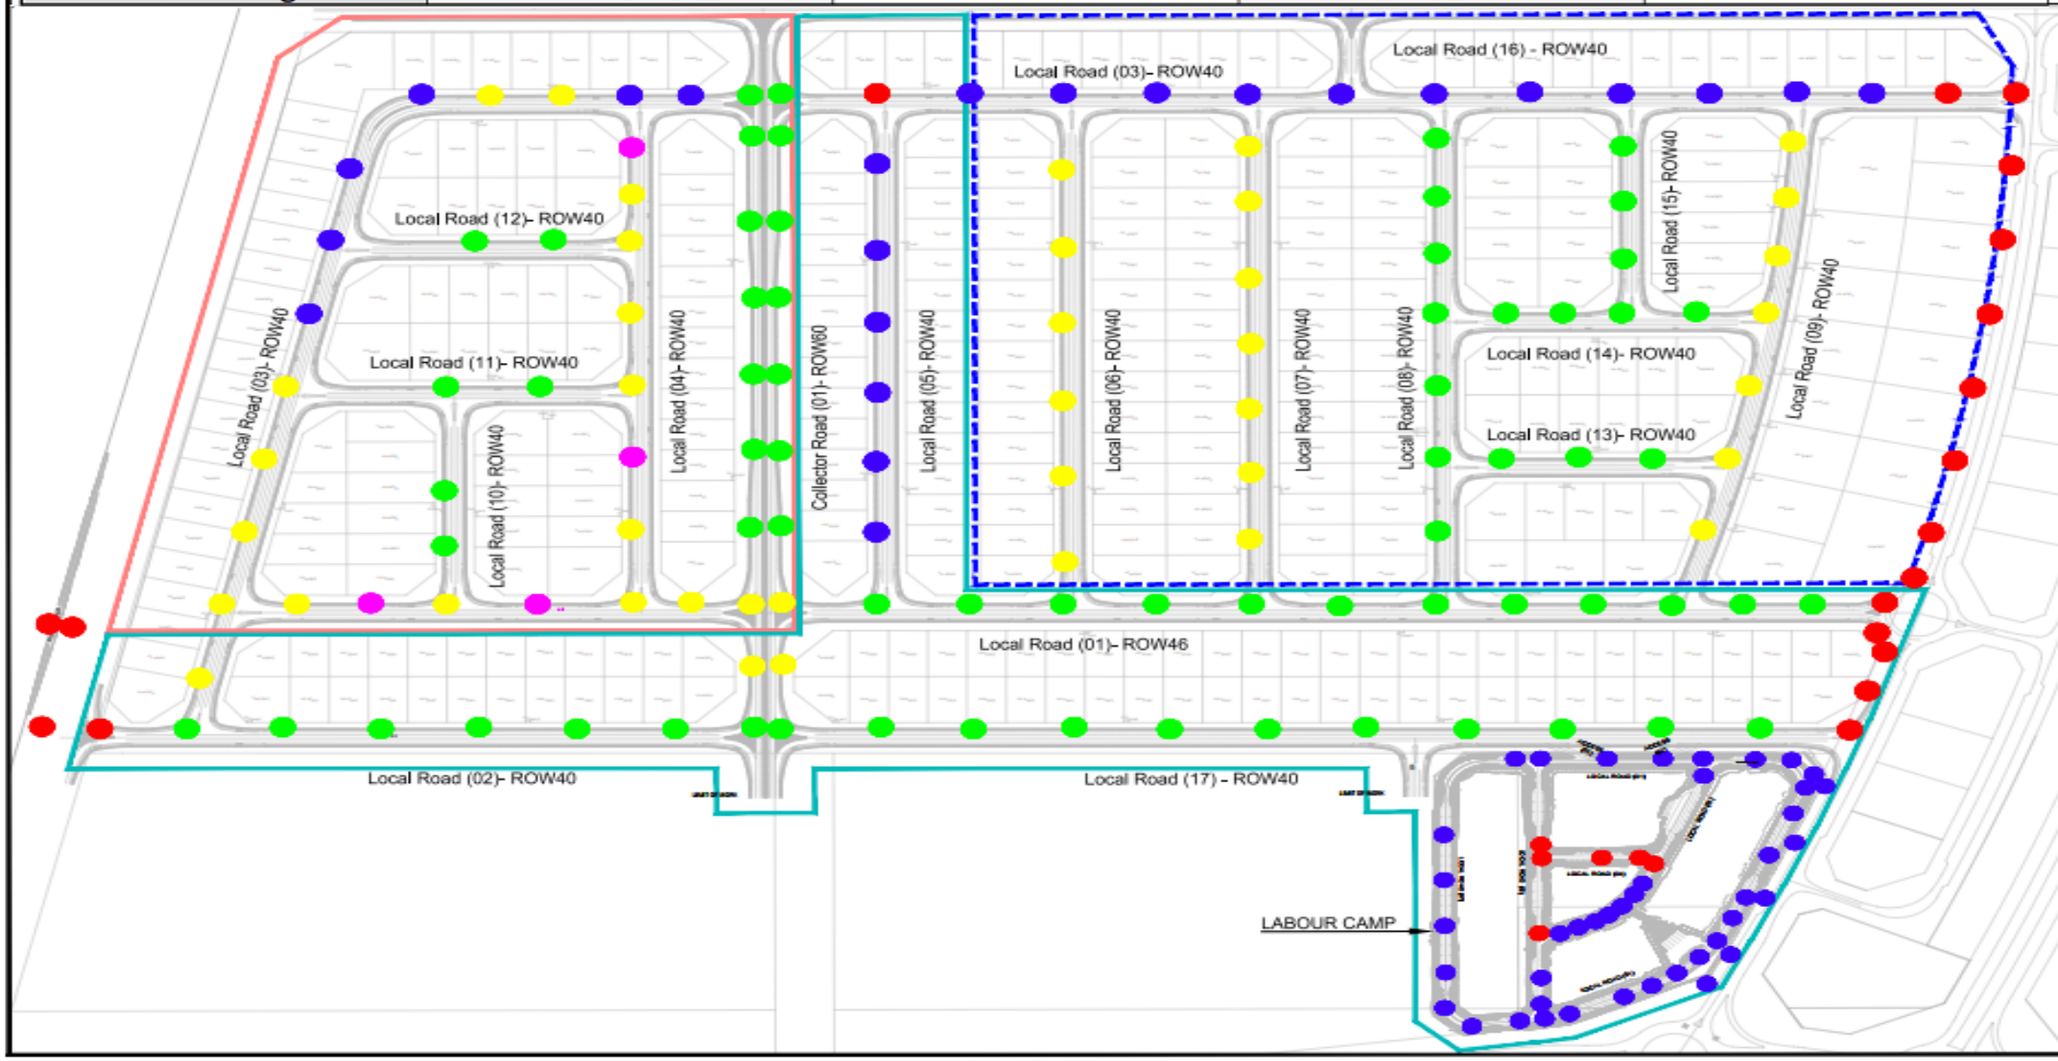

KEY PLAN



Legend

- Excavation
- Blinding
- Installation
- Backfilling
- Remaining

Work Area

- Engr.Shamy
- Engr.Mohammed
- Engr.Nivin

REFERENCE DRAWINGS

REVISIONS TABLE

PURPOSE OF ISSUE: FOR APPROVAL

MODON

egis

MOFARREH GROUP

STORM DRAINAGE SYSTEM

STORM MANHOLE PROGRESS LAYOUT ZONE A


SCALE 1:1000

SHEET

DATE

STORM MANHOLE PROGRESS LAYOUT ZONE-B

ZONE B (Storm Manhole) Progress				
ITEM	Total Quantity (EA)	Executed Quantity (EA)	Remaining Quantity (EA)	Percentage %
Excavation	104	94	10	90.38%
Blinding	104	87	17	83.65%
Installation	104	85	19	81.35%
Backfilling	104	25	79	24.04%

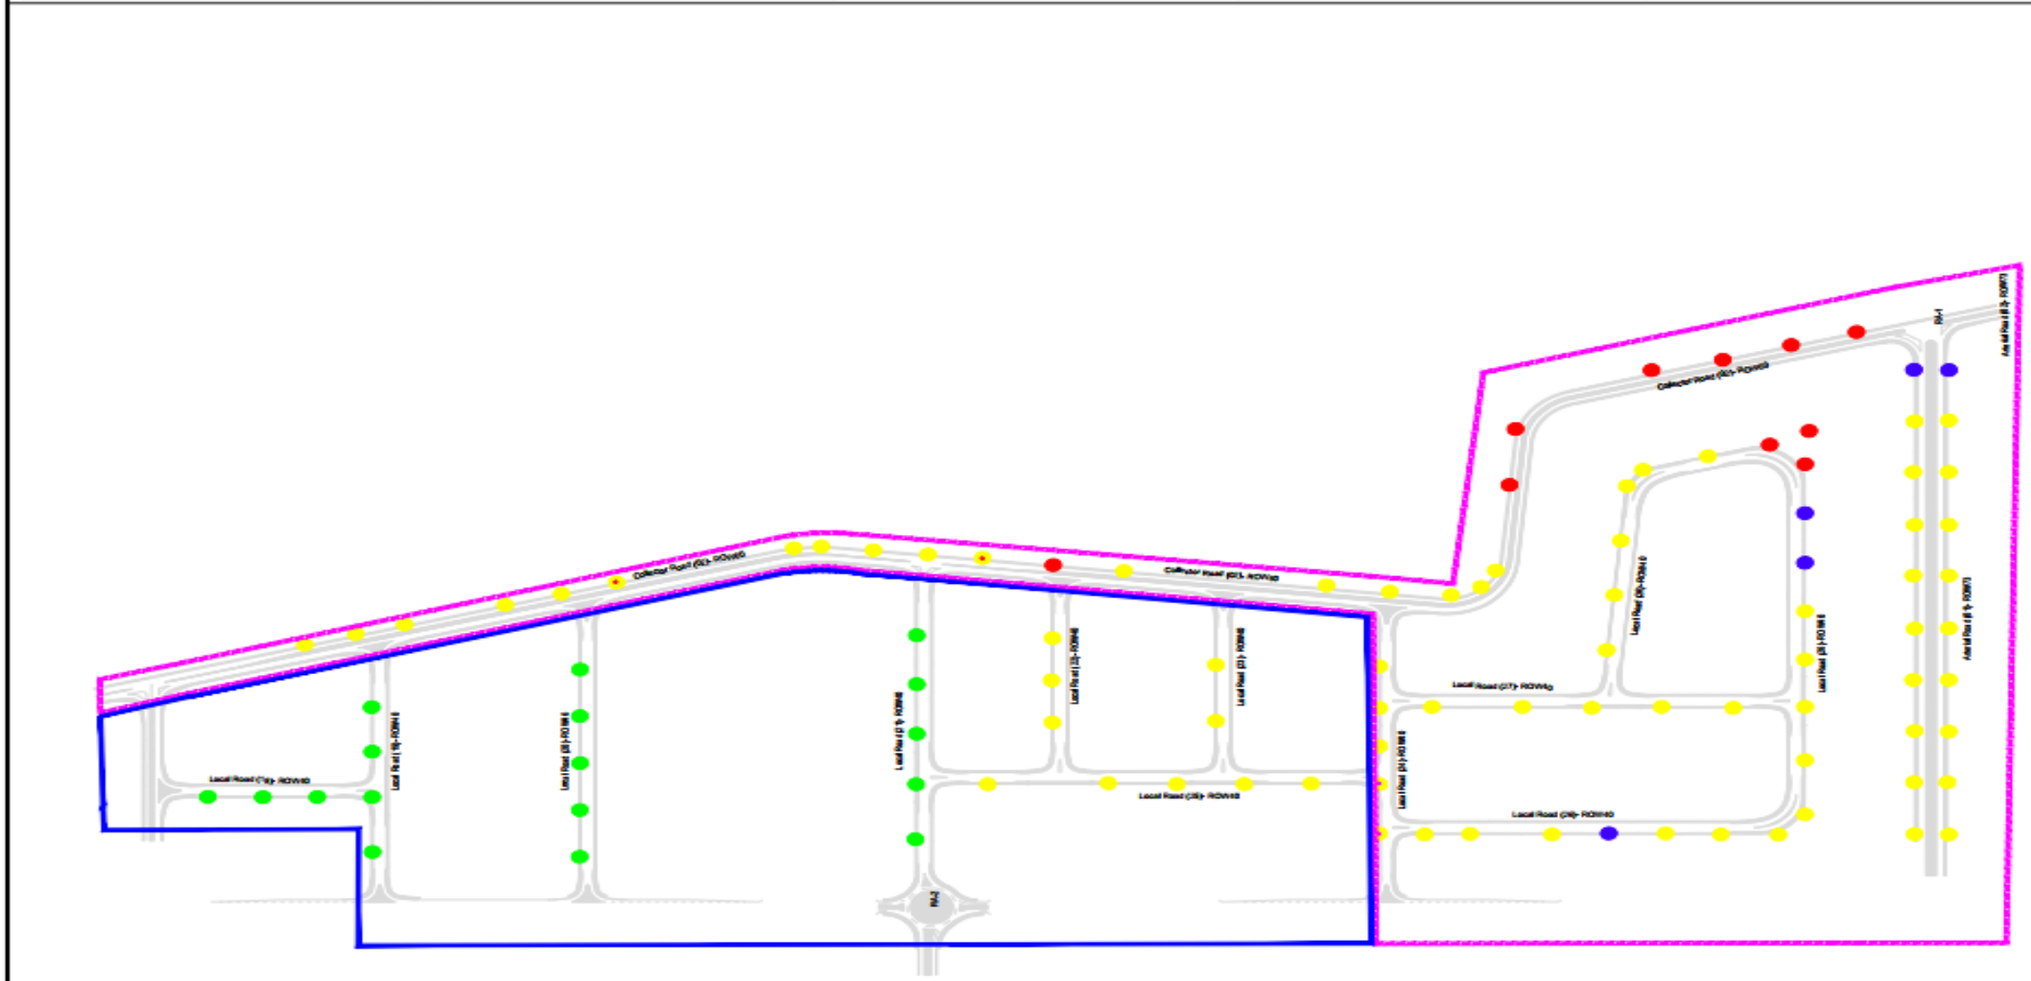

KEY PLAN



Legend

Excavation

Blinding

Installation

Backfilling

Remaining

Work Area

Eng.Bestawi

Eng.Salem

REFERENCE DRAWINGS

REVISIONS TABLE

PURPOSE OF ISSUE: FOR APPROVAL

MODON

egis

MOFARREH GROUP

STORM DRAINAGE SYSTEM

STORM DRAINAGE LAYOUT PLAN ZONE B

SCALE 1:1000


SHEET of 0052

STORM SECONDARY NETWORK PROGRESS LAYOUT ZONE-A

ZONE A (Storm Secondary)				
ITEM	Total Quantity (LM)	Excuted Quantity (LM)	Remaining Quantity (LM)	Percentage %
Excavation	7206.5	4344.895	2861.605	60.29%
Bedding	7206.5	4021.788	3184.712	55.81%
Installation	7206.5	3882.378	3324.122	53.87%
Backfilling	7206.5	2682.911	4523.589	37.23%



KEY PLAN

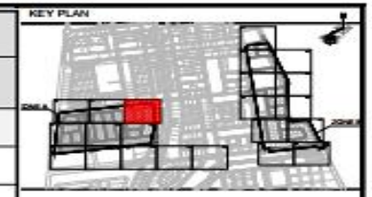

Legend

- Excavation
- Bedding
- Installation
- Backfilling
- Remaining

Work Area

- Engr.Shamy
- Engr.Mohammed
- Engr.Nivin

REFERENCE DRAWINGS

REVISIONS TABLE

PURPOSE OF ISSUE: FOR APPROVAL


STORM SECONDARY NETWORK ZONE -A

SCALE 1:1000


SHEET

SECONDARY STORM NETWORK PROGRESS LAYOUT ZONE-B

STORM SECONDARY CATCH BASIN PROGRESS (ZONE B)				
ITEM	Total Quantity (EA)	Executed Quantity (EA)	Remaining Quantity (EA)	Percentage %
Excavation	257	153	104	59.53%
Blinding	257	151	106	58.75%
Installation	257	172	85	66.77%
Backfilling	257	58	199	22.57%

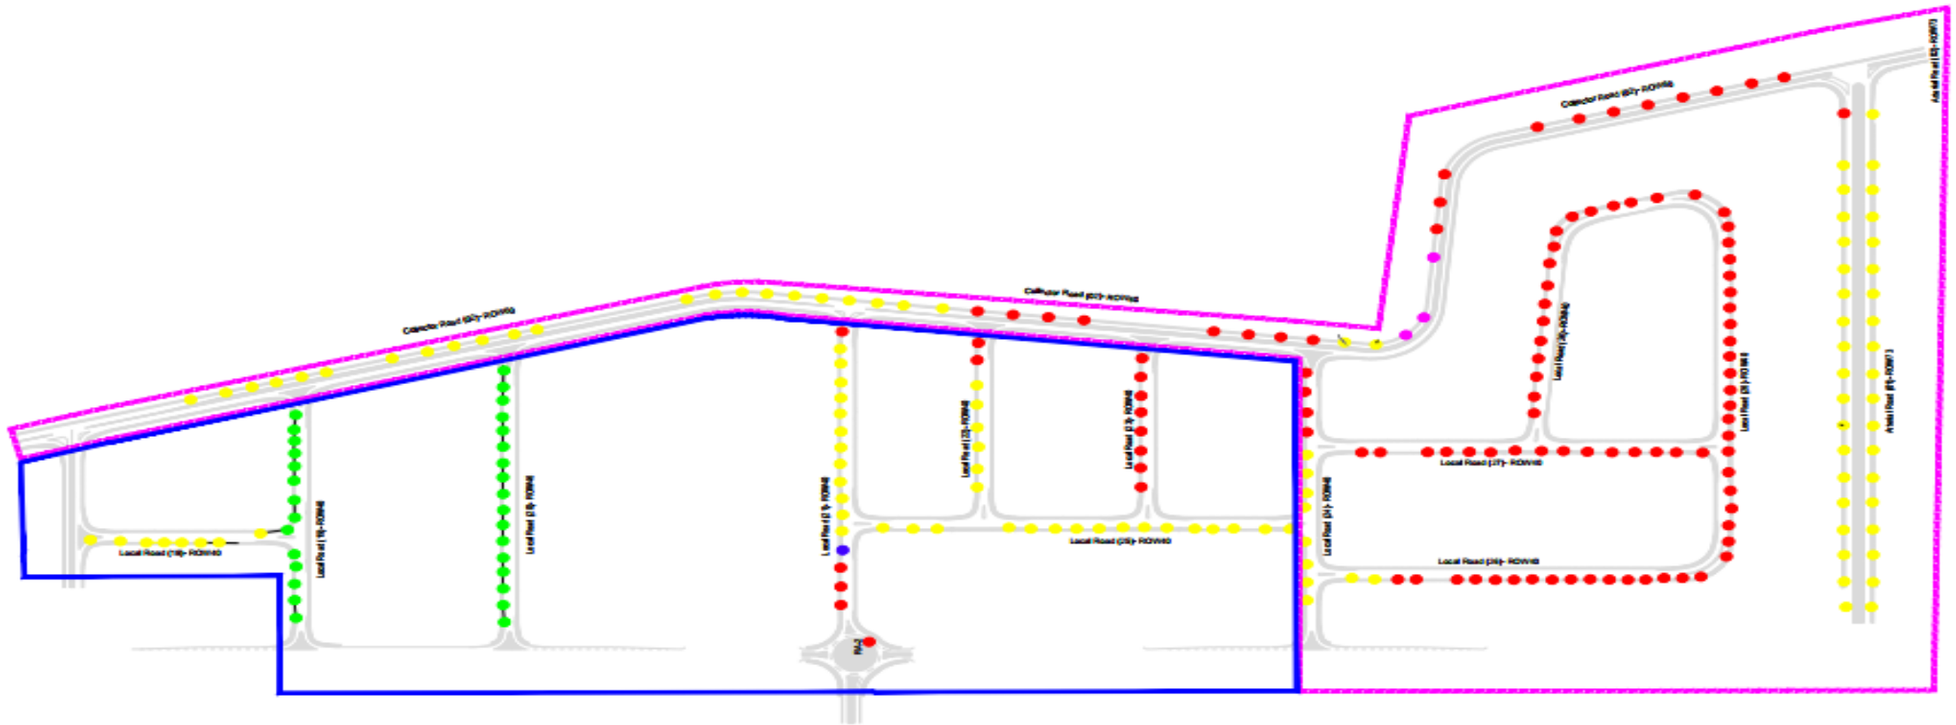

KEY PLAN

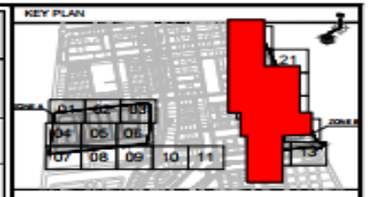

Legend

- Excavation
- Blinding
- Installation
- Backfilling
- Remaining

Work Area

- Eng.Bestawi
- Eng.Salem

REFERENCE DRAWINGS

REVISIONS TABLE

PURPOSE OF ISSUE: FOR APPROVAL

STORM DRAINAGE SYSTEM


STORM DRAINAGE SECONDARY LAYOUT PLAN ZONE B

SCALE

SHEET

SECONDARY STORM CATCH BASIN PROGRESS LAYOUT ZONE-A

ZONE A (Catch Basin)				
ITEM	Total Quantity (EA)	Executed Quantity (EA)	Remaining Quantity (EA)	Percentage %
Excavation	416	209	207	50.24%
Blinding	416	193	223	46.39%
Installation	416	192	224	46.25%
Backfilling	416	106	310	25.48%

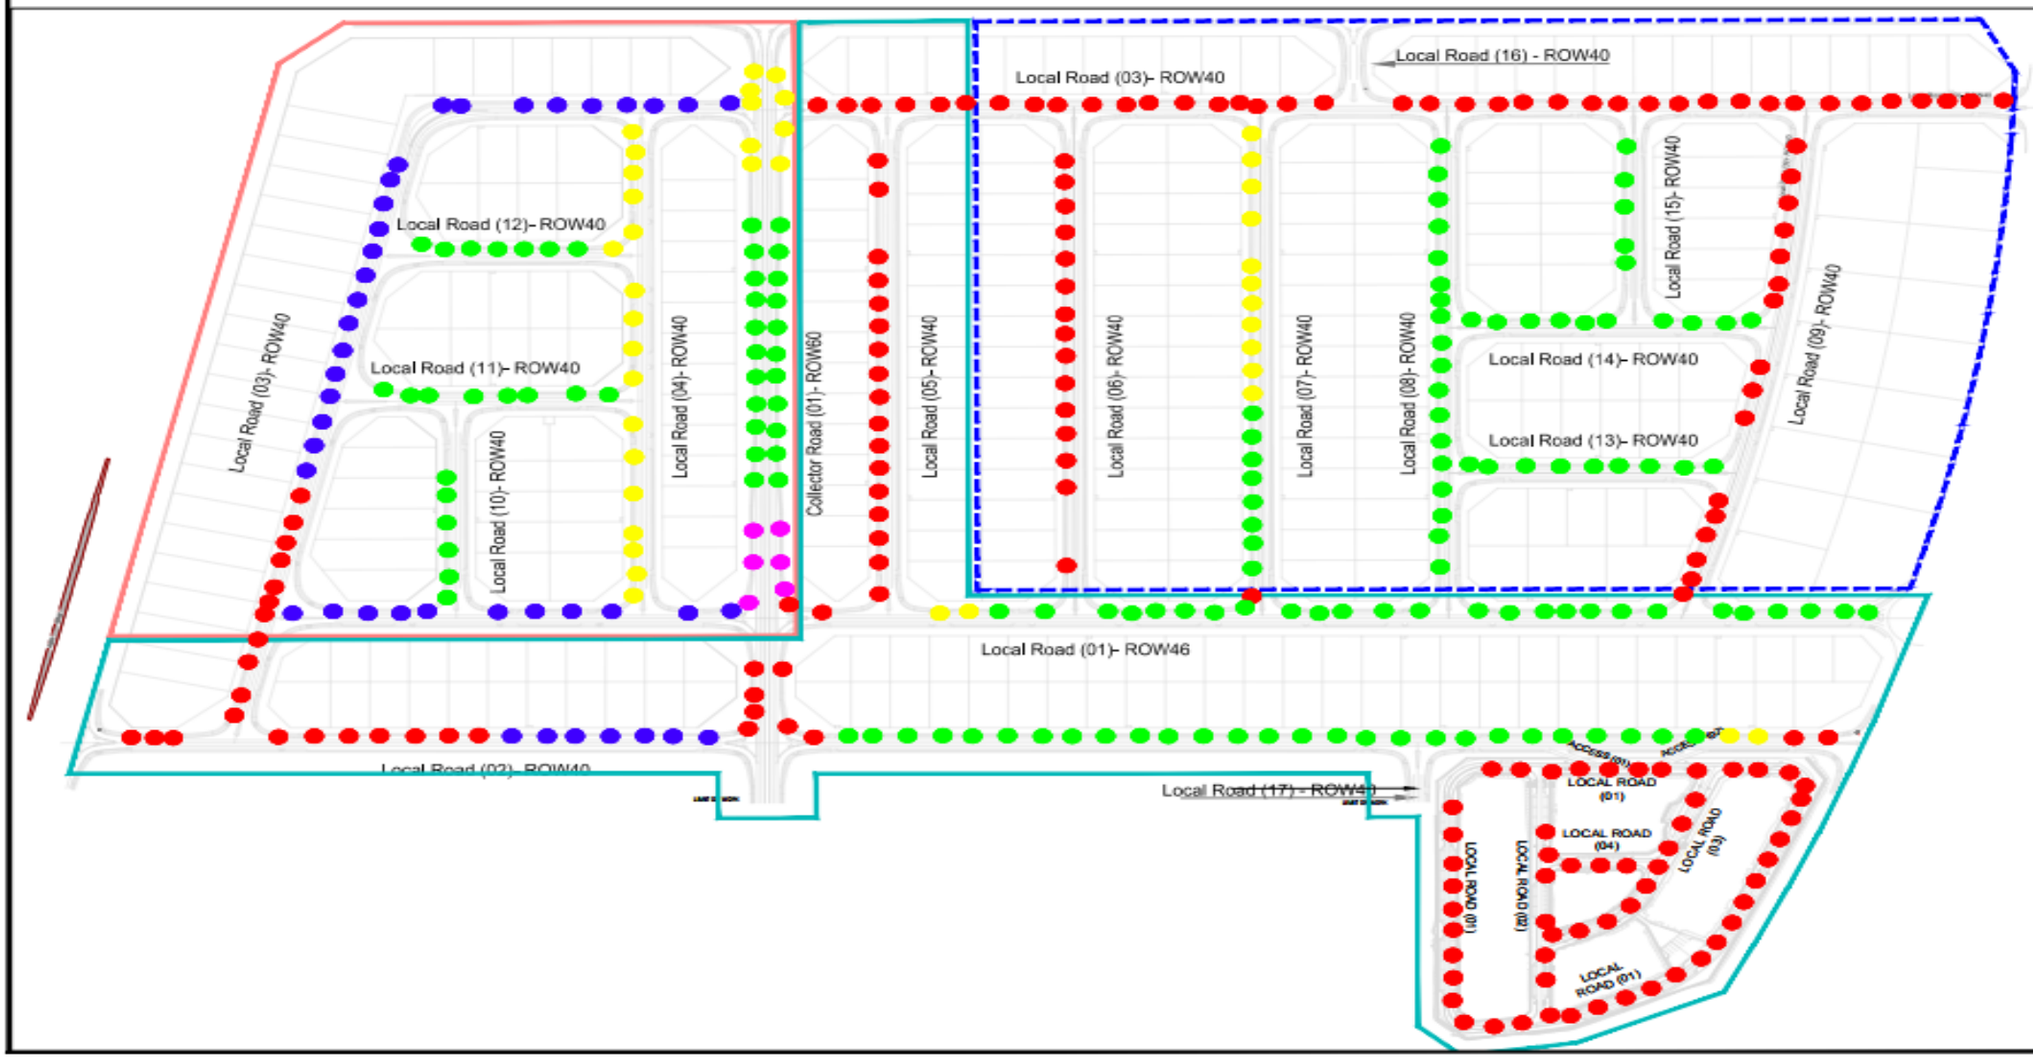



Legend

- Excavation
- Blinding
- Installation
- Backfilling
- Remaining

Work Area

- Engr.Shamy
- Engr.Mohammed
- Engr.Nivin

REFERENCE DRAWINGS

REVISIONS TABLE

PURPOSE OF ISSUE: FOR APPROVAL


CATCH BASIN LAYOUT ZONE-A

SCALE 1:1000

SHEET

SECONDARY STORM CATCH BASIN PROGRESS LAYOUT ZONE-B

STORM SECONDARY CATCH BASIN PROGRESS (ZONE B)				
ITEM	Total Quantity (EA)	Executed Quantity (EA)	Remaining Quantity (EA)	Percentage %
Excavation	257	153	104	59.53%
Blinding	257	151	106	58.75%
Installation	257	172	85	66.77%
Backfilling	257	58	199	22.57%

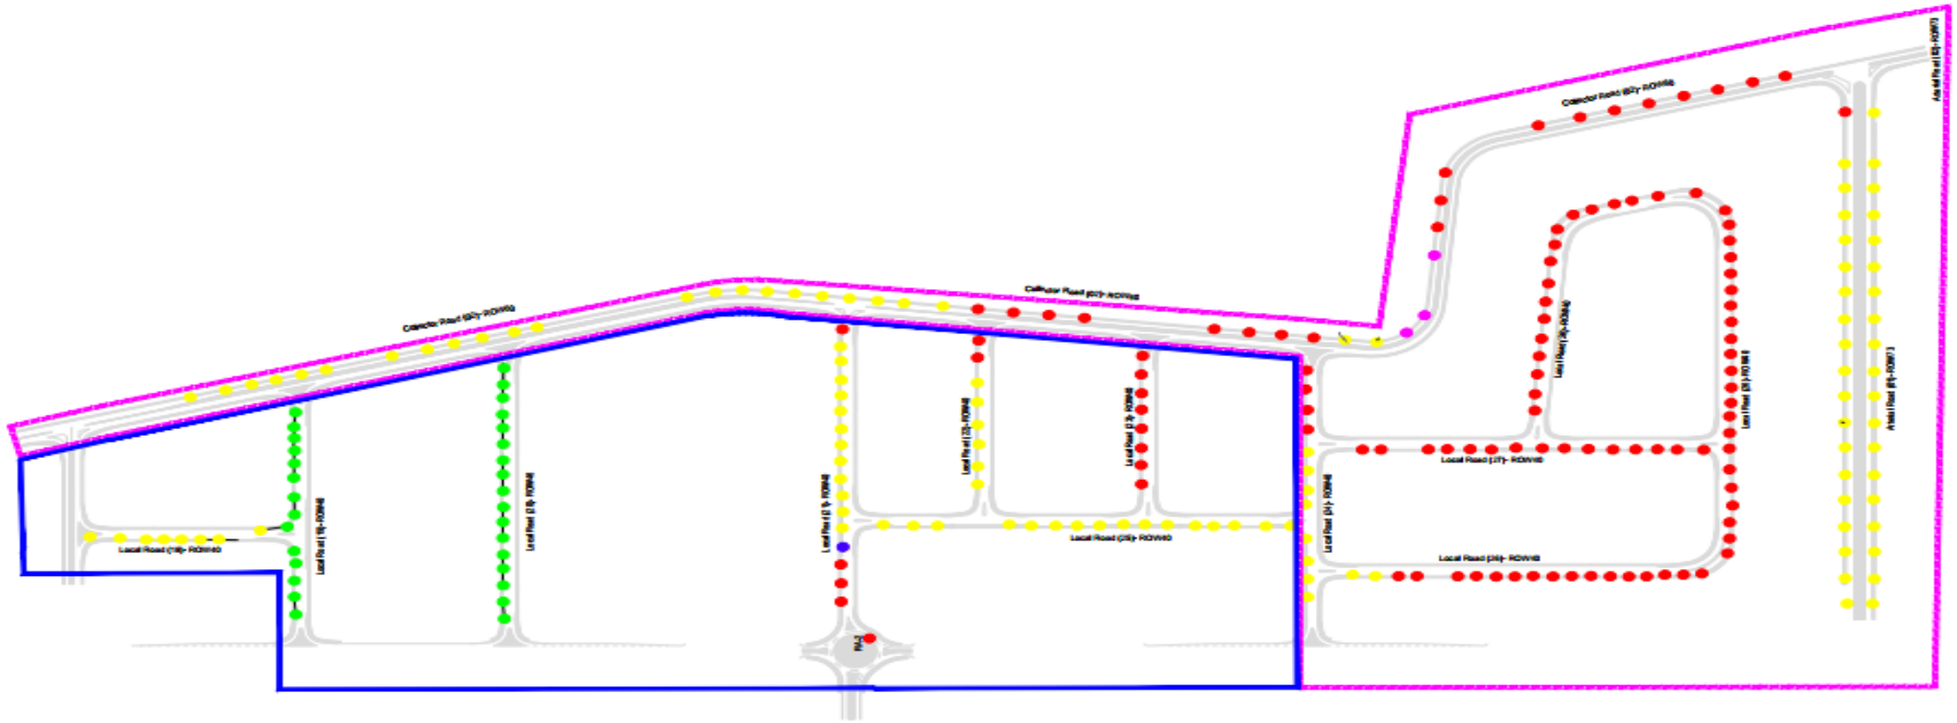

KEY PLAN



Legend

- Excavation
- Blinding
- Installation
- Backfilling
- Remaining

Work Area

- Eng.Bestawi
- Eng.Salem

REFERENCE DRAWINGS

REVISIONS TABLE

PURPOSE OF ISSUE: FOR APPROVAL

MODON

egis

MOFARREH GROUP

STORM DRAINAGE SYSTEM

STORM DRAINAGE SECONDARY LAYOUT PLAN ZONE B

SCALE


SHEET

STORM NETWORK PROCUREMENT PROGRESS LAYOUT (ZONE-A,B & LABOUR CAMP)

Storm Network materials status							
SR	MATERIAL	UNIT	TOTAL QTY	DELIVERED QTY	% DELIVERED	REMAINING QTY	% REMIAINING
1	GRP PIPE DIA 400 mm	L.M	12,011.00	8,416.00	70.07%	3,595.00	29.93%
2	GRP PIPE DIA 800 mm	L.M	1,850.00	1,572.00	84.97%	278.00	15.03%
3	GRP PIPE DIA 500 mm	L.M	1,225.00	1,836.00	149.88%	-611.00	-49.88%
4	GRP PIPE DIA 600 mm	L.M	2,578.00	2,796.00	108.46%	-218.00	-8.46%
5	GRP PIPE DIA 700 mm	L.M	1,245.00	1,064.00	85.46%	181.00	14.54%
6	GRP PIPE DIA 900 mm	L.M	870.00	754.00	86.67%	116.00	13.33%
7	GRP PIPE DIA 1000 mm	L.M	765.00	568.00	74.25%	197.00	25.75%
8	GRP PIPE DIA 1200 mm	L.M	1,690.00	1,690.00	100.00%	0.00	0.00%
9	Storm Manhole	EA	298.00	294.00	98.66%	4.00	1.34%
10	Box culvert	EA (2.5 M)	264.00	264.00	100.00%	0.00	0.00%
11	Box Conduit	EA (2.5 M)	799.00	298.00	37.30%	501.00	62.70%
12	Catch basin	EA	668.00	610.00	91.32%	58.00	8.68%
13	UPVC pipe dia 200 mm	L.M	1,818.00	1,500.00	82.51%	318.00	17.49%
14	UPVC pipe dia 300 mm	L.M	13,375.00	12,335.00	92.22%	1,040.00	7.78%
15	UPVC pipe dia 400 mm	L.M	915.00	738.00	80.66%	177.00	19.34%
16	Warning tape	Roll	900.00	450.00	50.00%	450.00	50.00%
17	DI COVERS FOR STORM MANHOLE & CATCH BASIN	EA	966.00	417.00	43.17%	549.00	56.83%

POTABLE WATER NETWORK PROGRESS LAYOUT ZONE-A

ZONE A + Labor Camp (Potable)				
ITEM	Total Quantity (LM)	Excuted Quantity (LM)	Remaining Quantity (LM)	Percentage %
Excavation	20475.00	2027.630	18447.370	9.90%
Bedding	20475.00	1862.630	18612.370	9.10%
Installation	20475.00	1862.630	18612.370	9.10%
Backfilling	20475.00	185.000	20290.000	0.90%

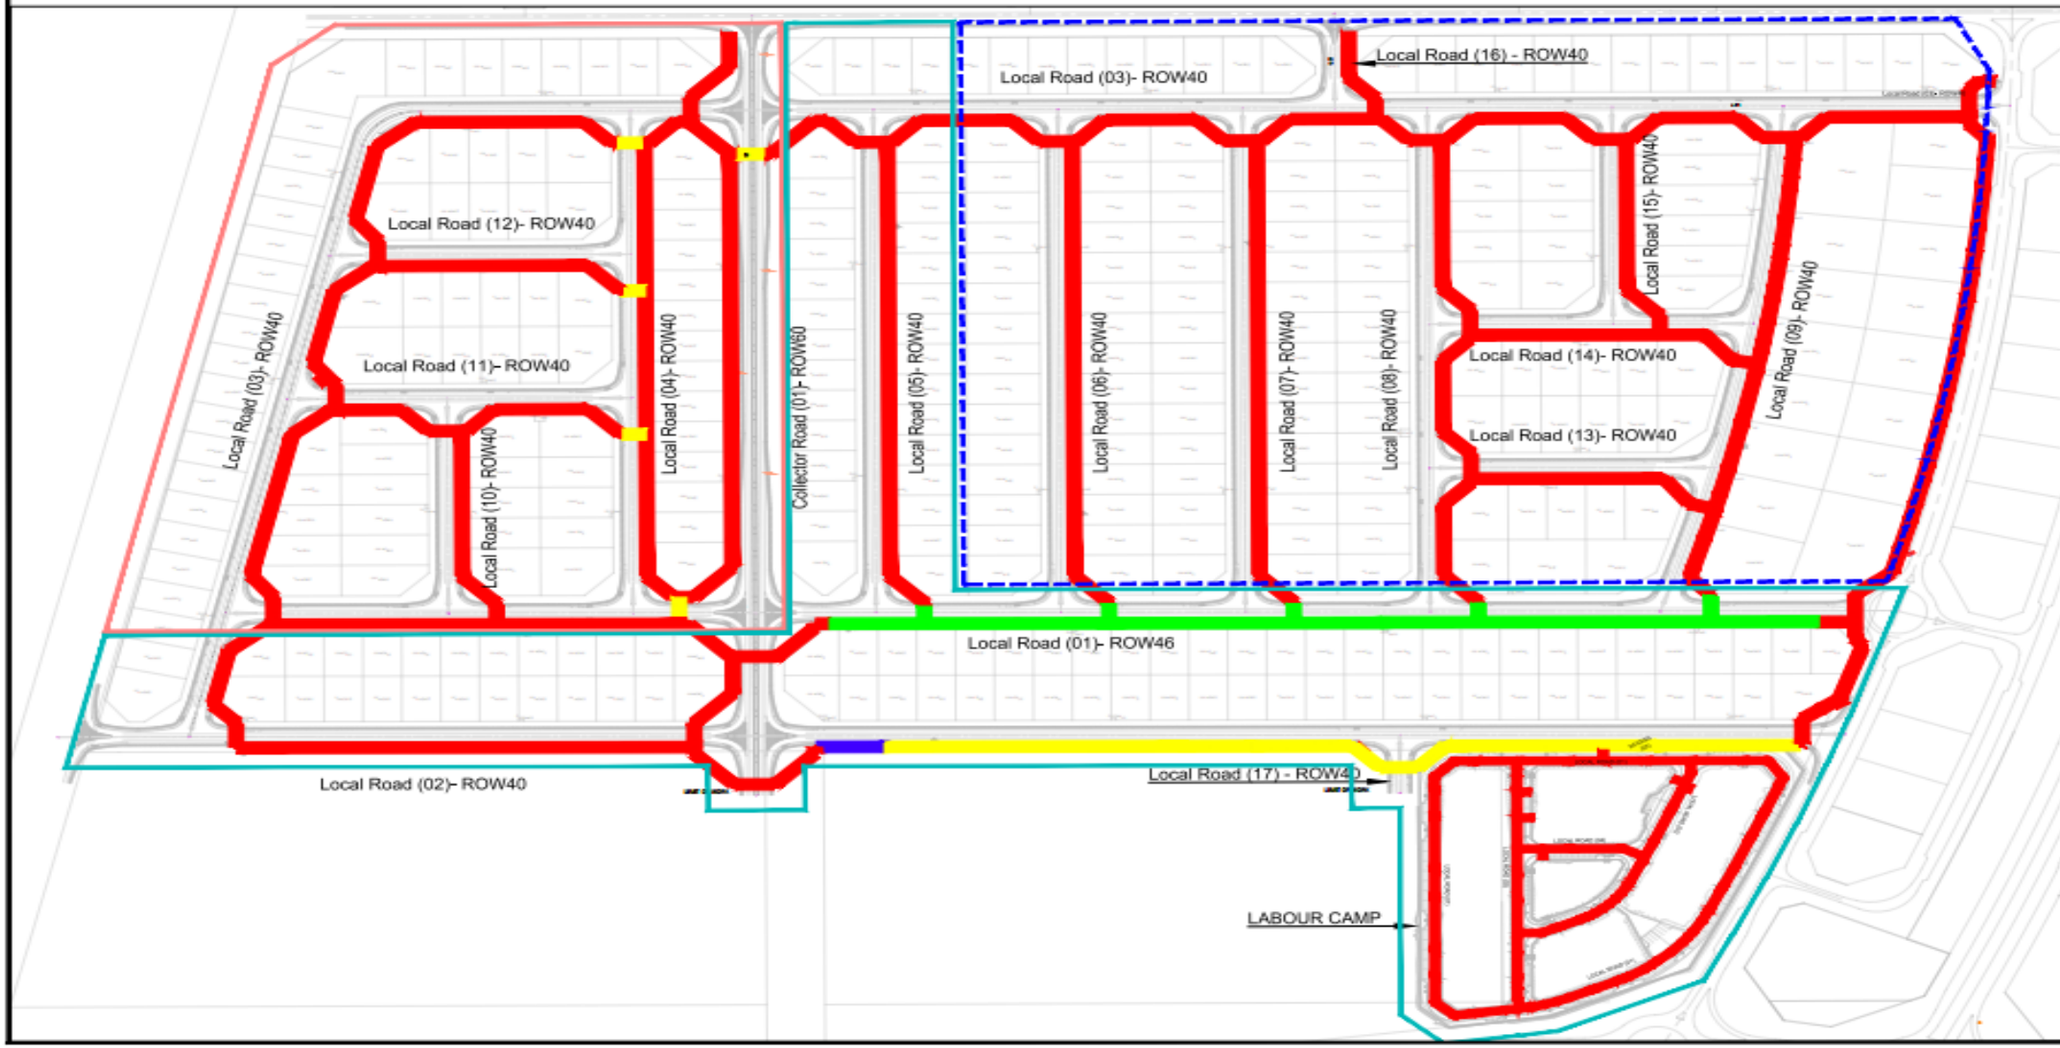

KEY PLAN



Legend

- Excavation
- Bedding
- Installation
- Backfilling
- Remaining

Work Area

- Engr.Shamy
- Engr.Mohammed
- Engr.Nivin

REFERENCE DRAWINGS

REVISIONS TABLE

PURPOSE OF ISSUE: FOR APPROVAL

MODON egis MOFARREH GROUP


POTABLE WATER NETWORK

POTABLE WATER NETWORK LAYOUT ZONE A

SCALE 1:1000

POTABLE WATER NETWORK PROGRESS LAYOUT ZONE-B

ZONE B (Potable) Pipes				
ITEM	Total Quantity (LM)	Excuted Quantity (LM)	Remaining Quantity (LM)	Percentage %
Excavation	10308.00	5494.33	4813.67	53.30%
Bedding	10308.00	5469.33	4838.67	53.06%
Installation	10308.00	5469.33	4838.67	53.06%
Backfilling	10308.00	1675.00	8633.00	16.25%

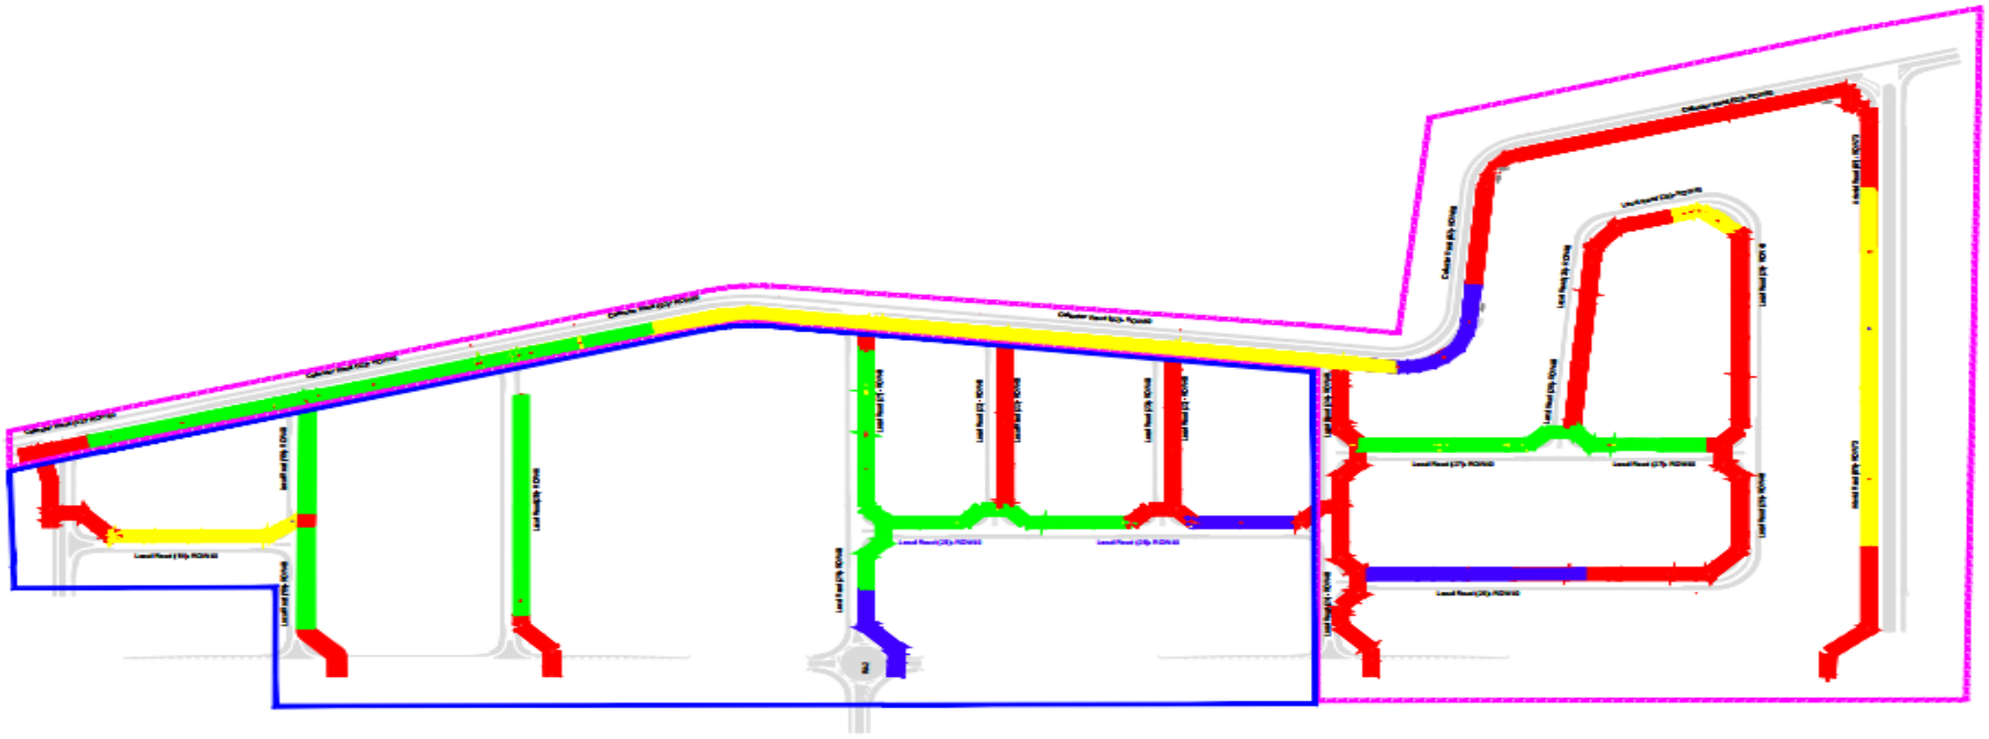

KEY PLAN



Legend

- Excavation
- Bedding
- Installation
- Backfilling
- Remaining

Work Area

- Eng.Bestawi
- Eng.Salem


REFERENCE DRAWINGS

REVISIONS TABLE

PURPOSE OF ISSUE: FOR APPROVAL

POTABLE FIRE HYDRANT PROGRESS LAYOUT ZONE-A

ZONE A FireHydrant Progress				
ITEM	Total Quantity (EA)	Excuted Quantity (LM)	Remaining Quantity (LM)	Percentage %
Excavation	170	13	157	7.65%
Blinding	170	1	169	0.59%
Installation	170	1	169	0.59%
Backfilling	170	0	170	0.00%

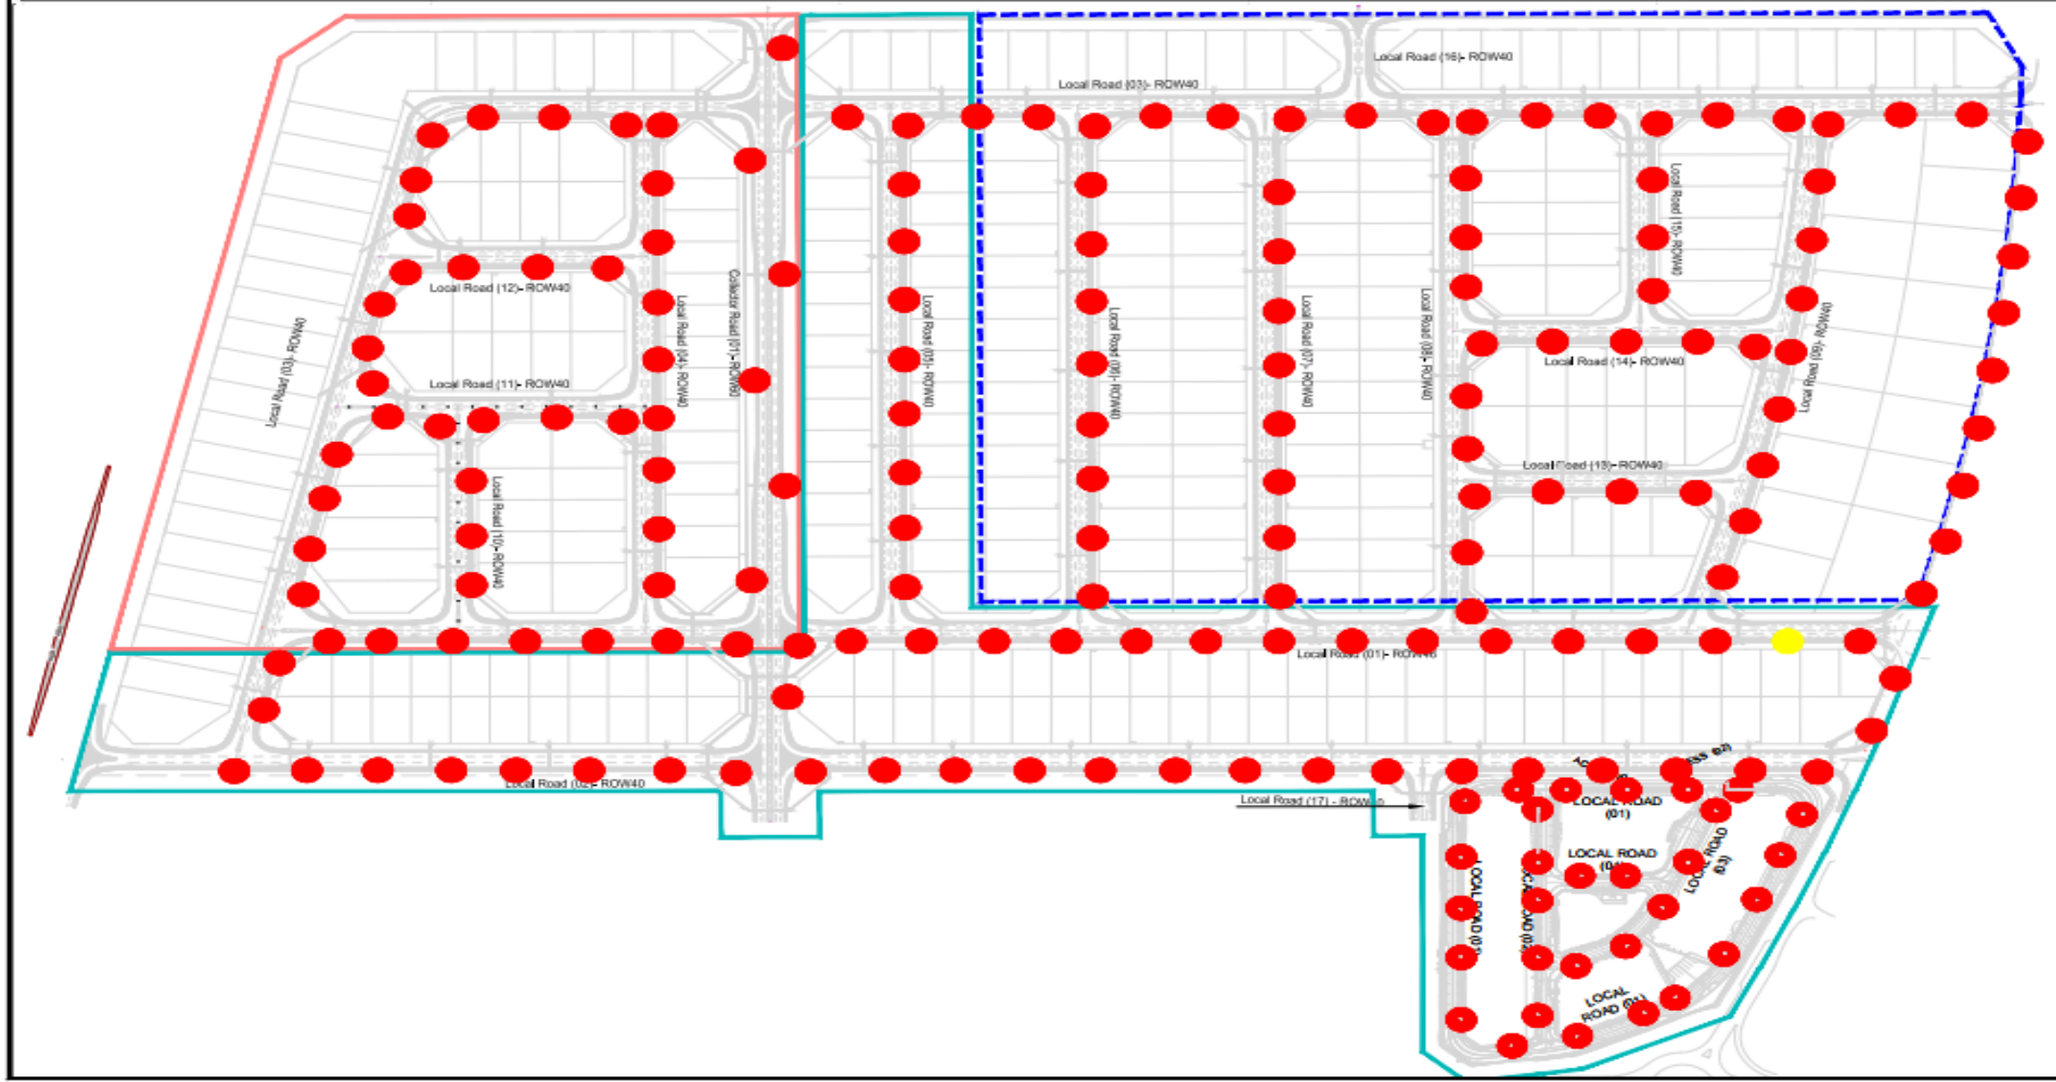

KEY PLAN



Legend

- Excavation
- Blinding
- Installation
- Backfilling
- Remaining

Work Area

- Engr.Shamy
- Engr.Mohammed
- Engr.Nivin

REFERENCE DRAWINGS

REVISIONS TABLE

PURPOSE OF ISSUE: FOR APPROVAL

MODON

egis

MOFARREH GROUP


FIRE HYDRANT LAYOUT ZONE-A

SCALE


SHEET

POTABLE FIRE HYDRANT PROGRESS LAYOUT ZONE-B

ZONE B FireHydrant Progress				
ITEM	Total Quantity (EA)	Excuted Quantity	Remaining Quantity (LM)	Percentage %
Excavation	110.00	4	106	3.64%
Blinding	110.00	4	106	3.64%
Installation	110.00	4	106	3.64%
Backfilling	110.00	0	110	0.00%

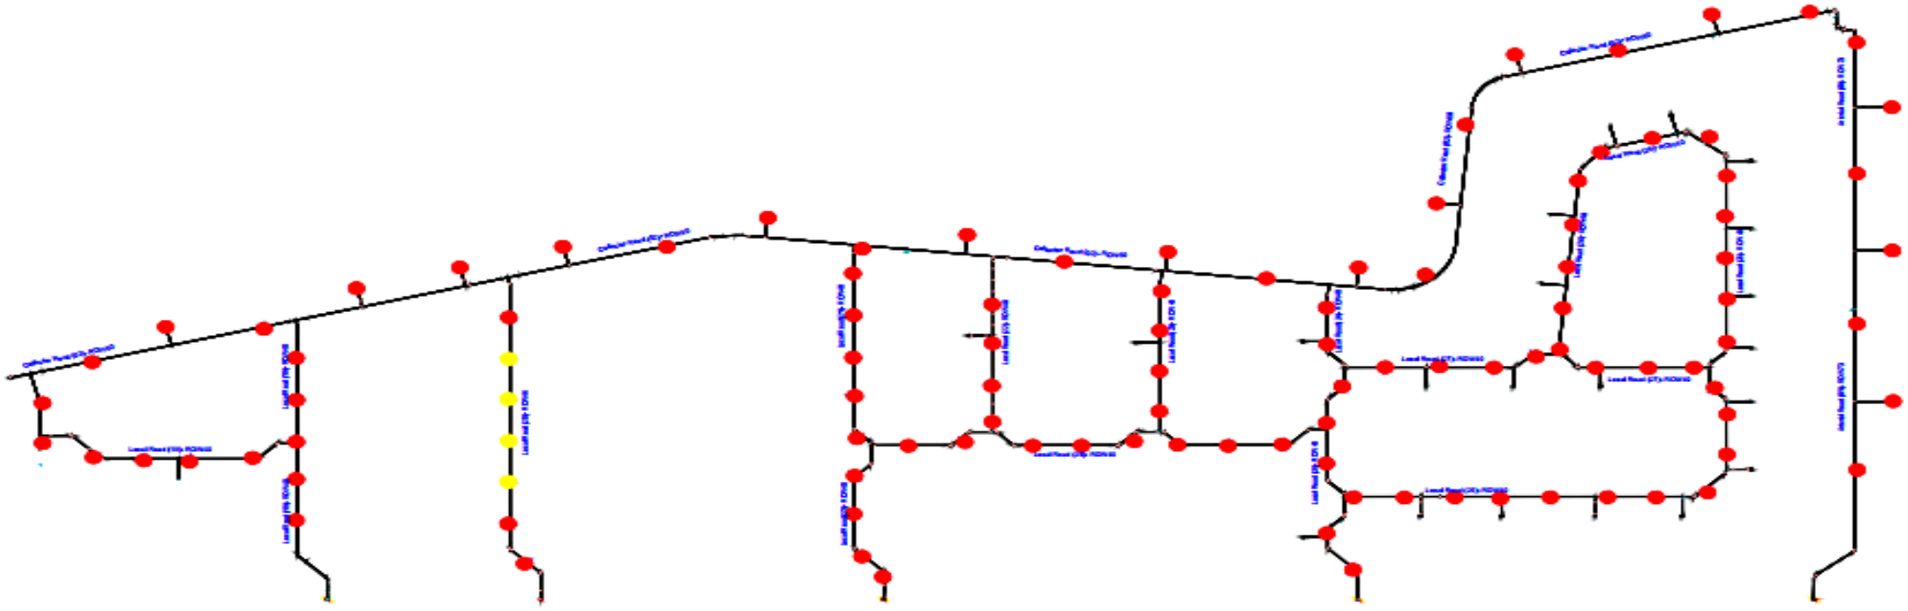

KEY PLAN

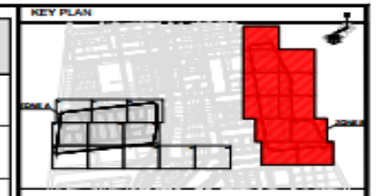

Legend

- Excavation
- Blinding
- Installation
- Backfilling
- Remaining

REFERENCE DRAWINGS

REVISIONS TABLE

PURPOSE OF ISSUE: FOR APPROVAL

MODON: UPDATED CONCEPT MASTER PLAN AND INFRASTRUCTURE OF MODON FOR ALKHOBAR INDUSTRIAL CITY

POTABLE SYSTEM


POTABLE LAYOUT PLAN ZONE B

SCALE

SHEET

TSE WATER NETWORK PROGRESS LAYOUT ZONE-A

(TSE) PIPE PROGRESS ZONE A				
ITEM	Total Quantity (LM)	Excuted Quantity (LM)	Remaining Quantity (LM)	Percentage %
Excavation	13023	175.000	12848.000	1.34%
Bedding	13023	155.000	12868.000	1.19%
Installation	13023	130.000	12893.000	1.00%
Backfilling	13023	0.000	13023.000	0.00%

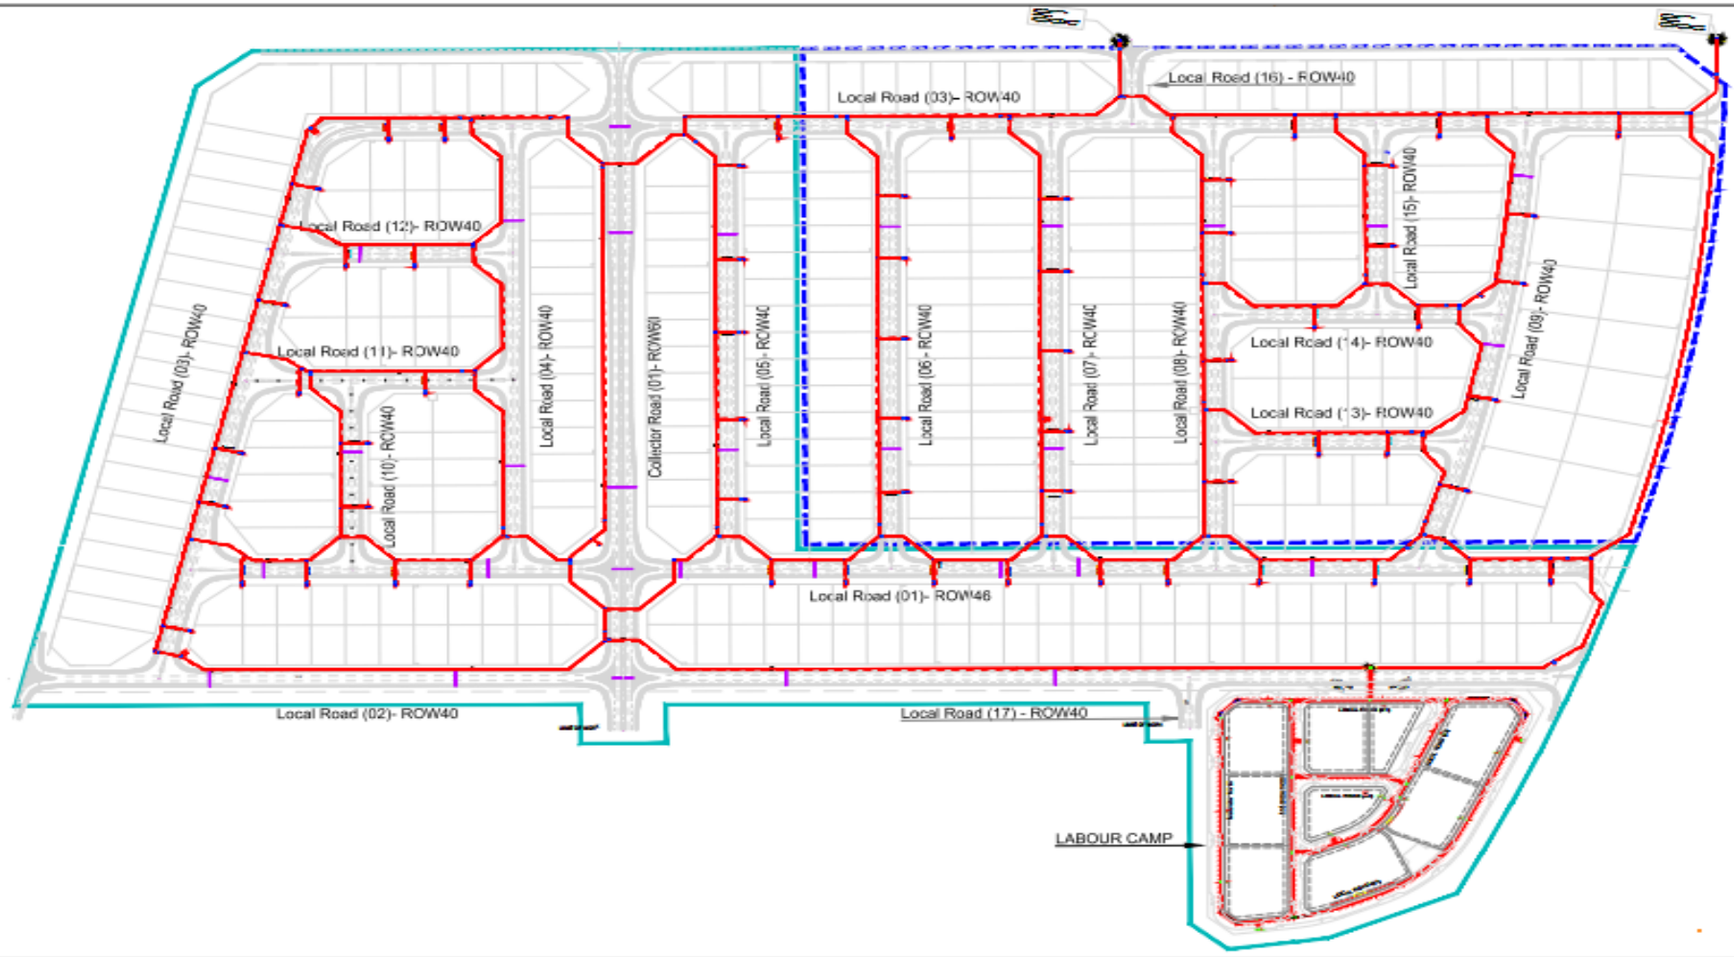



Legend

- Excavation
- Base Installation
- Backfilling
- Remaining

Work Area

- Engr.Shamy
- Engr.Mohammed

REFERENCE DRAWINGS

REVISIONS TABLE

PURPOSE OF ISSUE: FOR APPROVAL

MODON

egis

MOFARREH GROUP


TSE PROGRESS LAYOUT ZONE-A

SCALE

DATE

TSE WATER NETWORK PROGRESS LAYOUT ZONE-B

(TSE) PIPE PROGRESS ZONE B				
ITEM	Total Quantity (LM)	Excuted Quantity (LM)	Remaining Quantity (LM)	Percentage %
Excavation	10991	3480.780	7510.220	31.67%
Bedding	10991	3480.780	7510.220	31.67%
Installation	10991	3336.780	7654.220	30.36%
Backfilling	10991	2770.780	8220.220	25.21%

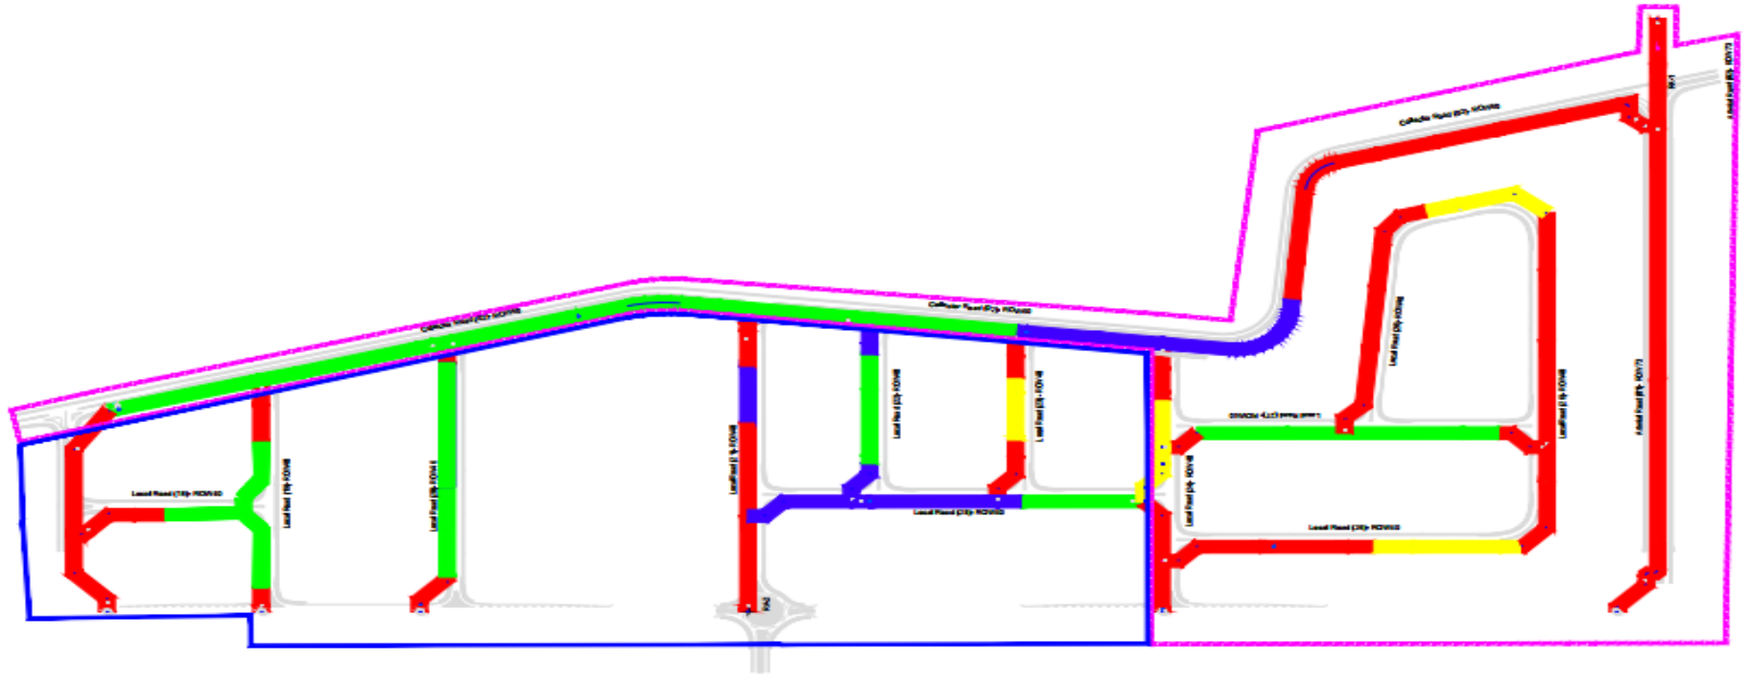

KEY PLAN



Legend

- Excavation
- Bedding
- Installation
- Backfilling
- Remaining

Work Area


- Eng.Bestawi
- Eng.Salem

REFERENCE DRAWINGS


REVISIONS TABLE


PURPOSE OF ISSUE: FOR APPROVAL

CROSSING PROGRESS LAYOUT-ZONE A

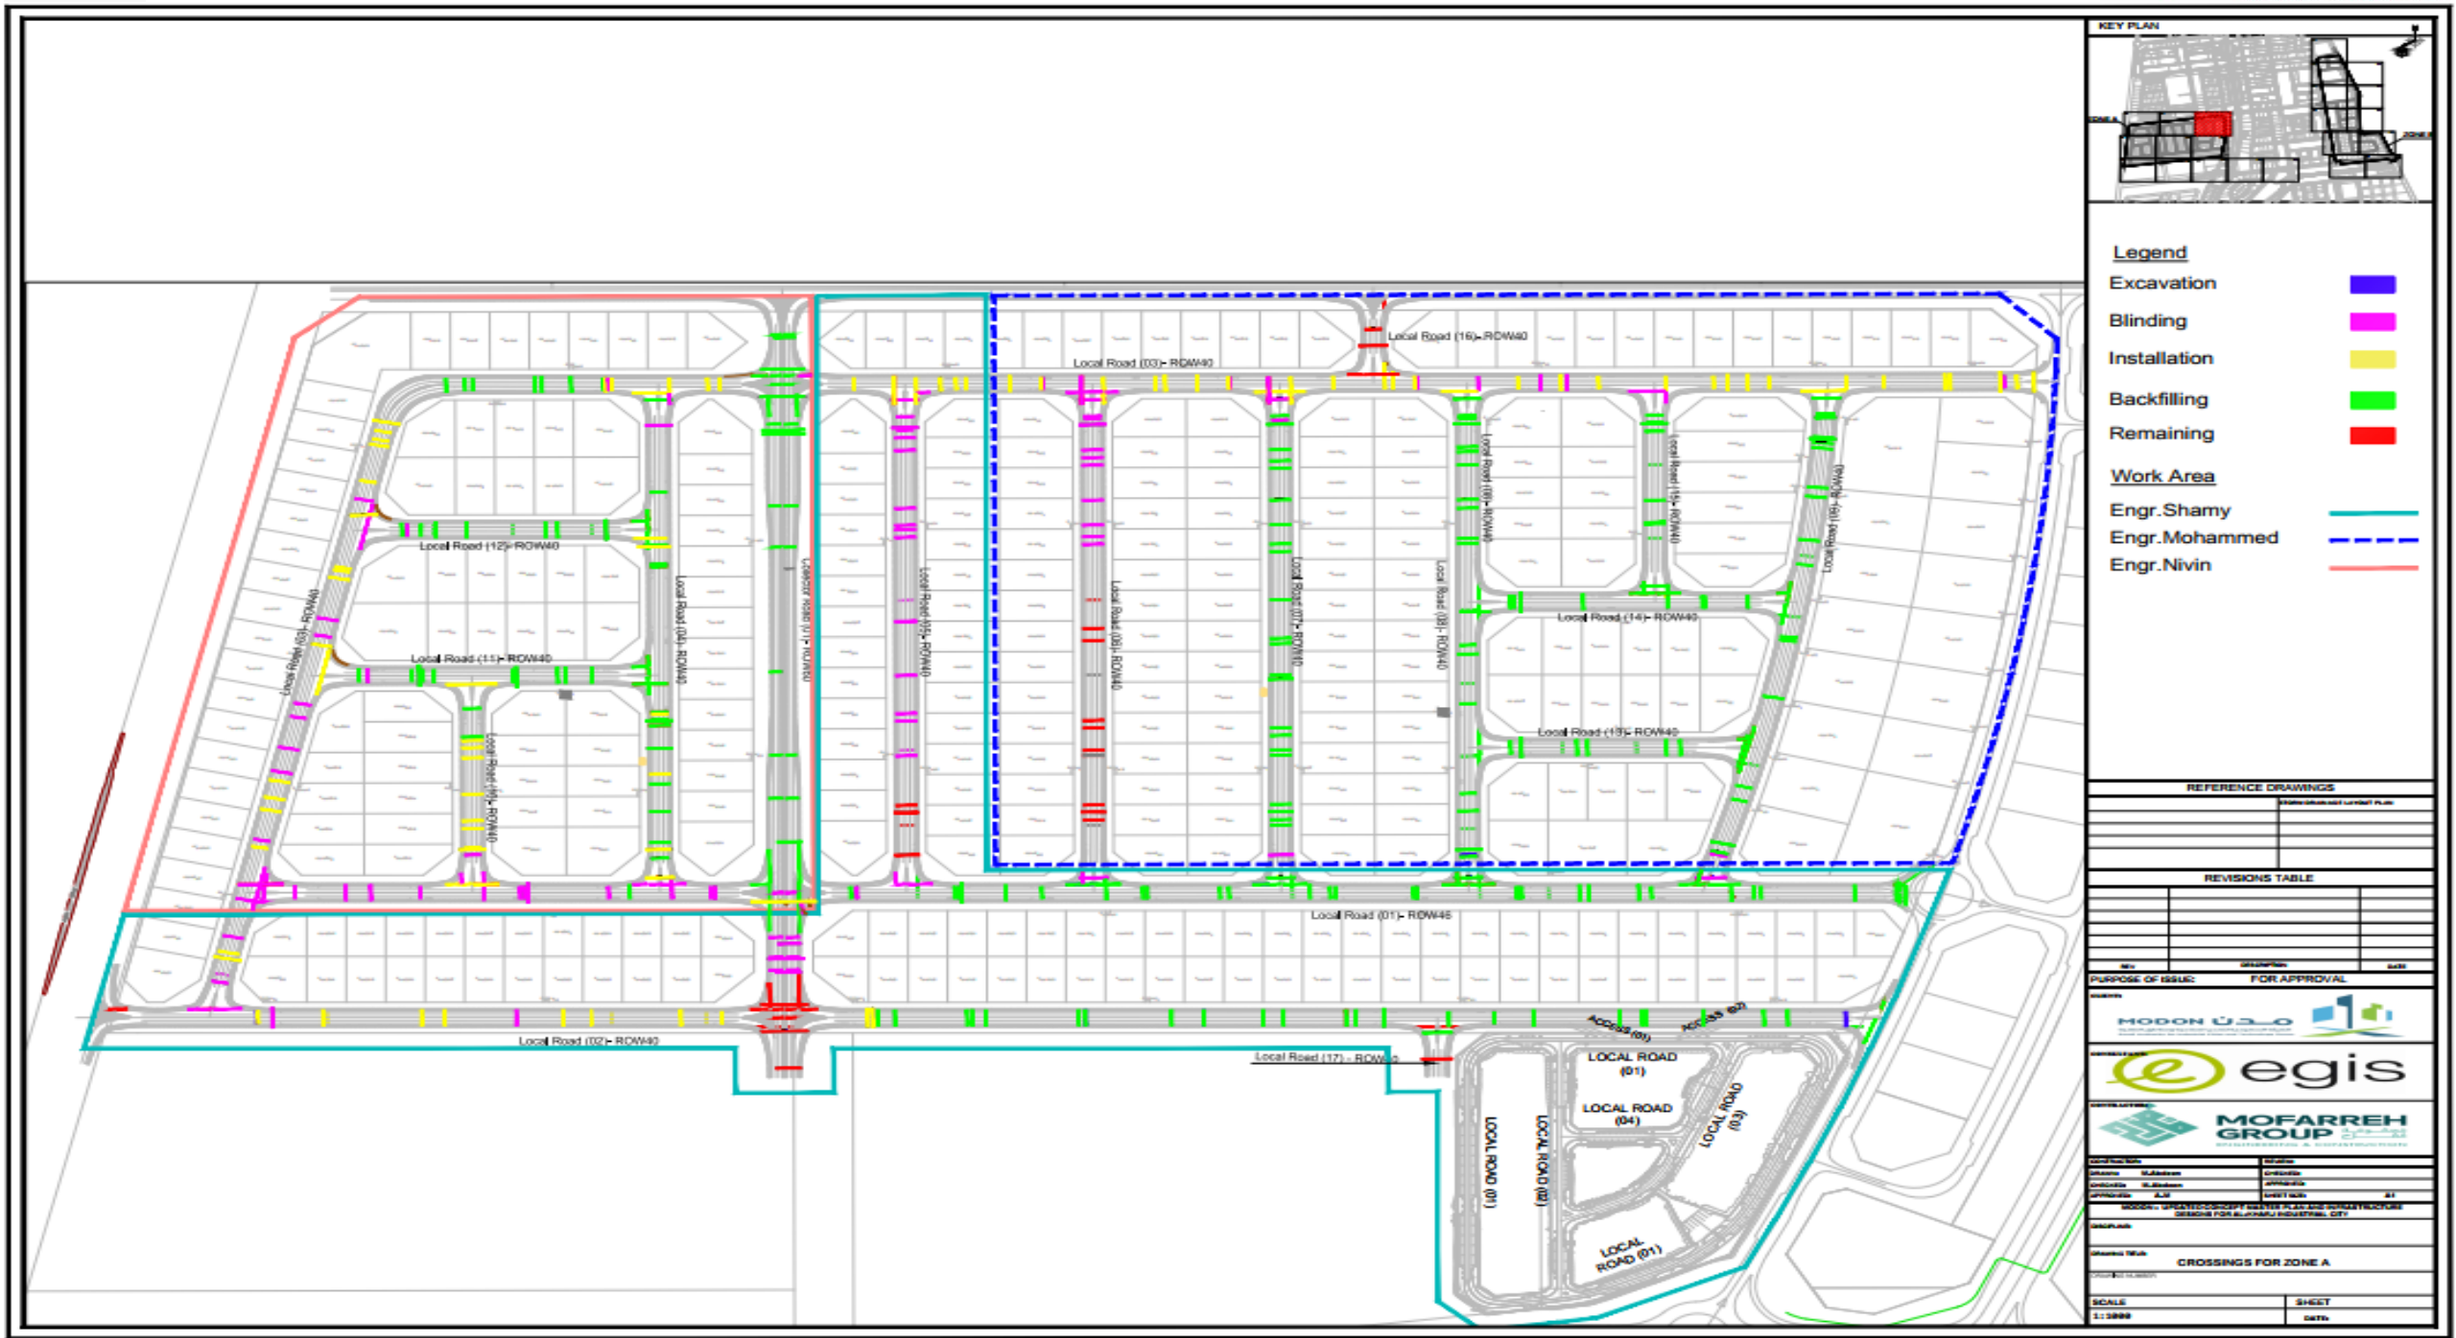

CROSSING PROGRESS LAYOUT ZONE-B

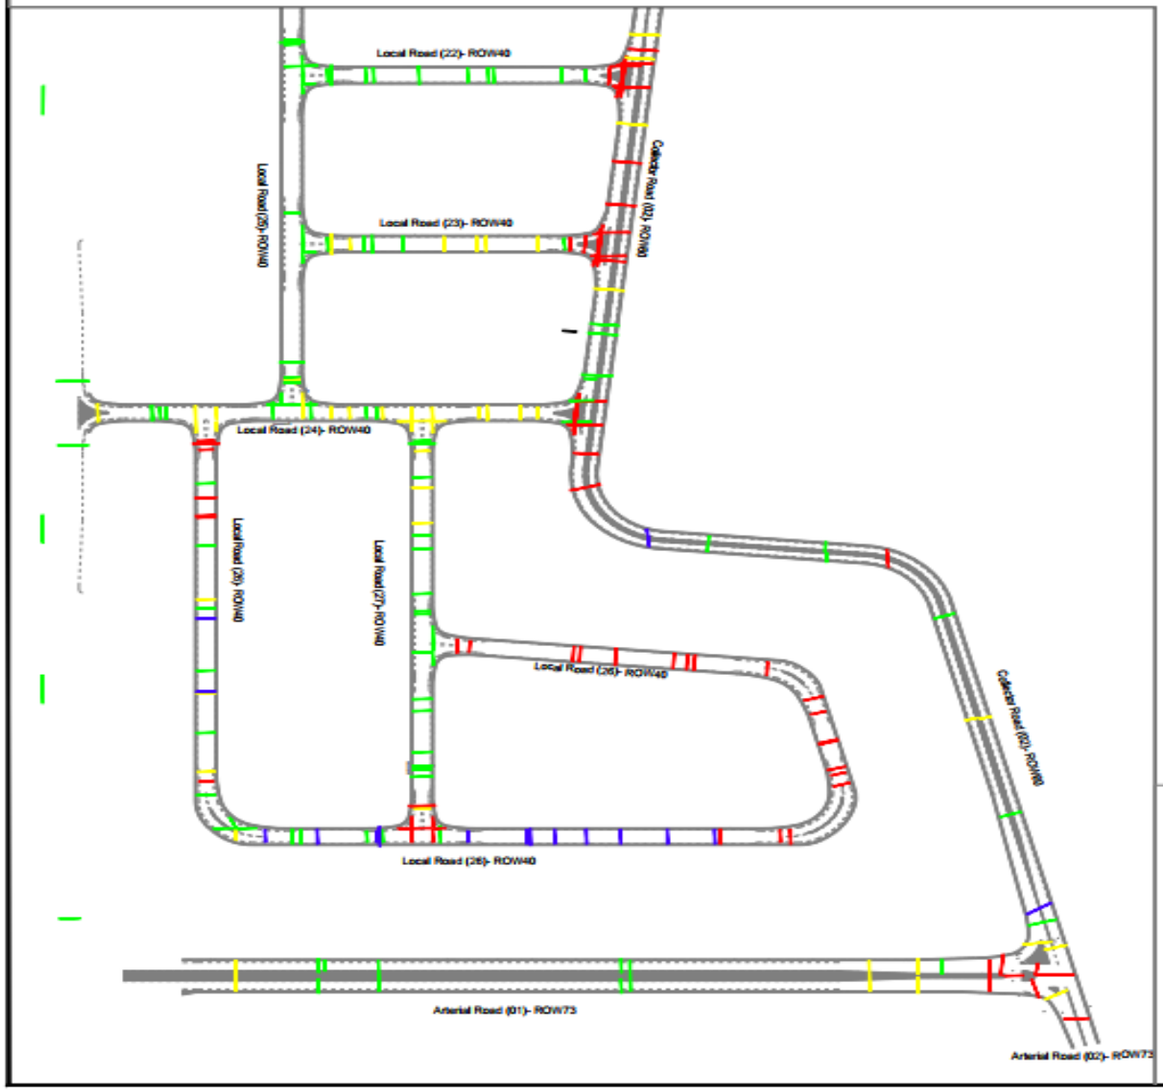

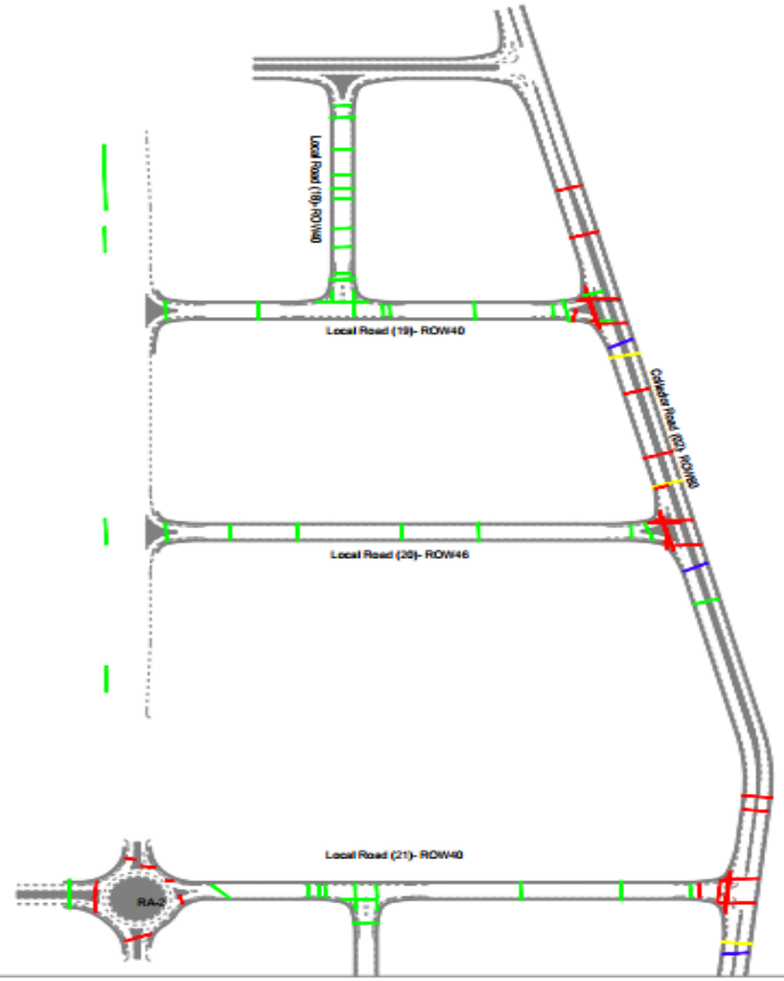



Legend

- Excavation
- Bedding/Blinding
- Piping
- Backfilling

Work Area

- Eng.Bestawi
- Eng.Salem

0 10 20 30 40 50 100 METERS
SCALE (AT) 1:1000

REFERENCE DRAWINGS

REVISIONS TABLE

NO.	DESCRIPTION	DATE

PURPOSE OF ISSUE: FOR APPROVAL

MODON مدن

egis

MOFARREH GROUP مجموعة مفرح ENGINEERING & CONSTRUCTION

MODON - UPDATED CONCEPT MASTER PLAN AND INFRASTRUCTURE DESIGNS FOR ALKHARJ INDUSTRIAL CITY


Weekly Progress

UTILITY CROSSINGS-ZONE B

SCALE Date

CURBSTONE PROGRESS LAYOUT ZONE-A

ZONE A (Curbstone)				
ITEM	Total Quantity (LM)	Excuted Quantity (LM)	Remaining Quantity (LM)	Percentage %
Excavation	81,767.97	3734.320	78033.650	4.57%
Blinding	81,767.97	1041.000	80726.970	1.27%
Installation	81,767.97	1041.000	80726.970	1.27%

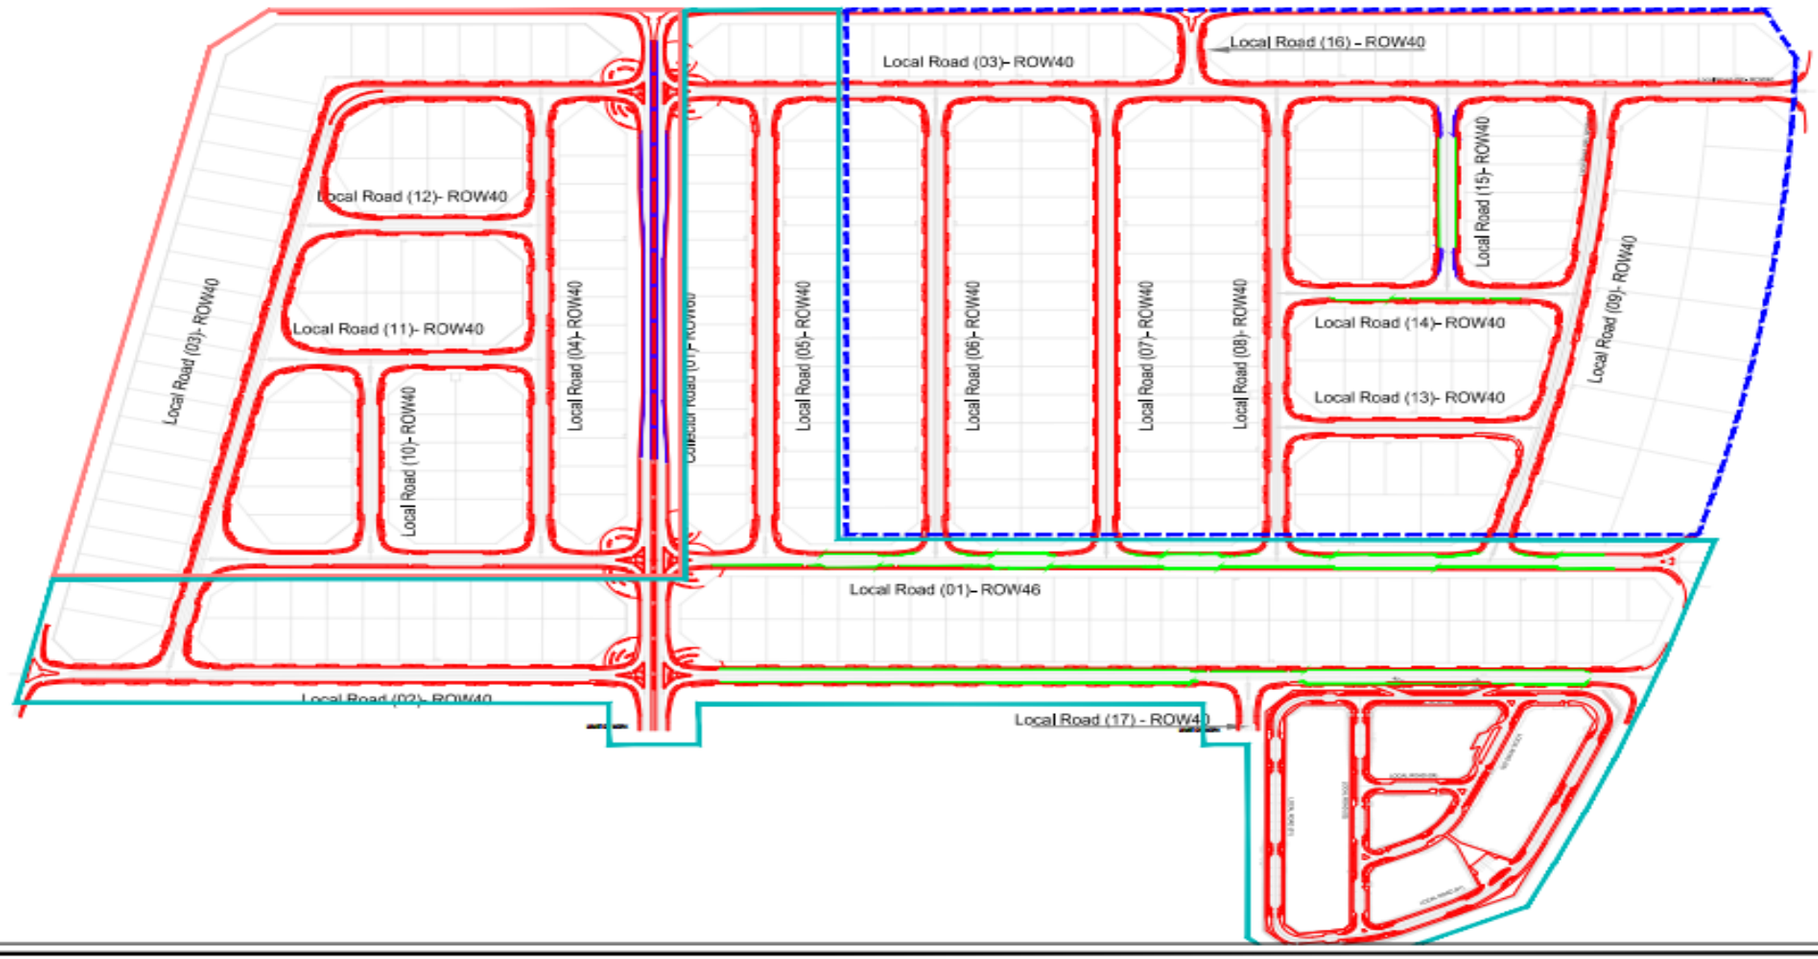



Legend

- Excavation
- Blinding
- Installation
- Remaining

Work Area

- Engr.Shamy
- Engr.Mohammed
- Engr.Nivin

SCALE (A1) 1:1000 METERS

REFERENCE DRAWINGS

REVISIONS TABLE


PURPOSE OF ISSUE: FOR APPROVAL

Weekly Progress

CURBSTONE PROGRESS LAYOUT-ZONE A

CURBSTONE PROGRESS LAYOUT ZONE-B

ZONE B (Curbstone)				
ITEM	Total Quantity (LM)	Excuted Quantity (LM)	Remaining Quantity (LM)	Percentage %
Excavation	74,108.65	5585.344	68523.306	7.54%
Blinding	74,108.65	5585.344	68523.306	7.54%
Installation	74,108.65	5585.344	68523.306	7.54%

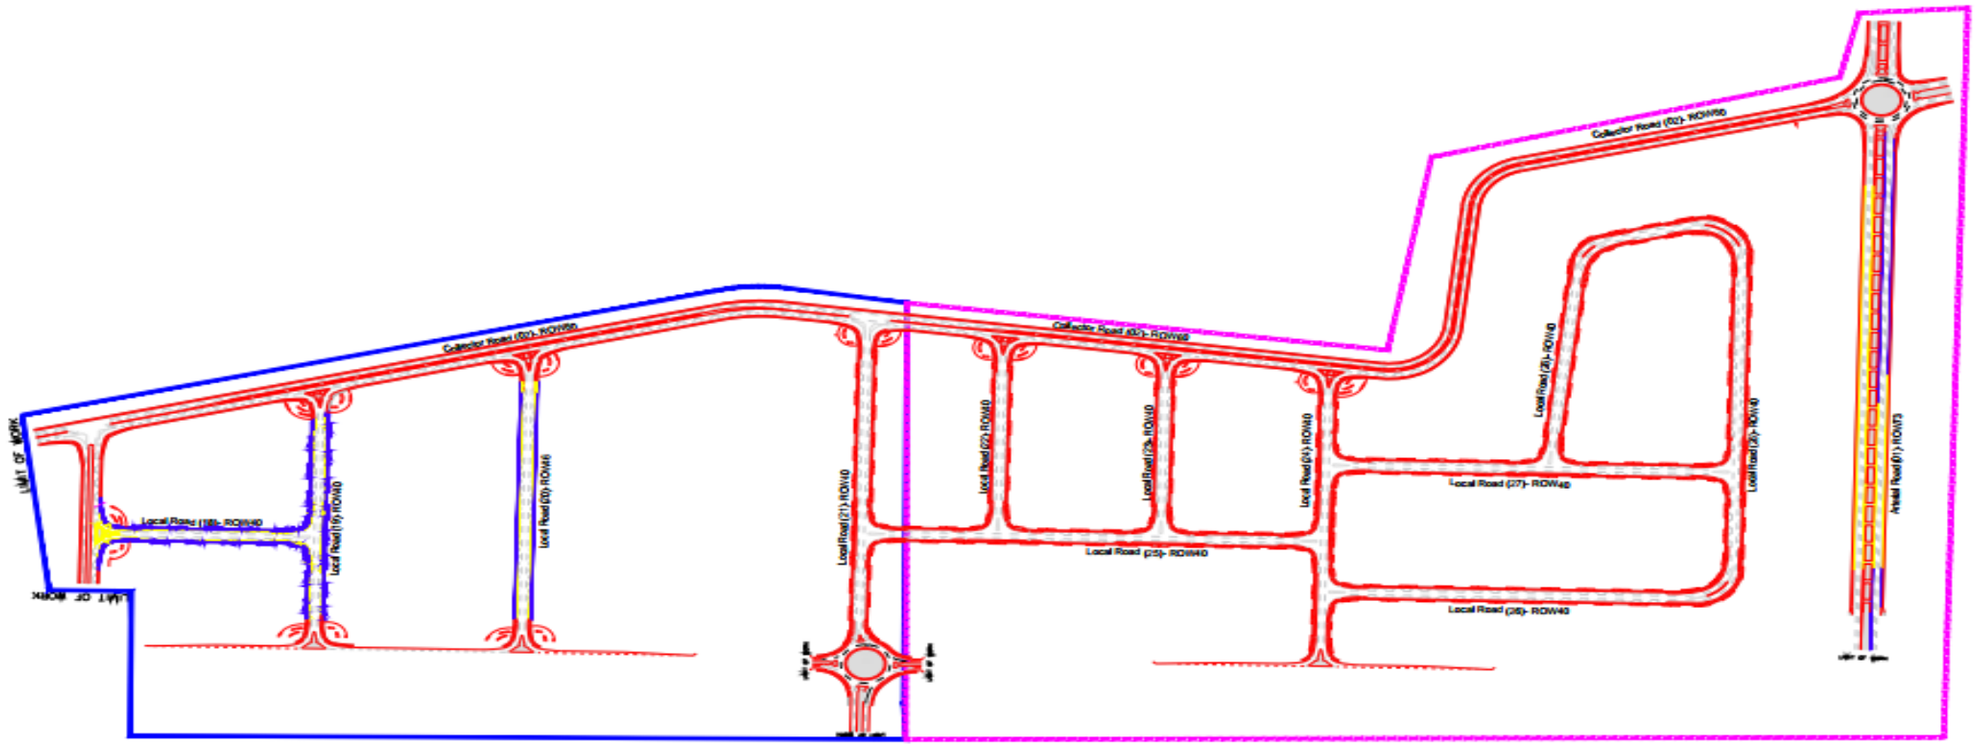



Legend

- Excavation
- Blinding
- Installation
- Remaining

Work Area

- Salem
- Abdullah

0 10 20 30 40 50 100 METERS
SCALE (A1) 1:1000

REFERENCE DRAWINGS

REVISIONS TABLE

PURPOSE OF ISSUE: FOR APPROVAL

MODON مدن

egis

MOFARREH GROUP


Weekly Progress

CURBSTONE LAYOUT - ZONE B

SCALE 1:1000 Date

INTERLOCK PROGRESS LAYOUT ZONE-A

ZONE A (Interlock)				
ITEM	Total Quantity (SQ.M)	Excuted Quantity (SQ.M)	Remaining Quantity (SQ.M	Percentage %
Backfilling	71,537.70	0.000	71537.701	0.00%
Bedding	71,537.70	0.000	71537.701	0.00%
Installation	71,537.70	0.000	71537.701	0.00%

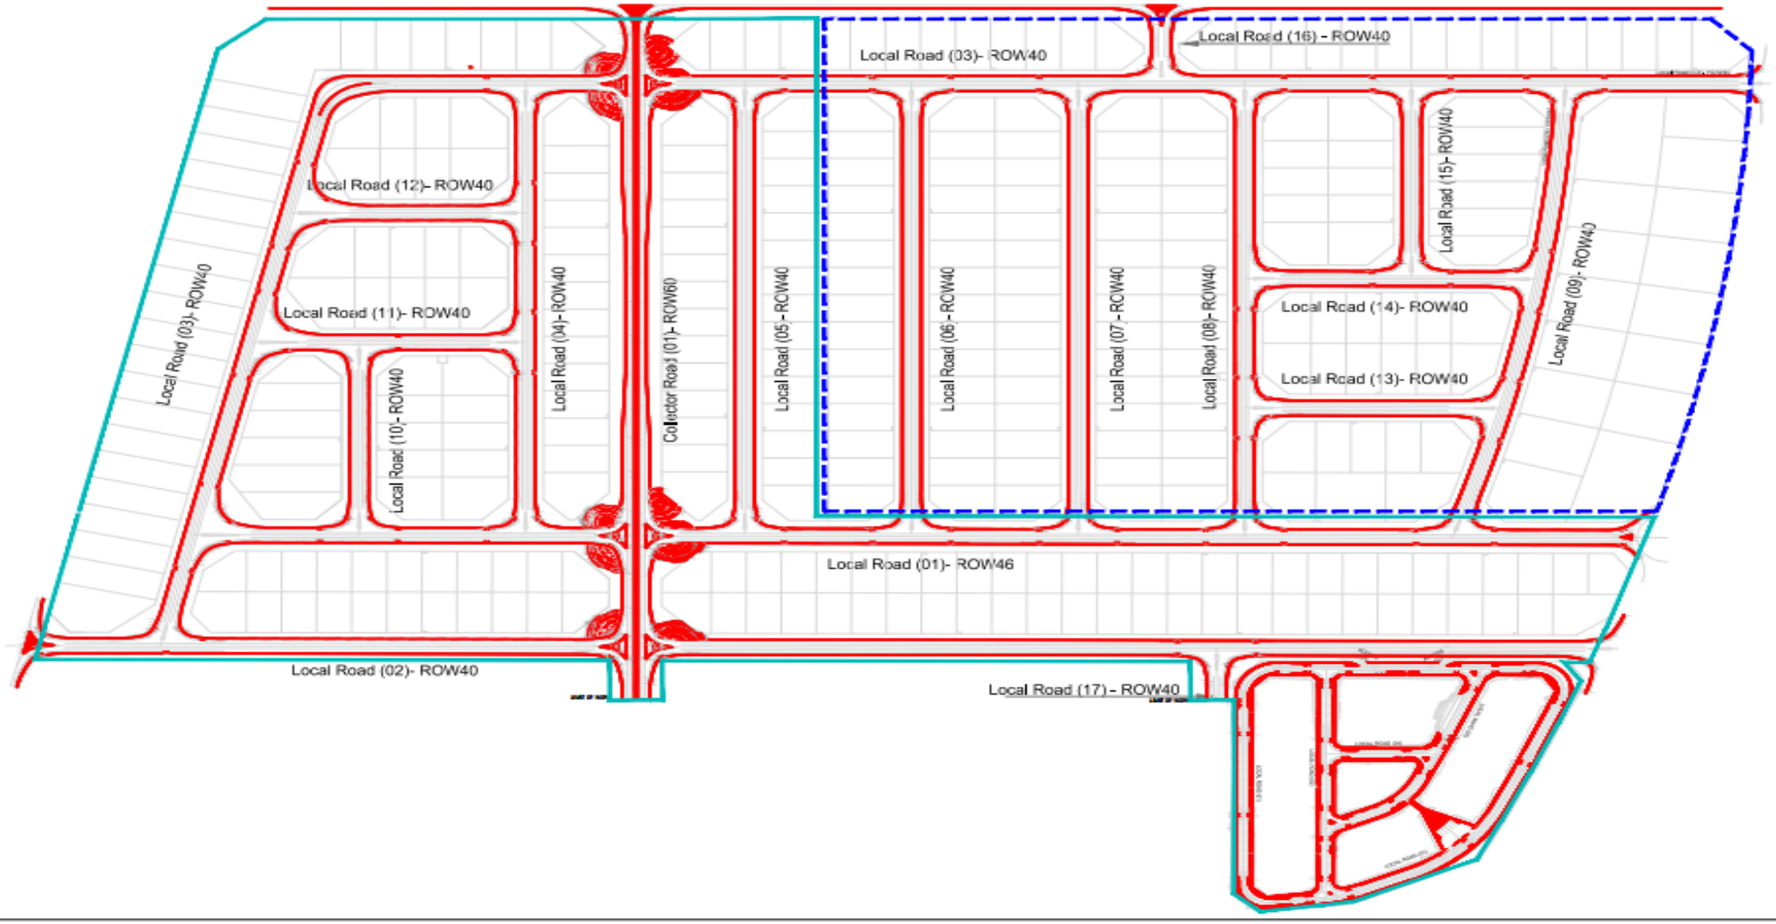

KEY PLAN



Legend

- Backfilling
- Bedding
- Installation
- Remaining

Work Area

- Engr.Shamy
- Engr.Mohammed

0 10 20 30 40 50 100 METERS
SCALE (A1) 1:1000

REFERENCE DRAWINGS

REVISIONS TABLE

REV	DESCRIPTION	DATE

PURPOSE OF ISSUE: FOR APPROVAL

MODON - UPDATED CONCEPT MASTER PLAN AND INFRASTRUCTURE DESIGNS FOR AL-KHAMIJ INDUSTRIAL CITY

Weekly Progress


CURBSTONE PROGRESS LAYOUT-ZONE A

SCALE 1:1000

Date 06/06/2026

INTERLOCK PROGRESS LAYOUT ZONE-B

ZONE B (Interlock)				
ITEM	Total Quantity (SQ.M)	Excuted Quantity (SQ.M)	Remaining Quantity (SQ.M)	Percentage %
Backfilling	68,821.68	0.000	68821.675	0.00%
Bedding	68,821.68	0.000	68821.675	0.00%
Installation	68,821.68	0.000	68821.675	0.00%

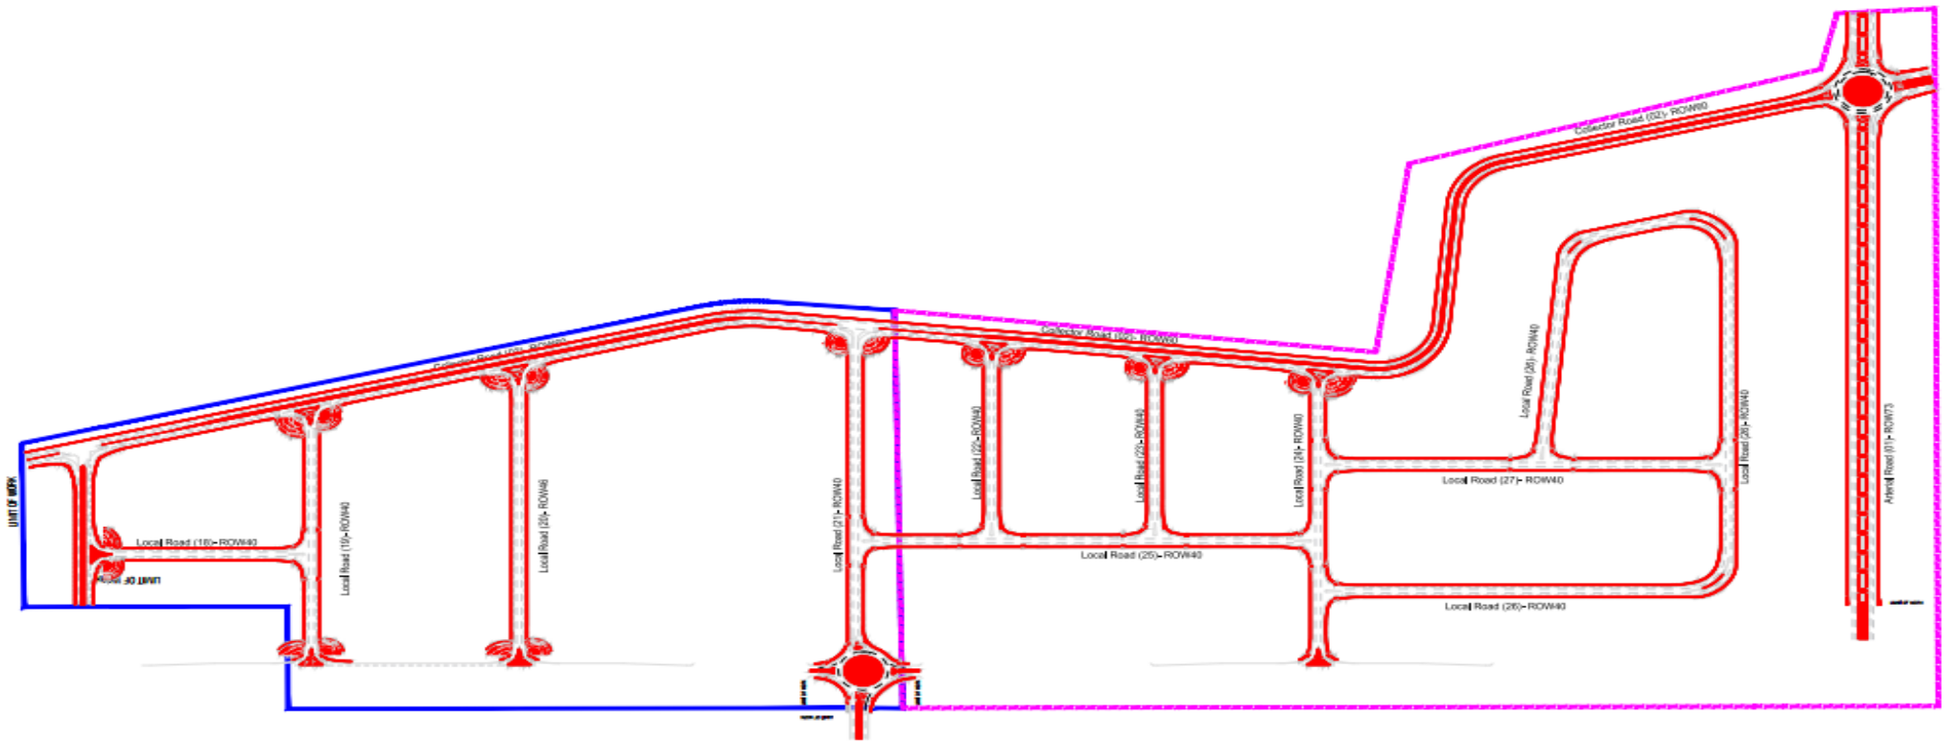

KEY PLAN



Legend

- Backfilling
- Bedding
- Installation
- Remaining

Work Area

- Salem
- Abdullah

0 10 20 30 40 50 100 METERS
SCALE (A1) 1:1000

REFERENCE DRAWINGS

REVISIONS TABLE

REV	DESCRIPTION	DATE

PURPOSE OF ISSUE: FOR APPROVAL

MODON – UPDATED CONCEPT MASTER PLAN AND INFRASTRUCTURE DESIGNS FOR ALKHMAL INDUSTRIAL CITY

Weekly Progress


INTERLOCK LAYOUT-ZONE B

SCALE 1:1000 Date

CULVERT PROGRESS-ZONE B

CULVERT PROGRESS LAYOUT


SHEET 01 OF 02

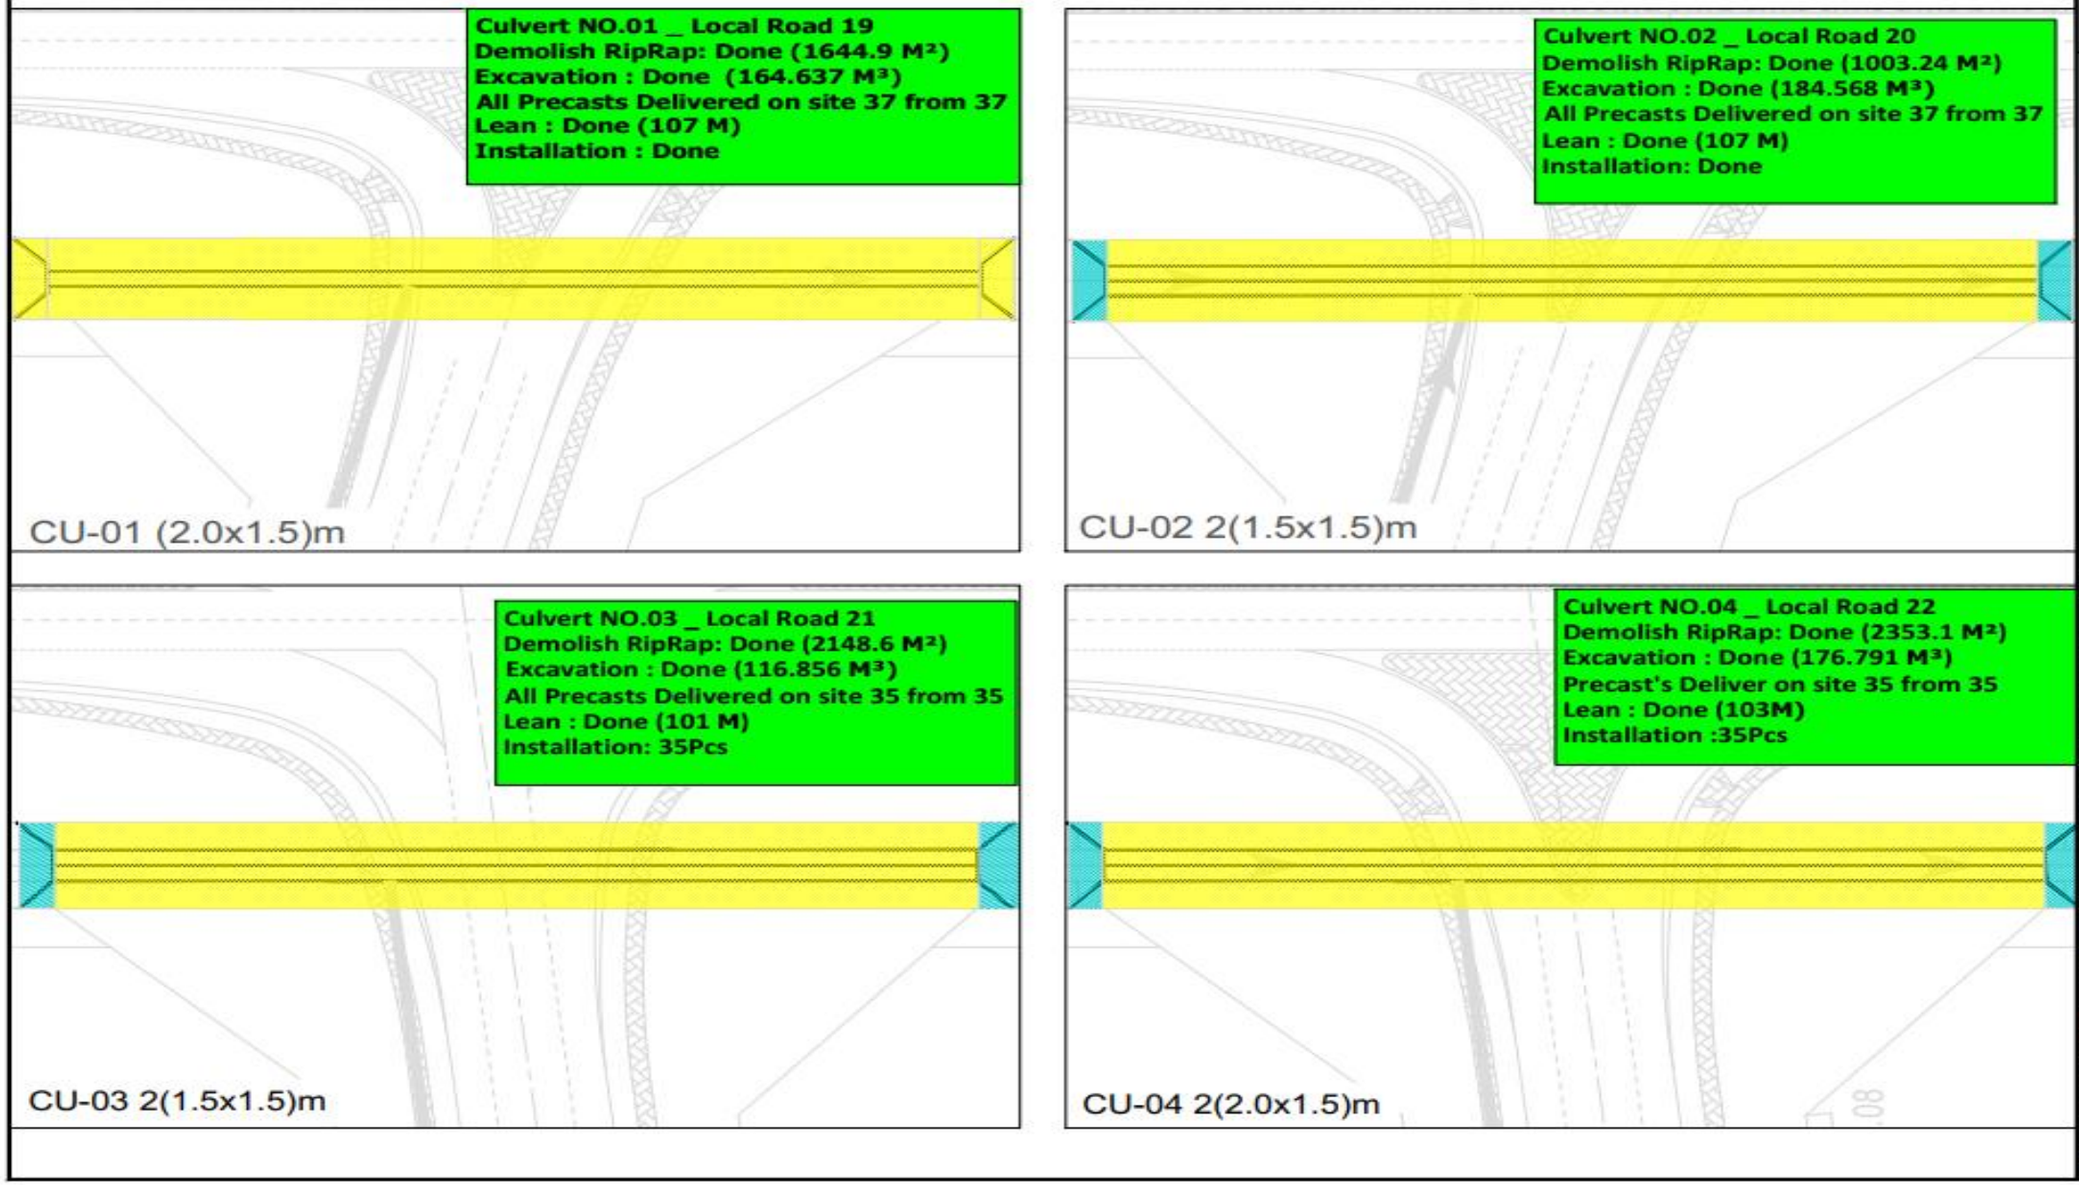



CULVERT PROGRESS-ZONE B

CULVERT PROGRESS LAYOUT

SHEET 02 OF 02

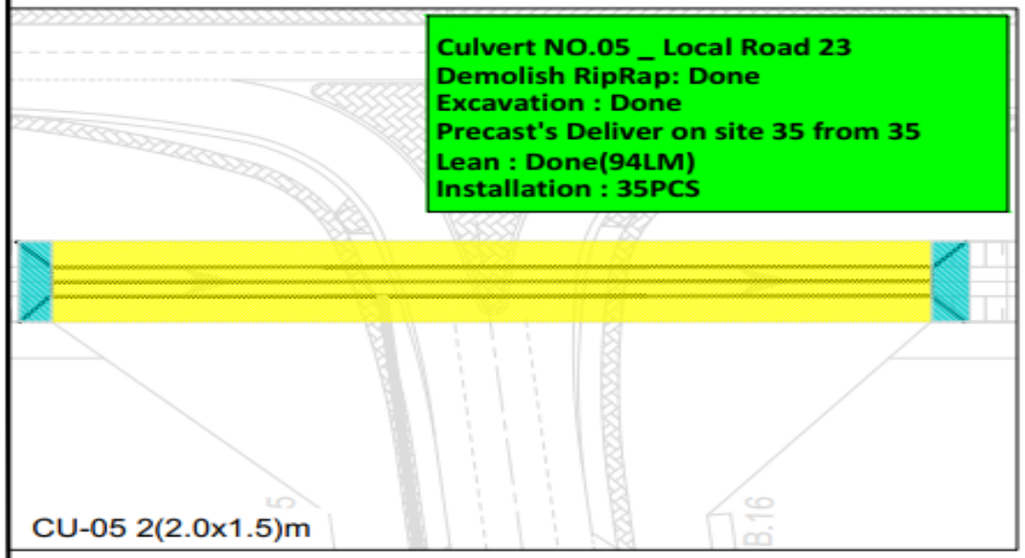

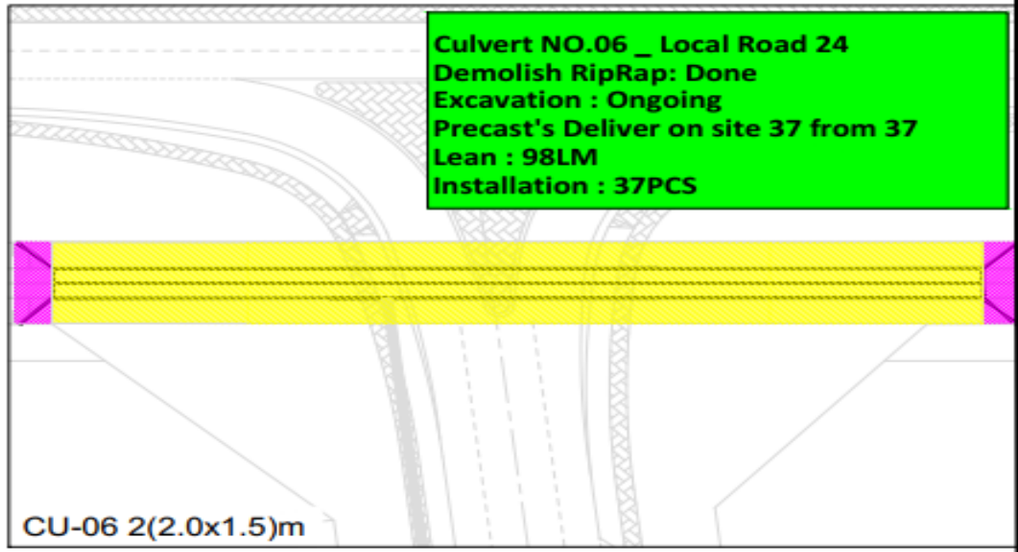

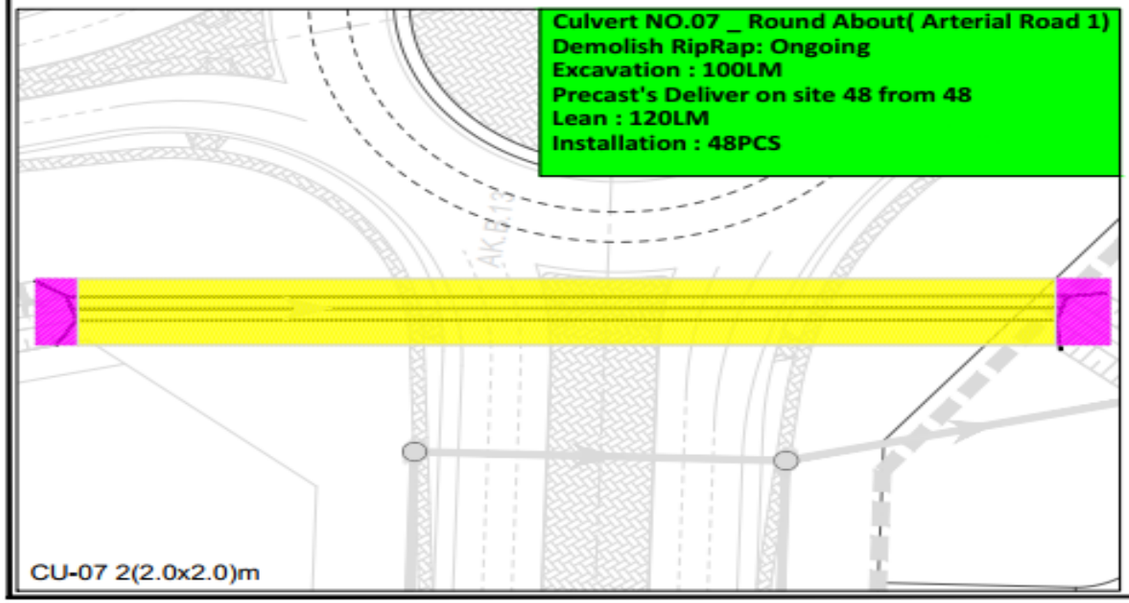



Legend

- Excavation
- Blinding
- Installation
- Backfilling
- Remaining

SCALE (AT) 1:1000 METERS

REFERENCE DRAWINGS

REVISIONS TABLE


PURPOSE OF ISSUE: FOR APPROVAL

Weekly Progress

Culvert Progress

BOX COUNDUIT PROGRESS LAYOUT ZONE-A

ZONE A (BOX CONDUIT)				
ITEM	Total Quantity (LM)	Excuted Quantity (LM)	Remaining Quantity (LM)	Percentage %
Excavation	1500	955.380	544.620	63.69%
Blinding	1500	757.000	743.000	50.47%
Installation	1500	677.000	823.000	45.13%
Backfilling	1500	0.000	1500.000	0.00%

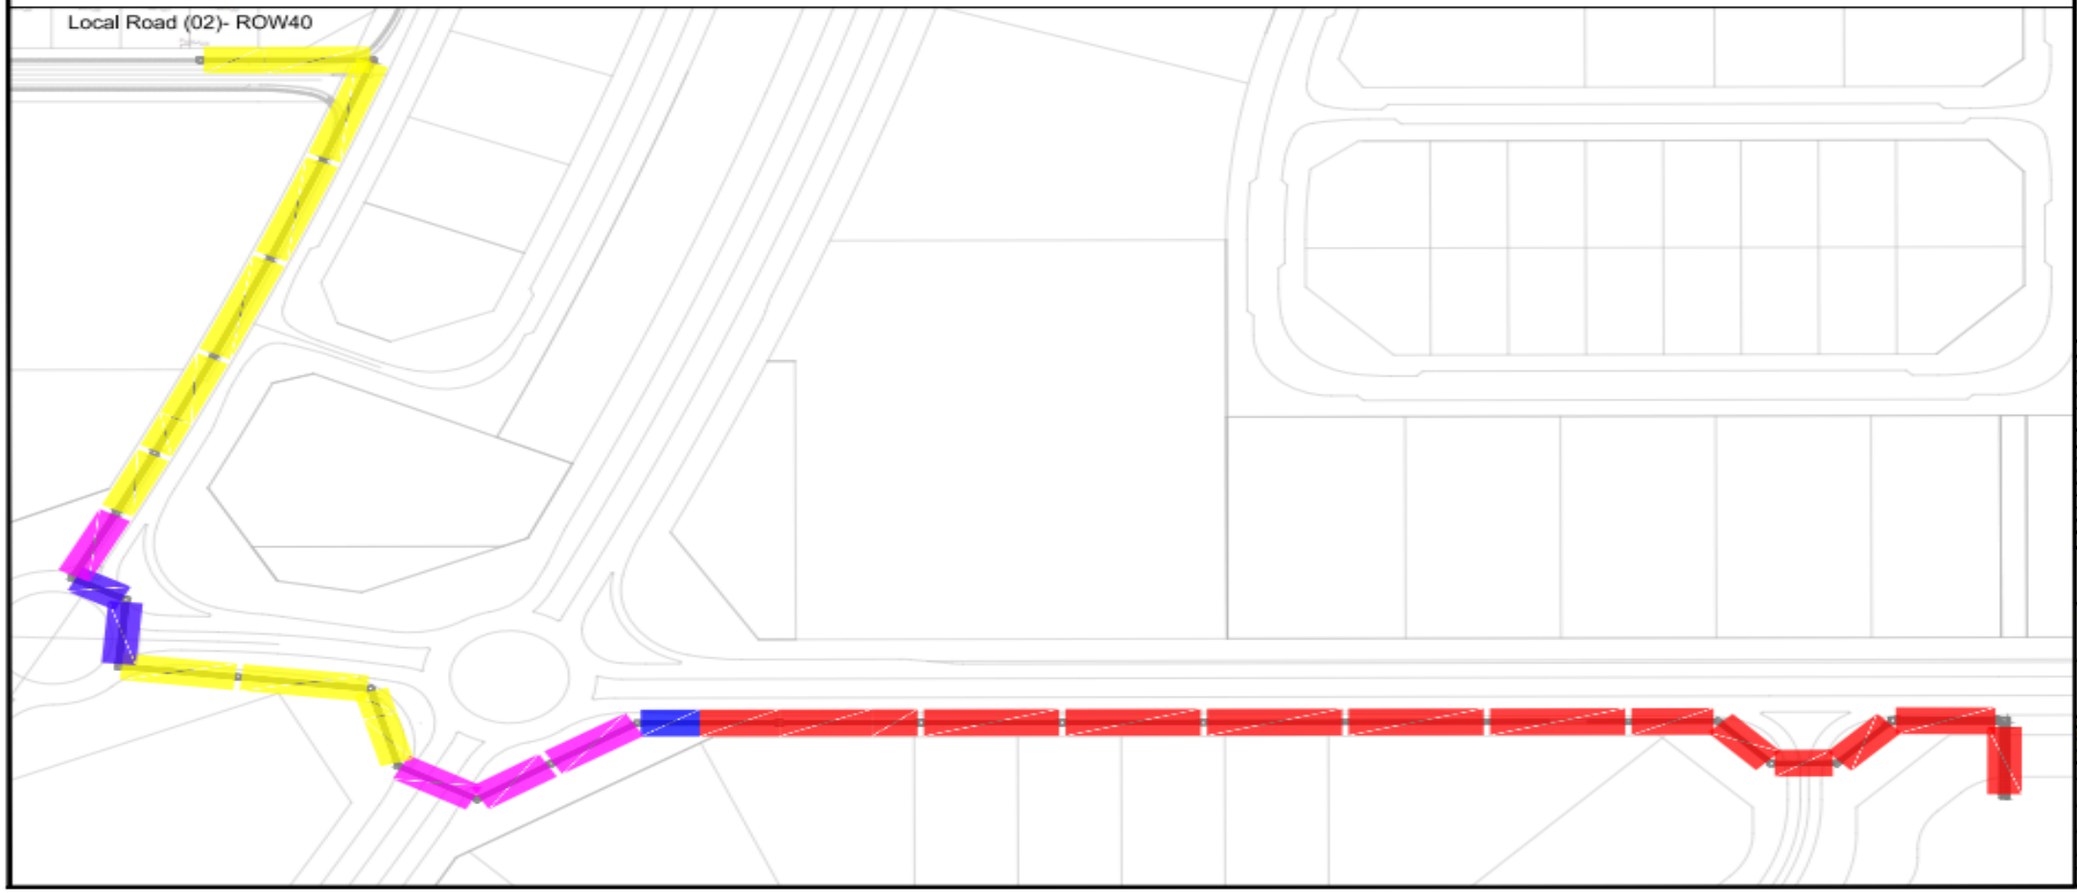

KEY PLAN



Legend

- Excavation
- Blinding
- Installation
- Backfilling
- Remaining

REFERENCE DRAWINGS

REVISIONS TABLE

PURPOSE OF ISSUE: FOR APPROVAL


Box Conduit Layout Plan-Zone A

SCALE

SHEET

STREET LIGHTING POLES PROGRESS LAYOUT ZONE-A

ZONE A Street Lighting (Poles)				
ITEM	Total Quantity (LM)	Excuted Quantity (LM)	Remaining Quantity (LM)	Percentage %
Excavation	509.00	78.000	431.000	15.32%
Base Installation	509.00	56.000	453.000	11.00%
Backfilling	509.00	0.000	509.000	0.00%

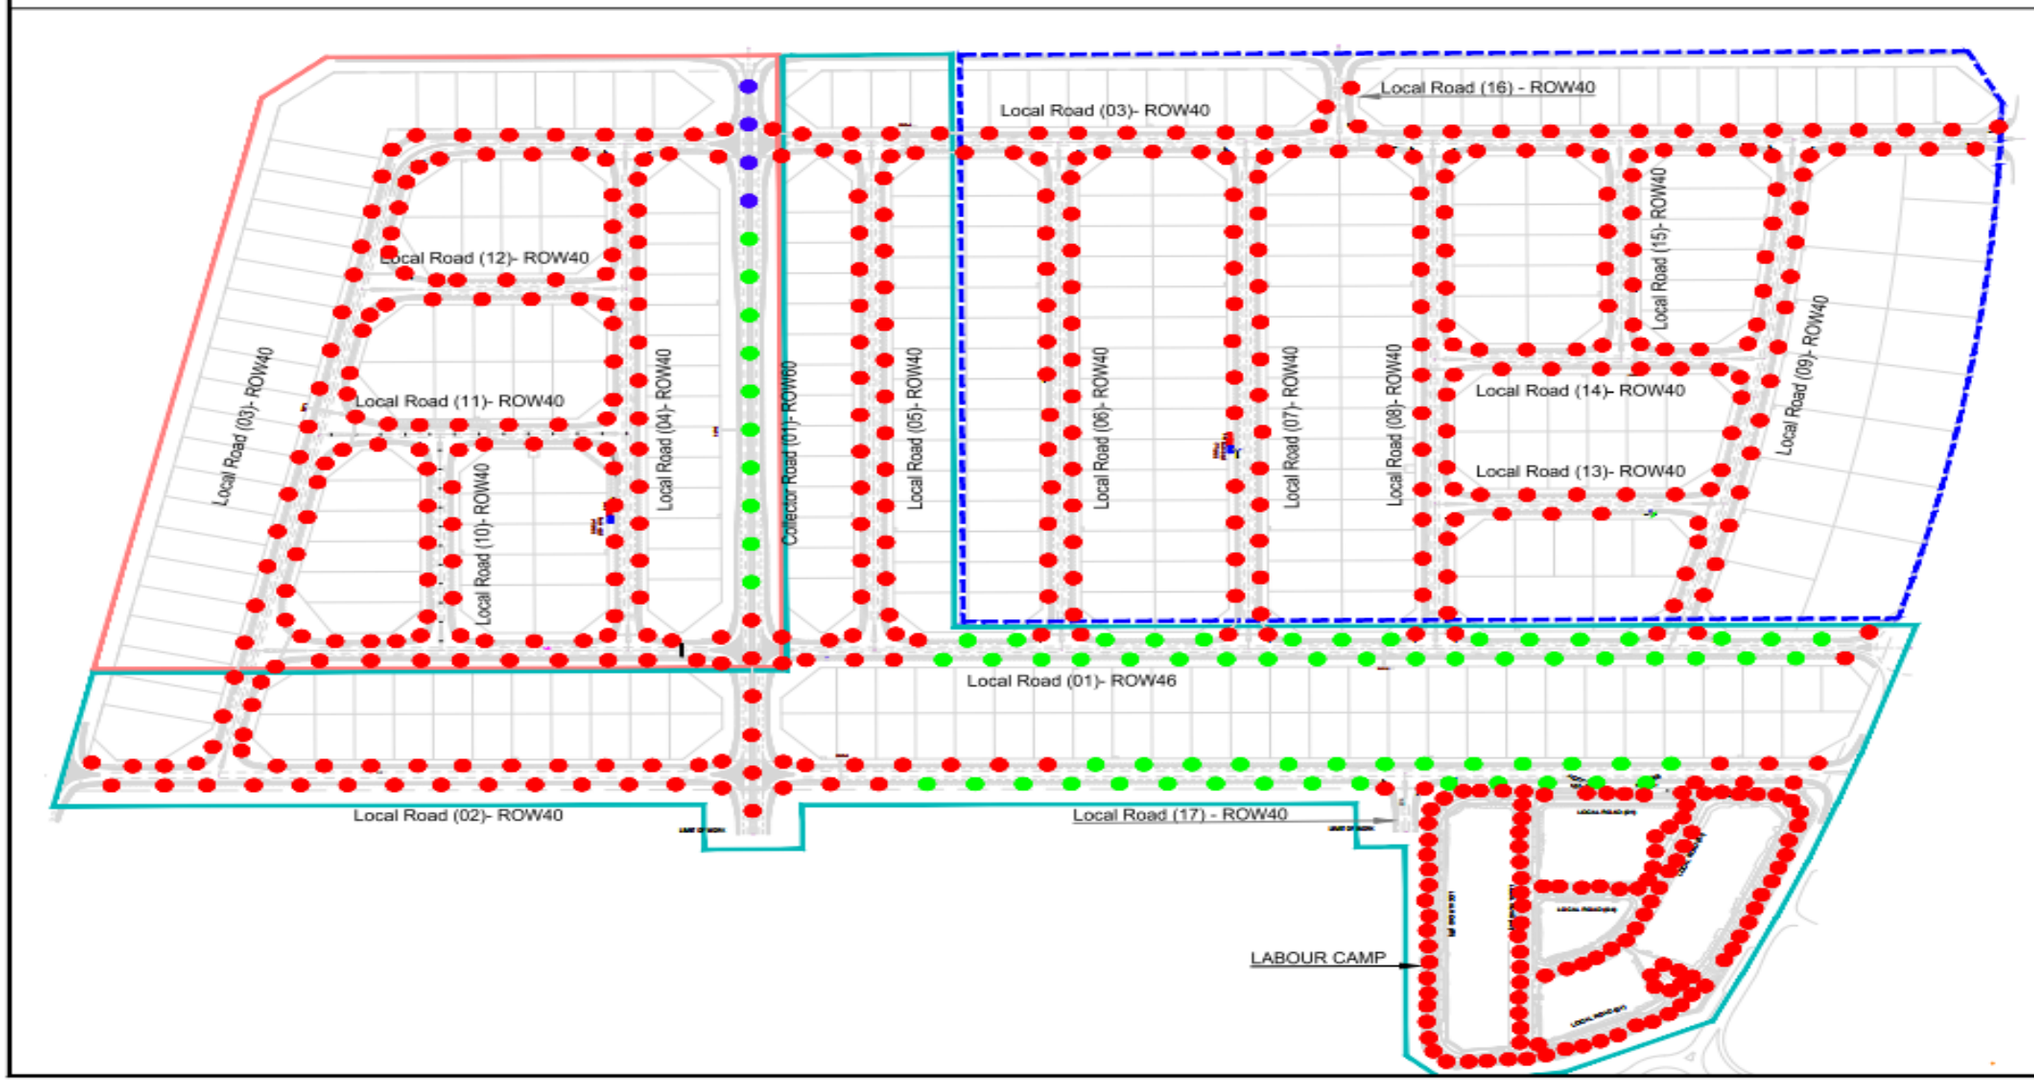

KEY PLAN



Legend

- Excavation
- Base Installation
- Backfilling
- Remaining

Work Area

- Engr.Shamy
- Engr.Mohammed
- Engr.Nivin

REFERENCE DRAWINGS

REVISIONS TABLE

PURPOSE OF ISSUE: FOR APPROVAL

MODON egis MOFARREH GROUP


SEWER NETWORK SYSTEM

STREET LIGHTING POLE PROGRESS LAYOUT ZONE-A


SCALE: 1:10000

STREET LIGHTING POLES PROGRESS LAYOUT ZONE-B

ZONE B Street Lighting (Poles)				
ITEM	Total Quantity (LM)	Excuted Quantity	Remaining Quantity (LM)	Percentage %
Excavation	353.00	94	259	26.63%
Foundation Installation	353.00	66	287	18.81%
Backfilling	353.00	66	287	18.70%

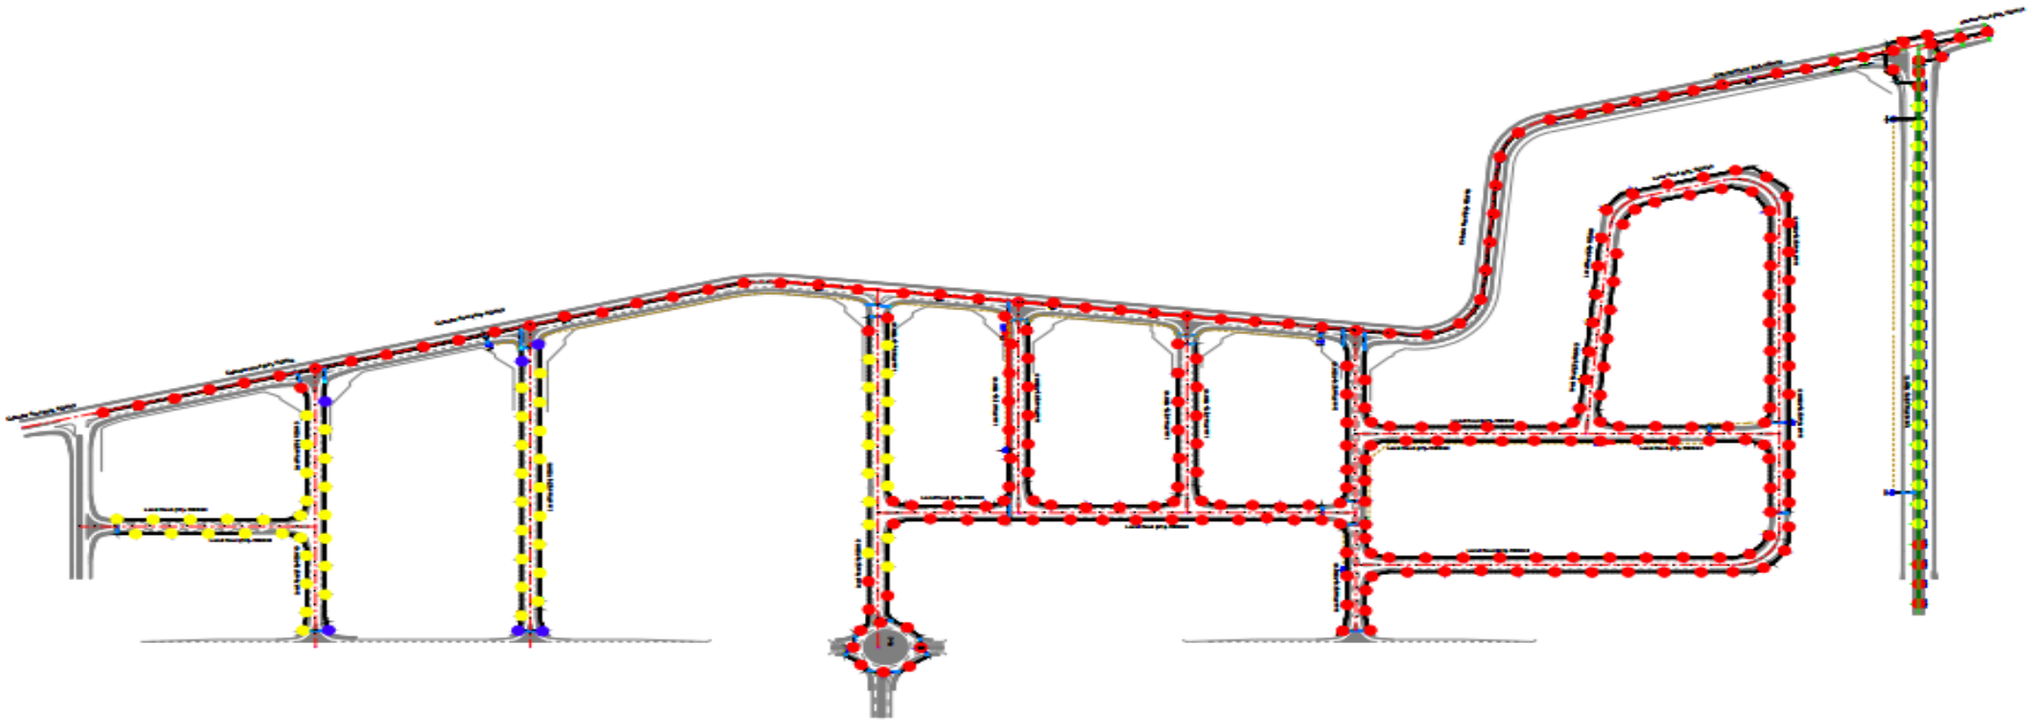

KEY PLAN

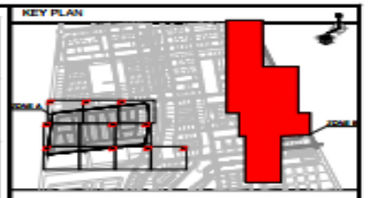

Legend

Excavation

Foundation Installation

Backfilling

Remaining

Work Area

Eng.Bestawi

Eng.Salem

REFERENCE DRAWINGS

REVISIONS TABLE

PURPOSE OF ISSUE: FOR APPROVAL

ELECTRICAL NETWORK SYSTEM


STREET LIGHTING NETWORK LAYOUT ZONE-B

SCALE

SHEET

STREET LIGHTING CABLE PROGRESS LAYOUT ZONE-A

ZONE A (STREET LIGHT NETWORK) CABLE				
ITEM	Total Quantity (LM)	Excuted Quantity (LM)	Remaining Quantity (LM)	Percentage %
Excavation	26093.42	1830.980	24262.435	7.02%
Bedding	26093.42	1830.980	24262.435	7.02%
Installation	26093.42	1830.980	24262.435	7.02%
Backfilling	26093.42	1830.980	24262.435	7.02%

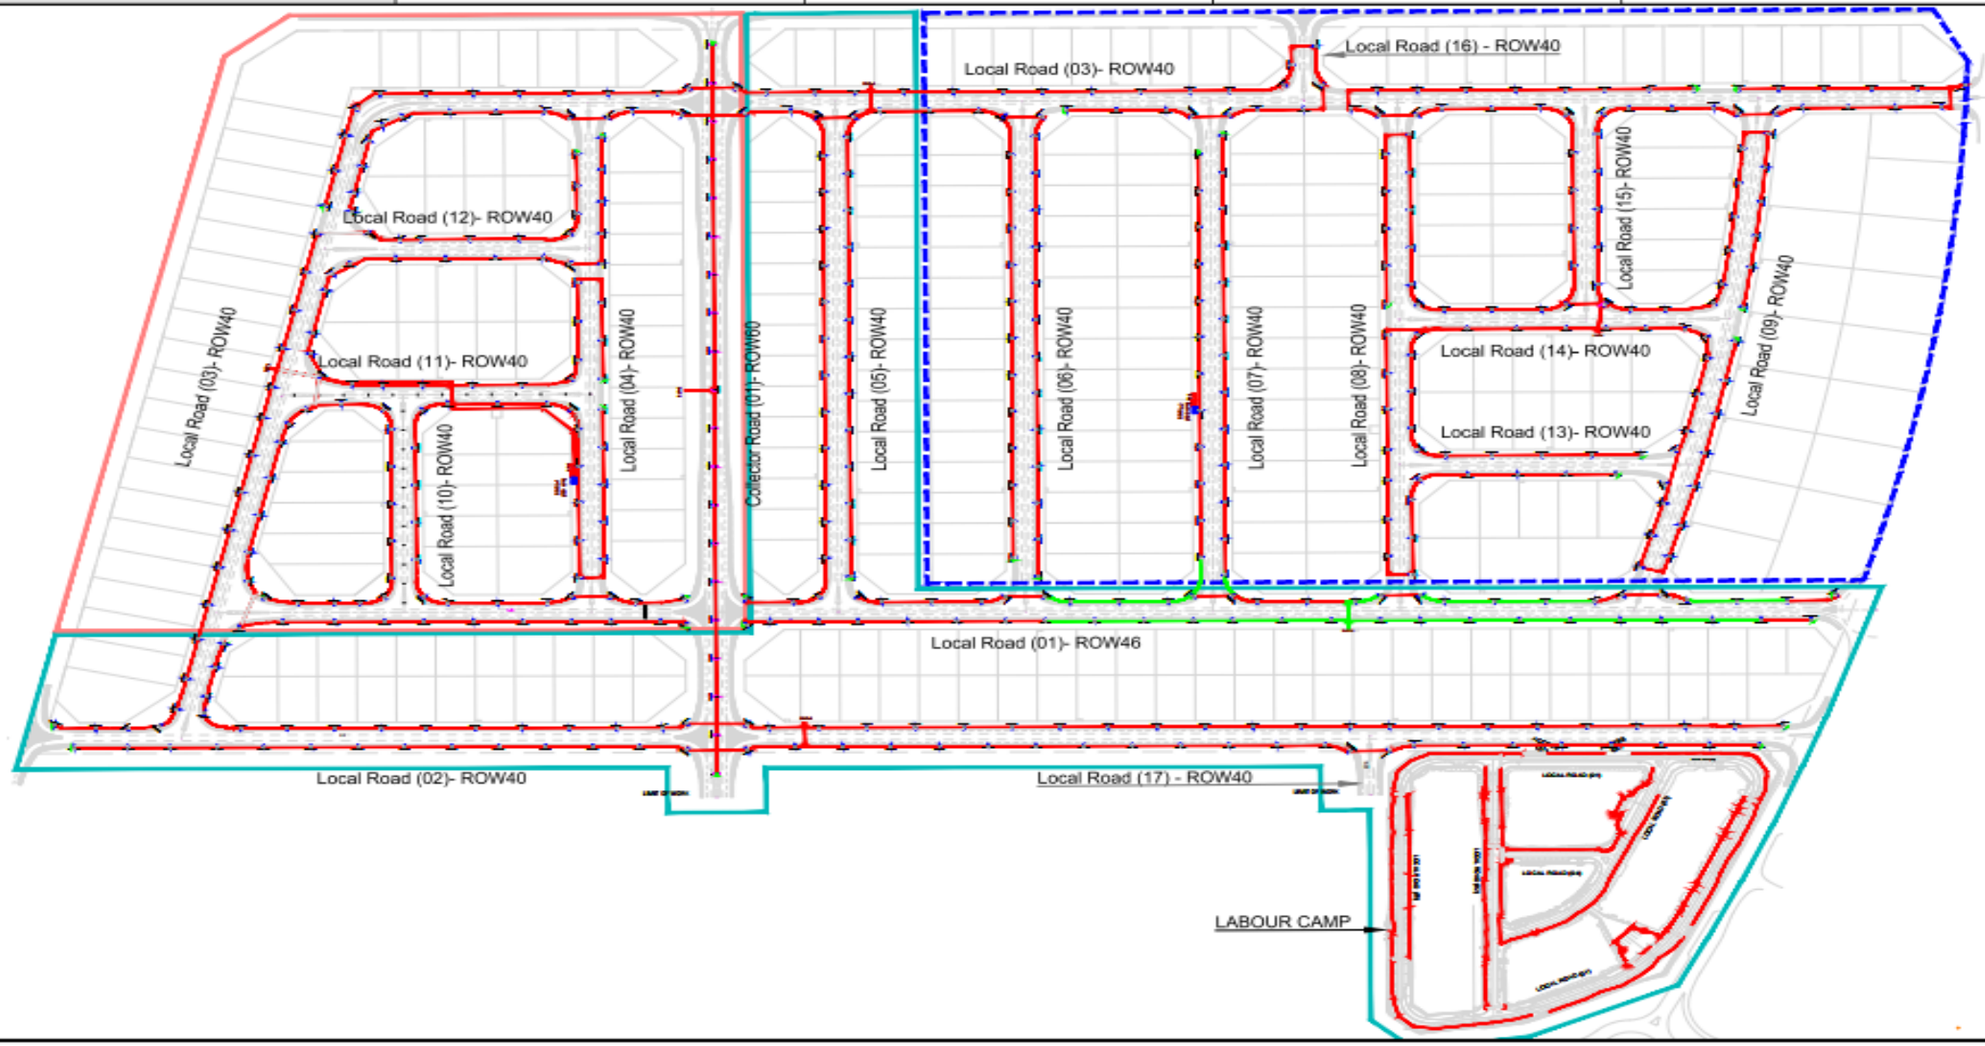



Legend

- Excavation
- Sand Bedding
- Installation
- Backfilling
- Remaining

Work Area

- Engr.Shamy
- Engr.Mohammed
- Engr.Nivin

REFERENCE DRAWINGS

REVISIONS TABLE

PURPOSE OF ISSUE: FOR APPROVAL


MODON egis MOFARREH GROUP

STREET LIGHTING CABLE PROGRESS LAYOUT ZONE-A

SCALE

STREET LIGHTING CABLE PROGRESS LAYOUT ZONE-B

ZONE B (STREET LIGHT NETWORK) CABLE				
ITEM	Total Quantity (LM)	Excuted Quantity (LM)	Remaining Quantity (LM)	Percentage %
Excavation	18,276.50	1631.508	16644.995	8.93%
Bedding	18,276.50	1631.508	16644.995	8.93%
Installation	18,276.50	1631.508	16644.995	8.93%
Backfilling	18,276.50	1631.508	16644.995	8.93%

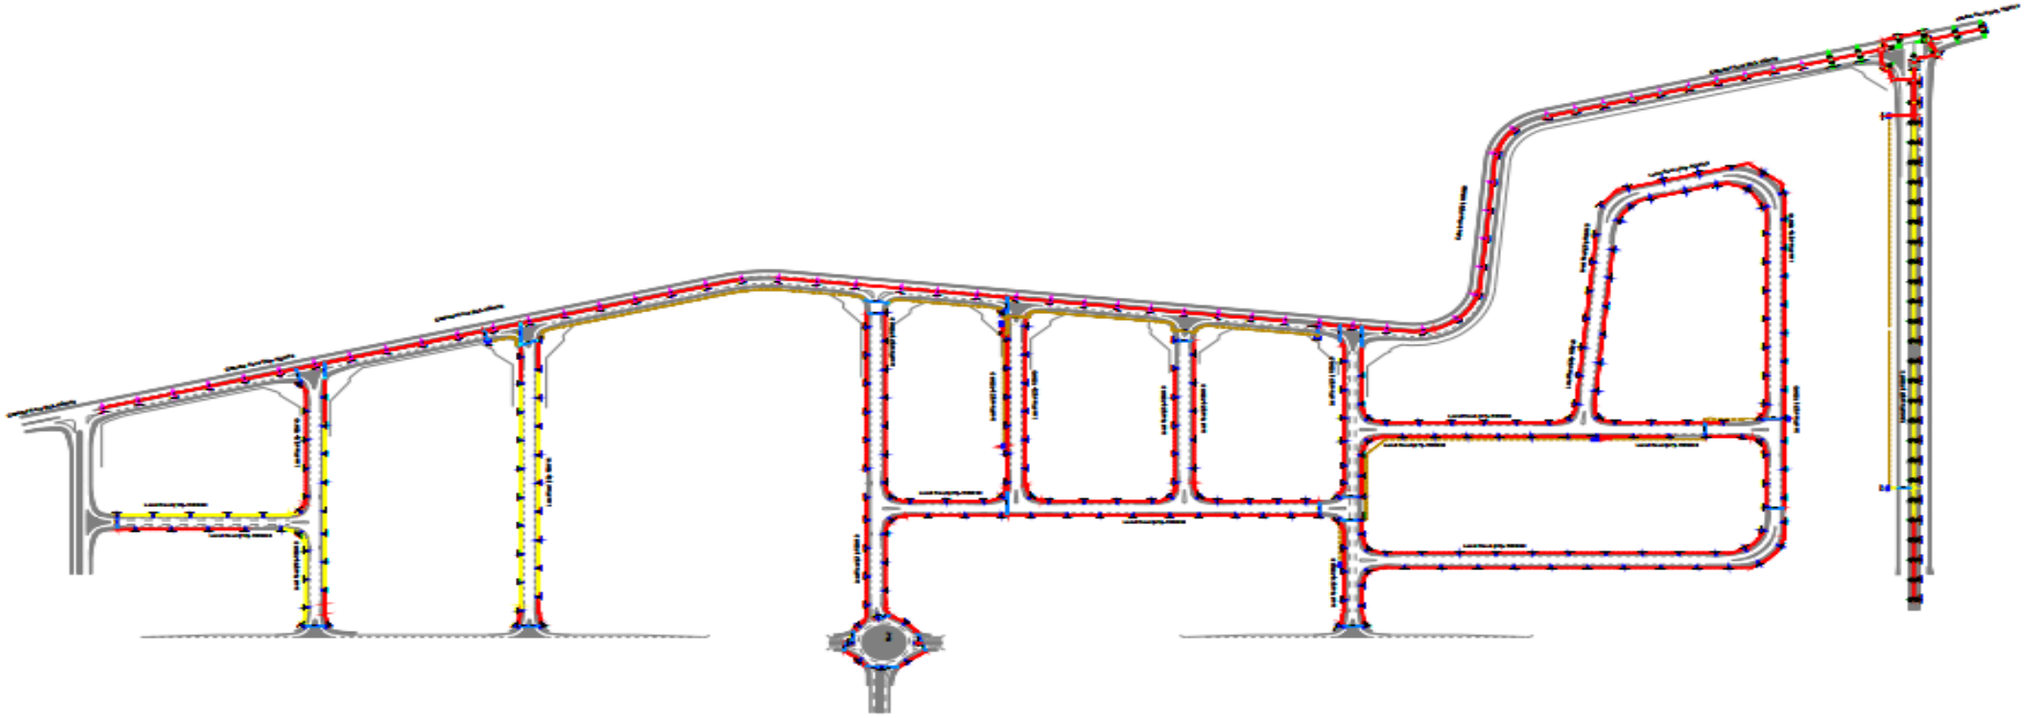

KEY PLAN



Legend

Excavation

Foundation Installation

Backfilling

Remaining

REFERENCE DRAWINGS

REVISIONS TABLE

PURPOSE OF ISSUE: FOR APPROVAL

ELECTRICAL NETWORK SYSTEM


STREET LIGHTING NETWORK LAYOUT ZONE-B

SCALE

SHEET

MV NETWORK PROGRESS LAYOUT ZONE-A

ZONE A (MV NETWORK) CABLE				
ITEM	**Total Quantity (LM)**	**Excuted Quantity (LM)**	**Remaining Quantity (LM)**	**Percentage %**
Excavation	**27225.00**	**3065.556**	**24159.444**	**11.26%**
Bedding	**27225.00**	**3065.556**	**24159.444**	**11.26%**
Installation	**27225.00**	**3065.556**	**24159.444**	**11.26%**
Backfilling	**27225.00**	**0.000**	**27225.000**	**0.00%**

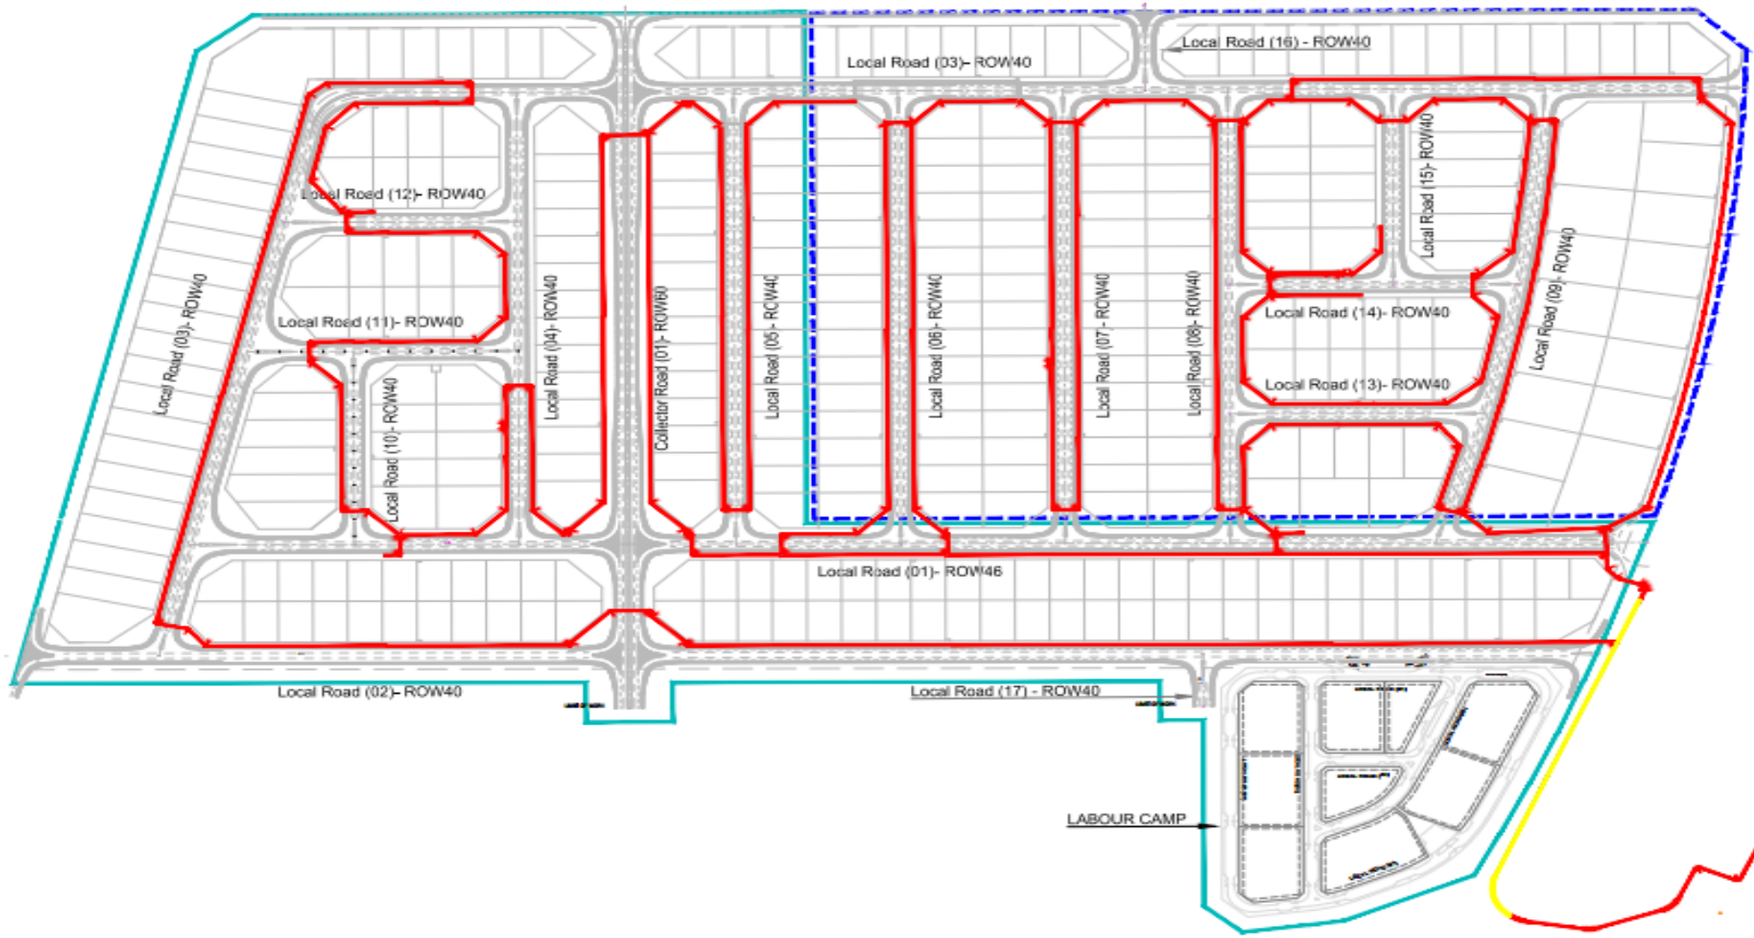

KEY PLAN



Legend

- Excavation
- Sand Bedding
- Cable Installation
- Backfilling
- Remaining

Work Area

- Engr.Shamy
- Engr.Mohammed

REFERENCE DRAWINGS

REVISIONS TABLE

PURPOSE OF ISSUE: FOR APPROVAL

MODON مدن

egis


MOFARREH GROUP مجموعة مفرّح ENGINEERING & CONSTRUCTION

MV PROGRESS LAYOUT ZONE-A

SCALE 1:3000

MV NETWORK PROGRESS LAYOUT ZONE-B

ZONE B (MV NETWORK) CABLE				
ITEM	Total Quantity (LM)	Excuted Quantity	Remaining Quantity (LM)	Percentage %
Excavation	44775.21	21024.040	23751.170	46.95%
Bedding	44775.21	21024.040	23751.170	46.95%
Installation	44775.21	21024.040	23751.170	46.95%
Backfilling	44775.21	0.000	44775.210	0.00%

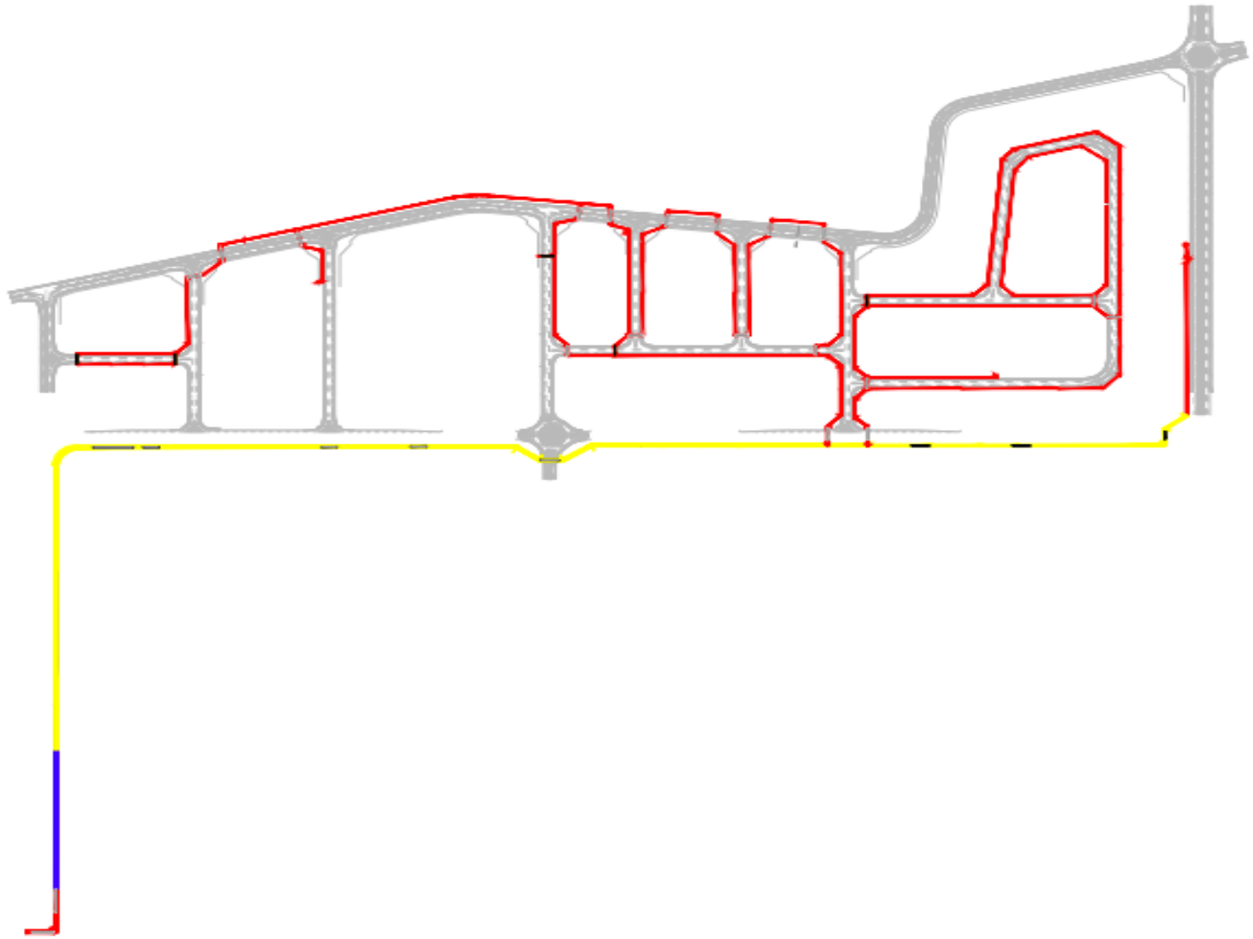

KEY PLAN



Excavation

Installation

Backfilling

Remaining

Work Area

Eng.Bestawi

Eng.Salem

0 10 20 30 40 50 100 METERS

SCALE (A1) 1:1000

REFERENCE DRAWINGS

REVISIONS TABLE

PURPOSE OF ISSUE: FOR APPROVAL

MODON

egis

MOFARREH GROUP


Weekly Progress

MV NETWORK LAYOUT-ZONE B

SCALE 1:1000

TELECOM NETWORK PROGRESS LAYOUT ZONE-A

ZONE A (TEL NETWORK) PROGRESS				
ITEM	Total Quantity (LM)	Excuted Quantity (LM)	Remaining Quantity (LM)	Percentage %
Excavation	155000.00	0.000	155000.000	0.00%
Bedding	155000.00	0.000	155000.000	0.00%
Installation	155000.00	0.000	155000.000	0.00%
Backfilling	155000.00	0.000	155000.000	0.00%

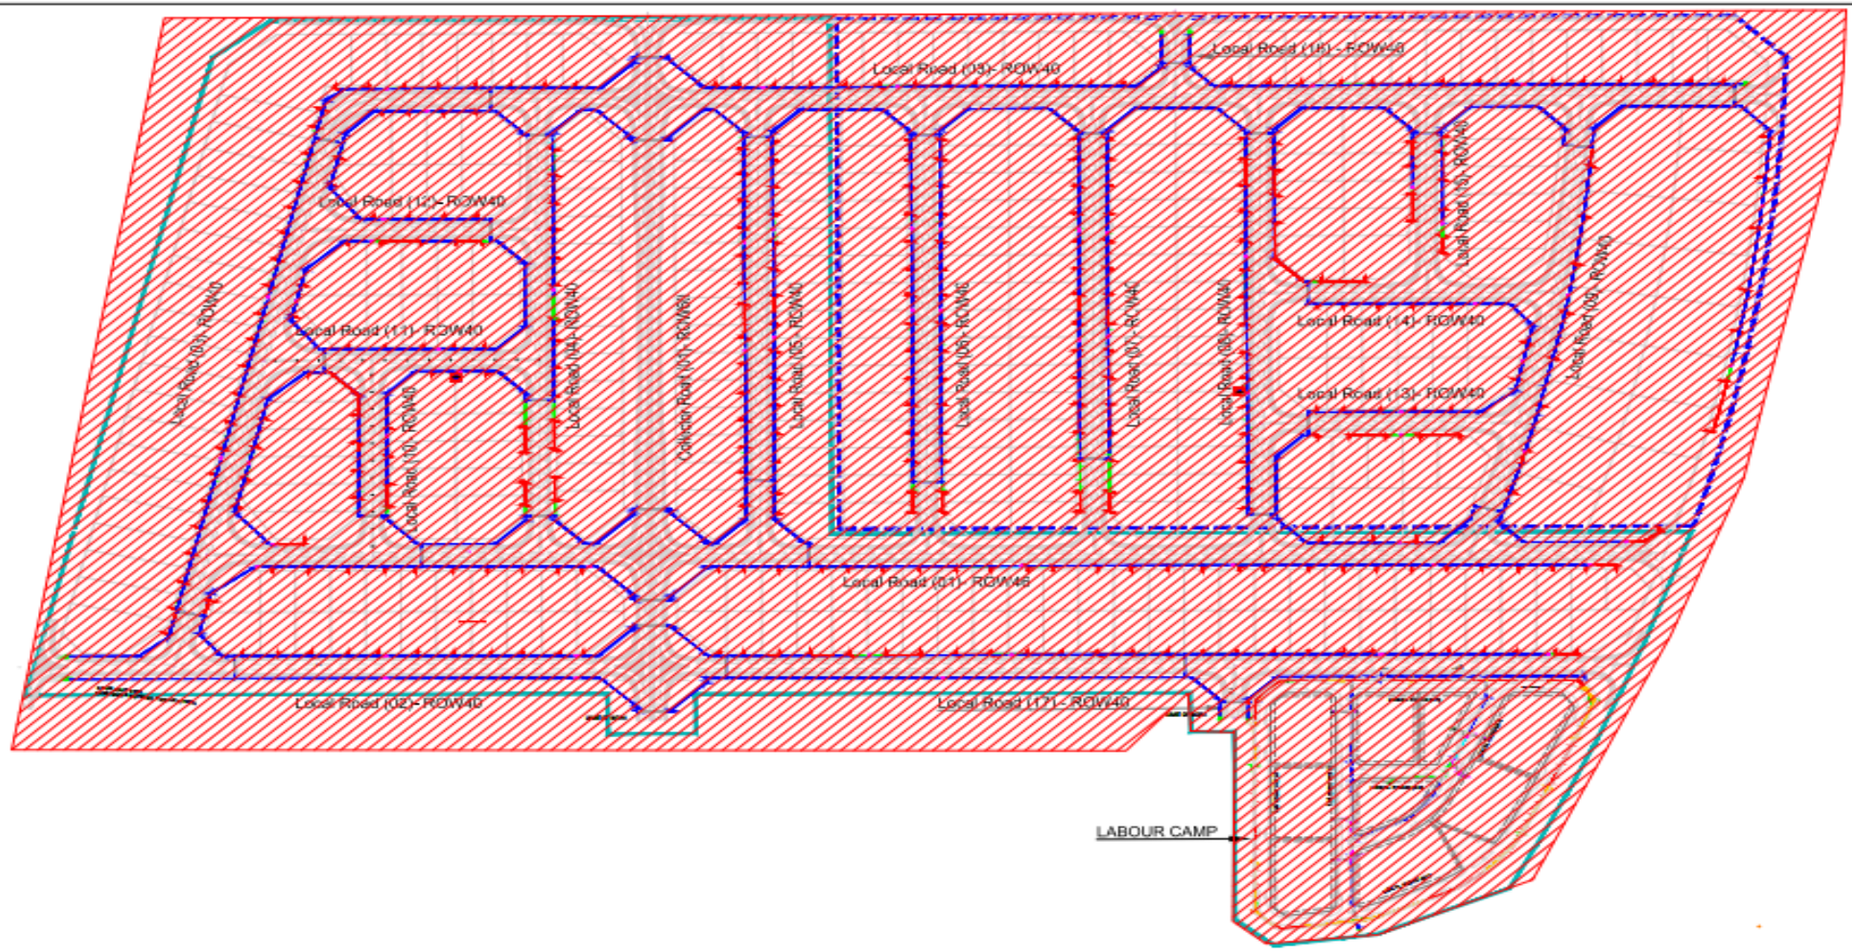



Legend

- Excavation
- Base Installation
- Backfilling
- Remaining

Work Area

- Engr.Shamy
- Engr.Mohammed

REFERENCE DRAWINGS

REVISIONS TABLE

PURPOSE OF ISSUE: FOR APPROVAL

MODON

egis


MOFARREH GROUP

TELECOM PROGRESS LAYOUT ZONE-A

SCALE 1 : 2000

TELECOM NETWORK PROGRESS LAYOUT ZONE-B

ZONE B (TEL NETWORK) PROGRESS				
ITEM	Total Quantity (LM)	Excuted Quantity	Remaining Quantity (LM)	Percentage %
Excavation	102000.00	830.000	101170.000	0.81%
Bedding	102000.00	415.000	101585.000	0.41%
Installation	102000.00	415.000	101585.000	0.41%
Backfilling	102000.00	0.000	102000.000	0.00%

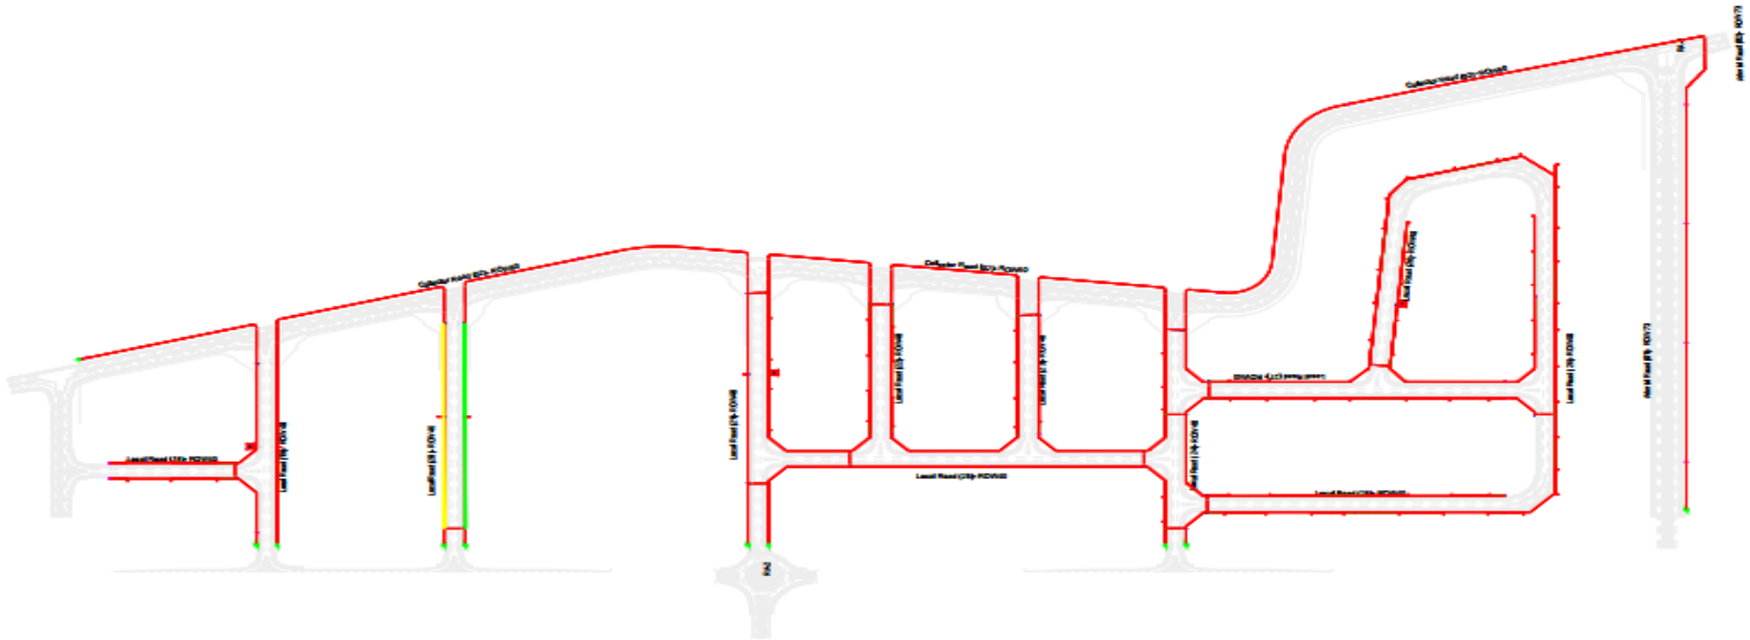

KEY PLAN



Legend

- Excavation
- Bedding
- Installation
- Backfilling
- Remaining

REFERENCE DRAWINGS

REVISIONS TABLE

PURPOSE OF ISSUE: FOR APPROVAL

MODON

egis

MOFARREH GROUP

TELECOM NETWORK SYSTEM

TELECOM NETWORK LAYOUT ZONE B

SCALE

CULVERT PROGRESS-ZONE B

Culverts Statue.						
SN	Culverts Name	Statue.	Recivied Date	Qauntity By Earth Work	Total	Notes
1	Culvert 01	Cut	4/15/2026	164.637		m3
2	Culvert 02	Cut	4/15/2026	184.568		m3
3	Culvert 03	Cut	4/15/2026	116.856		m3
4	Culvert 04	Cut	4/15/2026	176.791	1962.752	m3
5	Culvert 05	Cut	4/15/2026	140.752		m3
6	Culvert 06	Cut	4/15/2026	198.241		m3
7	Culvert 07	Cut	4/15/2026	980.907		m3


Page 1

Culverts Statue.						
SN	Culverts Name	Statue.	Recivied Date	Qauntity By Earth Work	Total	Notes
8	Culvert 01	Demolition	4/15/2026	1644.9		m2
9	Culvert 02	Demolition	4/15/2026	1003.24		m2
10	Culvert 03	Demolition	4/15/2026	2148.6		m2
11	Culvert 04	Demolition	4/15/2026	2353.1	12680.14	m2
12	Culvert 05	Demolition	4/15/2026	2365.18		m2
13	Culvert 06	Demolition	4/15/2026	2286.37		m2
14	Culvert 07	Demolition	4/15/2026	878.75		m2


Page 1

SN	Culverts Name	Statue.	Total Qauntity (m3)	Ex . Qauntity (m3)	Notes
1	Culvert 01	Lean Concrete	50.08202	49.0	Volume Body
2	Culvert 02	Lean Concrete	65.83282	65.9	Volume Body
3	Culvert 03	Lean Concrete	63.37282	62.292	Volume Body
4	Culvert 04	Lean Concrete	76.88832	68.986	Volume Body
5	Culvert 05	Lean Concrete	76.88902	35.711	Volume Body
6	Culvert 06	Lean Concrete	78.96442		
7	Culvert 07	Lean Concrete	96.59872		

MOSQUE PROGRESS LAYOUT

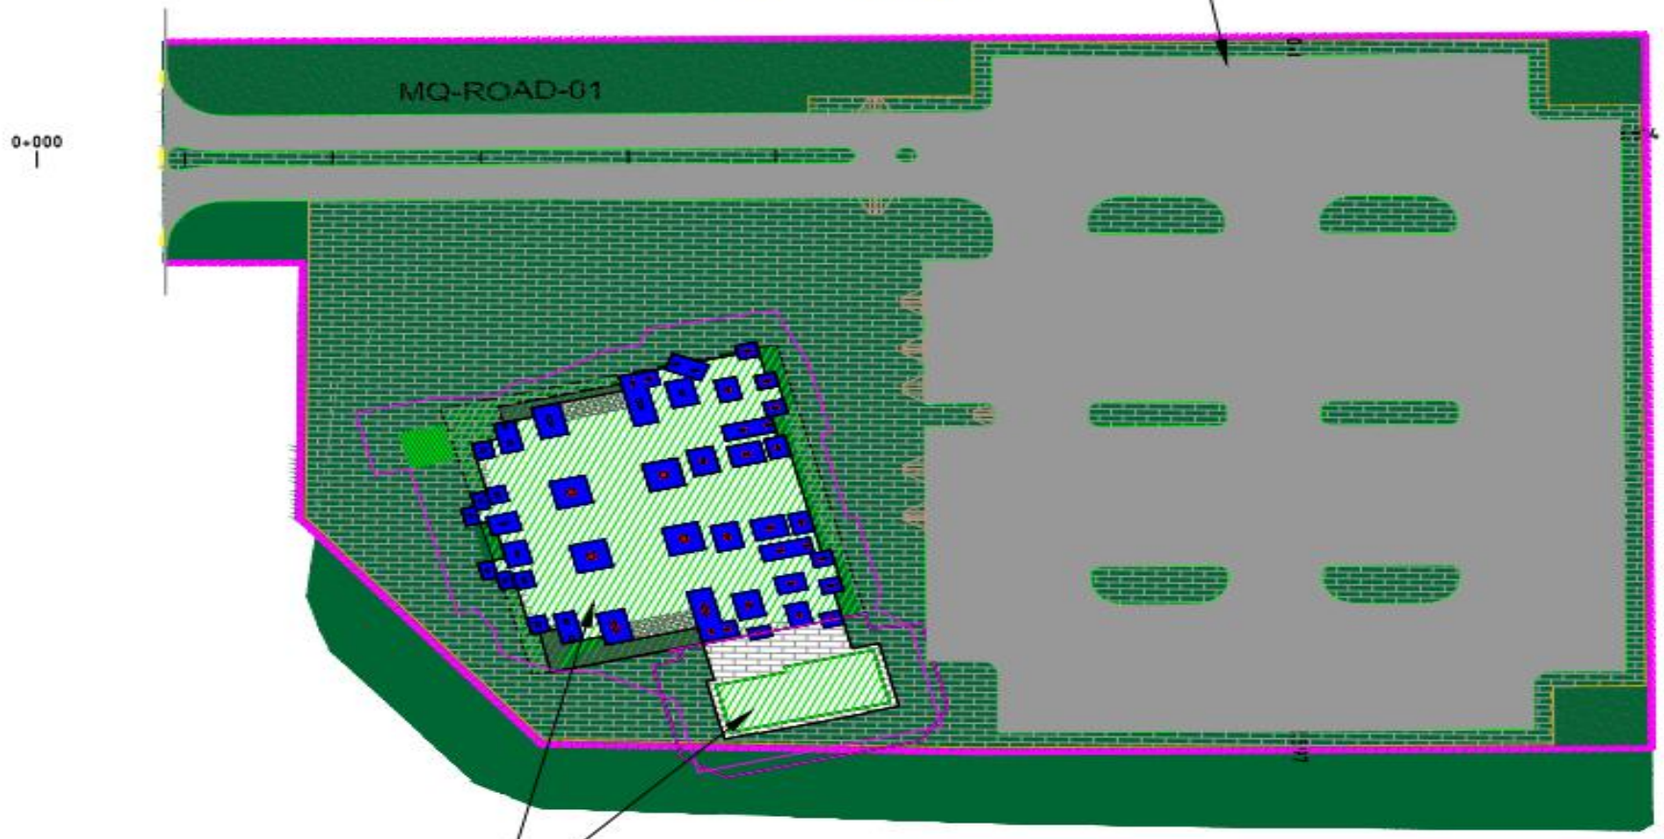

KEY PLAN

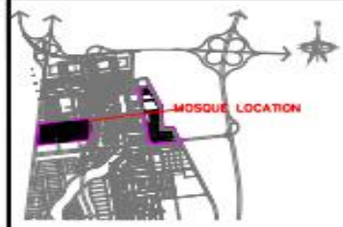

NOTES:

1. COORDINATES SYSTEM IS BASED ON UTM - WGS84-ZONE 38N
2. ALL LEVELS ARE IN METERS AND DIMENSIONS ARE IN METRES UNLESS STATED OTHERWISE.

LEGENDS

MOSQUE AREA WORK

1. PC FOUNDATION (DONE)
2. RC FOUNDATION (DONE)
3. BACK FILL FOUNDATION DONE
4. COLUMN NECK DONE
5. GRADE BEAM DONE
6. COLUMN STEEL ON GOING

BATH ROOM AREA WORK

1. PC FOUNDATION (DONE)
2. RC FOUNDATION (DONE)
3. BACK FILL FOUNDATION DONE
4. COLUMN (DONE)
5. GRADE BEAM (DONE)
6. SLAB AND BEAM (DONE)

Earth Work

REFERENCE DRAWINGS

REVISIONS TABLE

PURPOSE OF ISSUE: FOR APPROVAL

MODON egis MOFARREH GROUP

MODON - UPDATED CONCEPT MASTER PLAN AND INFRASTRUCTURE DESIGNS FOR AL-KHOBAR INDUSTRIAL CITY


MOSQUE LAYOUT PLAN

TRANSPORTATION

SCALE

SHEET

PORTA CABIN LAYOUT

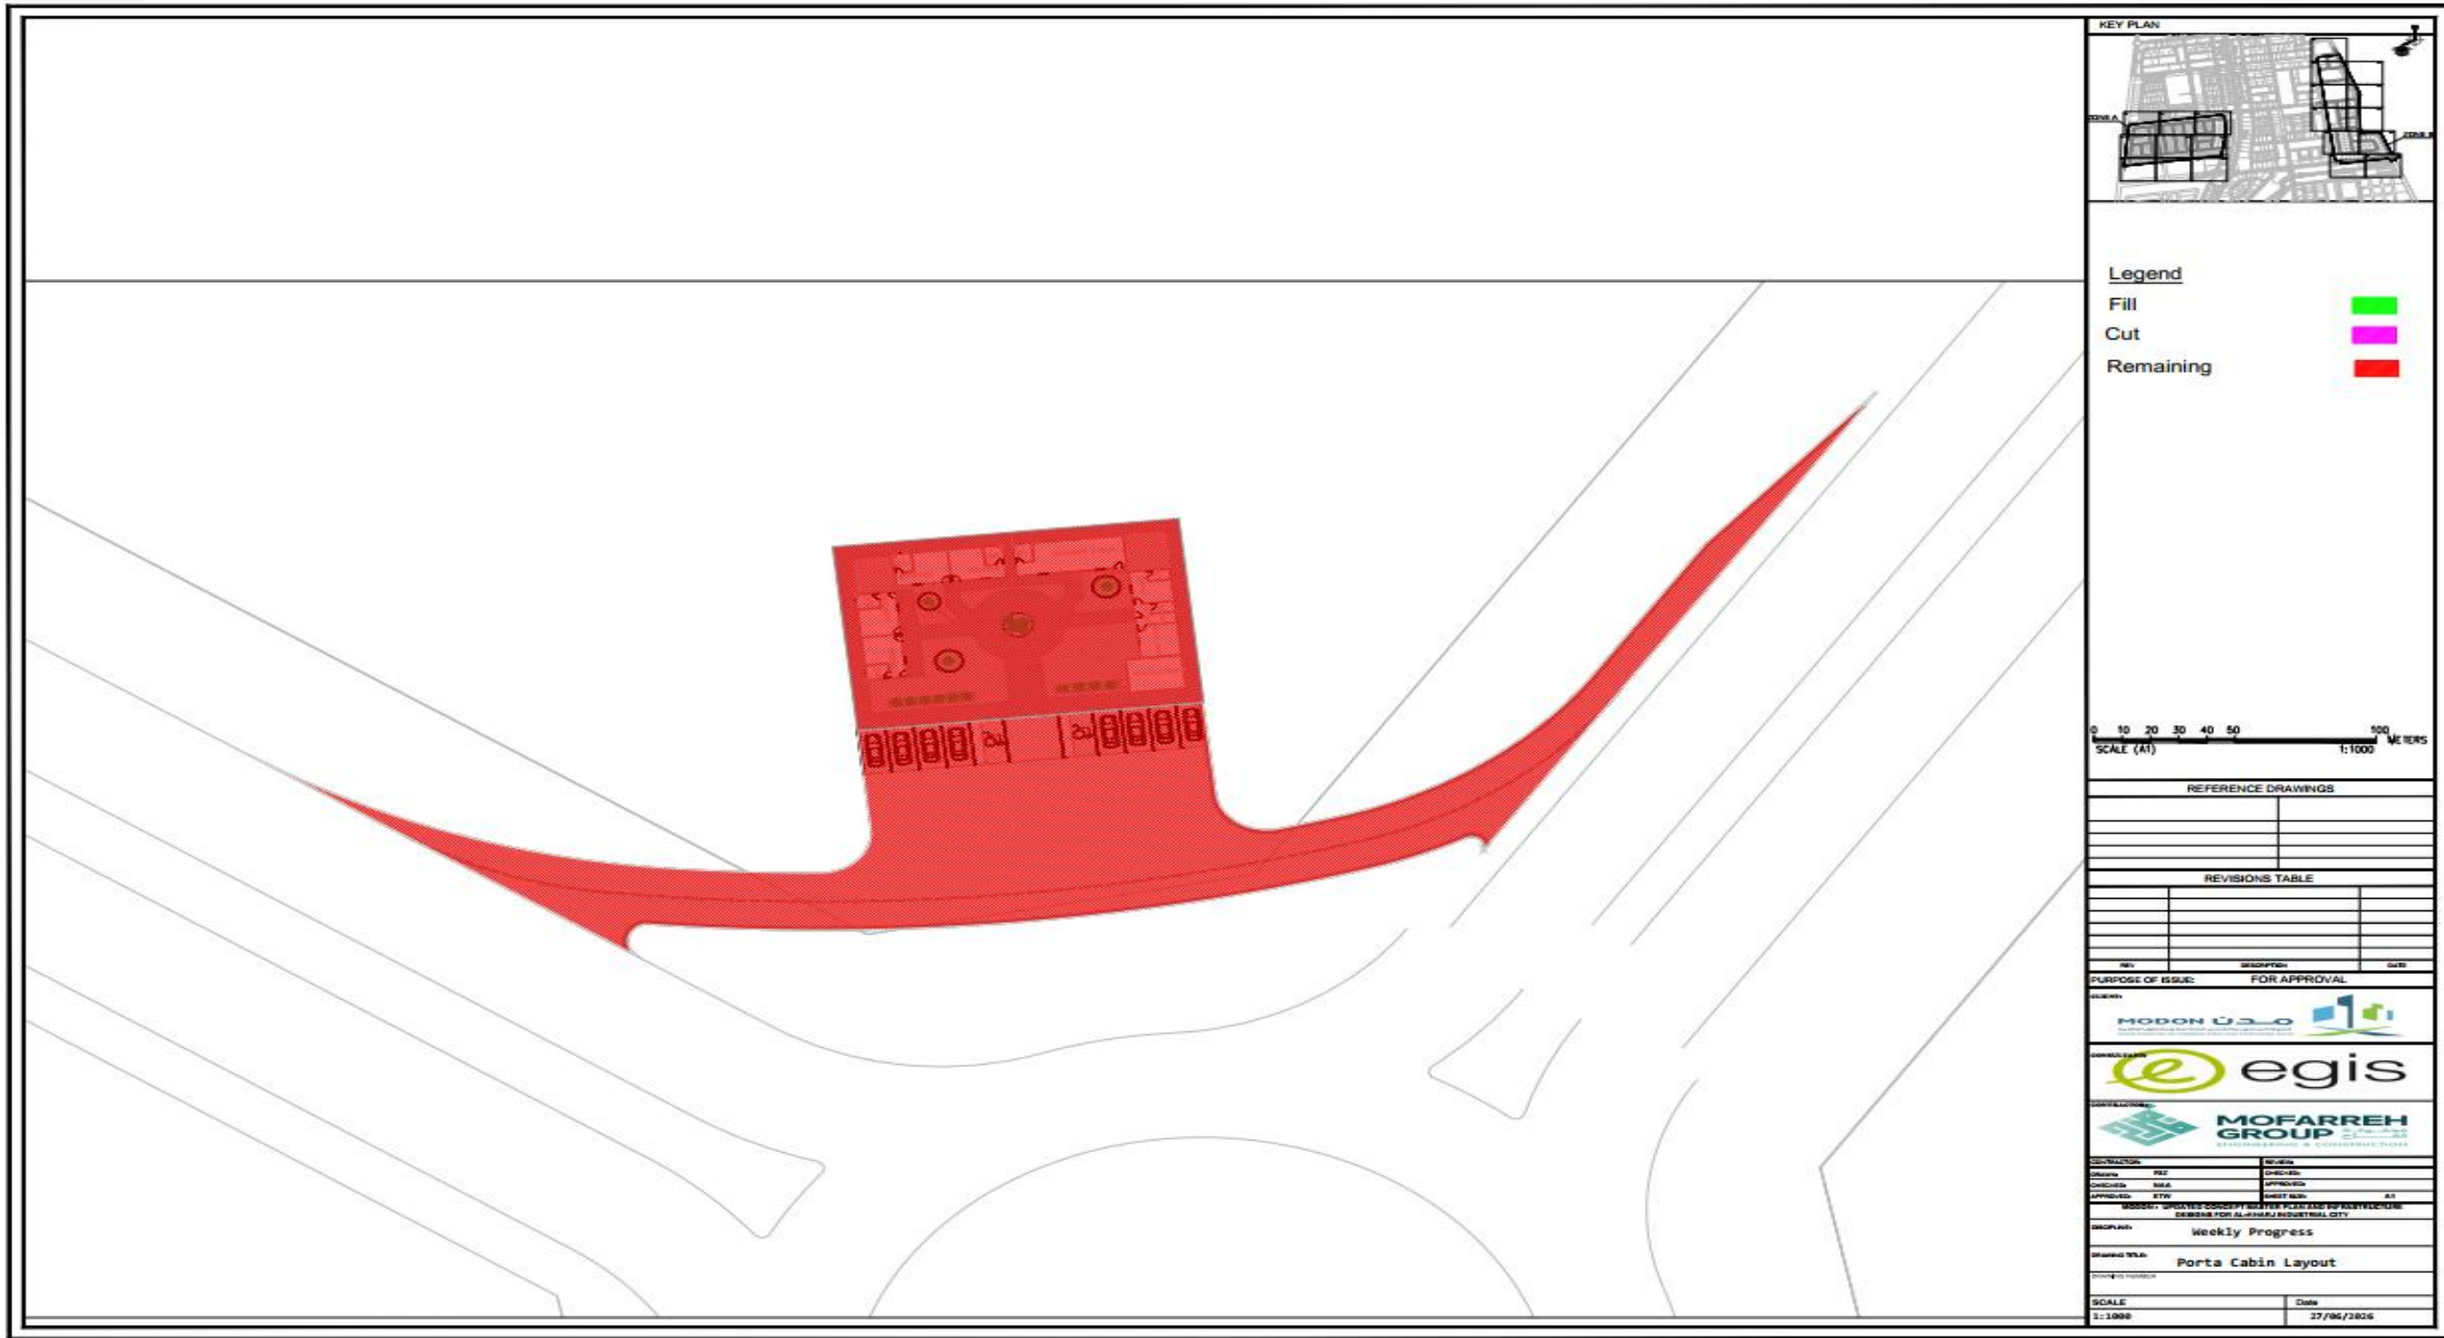

REHABLITATION ROAD LAYOUT -FACTORY AREA



MATERIAL PROGRESS SHEET

Potable Network materials status							
SR	MATERIAL	UNIT	TOTAL QTY	DELIVERED	% DELIVERED	REMAINING QTY	% REMIAINING
1	HDPE PIPE DIA 160 mm	L.M	9,565.00	7,587.00	79.32%	1978	20.68%
2	HDPE PIPE DIA 200 mm	L.M	11,490.00	9,396.00	81.78%	2094	18.22%
3	HDPE PIPE DIA 250 mm	L.M	8,764.00	8,052.00	91.88%	712	8.12%
4	HDPE PIPE DIA 315 mm	L.M	372.00	372.00	100.00%	0	0.00%
5	HDPE PIPE DIA 355 mm	L.M	72.00	72.00	100.00%	0	0.00%
6	DI VALVES	EA	306.00	213.00	69.61%	93	100.00%
7	Fire hydrant	EA	310.00	82.00	26.45%	228	200.00%
TSE Network materials status							
SR	MATERIAL	UNIT	TOTAL QTY	DELIVERED	% DELIVERED	REMAINING QTY	% REMIAINING
1	HDPE PIPE DIA 110 mm	L.M	27,889.00	27,756.00	99.52%	133	0.48%
2	HDPE PIPE DIA 160 mm	L.M	357.00	0.00	0.00%	357	100.00%
3	DI VALVES	EA	211.00	50.00	23.70%	161	76.30%
Secondary Irrigation Network materials status							
SR	MATERIAL	UNIT	TOTAL QTY	DELIVERED	% DELIVERED	REMAINING QTY	% REMIAINING
1	HDPE PIPE DIA 90 mm	L.M	1,126.00	900.00	79.93%	226.00	0.20
2	HDPE PIPE DIA 75 mm	L.M	247.00	0.00	0.00%	247.00	1.00
3	HDPE PIPE DIA 63 mm	L.M	1,254.00	0.00	0.00%	1,254.00	100.00%
4	HDPE PIPE DIA 50 mm	L.M	10,859.00	0.00	0.00%	10,859.00	100.00%
5	HDPE PIPE DIA 32 mm	L.M	37,259.00	0.00	0.00%	37,259.00	100.00%
6	UPVC PIPE 32 MM	L.M	27,800.00	24,684.00	88.79%	3,116.00	11.21%
Telecom Network materials status							
SR	MATERIAL	UNIT	TOTAL QTY	DELIVERED	% DELIVERED	REMAINING QTY	% REMIAINING
1	HDPE PIPE DIA 50 mm	L.M	224,688.00	209,792.00	93.37%	14896	6.63%
2	HDPE PIPE DIA 32 mm	L.M	66,692.00	66,962.00	100.40%	-270	-0.40%
3	HDPE PIPE DIA 16 mm	L.M	900.00	900.00	100.00%	0	0.00%
Electrical Network materials status							
SR	MATERIAL	UNIT	TOTAL QTY	DELIVERED	% DELIVERED	REMAINING QTY	% REMIAINING
1	UPVC PIPE DIA 150 mm	L.M	9,643.00	9,643.00	100.00%	0	0.00%
2	HDPE PIPE DIA 110 mm	L.M	66,692.00	0.00	0.00%	66692	100.00%
3	HDPE PIPE DIA 16 mm	L.M	900.00	0.00	0.00%	900	100.00%
4	UPVC PIPE 110 MM	L.M	4800	4,800.00	100.00%	0	0.00%
5	MV cable (3CX500mm²)	L.M	72000	40,500.00	56.25%	31500	43.75%
6	Foundation for Street Light Poles	EA	981	680.00	69.32%	301	30.68%
5	LV cable (4CX16mm²+4CX95mm²)	L.M	51082	9,800.00	19.18%	41282	80.82%

ENGINEERING STATUS

Shop Drawings Status

24/09/2026

Row Labels	A	B	C	D	UR	Grand Submitted Total	Total Required shd	Remainig	Req. As built	Actual remaing Remarks
ARC	38	37	0	0	0	75	75	0	75	DONE
CBC	50	23	0	0	0	73	73	0	73	DONE
CIV	3	5	0	0	0	8	8	0	8	DONE
ELE	29	45	0	0	8	82	82	0	82	DONE
MV	0	40	0	0	0	40	40	0	40	SUBMITTED TO EGIS For Information
HVA	0	9	0	0	0	9	9	0	9	DONE
IRR	35	137	0	0	0	172	172	0	172	DONE
LOG	0	3	0	0	0	3	3	0	0	DONE
LSC	23	28	0	0	0	51	56	5	56	DONE
MEP	8	11	0	0	0	19	19	0	19	DONE
POT	40	118	0	0	0	158	158	0	158	DONE
ROD	20	1036	0	0	0	1056	1078	22	500	DONE
SEW	0	93	0	0	0	93	93	0	93	DONE
ST	26	85	0	0	0	111	111	0	111	DONE
STR	23	128	0	0	0	151	151	0	151	DONE
TEL	11	17	0	0	0	28	28	0	28	DONE
FFS	0	11	0	0	0	11	11	0	11	DONE
Grand Total	306	1826	0	0	8	2140	2167	27	1586	
Percentage	14%	84%	0%	0%	0%	99%		1%		