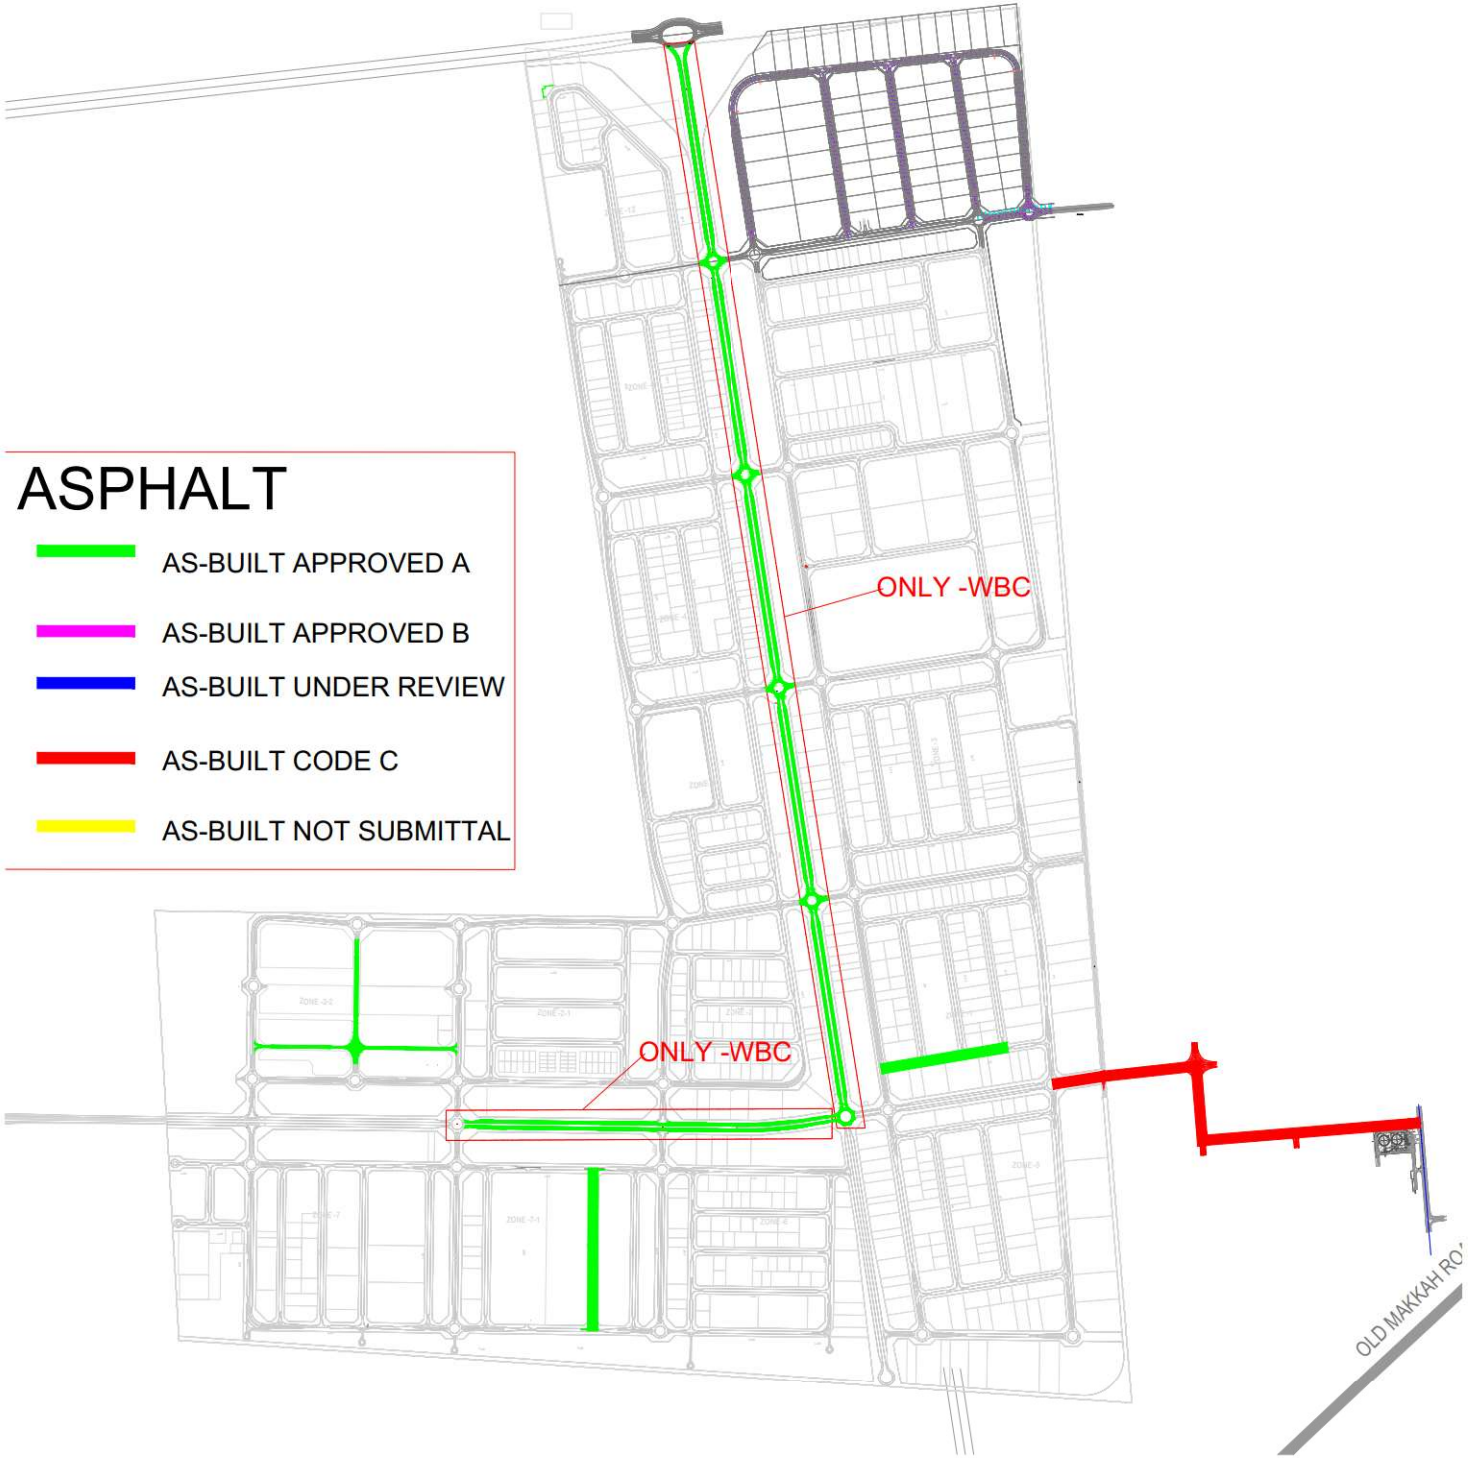
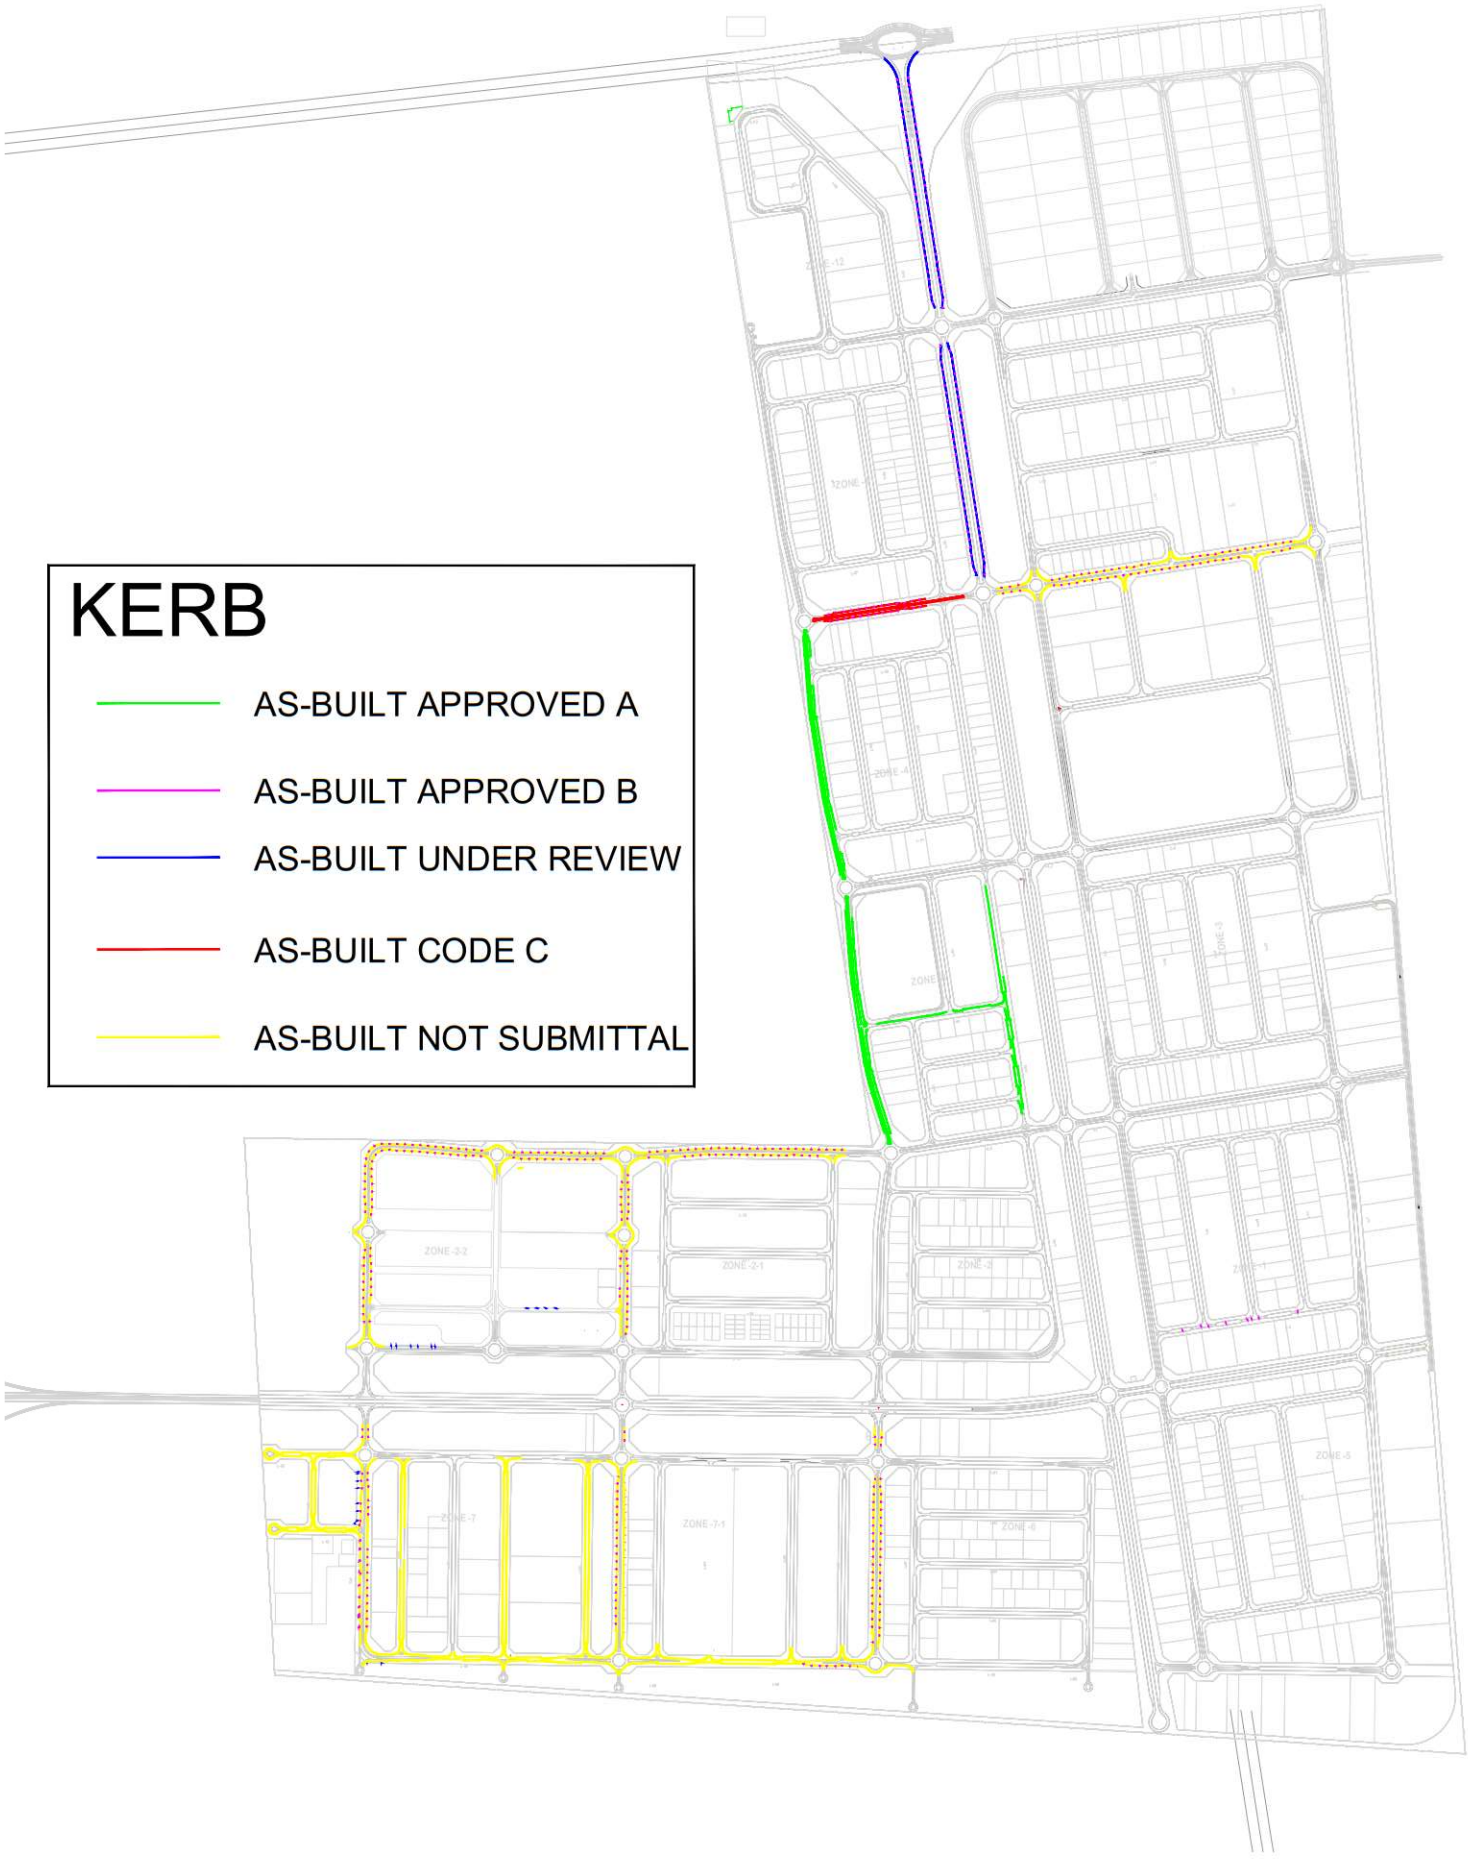

ASPHALT
AS-BUILT APPROVED A
AS-BUILT APPROVED B
AS-BUILT UNDER REVIEW
AS-BUILT CODE C
AS-BUILT NOT SUBMITTAL
ONLY -WBC
ONLY -WBC
OLD MAKKAH RO



KERB
AS-BUILT APPROVED A
AS-BUILT APPROVED B
AS-BUILT UNDER REVIEW
AS-BUILT CODE C
AS-BUILT NOT SUBMITTAL

AS-BUILT APPROVED

AS-BUILT UNDER REVIEW


AS-BUILT CODE C


AS-BUILT NOT SUBMITTAL

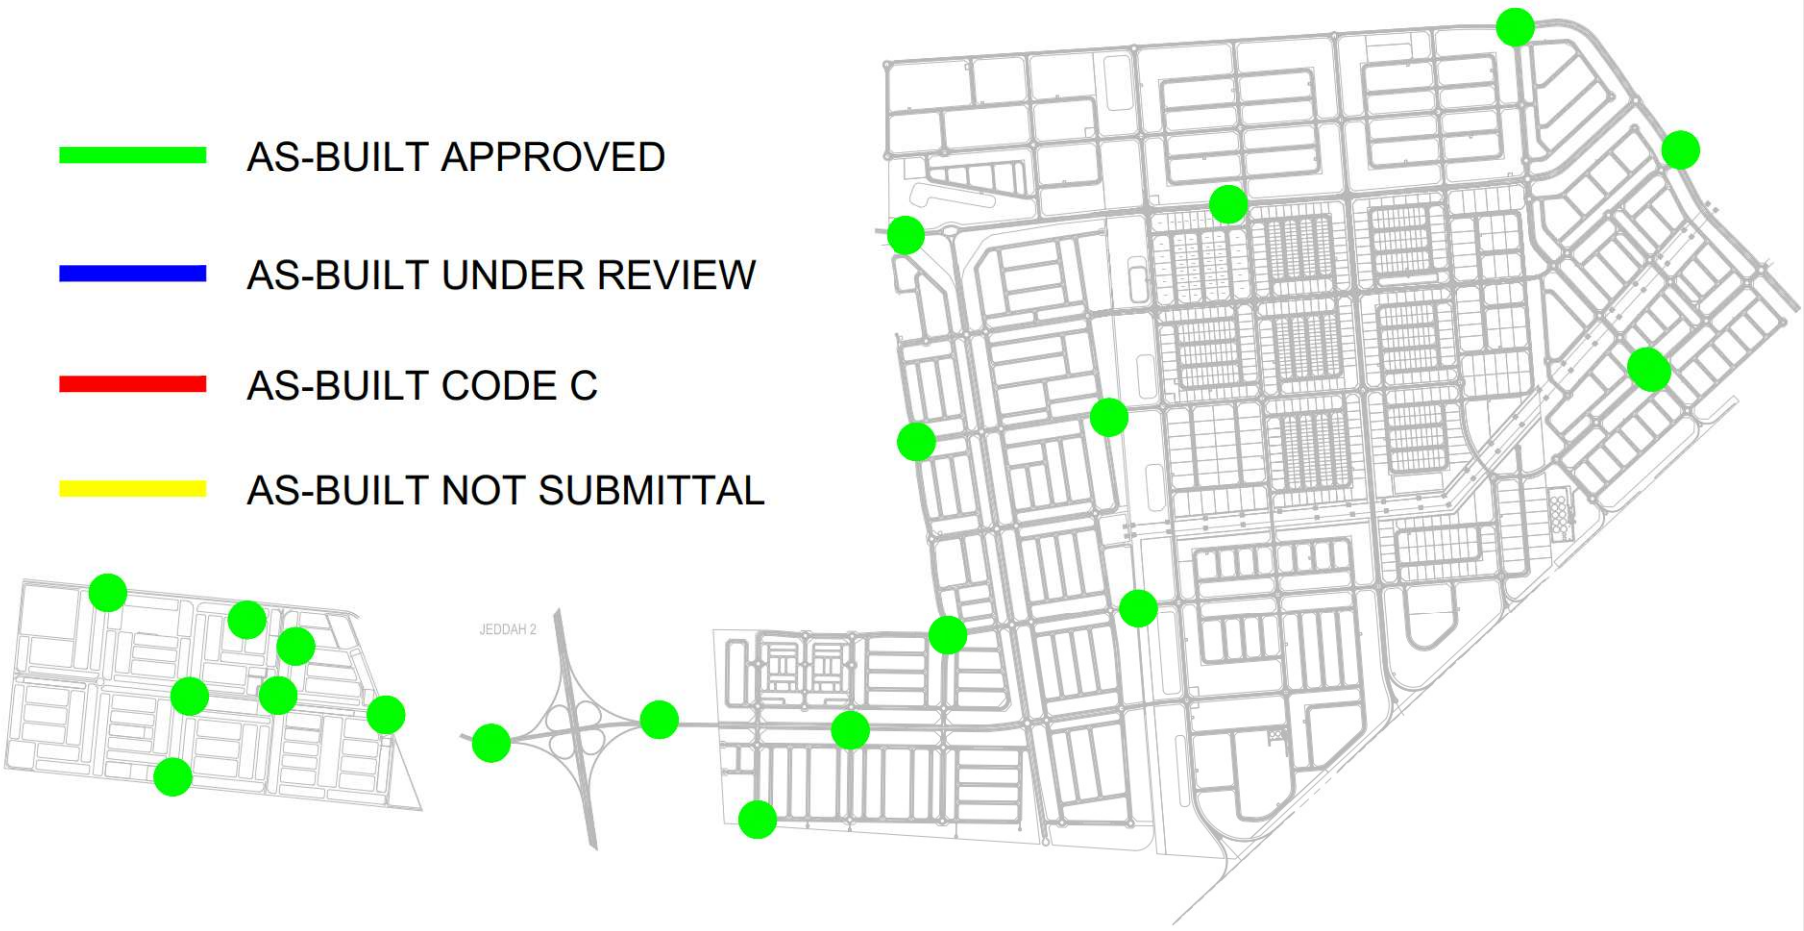

STORM DEPRESSED OPEN CHANNEL

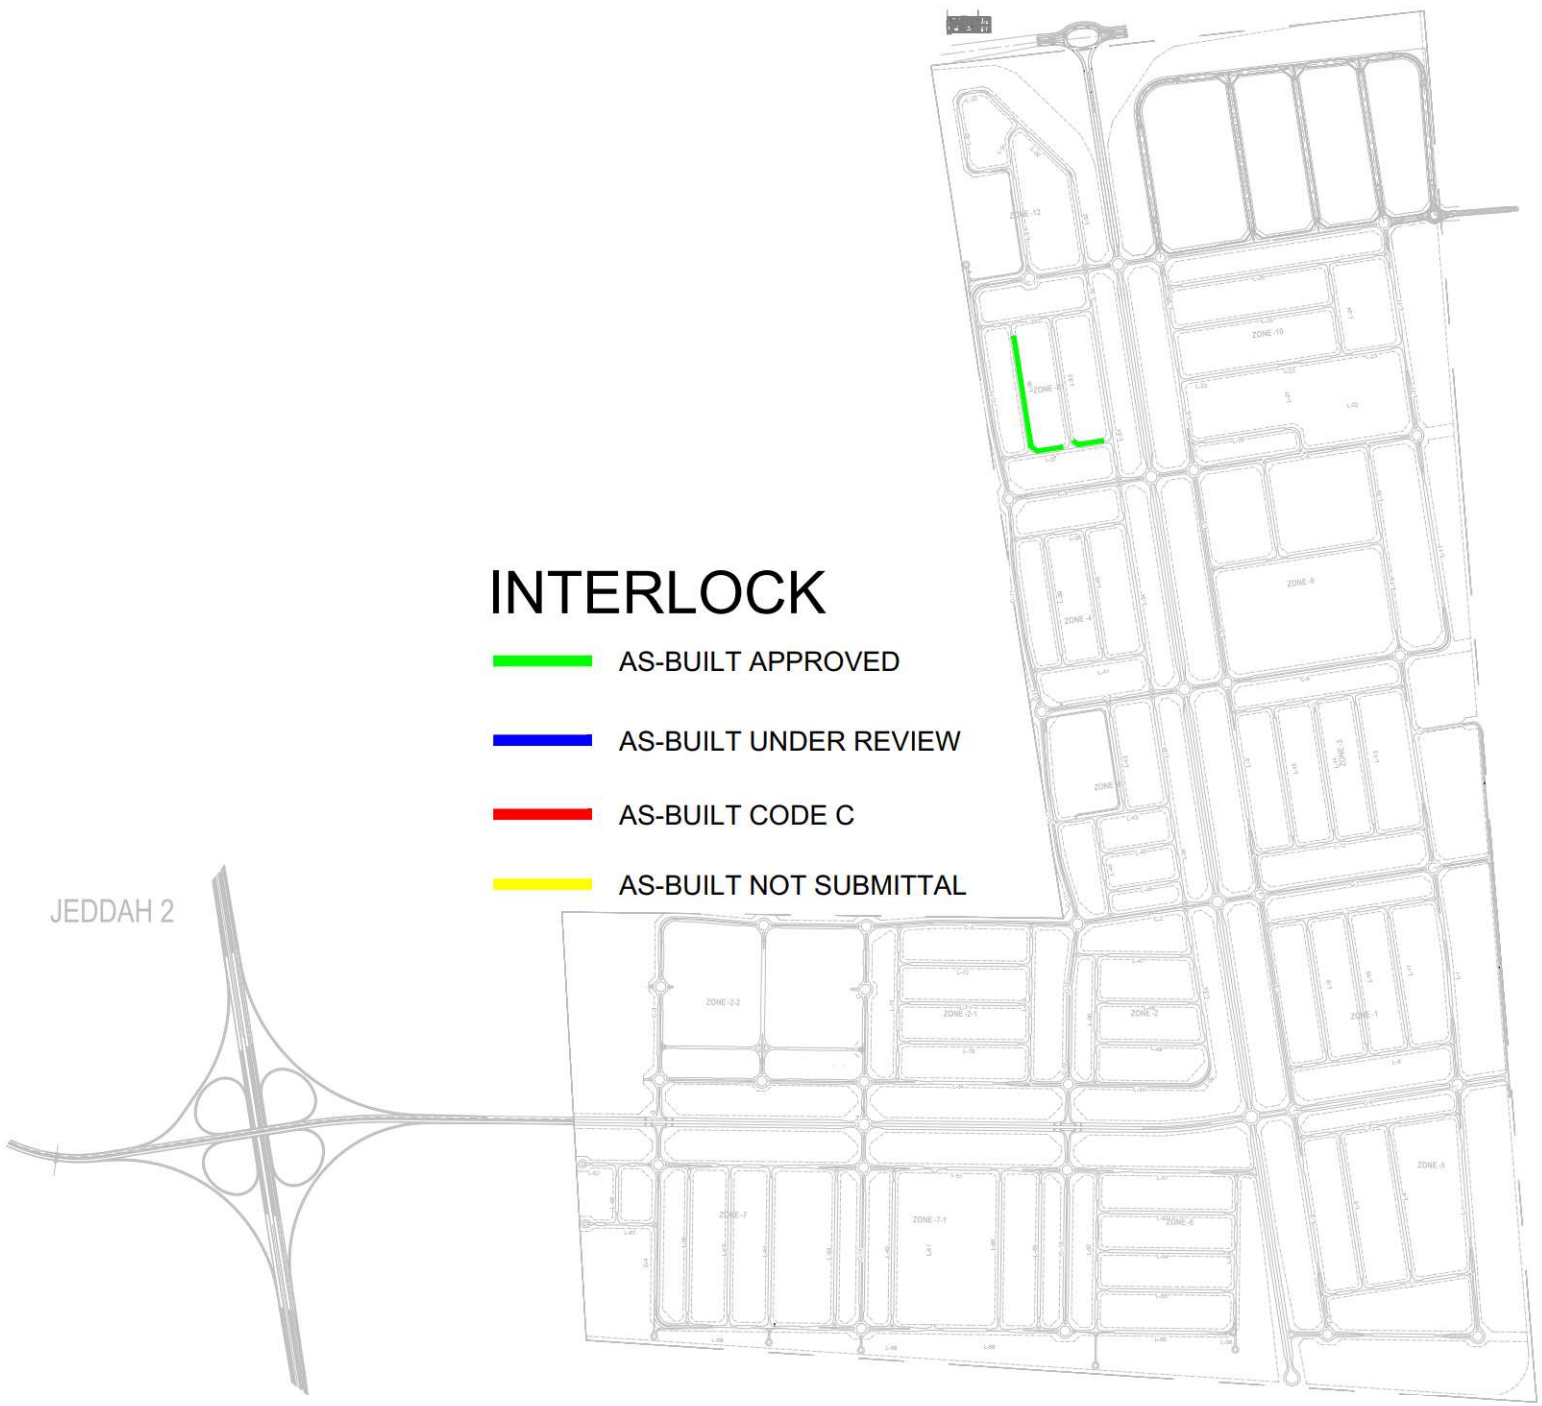



INTERLOCK
AS-BUILT APPROVED
AS-BUILT UNDER REVIEW
AS-BUILT CODE C
AS-BUILT NOT SUBMITTAL
JEDDAH 2

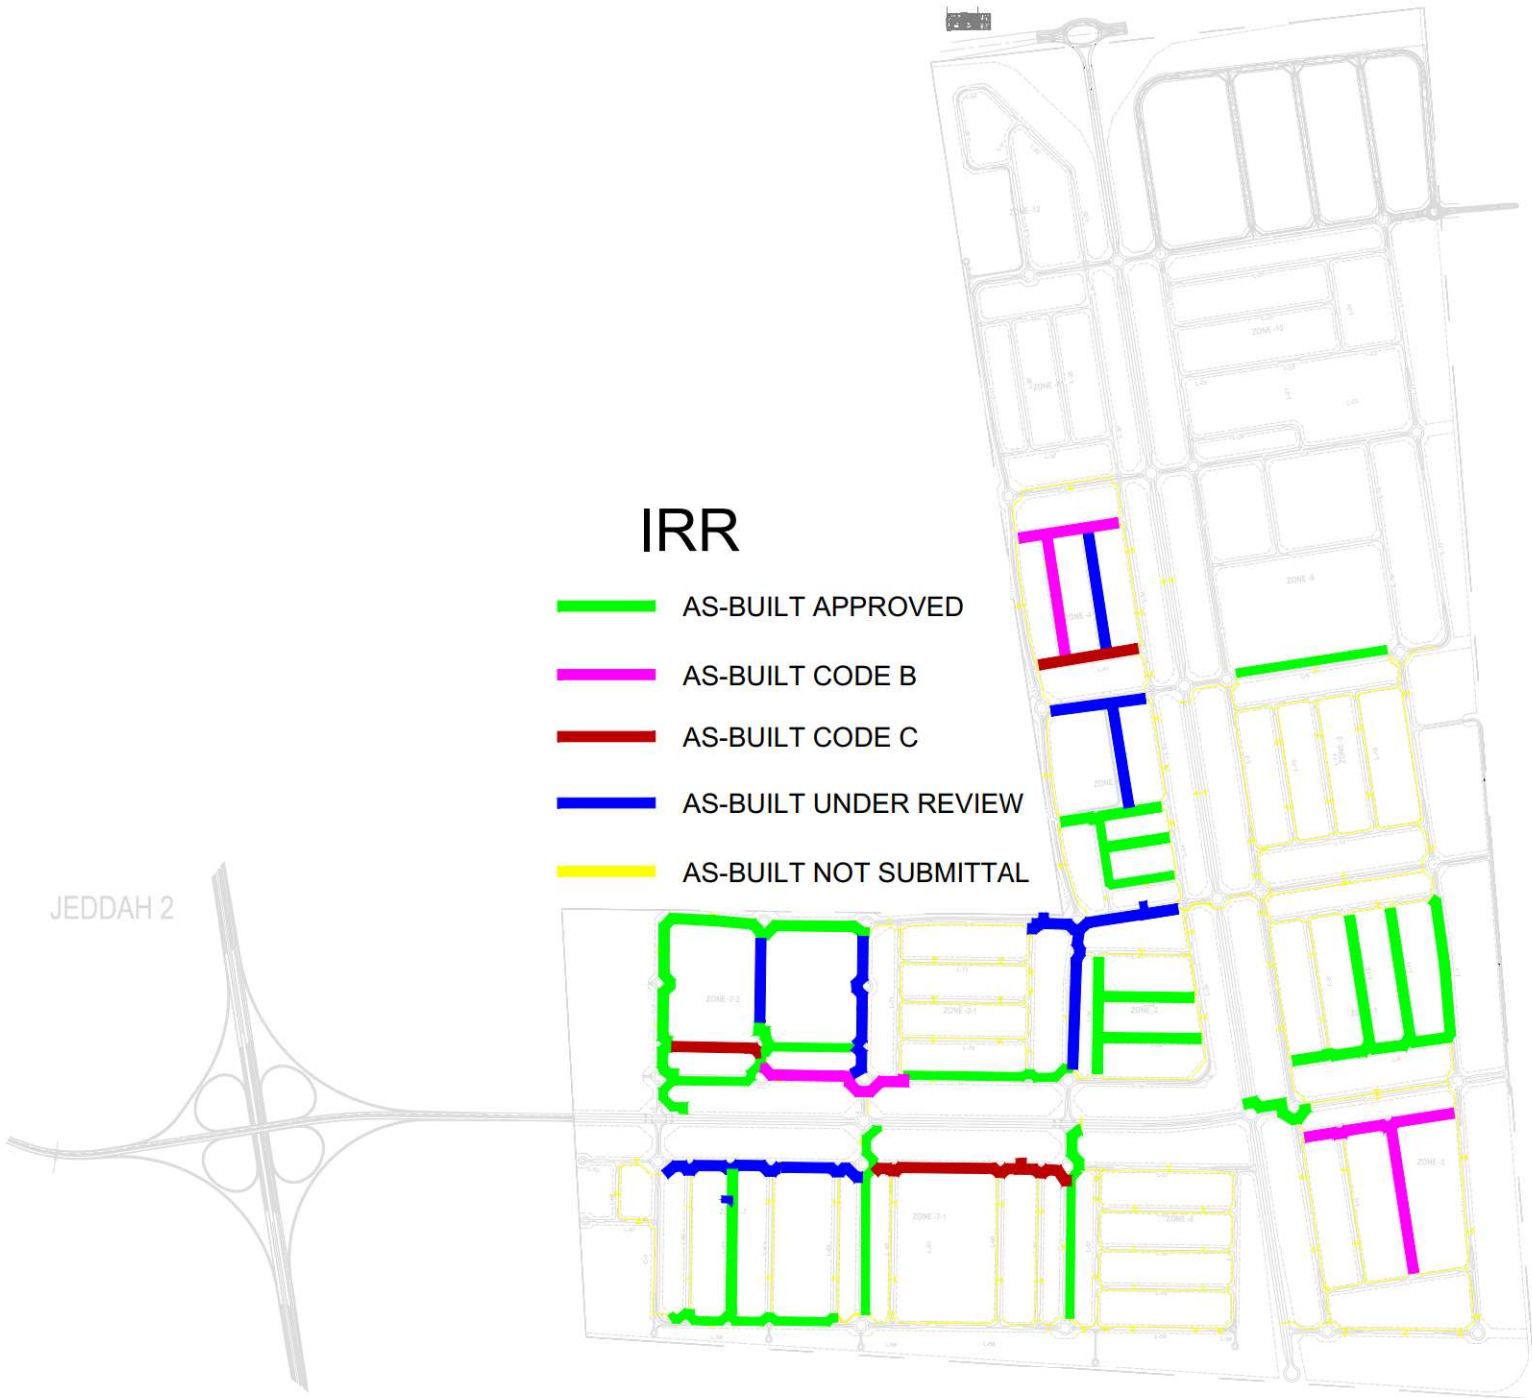

IRR
AS-BUILT APPROVED
AS-BUILT CODE B
AS-BUILT CODE C
AS-BUILT UNDER REVIEW
AS-BUILT NOT SUBMITTAL
JEDDAH 2

ROAD MARKING & SIGN


- AS-BUILT APPROVED
- AS-BUILT UNDER REVIEW
- AS-BUILT CODE C
- AS-BUILT NOT SUBMITTAL

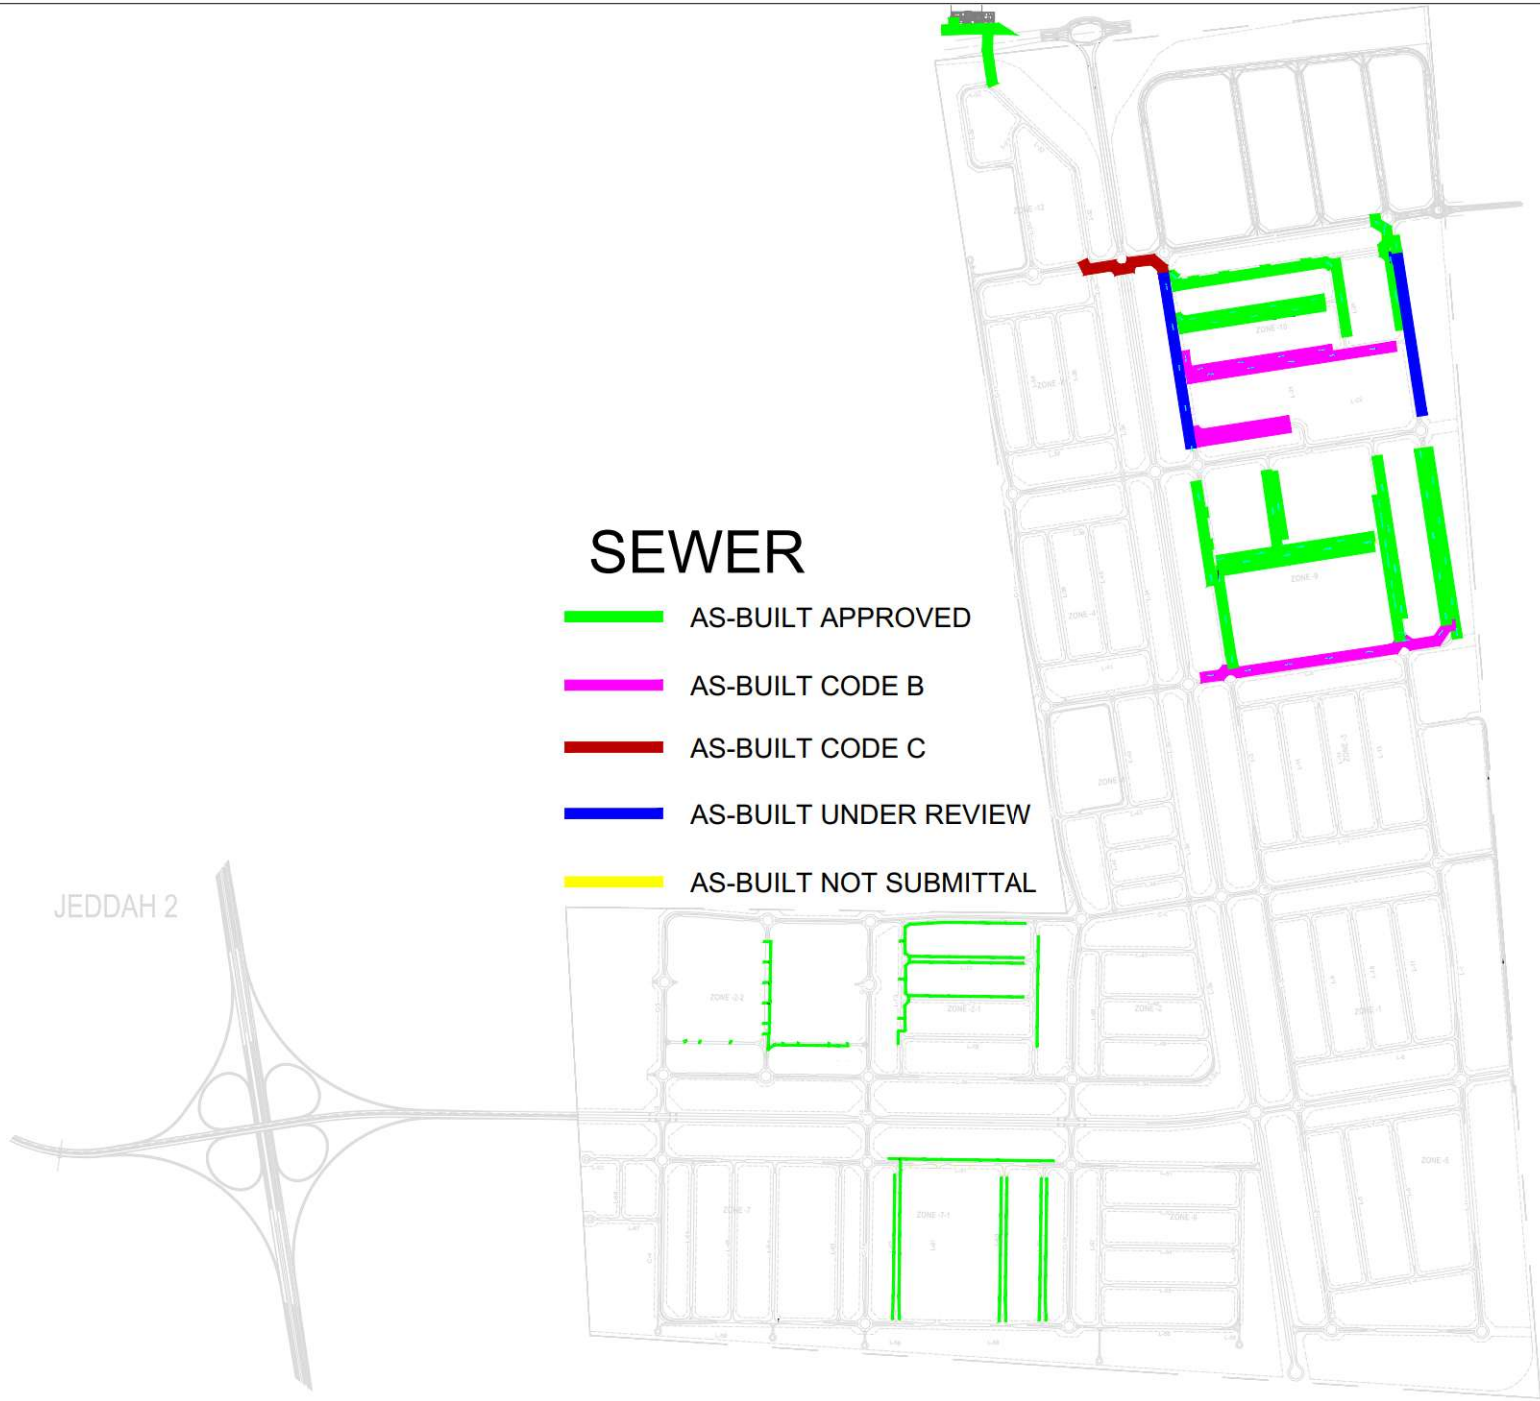



SEWER
AS-BUILT APPROVED
AS-BUILT CODE B
AS-BUILT CODE C
AS-BUILT UNDER REVIEW
AS-BUILT NOT SUBMITTAL
JEDDAH 2

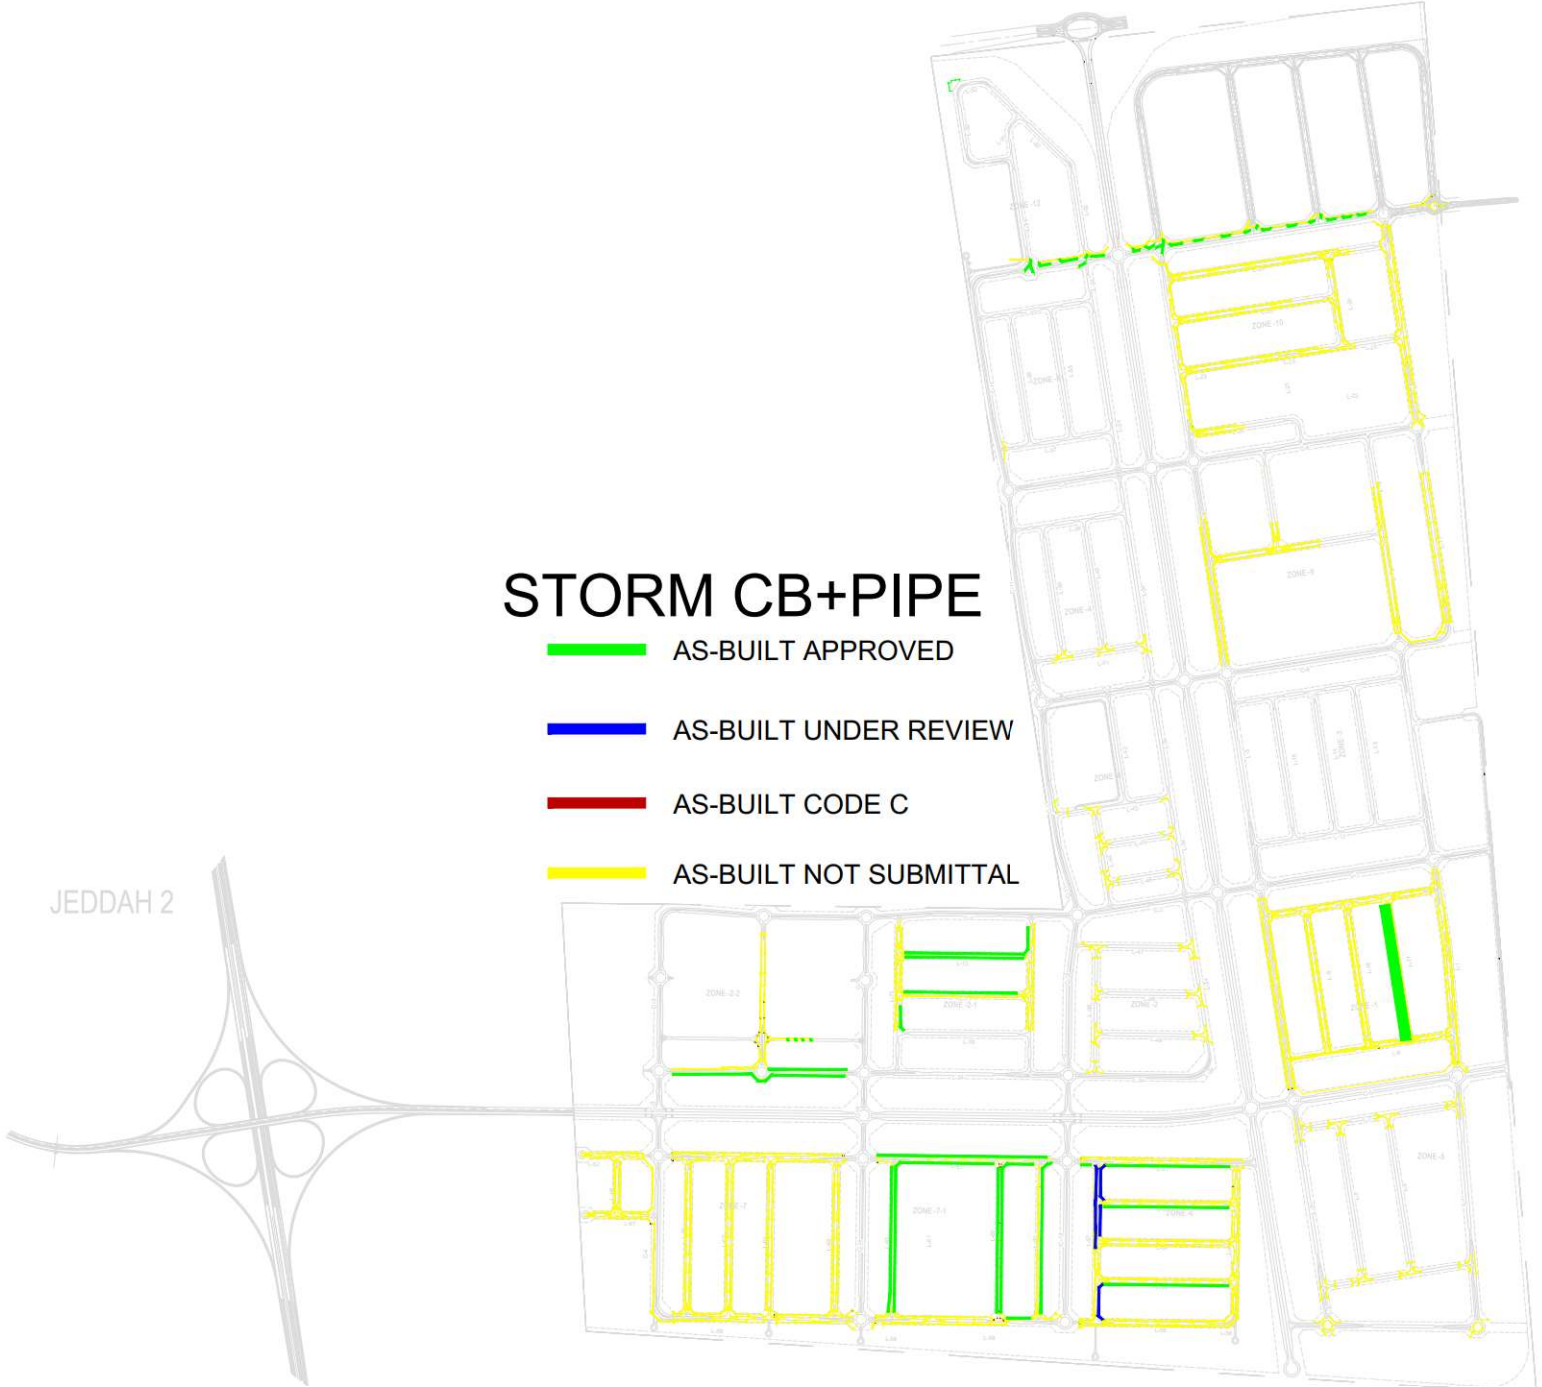
STORM CB+PIPE
AS-BUILT APPROVED
AS-BUILT UNDER REVIEW
AS-BUILT CODE C
AS-BUILT NOT SUBMITTAL
JEDDAH 2


STORM MANHOLE+PIPE

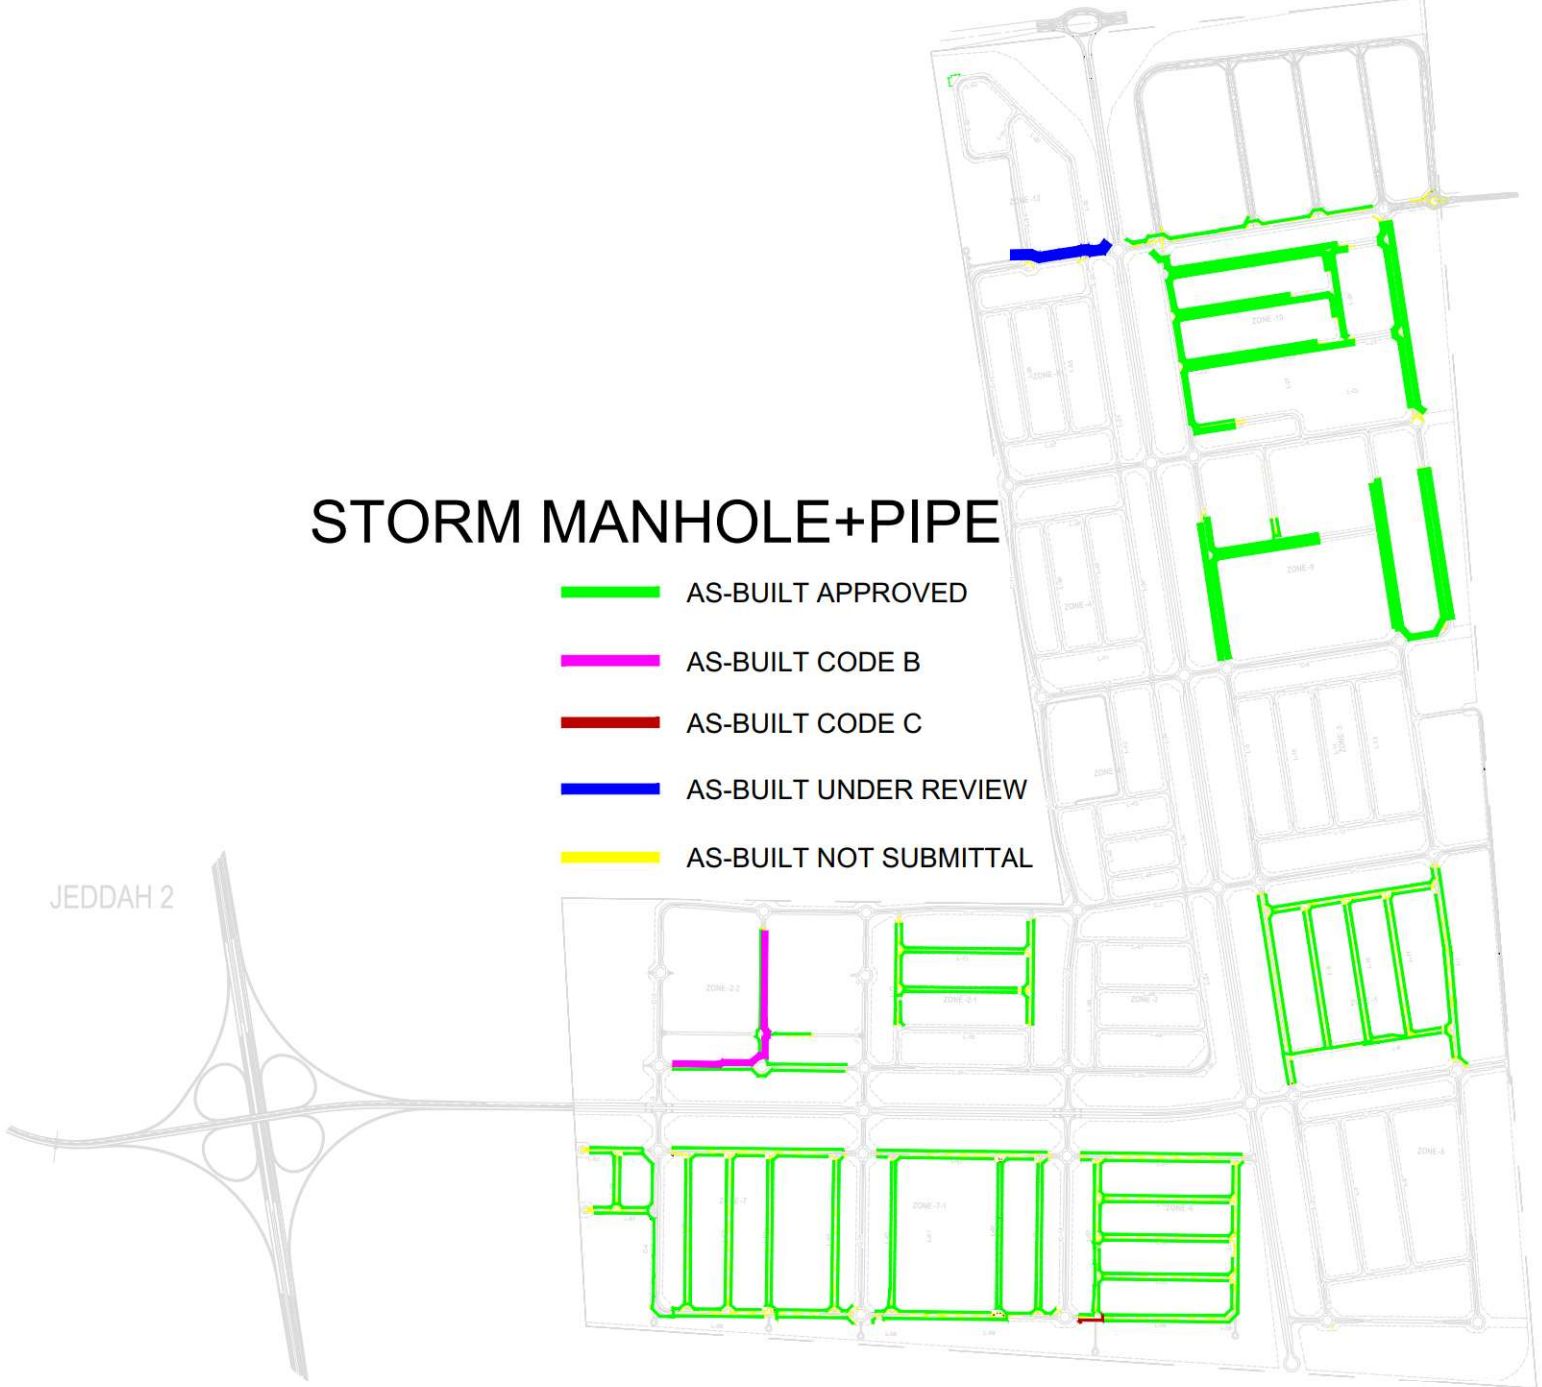

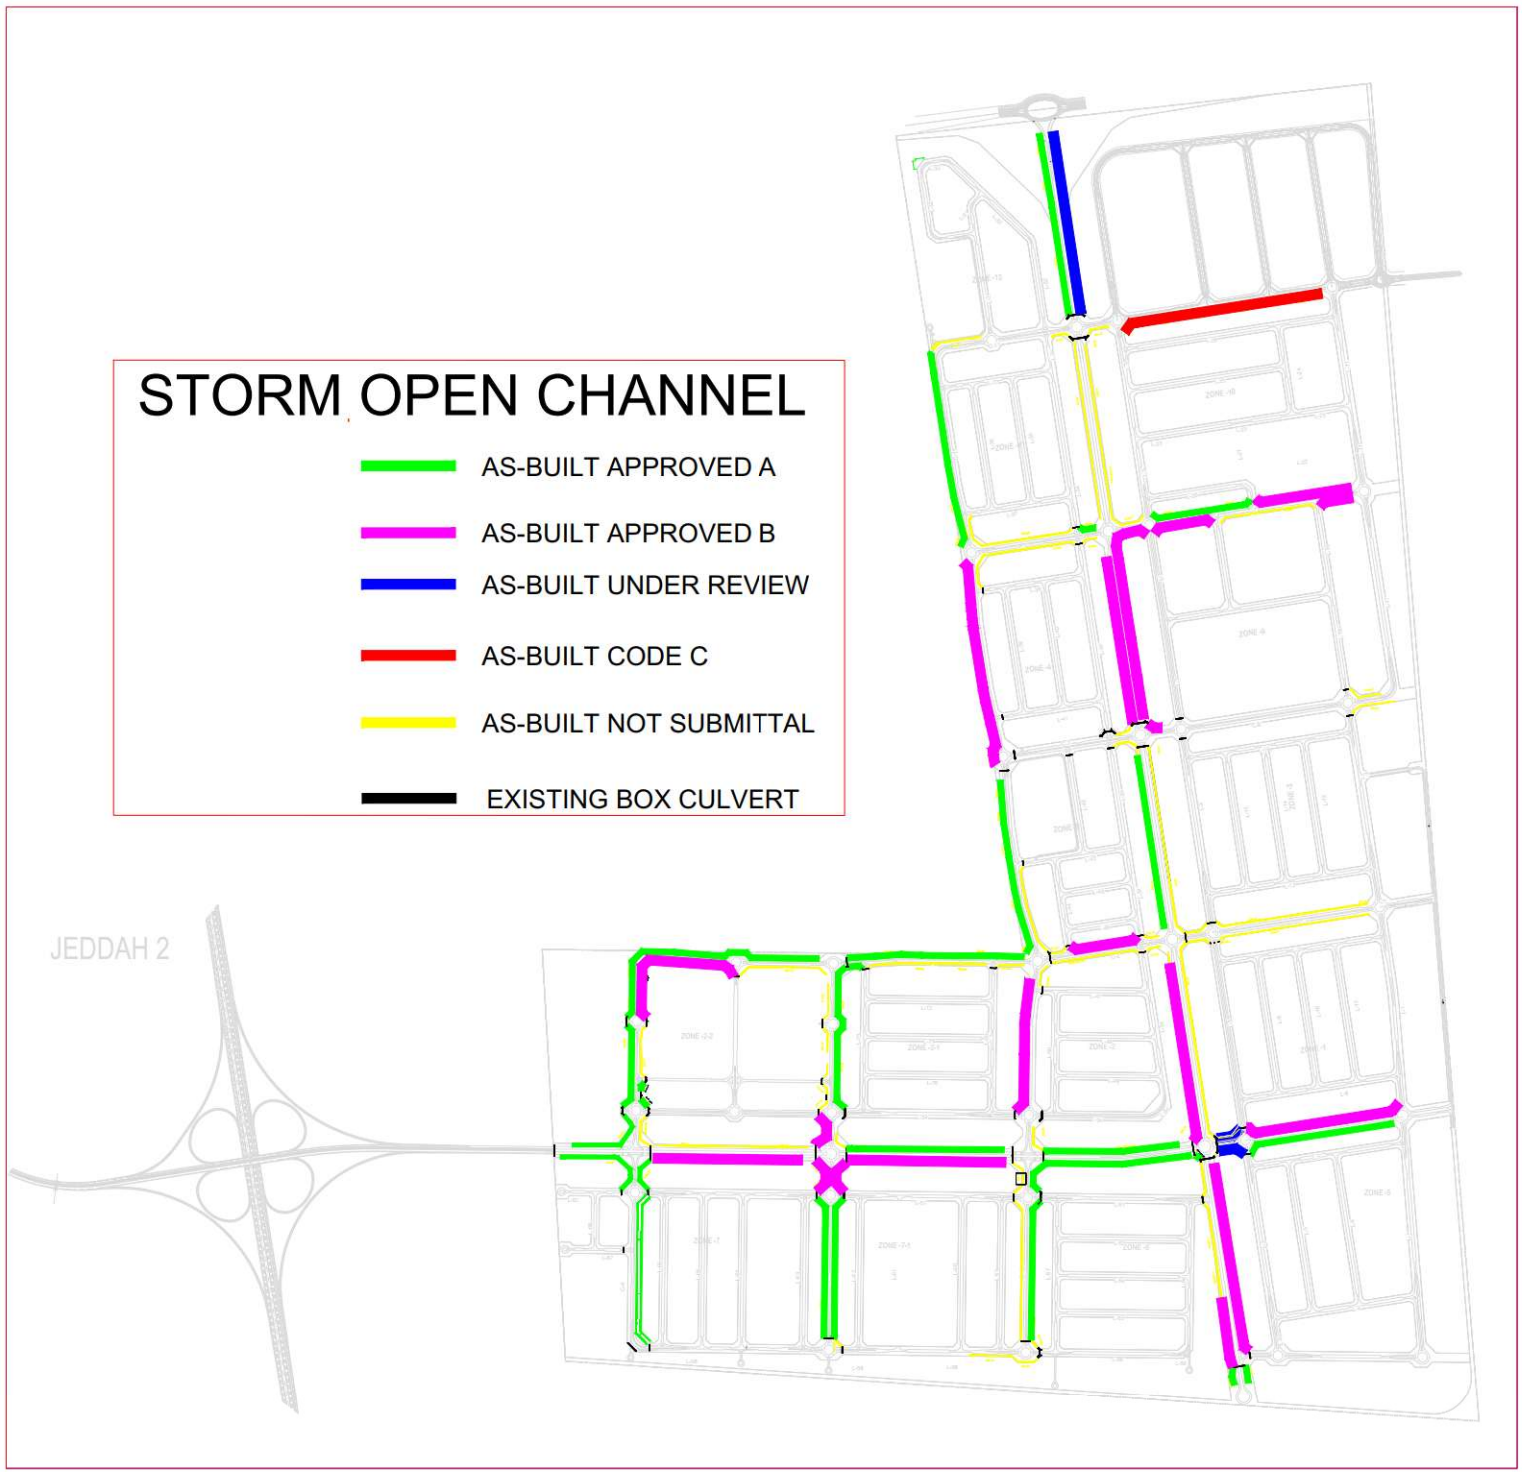
STORM OPEN CHANNEL
AS-BUILT APPROVED A
AS-BUILT APPROVED B
AS-BUILT UNDER REVIEW
AS-BUILT CODE C
AS-BUILT NOT SUBMITTAL
EXISTING BOX CULVERT
JEDDAH 2

STORM POND


- AS-BUILT APPROVED
- AS-BUILT UNDER REVIEW
- AS-BUILT CODE C
- AS-BUILT NOT SUBMITTAL
- EXISTING POND

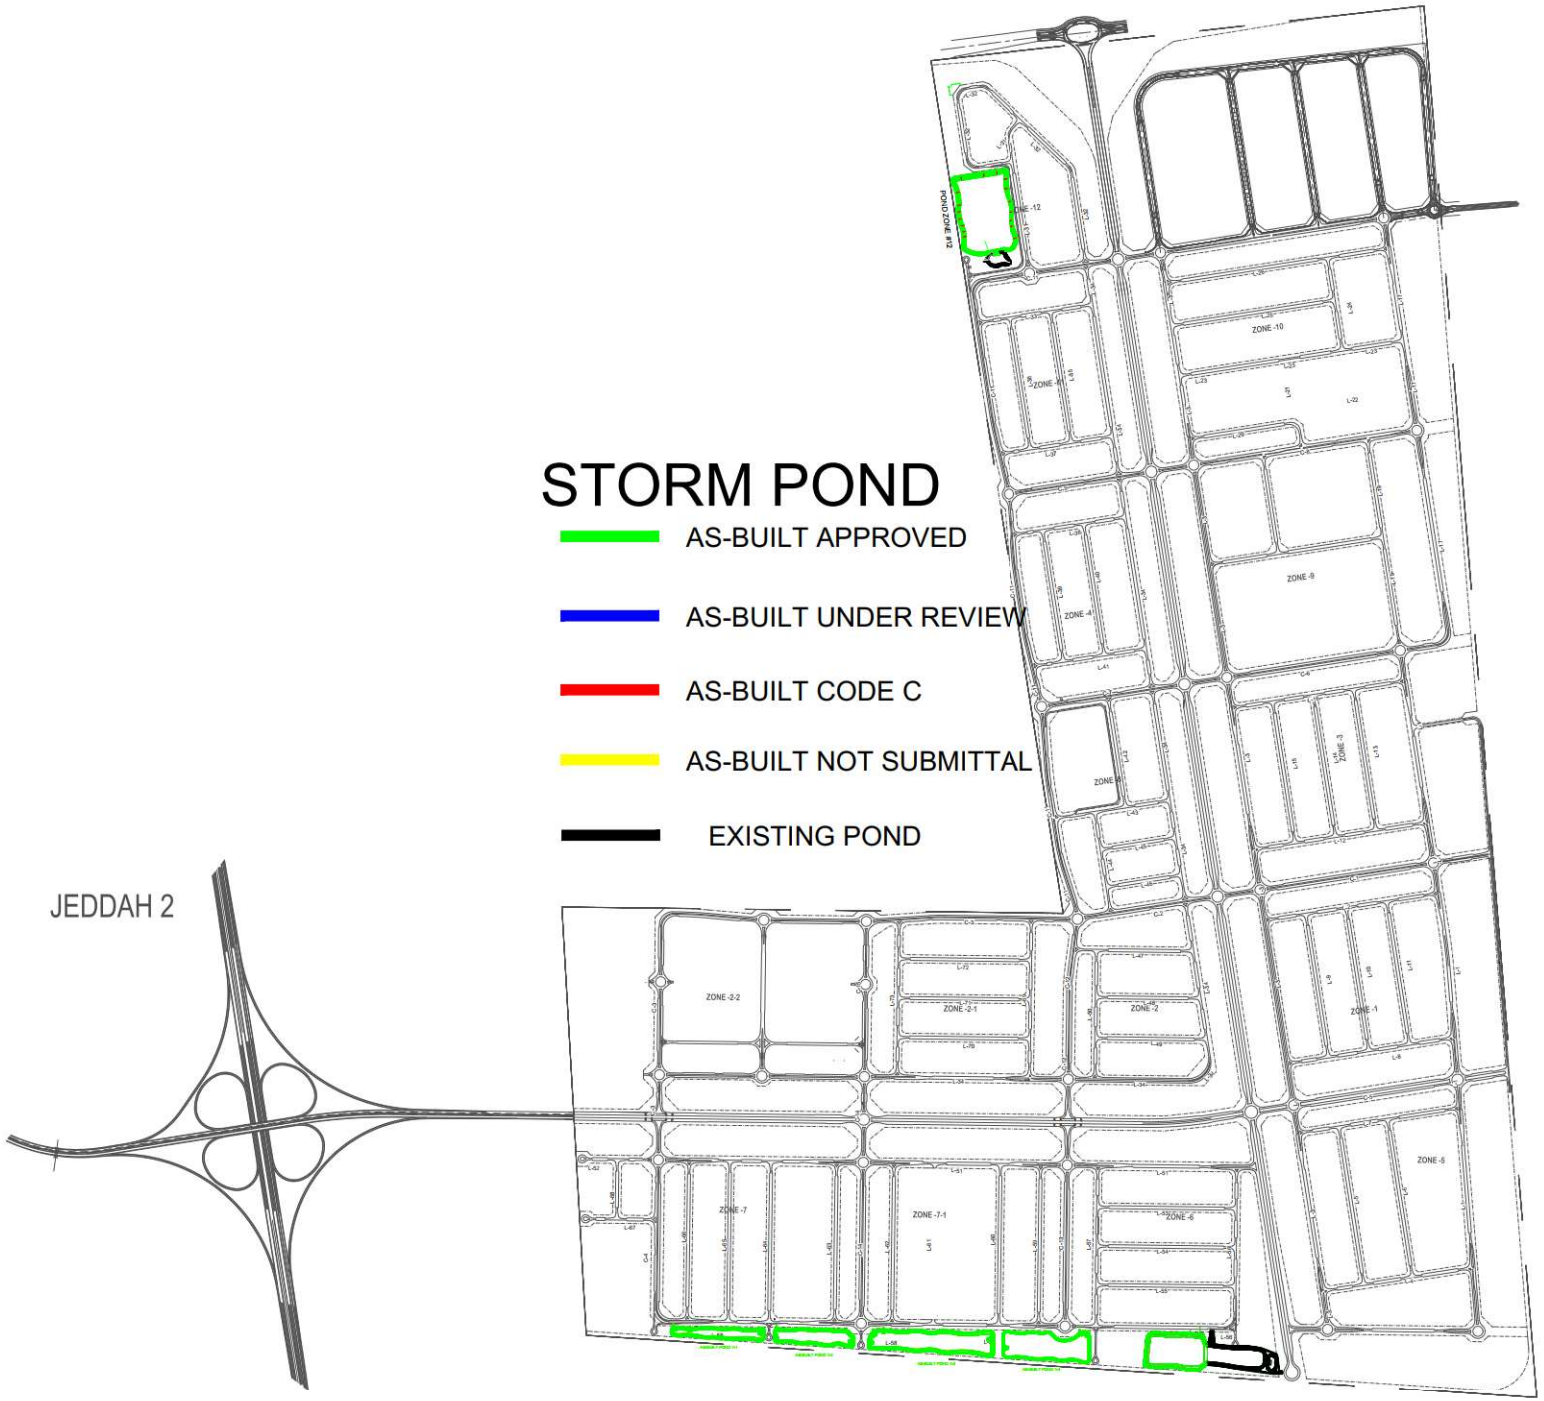


STREET LIGHT
AS-BUILT APPROVED
AS-BUILT UNDER REVIEW
AS-BUILT CODE C
AS-BUILT NOT SUBMITTAL
JEDDAH 2
JEDDAH 3

TELECOM

- AS-BUILT APPROVED
- AS-BUILT UNDER REVIEW
- AS-BUILT CODE C
- AS-BUILT NOT SUBMITTAL

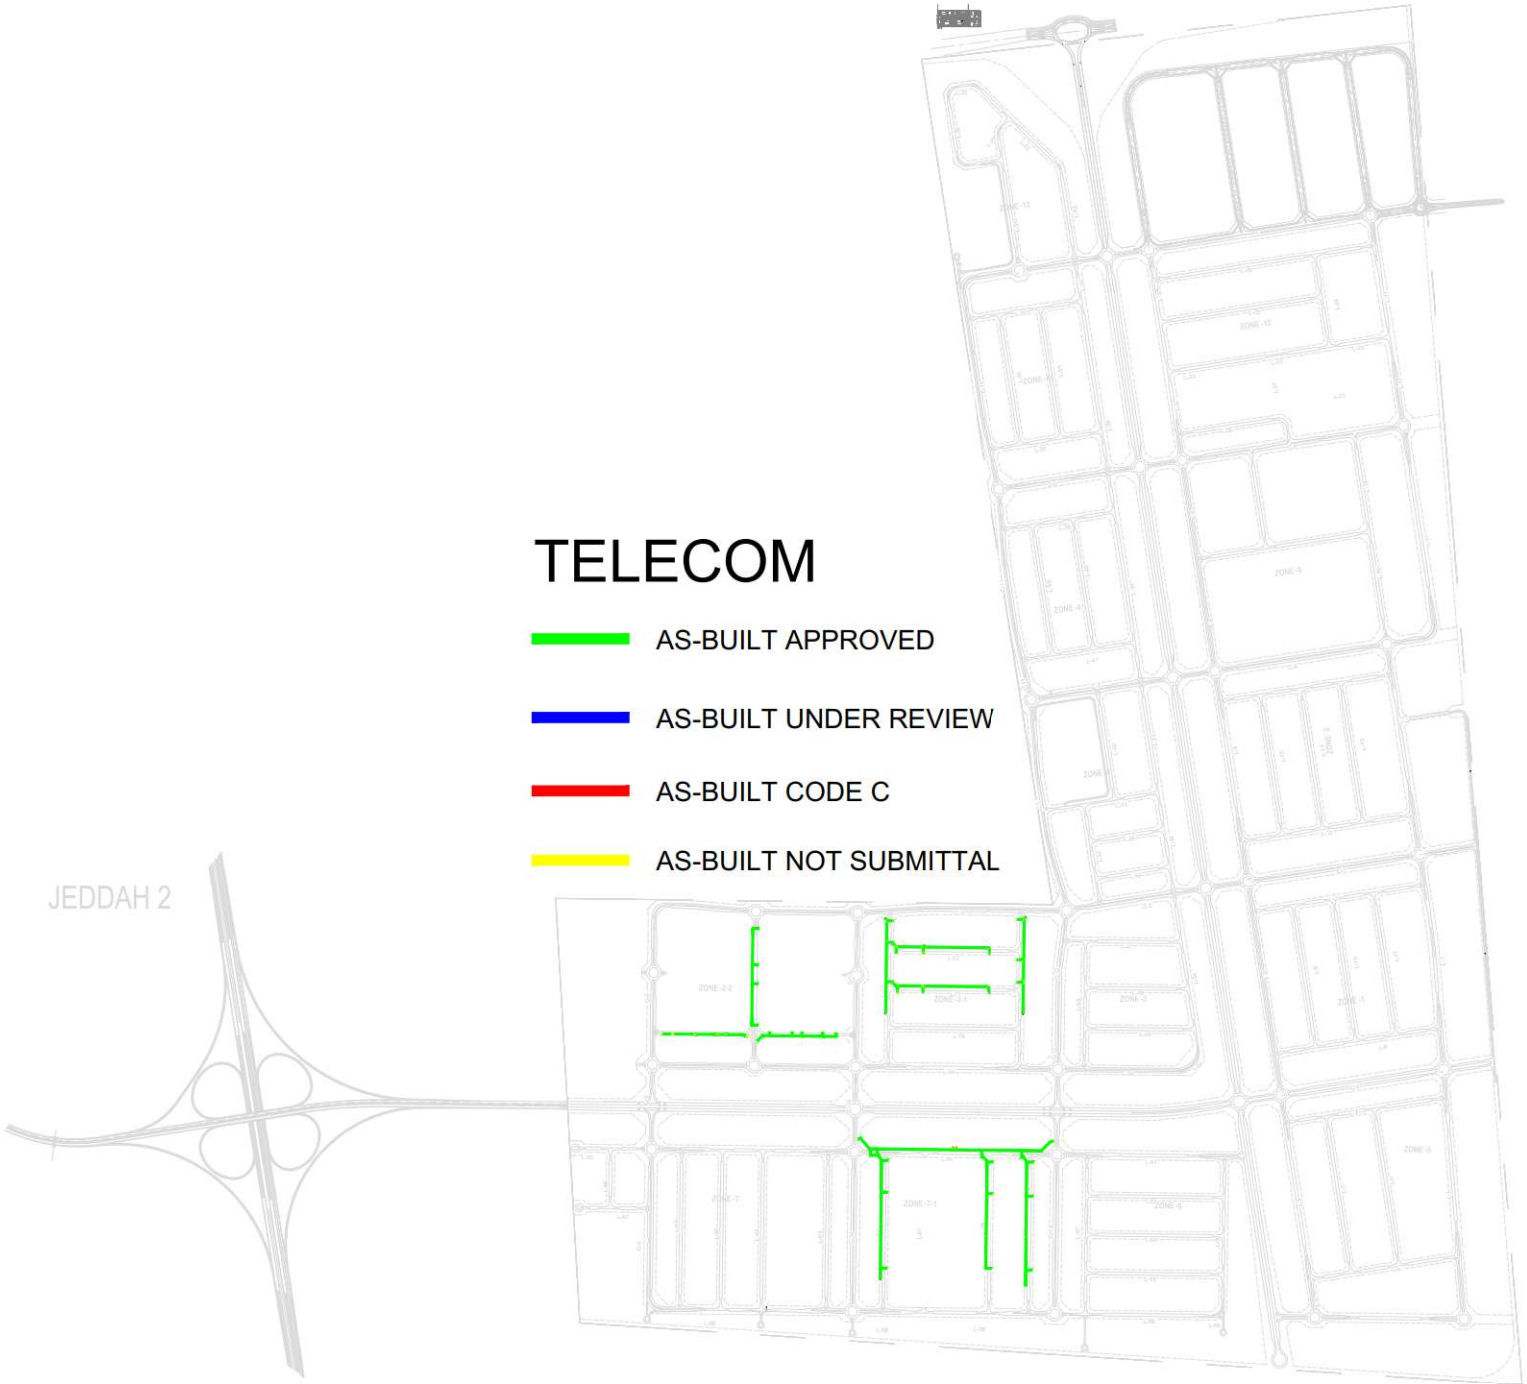


WATER+FH
AS-BUILT APPROVED
AS-BUILT CODE B
AS-BUILT CODE C
AS-BUILT UNDER REVIEW
AS-BUILT NOT SUBMITTAL
JEDDAH 2